




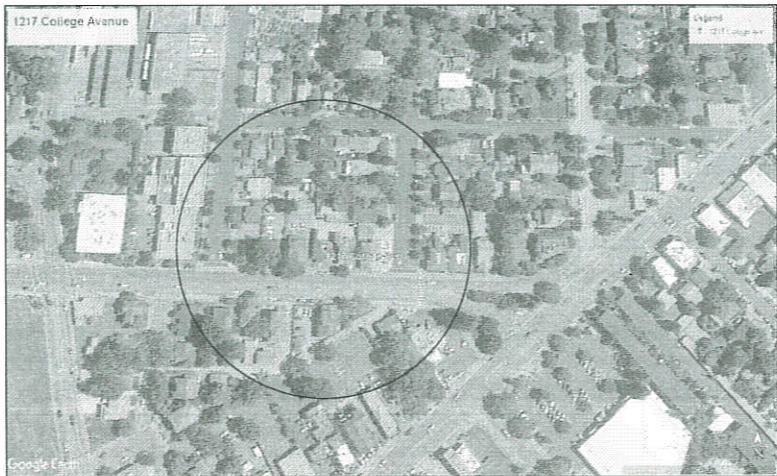


VICINITY MAP - CONTEXT MAP

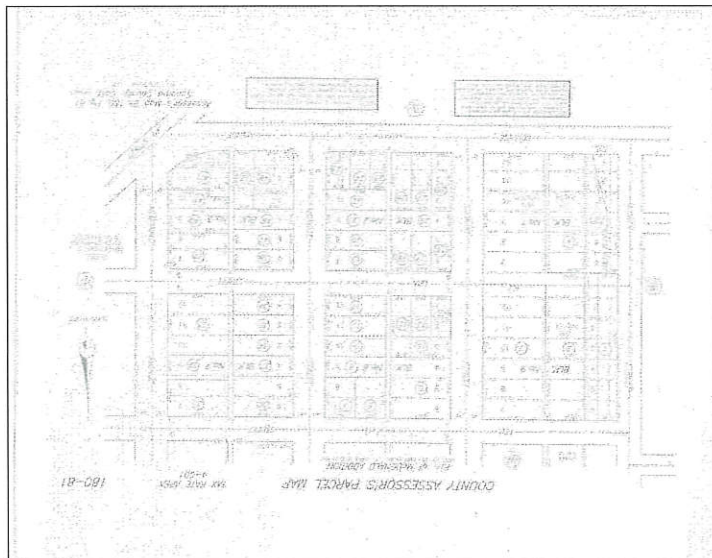


PARCEL MAP

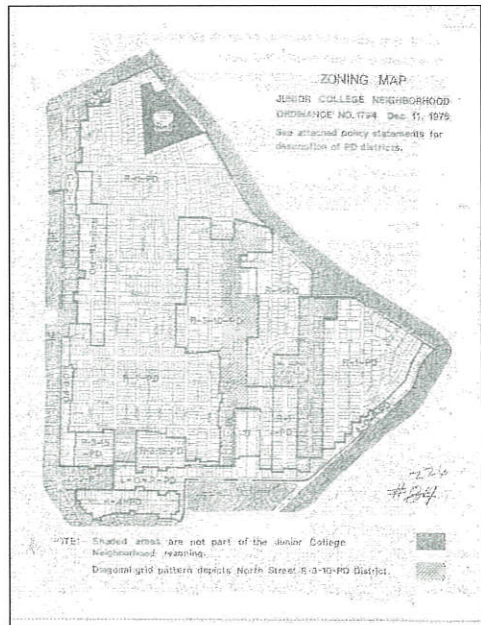

ZONING MAP

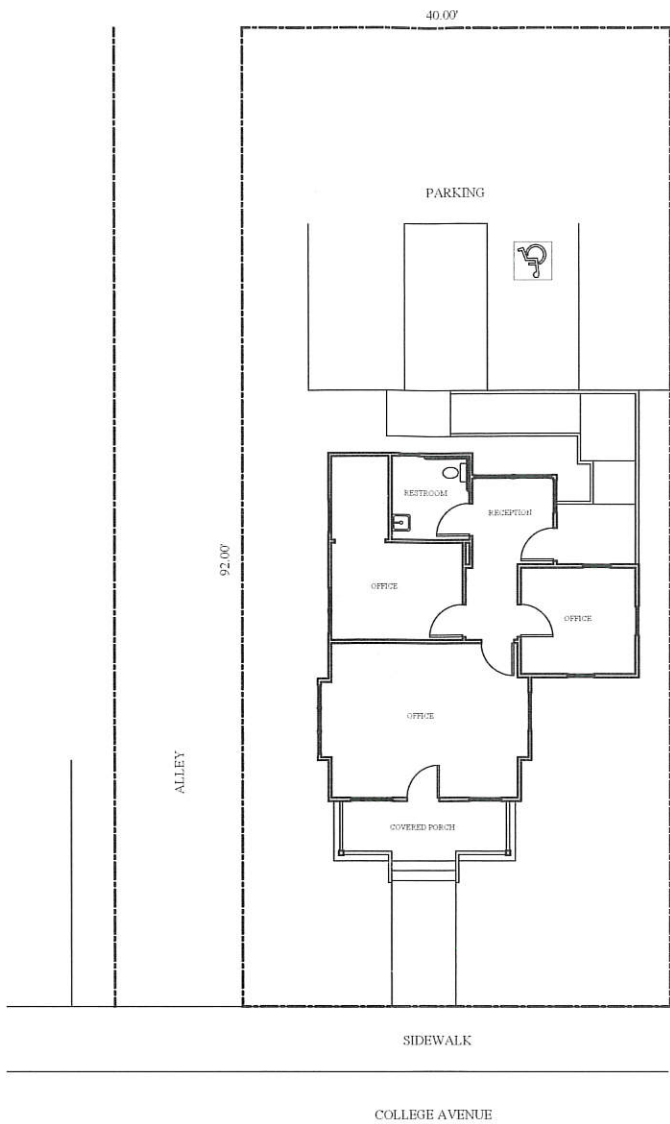

SITE PLAN - AS BUILT

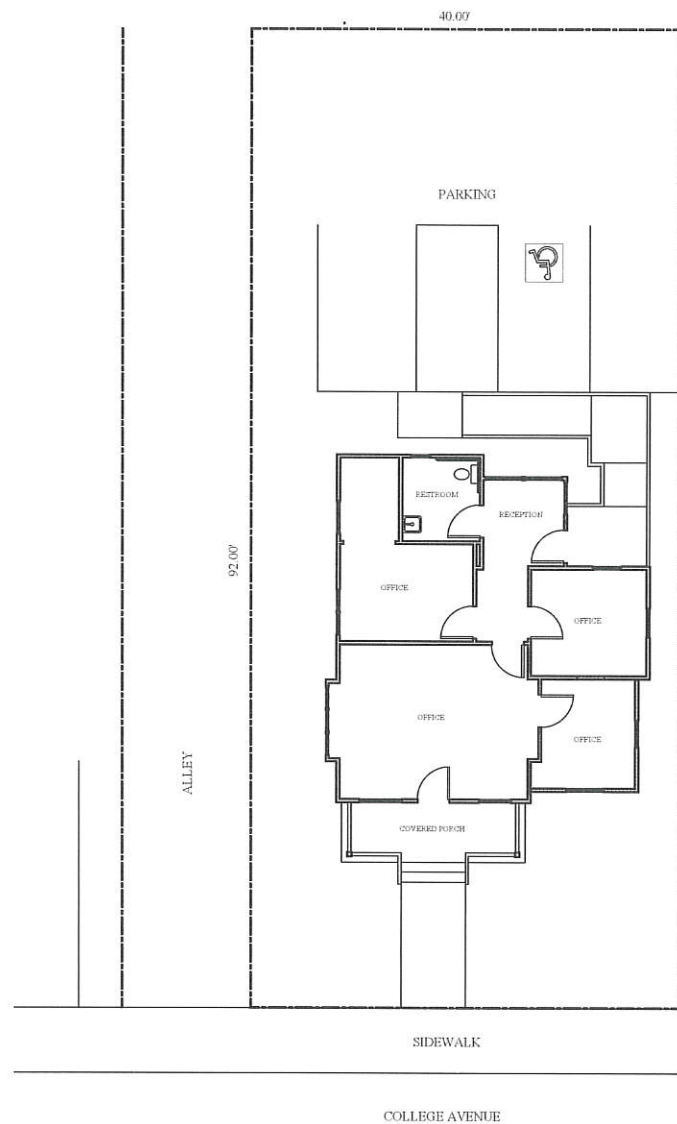

SITE PLAN - PROPOSED

SITE AREA 3,680 S.F.
BUILDING AREA 823 S.F.
LOT COVERAGE 22.36%


OWNERS
DAVID AND CYNTHIA WILLIAMS
1217 COLLEGE AVENUE
SANTA ROSA, CA 95404
707-571-8222

SHEET INDEX
SITE PLAN
FLOOR PLAN - AS BUILT
EXTERIOR ELEVATIONS - AS BUILT
FLOOR PLAN - PROPOSED
EXTERIOR ELEVATIONS - PROPOSED

City of Santa Rosa

SEP 28 2017

City of Santa Rosa
Economic Development Department

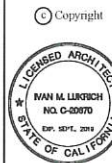

Revisions

IVAN M. LUKRICH
ARCHITECT
P.O. BOX 1642, SANTA ROSA, CA 95402
VOICE 707.573.8291 FAX 707.573.3012

1217 COLLEGE AVENUE
OFFICE ADDITION
APN 186-810-025
1217 COLLEGE AVENUE
SANTA ROSA, CALIFORNIA

AS BUILT - PROPOSED
SITE PLAN

Job Number
WILLIAMS

Drawn By
IML


Scale
1/8" = 1'-0"

Date
9-27-2017


Sheet Number

A1


of

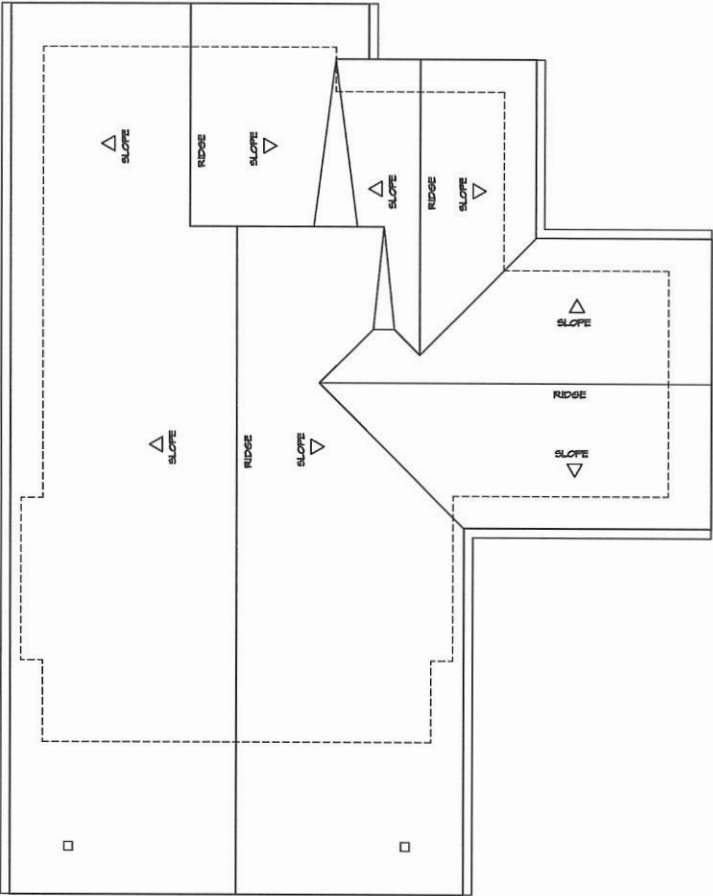

ROOF PLAN - AS BUILT

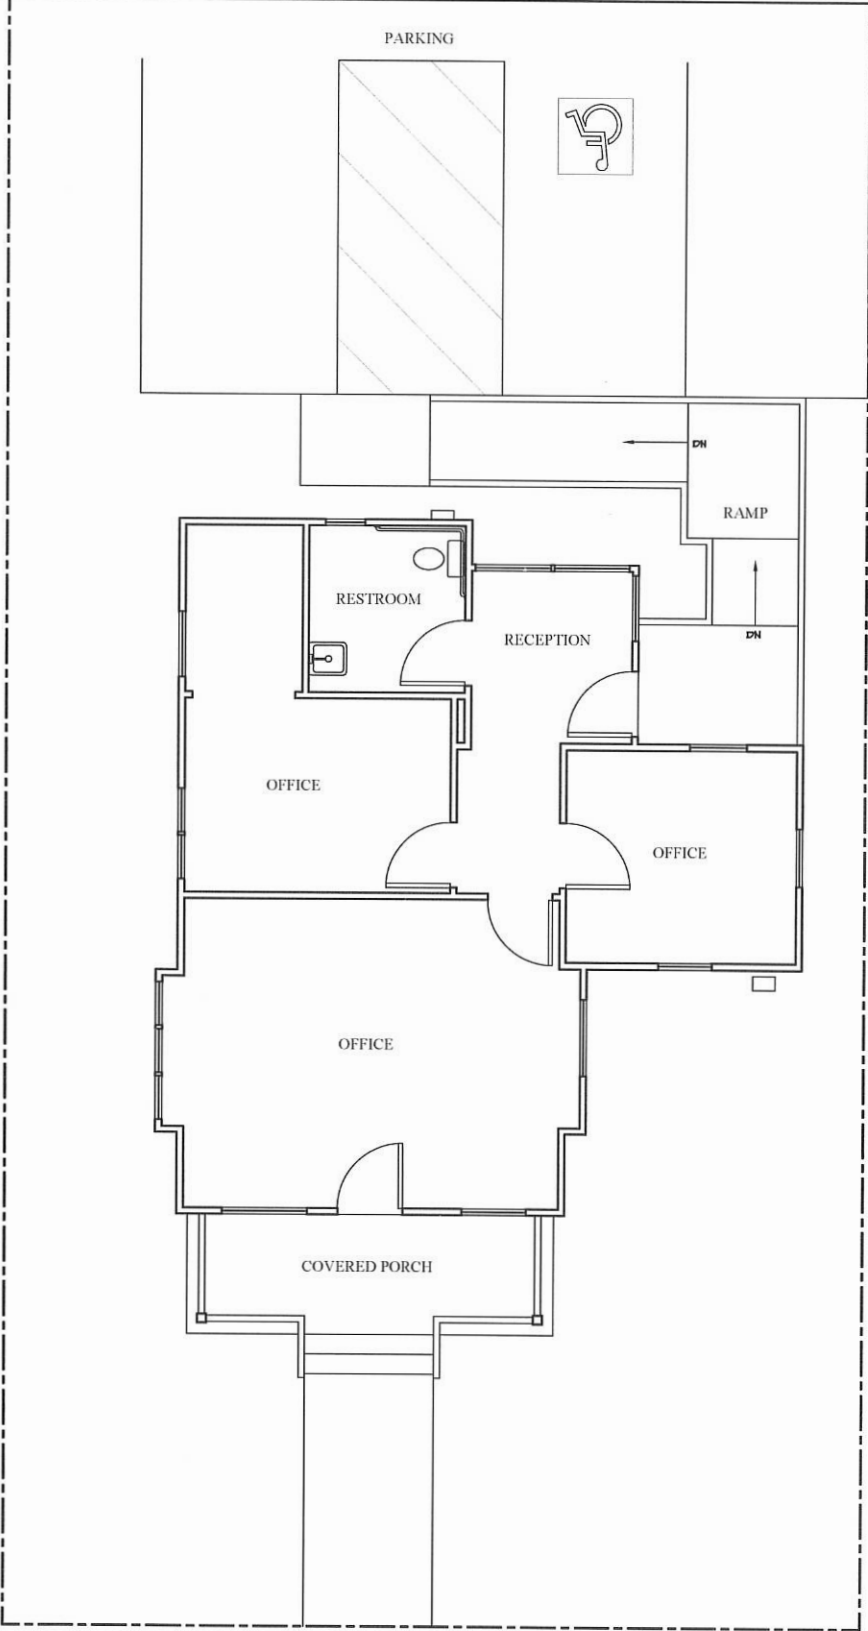

COLLEGE AVENUE
FLOOR PLAN - AS BUILT
BUILDING AREA
OFFICE 126 S.F.
COVERED PORCH 80 S.F.

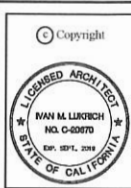

Revisions

IVAN M. LUKRICH
ARCHITECT
P.O. BOX 1642, SANTA ROSA, CA 95402
VOICE 707.573.8291 FAX 707.573.3012

1217 COLLEGE AVENUE
OFFICE ADDITION
APN 180-810-025
1217 COLLEGE AVENUE
SANTA ROSA, CALIFORNIA

FLOOR PLAN
AS BUILT

Job Number
WILLIAMS
Drawn By
JML
Scale
1/4" = 1'-0"
Date
9-27-2017
Sheet Number

A2
of



SOUTH ELEVATION



EAST ELEVATION



NORTH ELEVATION



WEST ELEVATION

EXTERIOR ELEVATIONS - AS BUILT

Copyright



Revisions

IVAN M. LUKRICH
ARCHITECT
P.O. BOX 1642, SANTA ROSA, CA 95402
VOICE 707.578.8291 FAX 707.578.3012

1217 COLLEGE AVENUE
OFFICE ADDITION
APN 186410-025
1217 COLLEGE AVENUE
SANTA ROSA, CALIFORNIA

EXTERIOR ELEVATIONS
AS BUILT

Job Number
WILLIAMS

Drawn By
IML


Scale
1/4" = 1'-0"

Date
9-27-2017


Sheet Number

A3

of

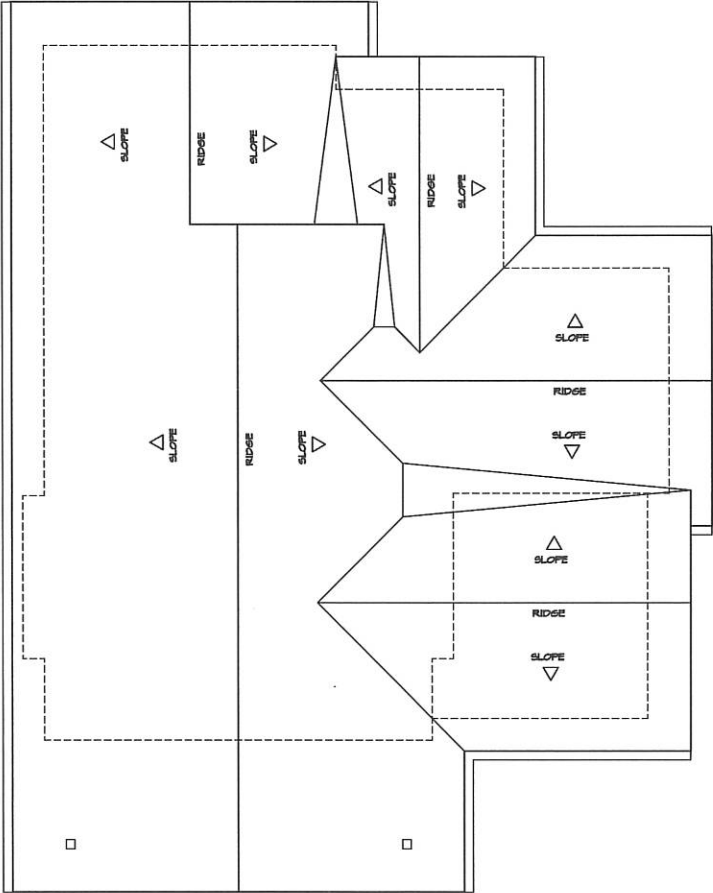


ROOF PLAN - PROPOSED

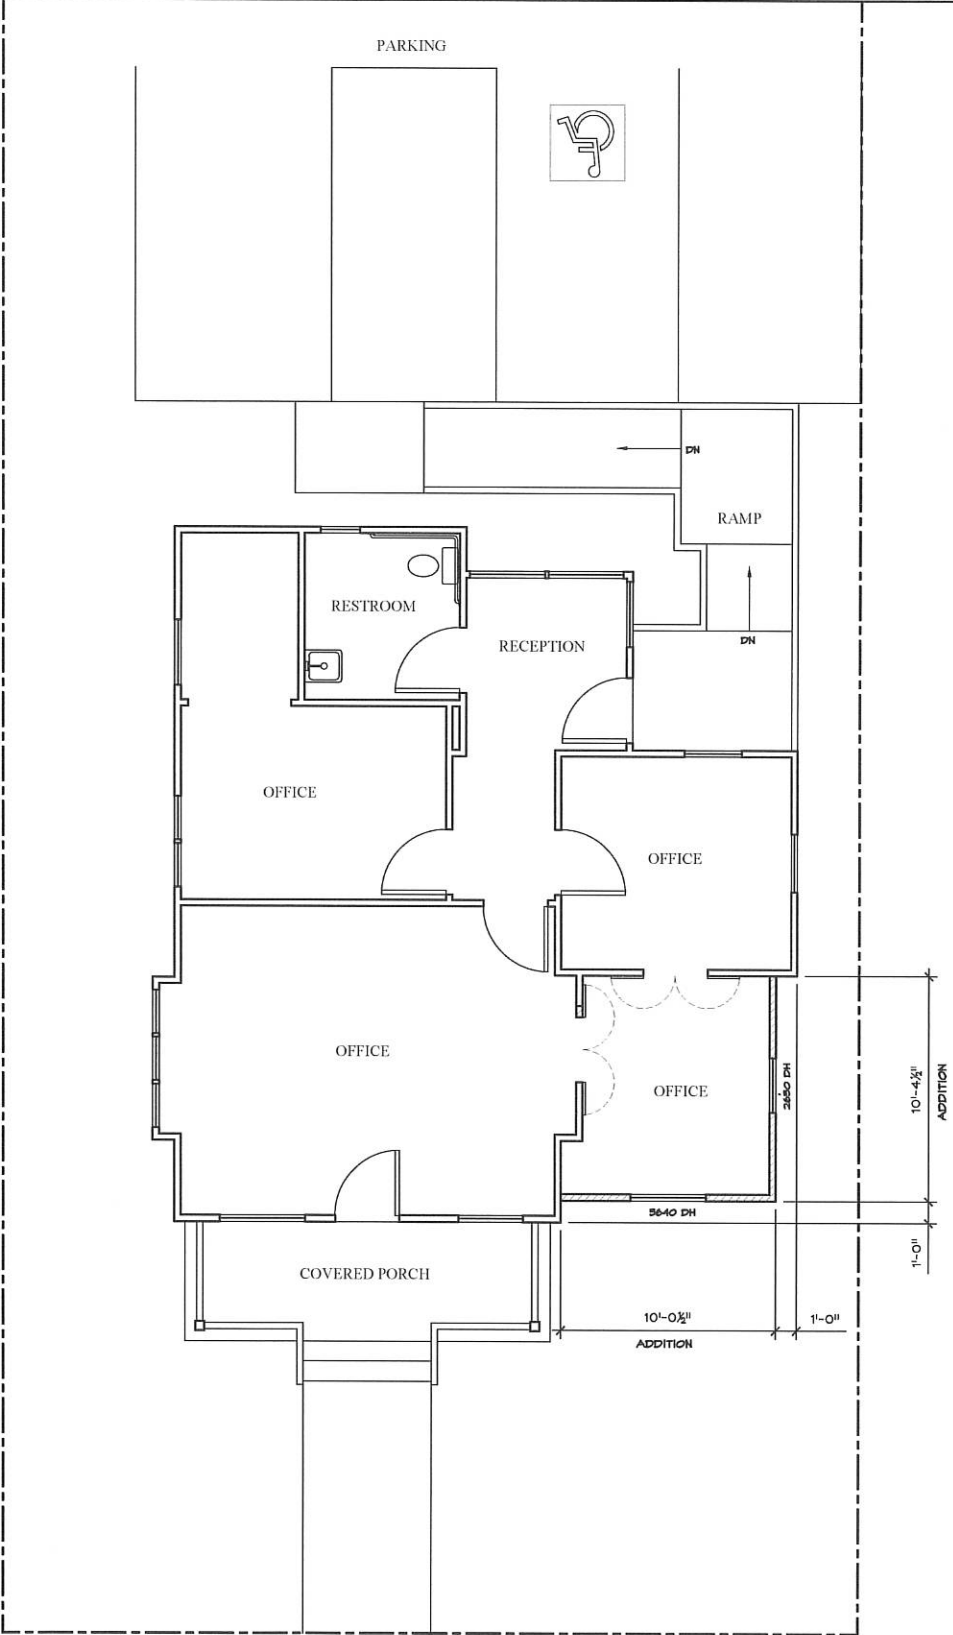

FLOOR PLAN - PROPOSED

BUILDING AREA	
OFFICE (EXISTING)	726 S.F.
OFFICE ADDITION	41 S.F.
TOTAL	828 S.F.
COVERED PORCH	80 S.F.

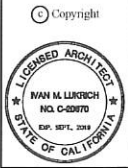

Revisions


IVAN M. LUKRICH
ARCHITECT
P.O. BOX 1642, SANTA ROSA, CA 95402
VOICE 707.573.8291 FAX 707.573.3012

1217 COLLEGE AVENUE
OFFICE ADDITION
APN 180-810-025
1217 COLLEGE AVENUE
SANTA ROSA, CALIFORNIA

FLOOR PLAN
PROPOSED


Job Number	WILLIAMS
Drawn By	IML
Scale	1/4" = 1'-0"
Date	9-27-2017
Sheet Number	

A4
of

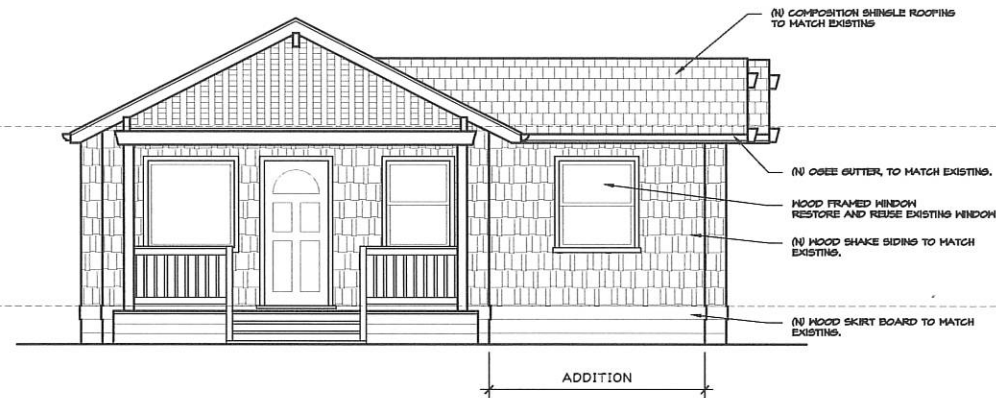

SOUTH ELEVATION

FINISHES
EXTERIOR FINISHES ON THE ADDITION SHALL MATCH EXISTING MATERIALS AND FINISHES

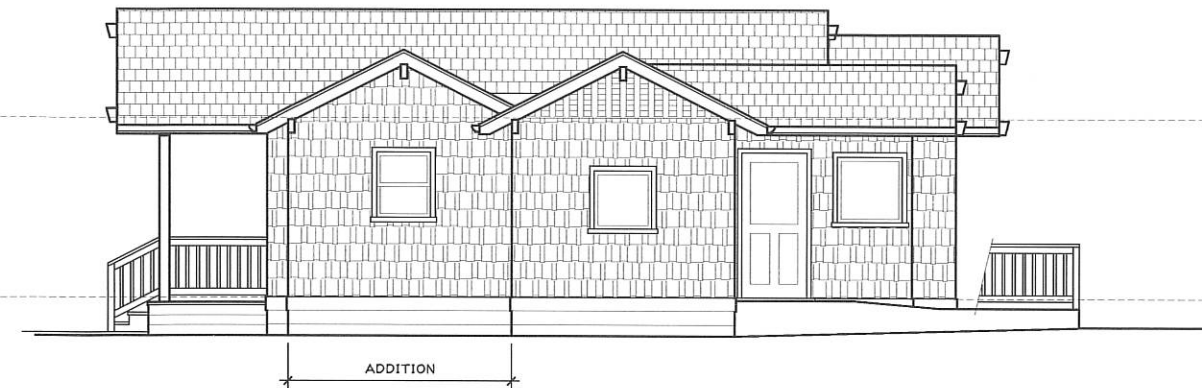

EAST ELEVATION



NORTH ELEVATION



WEST ELEVATION

EXTERIOR ELEVATIONS - PROPOSED

Copyright



Revisions

IVAN M. LUKRICH
ARCHITECT

P.O. BOX 1642, SANTA ROSA, CA 95402
VOICE 707.573.8291 FAX 707.573.3012

1217 COLLEGE AVENUE

OFFICE ADDITION
APN 186-810-025
1217 COLLEGE AVENUE
SANTA ROSA, CALIFORNIA

EXTERIOR ELEVATIONS
PROPOSED

Job Number
WILLIAMS

Drawn By
TML

Scale
1/4" = 1'-0"

Date
9-27-2017

Sheet Number

A5

of