


Attachment 14

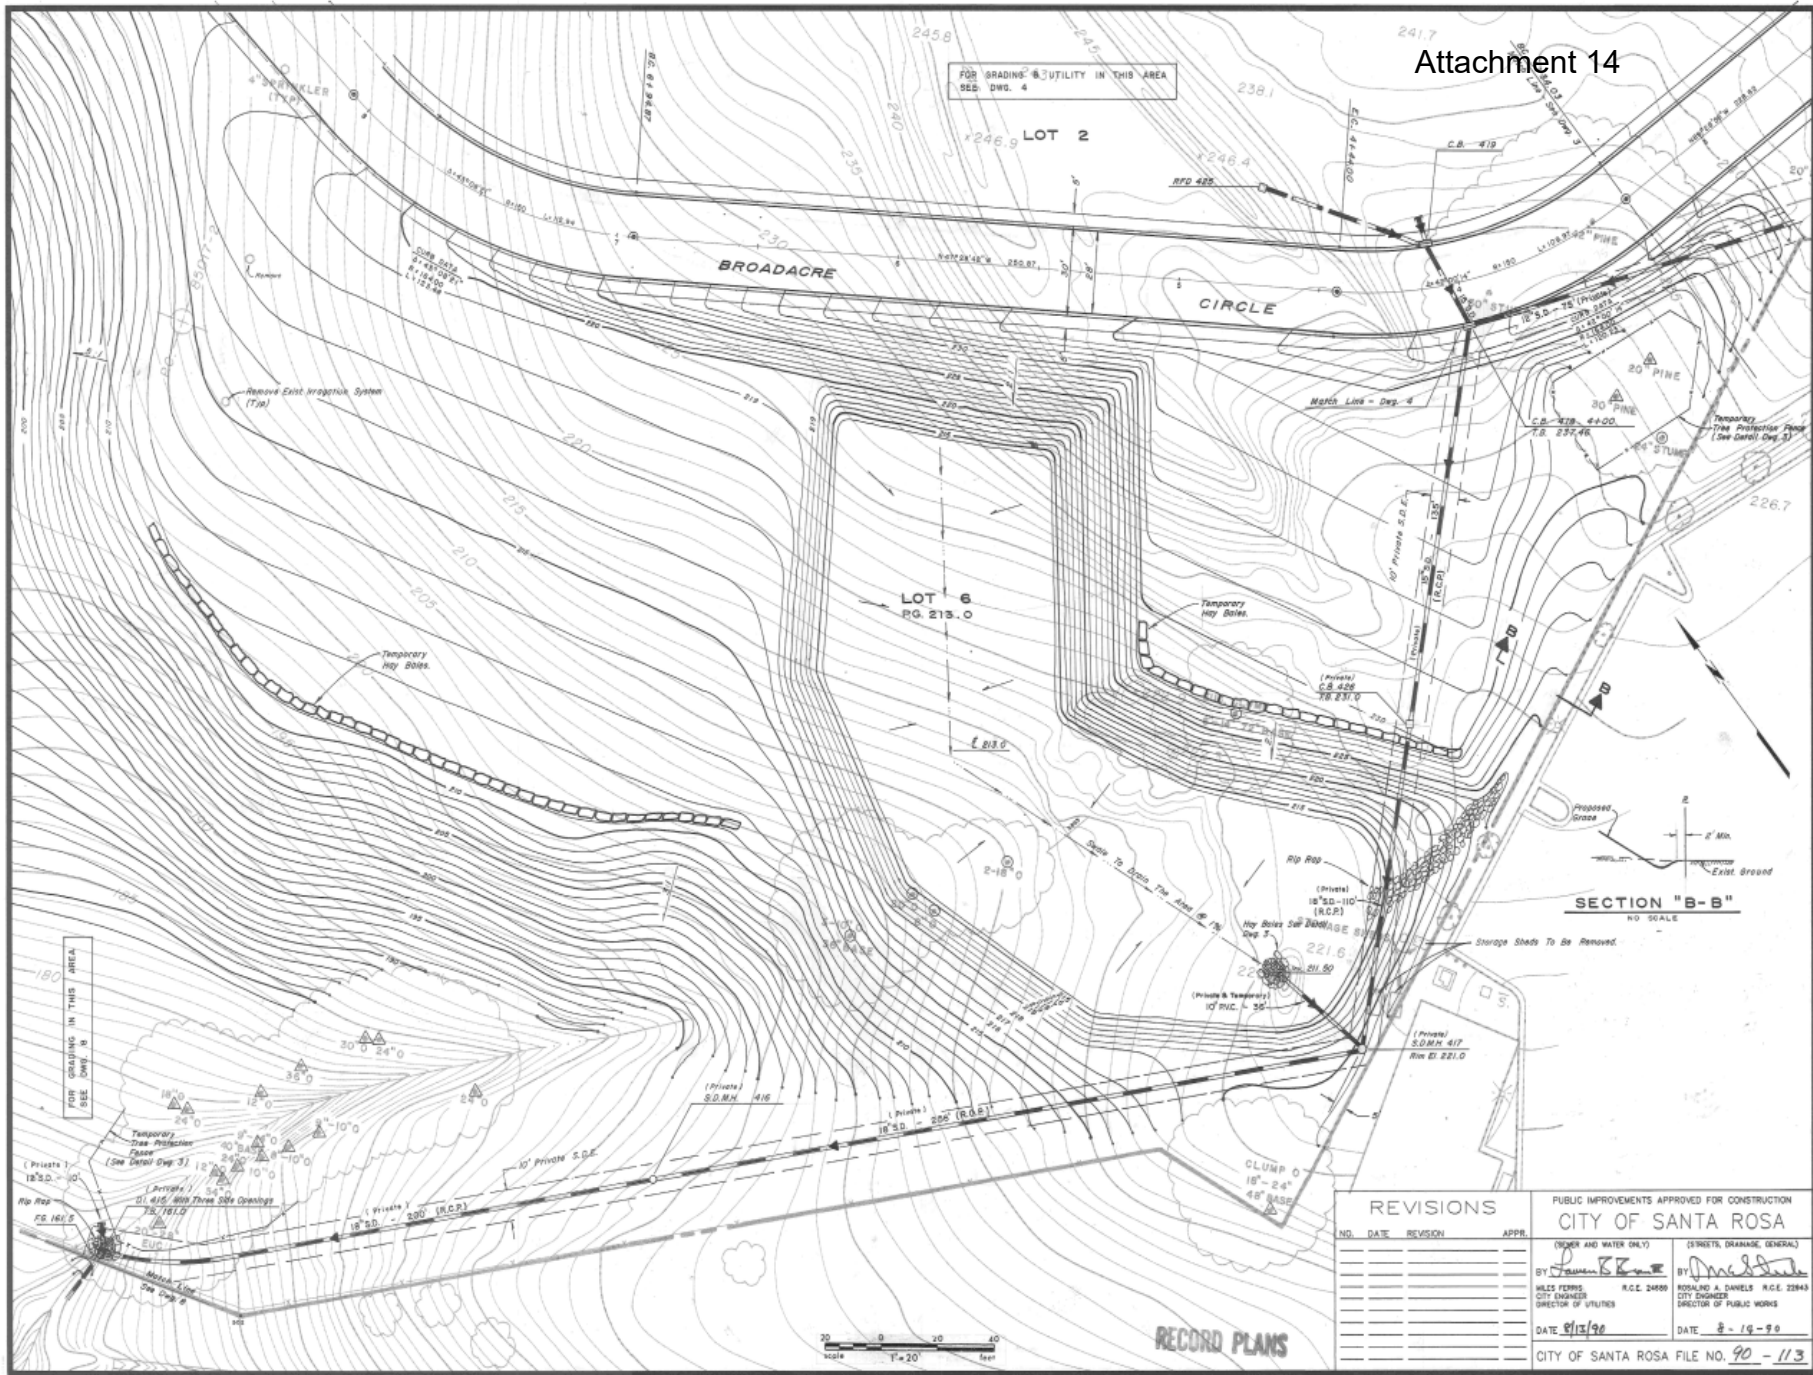

FOR GRADING & UTILITY IN THIS AREA
SEE DWG. 4

FOR GRADING IN THIS AREA
SEE DWG. 13

SECTION "B-B"
NO SCALE

Scale 1" = 20' feet

RECORD PLANS

REVISIONS

NO.	DATE	REVISION	APPR.

PUBLIC IMPROVEMENTS APPROVED FOR CONSTRUCTION CITY OF SANTA ROSA

(SEWER AND WATER ONLY)		(STREETS, DRAINAGE, GENERAL)	
BY: <i>[Signature]</i>	BY: <i>[Signature]</i>	DATE: 9/13/90	DATE: 8-19-90
MILES FERRIS CITY ENGINEER	ROSAURO A. DANIELS DIRECTOR OF PUBLIC WORKS	R.C.E. 24000	R.C.E. 22843
CITY OF SANTA ROSA FILE NO. 90-113			



CARLISLE / ASSOCIATES
CIVIL ENGINEERS • SURVEYORS • LAND PLANNERS
305 WEST COLLEGE AVENUE • SANTA ROSA, CALIFORNIA 95401
TEL: 757-1751



FOUNTAINGROVE EXECUTIVE CENTER
SANTA ROSA, CALIFORNIA
GRADING & UTILITY PLAN

DATE: FEB. 1990
REVISIONS:
DRAWN BY: CHECKED
K.A.M.
JOB NO.: 857-282
DRAWING NUMBER:
7 of 13