



SANITARY SEWER STANDARD SPECIFICATIONS

**Adopted by the Santa Rosa City Council
Resolution No. ~~25372~~
~~September 10, 2002~~**

TABLE OF CONTENTS

1. **Sanitary** Sewer System Design Standards
2. **Sanitary** Sewer System Standard Plans
3. **Sanitary** Sewer System Construction Specifications: ~~Section 71. Sewers~~
Section 130 Sanitary Sewer System
4. Engineer's List of Approved Items **for the Sanitary Sewer System**

SANITARY SEWER SYSTEM DESIGN STANDARDS

Adopted by the Santa Rosa City Council
Resolution No.
Date

TABLE OF CONTENTS

I.	PURPOSE.....	2
II.	REQUIREMENTS FOR IMPROVEMENT PLANS AND SUBDIVISION MAPS	2
I.	SANITARY SEWER MAINS – GENERAL.....	3
II.	CONNECTION TO AN EXISTING PUBLIC SANITARY SEWER MAIN.....	4
III.	MATERIALS.....	5
IV.	ALIGNMENT.....	5
	A. Horizontal.....	5
	B. Vertical.....	6
V.	MAIN SIZING CRITERIA.....	6
VI.	SLOPE OF SANITARY SEWER MAINS.....	7
VII.	MAIN / LATERAL COVER.....	8
VIII.	MANHOLES AND RODDING INLETS.....	8
IX.	SANITARY SEWER LATERALS.....	9
X.	ABANDONMENT OF SANITARY SEWER MAINS AND SERVICES.....	10
XI.	EASEMENTS.....	11
XII.	ACCESS ROADS.....	12
XIII.	SEWER FORCE MAINS.....	12
XIV.	INDUSTRIAL WASTE DISCHARGE PERMITS.....	13
XV.	LIFT STATIONS.....	13
	A. General Requirements.....	13
	B. Pumping Equipment.....	16
	C. Lift Station Piping and Valving.....	18
	D. Electrical Equipment.....	18
	E. Telemetry.....	19
	F. Standby Generator.....	24
	G. Gas Monitoring System.....	26
	H. Details Required on Improvement Plans.....	26
	I. Record Drawings and Manuals.....	27
	Example Single Line Diagram.....	28

APPENDIX “D” – SANITARY SEWER PEAK LOAD FACTORS VS. POPULATION SEWAGE DESIGN FLOW CONTRIBUTIONS.....	29
--	----

SANITARY SEWER SYSTEM

DESIGN STANDARDS

I. PURPOSE:

To provide guidelines for design of sewer utilities projects and thereby reduce the time required for processing the plans. These guidelines do not include, but may reference, additional conditions which may be promulgated by all other pertinent ordinances, codes and official policy set forth by the ~~Utilities~~ Water Department, other departments of the City of Santa Rosa, or other government agencies. These guidelines establish minimum acceptable design criteria. More stringent requirements may be imposed by the Director of Santa Rosa Water ~~of Utilities~~ based on specific project conditions.

Wherever the approval, discretion or opinion of the Water Department Director, or any other City staff, is called for herein, the project applicant shall submit a written request for the same. Variance requests must clearly identify the unusual circumstance that would warrant an exemption or waiver from the standards or specifications. The project applicant shall be responsible for providing any calculations or studies needed to support the proposal and for resolving specific design problems with the appropriate agencies, departments or divisions. Any final decision by City staff may be appealed pursuant to the City Code, but may be first directed to the Board of Public Utilities for a recommendation. ~~It is the responsibility of the design engineer to initiate written requests for approval of any design concepts that differ from these criteria, to verify additional requirements imposed, to perform any necessary calculations or studies, and to resolve specific design problems with the appropriate agency, department, or division.~~

II. REQUIREMENTS FOR IMPROVEMENT PLANS AND SUBDIVISION MAPS

- J. Provide a detailed utility plan showing onsite and offsite sewer systems, and their connections to existing City maintained sewer facilities. Show any septic systems existing or to be abandoned.
- B. For subdivisions, annotate the local agency information sheet of the Subdivision Map with information that is needed to notify property owners of requirements for connection to City Sewer System. These include, but are not limited to:
 - 1. payment of fees prior to issuance of Building Permits;
 - 2. lots requiring installation of sewer backflow protection;
 - 3. private sewage grinder pumps; and
 - 4. public sewer access requirements, such as gates or access roads.

The appropriate information may be obtained from the City's Planning & Economic Development Department. ~~Utilities Engineering~~

- C. It is common for a project on one property to be ~~dependent~~~~dependant~~ on the construction of sewer by another project or phase of the same project. Sewer system designs ~~will~~~~shall~~ incorporate any off-site sewer that is required for the connection to an existing public main.

III. **SANITARY SEWER MAINS – GENERAL**

- A. Sewer systems ~~will~~~~shall~~ be designed in public streets whenever possible. When not in public streets, the following conditions ~~must~~~~shall~~ be met:

1. Ductile iron pipe ~~must~~~~shall~~ be used from manhole to manhole when outside of roadways;~~and~~
2. In general, lateral connections ~~will~~~~shall~~ not be allowed in easements but where necessary ~~must~~~~shall~~ be ~~easy to locate, and accessible to maintenance personnel and equipment; and easy to locate;~~ and
3. Bolt-down lids are required on all manholes located in easements, on school grounds, through parks and on any trunk sewers **24" in diameter and larger.**~~than 12" diameter.~~

- B. Private **sanitary** sewer systems vs. public **sanitary** sewer systems:

In general, public sewer ~~will~~~~shall~~ be used only when they serve multiple lots and suitable access can be provided for maintenance reasons. Private sewer systems ~~will~~~~shall~~ only be used when they serve single lots or when they serve multiple lots and adequate access cannot be provided for public maintenance purposes. (See the City of Santa Rosa Sewer and Water Utility Maintenance Policy adopted by City Council Resolution No. 14853 in Water Design Appendix "B.")

- C. Extent of sewer main improvements ~~will~~~~shall~~ be as follows:

1. Any offsite, downstream sewer system improvements needed to serve the project ~~must~~~~shall~~ be shown on the improvement plans, including upgrades to existing mains that may be required as a result of an approved capacity study or modeling effort.
2. In general, sewer mains ~~must~~~~shall~~ be designed at least across one-half of the property frontage or to the most upstream service connection, whichever is greater; or
3. Where the project is required to provide new street improvements over the sewer alignment and the sewer ~~will~~~~shall~~ serve properties upstream of the project, the sewer main ~~must~~~~shall~~ be designed across the full property frontage or to the limits of the street improvements, whichever is greater.
4. When a sewer main extension ends at a manhole and the sewer ~~will~~~~shall~~ be extended further in the future, include in the design a 3' long stub out of the manhole with a **watertight** plug or cap for future connection.

- D. Streets with both water and sewer mains ~~must~~~~shall~~ be at least 20 feet wide, face-of-curb to face-of-curb; one utility only: at least 16 feet wide; no water or sewer mains in alleys.

IV. CONNECTION TO AN EXISTING PUBLIC **SANITARY** SEWER MAIN.

- A. Connect new mains to existing at existing manholes or by constructing a new manhole over the point of connection.
- B. Where an existing sewer main is to be extended, remove the existing plug, ~~cap~~~~cleanout~~, or ~~rodding inlet~~**mainline cleanout** and install a manhole. The main may be extended without installation of a structure only if it is on the same line and grade, the pipe size and material are the same, and the manhole spacing is adequate.
- C. Elevations of mains connecting to existing sewer mains ~~will~~**shall** be as follows:
 - 1. Side sewer mains connecting to an existing main at an angle of 30 degrees or greater ~~will~~**shall** be at least 0.1' higher than the existing.
 - 2. Connect ~~sewer collector~~ mains so that the crown of the smaller main is no lower than the crown of the larger main.
 - 3. Connections to ~~Trunk-trunk Sewers-sewers~~ ~~will~~**shall** be made so that the invert grade of the new main ~~will~~**shall** be no lower than the crown of the ~~Trunk-trunk Sewersewer~~.
- D. Where laterals are the same size as the main, connection ~~must~~**shall** be made with a manhole. Use a wye for all other lateral connections except as in "G" below.
- E. For lateral connections to existing mains 12" and larger, use taps and saddles per City Standard 513.
- F. Lateral connections to ~~Trunk-trunk Sewers-sewers~~ 15" and larger are **prohibited unless first receiving written approval of the Director of Santa Rosa Water.** ~~generally not allowed except with the specific approval of from the Director of Utilities.~~
- G. Approved alternatives for multiple connections, such as for grouped flag lots or multiple lots off private driveways are:
 - 1. Up to 2 joint trenched sewer laterals may be connected to the main using wyes at least 1' apart. (Taps or saddles where allowed ~~must~~**shall** be a minimum 1' apart **from nearest outside edge of each pipe.**)
 - 2. A private 6" main may be connected to the public main at a manhole and extend to the services onsite. This alternative requires a joint maintenance agreement or homeowner's association.
 - 3. Up to 4 laterals may connect to a junction structure similar to Standard 502.
- H. In most major streets, or where the street surface is less than 5 years old, installation methods other than open cutting may be required. The Encroachment Officer or the City Engineer / Director of Public Works ~~will~~**shall** determine the requirements based on the condition of the existing street.

V. MATERIALS

- A. Sewer service laterals ~~will~~**shall** be **SDR 26** Polyvinyl Chloride (PVC) ~~or , SDR26 or SDR35, or~~ Ductile Iron Pipe (DIP).

- B. Gravity sewer mains up to and including 12" ~~will shall~~ be SDR 26 PVC, ~~SDR26 or SDR35,~~ or epoxy lined DIP.
- C. Materials for pipes larger than 12" ~~will shall~~ be approved by the Director of Santa Rosa Water. ~~of Utilities.~~
- D. Sewer force mains ~~will shall~~ conform to the material requirements for water mains. Ductile iron pipe force mains shall be epoxy lined.
- E. If a gravity sewer main is installed outside of a paved roadway, ductile iron pipe is required.
- F. In general, use the same pipe material from structure to structure.
- G. Use of Asbestos Cement Pipe is not allowed under any circumstances.

VI. ALIGNMENT

A. Horizontal

- 1. Conform to the State of California, ~~Department of Public Health Services (C.D.P.H.), formerly the Department of Health Services (D.H.S.);~~ Water Resources Control Board "Criteria for the Separation of Water and Non-Potable Pipelines ~~Sanitary Sewer.~~" (See Appendix "A" in Water Distribution System Design Standards.)
- 2. Horizontal separation from storm drain or other sewer mains ~~will shall~~ be minimum 5' ~~five feet~~ clear between pipes except at crossings.
- 3. Horizontal separation from other utilities, such as gas, underground electric, underground television cable, etc., ~~will shall~~ be a minimum of 4' ~~four feet~~ clear between the pipes except at crossings.
- 4. In general, design public sewer mains in straight street sections to run parallel to the street centerline. All public mains ~~must shall~~ be a minimum five feet clear from all structures, building overhangs, gutters, property lines or edge of easements and 3 feet clear from all monuments, and/or lips of gutters. The alignment ~~will shall~~ be designed so that any 48" manhole shall be centered a minimum of 3 feet from the lip of gutter and any 60" manhole shall be centered a minimum of 4' from lip of gutter.
- 5. In curved streets, design the sewer alignment generally on one side of the centerline to allow installation of other facilities such as water, storm drains, etc. without using transverse crossings. Provide an alignment such that no part of the sewer main is less than 1 foot from the lip of gutter. Structures ~~must shall~~ be designed in accordance with subsection VI-A(4) above.
- 6. Horizontal curves in gravity sewer mains are not allowed.
- 7. All sewer main trenches that are parallel to and deeper than the footing of any adjacent structure ~~must shall~~ be at least 45 degrees from the footing as required in the Uniform Plumbing Code. Any exceptions ~~require a written approval must shall be approved in writing~~ by the Director of Santa Rosa Water ~~of Utilities~~ and the Director of Building and Code Compliance.

B. Vertical

1. Conform to the State of California; ~~Water Resources Control Board~~ ~~Department of Public Health Services (C.D.P.H.);~~ (SWRCB) "Criteria for the Separation of Water Mains and Non-Potable Pipelines". ~~Sanitary Sewer.~~ (See Appendix "A" in Water Distribution System Design Standards.)
2. Generally, provide a minimum of ~~six inches~~ 6" of vertical separation ~~from between sanitary sewer lines and;~~ storm drains, telephone lines (non-fiber optic) and cable T.V., and 12" vertical separation between sanitary sewer lines and; gas mains, electrical lines and fiber optic cables. ~~or other utilities, such as gas, underground electric, underground television cable, etc.~~ When these minimums cannot be maintained, plans ~~will~~ shall indicate all new and existing utility elevations. When a 6" minimum separation cannot be maintained, installation of felt expansion material or an approved equivalent between facilities ~~is~~ shall be required per City Standard 517. To protect the sewer main from distorting under extreme loads, other measures, such as a concrete cap, ~~encasement~~ controlled density backfill or ductile iron pipe, may be submitted for ~~approval review of by~~ the Director of Santa Rosa Water. ~~of Utilities.~~
3. Vertical curves in gravity sewer mains are not allowed.

VII. MAIN SIZING CRITERIA

- A. Public mains ~~will~~ shall be sized to serve the entire tributary area at buildout densities conforming to the General Plan. Engineers for large developments may be required to provide trunk or collection system calculations or have a wastewater model run performed.
- B. The design flows ~~will~~ shall be based on the following criteria:
 1. Use population densities for various zoning on the chart "Sewage Contribution" in Appendix "D." Average domestic flow ~~will~~ shall be 125 gallons per person per day.
 2. Multiply average flow as determined in VII-B(1) above, by Peak Load Factor from the graph "Sewage Peak Load Factor vs. Population," also in Appendix "D," to obtain the design flow.
 3. Public sewers ~~will~~ shall be designed to carry infiltrated water at the rate of 7% of the design flow in addition to the volumes above.
- C. Design all gravity sewers to achieve a minimum velocity of 2 feet per second (fps) when the pipe is flowing full. Lesser velocities require the approval of the City Engineer. When analyzing the existing or proposed sewer systems, use Manning's Formula to determine the design flow and velocity. Use "n = 0.013".
- D. The minimum size is 8" in diameter.

VIII. SLOPE OF SANITARY SEWER MAINS

- A. The sewer ~~must~~ shall be designed with a slope to be able to serve its entire tributary area. The preferred minimum slope for gravity sewers is 0.005. When conditions require, flatter slopes may be approved in accordance with the following:

The minimum slope for an 8" sewer is 0.0035.
The minimum slope for a 10" sewer is 0.0025.
The minimum slope for a 12" sewer is 0.0020.
The minimum slope for a 15" sewer is 0.0015.

- B. The maximum slope for gravity sewers is 0.15, or 15' per 100'. Considering relevant factors such as steep terrain, steeper sewers may be allowed with the following conditions:
1. Use with restrained joints.
 2. Provide trench dams and drainage measures to prevent a buildup of hydrostatic pressure in trenches.
 3. When a sewer with a slope greater than 0.15 passes through a structure with a horizontal change of direction in excess of 30 degrees, a special design of the base canalization is required to prevent overflows and yet allow for routine maintenance operations.

C. Slope through manholes:

1. When sewers of uniform slope pass through a manhole, the slope ~~will~~ shall be maintained ~~through the manhole and both the incoming and outgoing the~~ invert elevations shall ~~at the center of the manhole will~~ be given.
2. When sewer lines change slope at a manhole, incoming and outgoing invert elevations ~~will~~ shall be given. The slope change shall take place inside the manhole channel in a smooth and gradual and manner. No portion of a manhole channel shall be flat (no measurable slope) unless first approved by the Water Department.
3. Provide sufficient drop through a manhole to compensate for energy loss caused by change of alignment. A minimum drop of 0.1' ~~foot~~ is required for a change of alignment greater than 30 degrees.
4. When pipe sizes change at structures, design the inlet crown at the same elevation or higher ~~least as high~~ as the outlet crown on collector mains, and inlet inverts at the same elevation or higher as the outlet crown on trunk sewer.

IX. MAIN / LATERAL COVER

- A. Cover is the distance from the top of the pipe to final finished grade measured directly over the pipe.
- B. Minimum cover for all sewer mains and laterals ~~will~~ shall be 36". The Director of Santa Rosa Water ~~of Utilities~~ may approve shallower installations but in no case ~~will~~ shall cover be less than 24".
- C. Where cover is less than 36", special construction techniques must be approved such as ~~concrete encasement~~, the use of ductile iron pipe, a concrete cap over the trench, or the use of controlled density backfill.

X. MANHOLES AND ~~RODDING INLETS~~ MAINLINE CLEANOUTS

- A. A manhole is required at every horizontal ~~or~~ vertical change in alignment.
- B. Maximum distance between manholes is 300 feet.
- C. A manhole is required at the end of every main in excess of 200 feet in length.
- D. ~~Rodding Inlets~~ Mainline Cleanouts may be installed in lieu of manholes at the end of a sewer main where the distance is less than 200 feet to the nearest manhole and the main size is 10" or less.
- E. 60" diameter manholes are required for mains 18" or larger in diameter.
- F. The manhole ~~will~~ shall be designed such that the angle in the horizontal plain between the downstream and any incoming sewer is a minimum of 90 degrees.
- G. Stubs provided out of manholes for future extension ~~will~~ shall have ~~rodding inlets~~ a mainline cleanout provided when more than one length of pipe is installed or where service laterals are connected to the stub.
- H. Private sewer mains ~~must~~ shall connect to the public main at a manhole.
- I. Standard drop manhole installations are required when the difference in elevation between the incoming and outgoing sewer is greater than 2 feet. While not encouraged, drop manholes may be required because of some physical restraints. They may not however, be used to merely avoid extra depth of trenching unless unusual circumstances exist. Upstream slope changes should be used to avoid the need for a drop manhole. ~~Drops installed outside of manholes shall not be allowed.~~
- J. Drops installed outside of manholes are not allowed.
- K. When one drop connection is required, use a 60" diameter manhole. When two or more drop connections are required, use a 72" diameter manhole.
- L. Minimize the number of drop manholes.

XI. SEWER LATERALS

- A. Provide a separate lateral for each lot.
- ~~A.B.~~ Two way cleanouts shall be installed on all service laterals per Standard 513A unless otherwise specified or unable due to field conditions and Standard's requirements.
- ~~B.C.~~ The minimum sewer lateral size is 4".
- ~~C.D.~~ Sewer laterals ~~will~~ shall be sized as determined by the Design Engineer, in accordance ~~ing~~ ~~to~~ with the requirements of the Uniform Plumbing Code (UPC), any amendments in California Plumbing Code (CPC) and these Standards, and per final approval from the Engineer. ~~, the City Engineer and determinations by the Design Engineer.~~
- ~~D.E.~~ Sewer laterals ~~will~~ shall be located on the property frontage, defined as either the front or side boundary line of a parcel which abuts on a street.

- ~~E.F.~~ Laterals ~~will~~ **shall** not be located in easements when gravity service can be provided to the property frontage.
- ~~F.G.~~ When reasonable public vehicular access cannot be achieved, multiple lots may be served by a private main, providing approval by the Chief Building Official is received and appropriate maintenance agreements are approved by the **City of Santa Rosa Planning & Economic Development** Department. ~~of Community Development~~
- ~~G.H.~~ The minimum slope of sewer laterals ~~is~~ **shall be** 2% or ~~1/4"~~ **1/4"** per foot for 4" laterals and 1% or 1/8" per foot for 6" laterals; unless otherwise approved by the Building Department, and ~~will~~ **shall** be designed at a depth sufficient to serve the entire building envelope of the parcel. **Any Building Department approved slope, along with related depths, that vary from those specified shall be shown on the plans. Provide the slope and / or depth different from the minimums shown on the City Standard Plans.**
- ~~H.I.~~ All sewer laterals, from property line or edge of easement to the point of connection with the main line or a manhole, ~~will~~ **shall** ~~generally~~ be perpendicular to the curb alignment or easement ~~unless otherwise approved. At no time~~ **and will** ~~shall any sewer lateral~~ have an angle of intersection with the downstream section of sewer ~~of no~~ less than 90 degrees. No lateral alignments adverse to the flow of the main ~~will~~ **shall** be permitted.
- ~~I.J.~~ Locate sewer laterals outside of driveway area where possible and where driveway locations are known. In general, sewer laterals ~~will~~ **shall** be in the center third of lots when driveway locations are unknown and a minimum of 10 feet from trees whenever possible. For hillside development, place sewer laterals on the low side of property frontage when not in proposed driveway.
- ~~J.K.~~ Sewer laterals serving lots or buildings with plumbing fixtures below the nearest upstream sewer manhole rim require ~~and~~ approved backflow overflow device.

XII. ABANDONMENT OF SEWER MAINS AND SERVICES:

- A. Any existing sewer mains and service laterals that will not be used ~~will~~ **shall** be abandoned and the following ~~must~~ **shall** be noted on the Improvement Plans:
1. Sewer mains that are to be abandoned ~~will~~ **shall be** **done per Standard 507. securely closed at all pipe ends with a cap or at manholes with a concrete plug. Further, mains 12" and larger must** ~~shall be filled with a sand slurry or other suitable material per current City Standards.~~
 2. Sewer laterals in streets that have been constructed or overlaid within the last ~~five~~ **(5)** years ~~will~~ **shall be** ~~plugged~~ **abandoned per Standard 507** behind the curb line or outside the edge of pavement **and any cleanout removed.**
 3. Sewer laterals in streets that have not been constructed or overlain in the last ~~five~~ **(5)** years ~~will~~ **shall be** abandoned by excavating at the main, removing the wye, and repairing the main **with a minimum 4' section of approved pipe and approved couplers** per current **City of Santa Rosa Sanitary Sewer Construction Specifications.** If the connection to the main is a tap or saddle, it ~~will~~ **shall be** removed and a full circle repair clamp installed. When a wye is removed that is within 18" of a pipe joint, the repair ~~will~~ **shall be** extended to include the joint. **All pipe ends shall be abandoned per Standard 507 and any existing cleanout removed.**

XIII. EASEMENTS

- A. An easement ~~must~~shall be provided, in favor of the City, over any public sanitary sewer when it is installed outside a public right-of-way.
- B. The easement ~~must~~shall be a minimum of 15' wide if it only contains a sewer main or 20' wide (or wider) if it contains another facility, such as water, storm drain, or other utility. The easement ~~will~~shall be dedicated as a "public sewer easement" if it contains sewer only. ~~It will shall be dedicated as a "public sewer easement" if it contains sewer only.~~ It ~~will~~shall be dedicated as a "public utilities easement" if it contains other facilities as well.
- C. Easements ~~must~~shall- be configured to encompass all publicly-maintained appurtenances, such as service laterals up to the cleanout, and ~~will~~shall be generally centered over the facility. Separate access easements may be required depending on site conditions. When sanitary sewers are to be installed along a property line the easement ~~will~~shall be wholly contained on one parcel.
- D. All property restrictions placed as a result of dedication of easements ~~will~~shall be so noted on the supplemental sheet of the Subdivision Map, or on the Easement Deed if the easement is not dedicated as part of a subdivision. Typical required notes as applicable are:
 - 1. No structures may encroach on, above, or below the surface of the ground in any public easement. This includes footings of foundations, eaves from the roof of any adjacent structure, pools, ponds or outbuildings on slabs or foundations. Decks, sheds, or other structures which may be easily removed for maintenance of the sewer system may be allowed at the discretion of the Director of Santa Rosa Water. ~~of Utilities.~~
 - 2. No trees may be planted in a public sewer easement without first obtaining approval of the Director of Santa Rosa Water ~~of Utilities.~~ Trees may be allowed to the extent that damage to the sewer system does not occur from root intrusion and adequate access can be provided for maintenance and repair vehicles.
 - 3. The ~~Utilities~~Water Department ~~will~~shall take due caution when performing maintenance or repair of sewer systems in easements, but ~~will~~shall not be responsible for repairs or replacement of trees, landscaping or structures not specifically approved by the Director of Santa Rosa Water. ~~of Utilities.~~

XIV. ACCESS ROADS

- A. Clear access ~~must~~shall be provided and maintained to all structures on the sewer system:
 - 1. All-weather vehicle access roads are required to every structure on the sewer system. Access roads ~~must~~shall be a minimum of 12' in width and ~~must~~shall be provided with turnarounds per City Standard 206 when the back-up distance for any maintenance vehicle exceeds 100'.
 - 2. The design of access roads ~~must~~shall be included with the sewer system design plans. At a minimum, the design ~~will~~shall conform to the requirements of Standard 216. Include adequate drainage measures in the design to prevent damage to the access roads from storm water.

3. Gates ~~must~~shall be provided for access through any fence crossing a public sewer easement. Where vehicular access is required for maintenance, minimum 14' wide gates ~~must~~shall be provided with sliding gates preferred. Where vehicular access is not required, 4' wide gates for pedestrian access ~~must~~shall be provided and ~~will~~shall be located to permit visual access between sewer structures.
4. The maximum grade allowed at any point on an access road is 15%. The maximum cross-slope for any access road is 5%.

XV. SEWER FORCE MAINS

- A. Locator boxes ~~will~~shall be placed at every horizontal change in alignment or a maximum of every 500'. ~~Tracer wire No. 12 insulated solid copper wire will~~shall be laid on top of and along the entire length of all ~~nonmetallic~~ pipe and ~~will~~shall be extended to the surface at all box locations and manholes sufficiently for locator equipment to be attached. Fasten the wire to the top of the pipe so as not to be displaced or broken during backfilling, such as by affixing the wire to the pipe with duct tape at approximately 10 feet intervals. ~~Tracer wire shall be 12 AWG solid copper wire with a green type UF 60 mil insulation that is designed for use in the detection of underground utilities. Where splicing is required only watertight connectors shall be used, and shall be either Copperhead Sharkbite, 3M DBR, or an approved equivalent. (See Water System Construction Standard Specifications Section 99-1.1312 and Standard 877)~~
- B. Boxes ~~will~~shall conform to valve box requirements per Standard 877 with the lids clearly marked "sewer".
- C. Private force mains ~~must~~shall connect to the City sewer system per Standard 515, and may not discharge directly into sewer manholes. Public force main connections ~~must~~shall be detailed on the plans, but also may not discharge directly into sewer manholes.
- D. Provide details for a swab launching station for force main preventative maintenance. Launching facility ~~will~~shall be detailed on lift station plans and ~~must~~shall accommodate ~~the use of using~~ lift station pumps for propulsion. Provide necessary valving. ~~All swab launching station designs must be reviewed and approved by the Water Department Director or their designee. Contact Utilities Engineering staff for suggested design details.~~

XVI. INDUSTRIAL WASTE DISCHARGE PERMITS

- A. Most commercial uses require Industrial Waste Discharge Permits which may be obtained from the Environmental Services Division of the ~~Utilities~~Water Department.
- B. Grease traps, grease and sand traps, grease interceptors, and sampling structures as may be required by the Division of Environmental Services ~~must~~shall be shown on the plans submitted for permit approval, or referred to appropriate City Standard Plans.
- C. Trash enclosures and other outdoor pad areas used for washing ~~will~~shall be plumbed to the sanitary sewer system at grease interceptor or other connection point approved by Environmental Services. Preventive measures ~~will~~shall be taken to eliminate the intrusion of any rainwater or surface runoff.

- D. Wash pad areas ~~will~~shall be diked and /or sloped so that the smallest area possible drains to the sewer.
- E. A fixed roof ~~will~~shall be installed over the wash area. ~~The City's Environmental Compliance Section~~ ~~Environmental Services~~ may consider alternatives to a roof where it is not feasible.

XVII. LIFT STATIONS

A. General Requirements

1. Lift stations ~~will~~shall not be allowed where an acceptable alternative gravity route exists.
2. Design the lift station to serve the entire tributary at build-out densities conforming to the General Plan, and in accordance with City peaking standards and I / I allowances.
3. Lift stations may be submersible pumping stations, package wet well / dry well stations or site designed vertical, dry pit, non-clogging, centrifugal pumping stations, depending on station size, head requirements and motor horsepower.
4. Interior surfaces of wet well shall have an approved epoxy coating, or other material, to protect against inflow and infiltration and corrosion. Coating thicknesses shall be per manufacturer's recommendations.

Table 1, below, outlines the allowable design criteria for each type of pump station, listed in order of preference:

TABLE 1
PUMPING STATION DESIGN CRITERIA

Station Type	Influent Flow Range (gpm)	Maximum TDH*	Maximum Motor
Packaged wet well / dry well	Up to 3000 gpm	Up to 45 feet	100 HP @ 1450 rpm
Vertical centrifugal	No restrictions	No restrictions	No restrictions
Submersible	Up to 2000 gpm	Up to 160 feet	100 HP @ 1800 rpm

* TDH = Total Dynamic Head. Submittal of calculations required.

4. Tandem pumping may be allowed where low flow, high TDH conditions exist, with expressed written permission from the Director of Santa Rosa Water ~~of~~ Utilities.

5. All pumps, regardless of station type, ~~will~~shall be non-clogging, capable of passing a minimum 3" diameter sphere. All pumps, regardless of station type, ~~will~~shall be single speed.
6. Lift stations are not allowed within the street right-of-way.
7. Provide a 12-foot paved access road with a 14-foot wide rolling gate preferred where possible, to allow service vehicles to be parked off the street and clear of the sidewalks. Turnarounds are required for stations constructed along heavily traveled streets. Provide service vehicle access to wet well.
8. Provide a reinforced concrete base slab sized adequately to counteract buoyancy. Provide supporting design calculations.
9. Provide a single surface pad over site that incorporates lift station access, wet well / dry well access and supporting generator and fuel supply tanks, as necessary.
10. Provide restrained flexible couplings on all outlet piping within 2 feet of the station wall.
11. Provide reinforced concrete supports for pipes between wet well and dry well, where appropriate.
12. Wet well to be ~~circular, with~~and a minimum 72" in diameter with 4-hour capacity or as necessary to accommodate pumping equipment for submersible stations. For all other station designs wet well size ~~will~~shall be based on good sanitary engineering practices. Provide resilient-seat gate valve on-line into wet well.
13. Provide 6" ~~PVC-epoxy lined ductile iron pipe~~ emergency by-pass system consisting of a suction line and a discharge line and a standpipe equipped with a cap and cam-lock connector. Bypass ~~will~~shall be located in a vault. Standpipe connects to force main through an AWWA resilient seat gate valve with stainless steel trim and check valve. The suction and discharge lines ~~will~~shall have gate valves for isolation. Adequately support all piping.
14. Provide 1-inch minimum water service with reduced pressure backflow preventor and piping insulation.
15. Provide re-keyable Almont locks for all padlock applications.
16. Provide Simplex keyless push button access control systems for all buildings.
17. Provide fall protection device for ladders that include winch and center post. Winch ~~will~~shall be Miller M 52-50SS or approved equal. Center post ~~will~~shall be Uni-Hoist Arm #UH 504-24 with top and back rollers or approved equal. Provide non-skid surface on ladder.
18. Provide a spare pump and air release valve prior to acceptance.
19. Provide calculations to determine the need for hydrogen sulfide suppression in force main.
20. ~~Station piping, equipment and appurtenances will~~shall be painted in accordance with City of Santa Rosa Utilities Department standard colors as set forth in Table 2, below:

TABLE 2-(OMIT)
CITY OF SANT ROSA

PUMPING STATION COLOR CODES

TYPES OF EQUIPMENT, PIPING VALVES,		COLOR
1.	Pump suction	Blue
2.	Pump discharge isolation valve	Red
3.	Pump discharge check valve	Orange
4.	Force main isolation valve	White
5.	Emergency pump isolation valve	Yellow
6.	Emergency pump check valve	Brown
7.	Sump pump isolation valve	Black
8.	Sump pump check valve	Orange
9.	Mechanical seal pressure valve	Pink
10.	Chemical isolation valve / piping	Purple
11.	All electric motors	Blue
12.	All sewer pumps and pipes	Green
13.	All compressed air system	Per City
14.	Standby generator	Per City

B. Wet Well Lid and Hatch

1. The Contractor shall provide all the necessary materials, equipment, parts and labor required to design and install the concrete wet well lid. The Contractor shall provide to the Engineer structural calculations stamped, sealed and signed by a Structural engineer licensed in the State of California for the wet well lid which shall indicate that it is capable of supporting all real and potential loads it may encounter. These loads include, but are not limited to traffic loading, the wet well access cover, concrete and backfill material.
2. The wet well lid shall be rated for AASHTO H20-44 direct traffic loading.
3. The concrete used in construction of the wet well lid shall be ~~be Class A~~ Portland cement concrete conforming to the acceptable standards of Section 90 of the City of Santa Rosa Standard Specifications.
4. The lid shall be poured in a single pour
5. The circumference of the lid shall be notched to fit the barrel of the wet well.
6. The wet well lid shall not be constructed or delivered to the project until the design submittal has been accepted.
7. The wet well shall be provided with an aluminum access hatch with safety grating, H-20(incidental Traffic) load rating, with a free inside opening of 4' x 6' (four feet by six feet clear opening with top covers opened).
8. Access hatch frame shall be cast into and supported by the concrete as required by the hatch cover manufacturer
9. The access hatch shall be equipped with hold open arm, recessed lift handles, recessed slamlock, lift spring on safety grates, stainless steel slam lock, stainless steel hardware, recessed padlock clip, black paint on exterior of frame, 1/4" diamond plate.
10. The manufacturer shall provide structural calculations showing that the cover hatch design meets the loading requirements of AASHTO H20.

11. The access hatch shall be designed to combine covering the opening, fall through protection per OSHA Standard 1910.23 and controlled confined space entry per OSHA Standard 1910.46.
12. The safety grate shall be made of 6061-T6 aluminum and designed per the "Specifications for Aluminum Structures" by the Aluminum Association, Inc 5th Edition, Dec 1986 for Bridge Type Structures.
13. Each door and grate shall be provided with 316 stainless steel hold open arm which shall lock the door or grate in the 90-degree position opened. Design shall assure that the safety grating is in place before the doors can be closed.
14. The grating shall be designed to withstand a minimum live load of 300 pounds per square foot. Deflection shall not exceed 1/150th of the span.
15. Grate openings shall allow for visual inspection, limited maintenance and adjustments while the safety grate fall through protection is left in place.
16. Each aluminum safety grate shall be epoxy coated with a safety orange color.
17. Install shall be in accordance with ANSI/AWS D1.2-90 Structural Welding Code for Aluminum
18. Access cover shall be "Safe Hatch" FLED-17HDAOSHRPC, as manufactured by Flygt Corporation.

BC. Pumping Equipment

1. Provide a minimum of two pumps and controls to alternate lead and lag pumping. Where required by Director of Santa Rosa Water of Utilities, 3 or more pumps may be required in a lead, lag, standby arrangement.
2. For each type of pump, provide one spare rotating mechanism to replace each pump type.
3. Provide one set of routine service replacement parts such as wear rings, bearings, and seals for the pumps.
4. Provide calculations used to determine the capacity of the wet well and the specifications for the pump.
5. Provide hour meters for each pump that records pump run time, only if the motor is operating.
6. Provide a magnetic flow meter on the discharge of the pump station. Meters may be in an approved vault. Display ~~will~~shall be installed in pump station.
7. Packaged wet well / dry well stations
 - a. Above ground lift station is preferred.
 - b. Lift station standard is 7' – 6" diameter, Fiberglass Reinforced Plastic underground lift station by Gorman-Rupp with above ground controls and underground pump shut-offs.
 - c. All pumps, motors, internal valves and piping, level indicators, control switches, ladder, alarms, blower and dehumidifier ~~will~~shall be

manufactured and assembled as a package. Supply and warranty ~~will~~shall be through one company.

- d. The pumps ~~will~~shall be self-priming, horizontal, centrifugal, sewage pumps. Pumps ~~will~~shall pass a maximum solid, 3" diameter sphere.
- e. All motors ~~will~~shall be totally enclosed, fan cooled, premium efficiency.

3. Vertical centrifugal stations

- a. The lift station ~~will~~shall employ vertical, dry pit, single stage non-clogging centrifugal sewage pumps.
- b. Pumps with mechanical grease seals ~~will~~shall be provided with a grease reservoir.
- c. All motors ~~will~~shall be totally enclosed, fan cooled, premium efficiency.
- d. Pumps ~~will~~shall include an individual air bleed system from each pump to the wet well.
- e. Seal water piping systems, where necessary, ~~will~~shall be schedule 80 PVC or Type "K" copper. Seal water systems ~~will~~shall be designed with drains.
- f. Design of lift station enclosure for vertical centrifugal stations ~~will~~shall be coordinated with the City Building and Fire Departments with respect to occupancy class and electrical and HVAC system design.

9. Submersible pumping stations

- a. The lift station ~~will~~shall consist of a minimum of two submersible centrifugal sewage pumps, guide rails, wet well access, discharge seal and elbow, motor control center, starters, liquid level control system and all hardware necessary to make a complete working system. Supply and warranty ~~will~~shall be through a single company. Standards are ITT Flygt, Gorman Rupp Company or equal.
- b. The pumps ~~will~~shall be electric, submersible, centrifugal non-clogging units capable of passing a 3-inch sphere. Pump and motor ~~will~~shall be suitable for continuous operation at full name plate load while the motor is completely submerged, partially submerged or totally non-submerged. All electrical equipment / panels ~~will~~shall be above ground.
- c. Each pump ~~will~~shall be furnished with a discharge connection system, which ~~will~~shall permit removal and installation of pump without the need for the operator to enter the wet well.
- d. All hardware in wet well, chains, cables and slide rails ~~will~~shall be 316 stainless steel.

ED. Lift station piping and valving

- 1. When not included with package stations, all internal main lift station piping ~~will~~shall be flanged, except as discussed in No. 2.

2. All main lift station pipes ~~will~~**shall** have flexible connections (Victaulic or Dresser) to allow for disassembly.
3. All main piping ~~will~~**shall** have manual vents and drains to allow draining of sewage prior to piping disassembly.
4. Resilient seat gate valves in manholes ~~will~~**shall** be used for station wet-well isolation.
5. Cast iron, non lubricated eccentric plug valves with worm gear operators ~~will~~**shall** be used for pump isolation valves. Valves ~~will~~**shall** have stainless steel bearing, nickel seats, neoprene faced plugs and nitrile-butadiene packing. For package wet well / dry well stations, if space does not permit isolation valves for each pump use 3-way valves.
6. Main Pump Check Valves ~~will~~**shall** be ~~cast iron swing checks with external lever return~~**Swing Flex Check Valves**. Check valve ~~will~~**shall** not be installed in the vertical. ~~Disc will shall be 316 stainless steel or cast iron with bronze trim. Pivot arm and bearing will shall be 316 stainless steel or cast iron with bronze trim. Pivot arm and bearing will shall be 316 stainless steel or bronze. Seat will shall be field replaceable with neoprene facing.~~

DE. Electrical Equipment

1. Free standing electrical service and transfer switch ~~will~~**shall** be heavy duty electrical weatherproof enclosure securely mounted, ~~per approved submittal~~, in a manor acceptable to the Director ~~of Santa Rosa Water. of Utilities~~, Enclosure shall ~~be mounted~~ a minimum of 24" above the ground ~~or per an approved pedestal design~~. Provide a concrete pad around steel supports. Enclosure and equipment to be provided by Tesco, ~~Challenger~~, Cutler-Hammer, or Square D. Provide 110-volt duplex, GFI, receptacle in a weatherproof box. The ~~box enclosure shall be constructed of stainless steel or hot dipped galvanized sheet metal, and will shall have 316 stainless steel hinges and hardware, and will shall have a be factory applied powder coated finish in a color approved by the Water Department. primed and field painted per City requirements. Enclosures to be epoxy coated.~~ Where a Water Department approved color cannot be obtained, the powder coated enclosure shall be installed as required and then, by a licensed coater, properly prepared and spray coated in a manner and with a material that is approved by the Water Department.
2. Provide Killark connector for mobile generator with manual transfer switch. Generator plug ~~will~~**shall** be a minimum of 36-inches above ground. See attached single-line diagram for wiring manual transfer switch.
3. If the lift station dry well is a confined space, provide explosion proof dry well lighting adequate to illuminate the ladder and the floor of the dry well.
4. Provide an exterior light in accordance with STD #601. Provide 12-inch diameter pole-mounted luminaires at 120V, ~~50W LED with Bi-Level option. 70W HPS.~~
5. Provide OSHA approved rubber mat in front of all indoor control panels.
6. ~~Provide ability to operate station with one pump removed for maintenance, by utilizing a local remote switch and no parallel switching in order to allow for proper lockout procedures. Provide local disconnect at motor per NEC.~~

- 7.6. Provide waterproof local control in dry well to operate pumps for testing. i.e. Auto/Manual selector switch, spring return to "Auto".
- 8.7. Provide 25% additional spare wires and 2" conduits or oversize conduits to meet ultimate station capacity. Label all wires, both end's with heat shrink labels.
- 9.8. ~~Drives willshall be Allen Bradley or approved equal and provided with solid state smart type motor starters with a pump control option used to provide ramp starting and stopping of motors. The controller willshall have the following start modes: soft start with selectable kickstarts, current limit and full voltage. – Reduced Voltage Soft Starter (RVSS) shall be Allen Bradley SMC-Flex with built in by-pass.~~

EF. Telemetry

1. Control Panels

All control panels ~~will~~shall have the following general features.

- a. Panels and enclosures ~~will~~shall have NEMA ratings as shown on the drawings.

In general, the NEMA ~~3R/12~~ ratings ~~will~~shall be:

- 1) NEMA ~~3R/12-316-SS~~ for outside installations ~~with custom gasketed doors, and sun/rain shield. Include sun shield.~~
- 2) NEMA 12 for protected installations inside buildings.

- b. Panel design ~~will~~shall incorporate the following features:

- 1) Provide a lamp with ~~door~~ switch.
- 2) Provide a 120 VAC ~~GFI protected~~ duplex convenience outlet.
- 3) Provide heating and cooling, ~~in each outdoor cabinet section~~, to maintain internal components within operating tolerances and to avoid condensation.
- 4) Provide 120 VAC uninterruptible power supply (UPS) or an equivalent DC voltage subsystem sized for 150% of peak load for all internal panel components for a minimum of ~~30 minutes~~ 8 hours run time.
- 5) Provide radio communications system compatible with CITY'S current SCADA system. See City personnel for specific frequency and any changes.
- 6) Provide a high temperature switch (alarm) for the control panel.
- 7) Provide an automatic alarm dialer to annunciate critical alarms. (per Water Department approval)

2. Programmable Logic Controller (PLC)

PLC and related components subject to review and approval by the Water Department.

Provide Allen-Bradley CompactLogix 5370 or Tesco L3000a PLC, ~~programmable logic controller~~ or approved equivalent, to perform monitoring and control of the facility. Provide ~~a large or small~~ PLC as shown on the Drawings and/or as specified in the Contract Documents.

a. ~~For small PLC applications, provide one of the following:~~

- ~~1) Modicon Micro CPU 12,~~
- ~~2) Allen Bradley MicroLogix 1500,~~
- ~~3) Siemens S5-95U, or~~
- ~~4) Tesco L2000~~

b. ~~For large PLC applications, provide one of the following:~~

- ~~1) Modicon Quantum,~~
- ~~2) Allen Bradley ControlLogix,~~
- ~~3) Siemens S7, or~~
- ~~4) Tesco Liquitronix 5/30~~

~~All PLC's will~~shall utilize the following features: Product Description;

1. The PLC shall be intelligent, modular unit, capable of both data acquisition and local data processing.
2. It shall be capable of monitoring and controlling local equipment in stand-alone mode, as well as being an intelligent node in a distributed system.
3. It shall be suitable for installation in outdoor environments. Programs shall be capable of being downloaded either directly to the unit using RS-232 interface cable, remotely through the communication network.
4. The operator inter face shall be a sealed membrane keypad suitable for corrosive atmospheres with eight character alpha-numeric display

c. All PLC's shall utilize the following features

- 1) All analog inputs ~~will~~shall be isolated with 4-20 mA current signal isolators.

- 2) All analog outputs ~~will~~shall be isolated with 4-20 mA current signal isolators.
- 3) Provide two serial communication interfaces running MODBUS RTU mode.
- 4) Provide an operator interface panel.
- 5) Provide input and output points as defined in the specifications and drawings.
- 6) Provide 20% spare analog and digital I/O's.
- 7) Provide Heartbeat Alarm to external dry contacts for PLC failure alarm.

4. ~~3.~~ 150MHz Radio Subsystem

- a. Provide radio system components at Lift Station, including radio, antenna, antenna mast, antenna cable, system grounding, lightening protection and physical connections for a complete operating system.

- 1) Provide a 150MHz band radio for PLC. Select specific frequencies to match the City's existing radio system.
- 2) The radio shall be the Dataradio Integra-TR 242-4018-551 wireless data modem.
- 3) Provide antenna appropriate to site:
 - a) Yagi antenna with 9db gain. Antenna shall be cut at the factory for the assigned frequencies. KATHREIN SCALA YA7-155 150-164Mhz or _____equal.
~~_____Low profile transit style antenna. Field tunable, 150-168MHz, _____unity gain. Antenex TRAT1500 or equal.~~
- 4) Antenna Mast: Polyester powder-coated steel or anodized aluminum _____with 2 - 3/8" diameter tenon, rated for 80 MPH wind, Valmont _____DS2000 or equal with weatherhead on top of tenon.
- 5) Antenna cable: 1/2" foam filled 50-ohm heliax, Times Microwave Systems LMR-600-DB
- 6) Antenna grounding kit: Andrew SGPL4-06B2 Sure Ground Plus.
- 7) Crimp-style lug: Andrew 244456 or equal

- 8) Cold shrink weatherproof tubing: Andrew 241474-4 or equal
- 9) Antenna down conductor: #6 AWG bare tinned solid copper, Microflect B1961 or equal.
- 10) Lighting arrestor: Bulk-head style, Polyphasor IS-B50HN-C2-ME or equal
- 11) Hardware: Stainless Steel

4. Panel Mounted Devices

- a. 12/24 VDC Power supplies: Power supplies ~~will~~shall be linear, open frame supplies with a minimum capacity of 3.0 Amp manufactured by Acopian, Power One, or Solo.
- b. Relays: Relays ~~will~~shall be SPDT with a minimum 10 Amp rating by Idec, Potter & Brumfield, Turck, or Allen-Bradley.
- c. Signal Isolators: Current isolators and converters ~~will~~shall be by M-Systems, Wago, or Wilkerson.
- d. Terminal Block System: Terminal blocks, fuse blocks, and disconnect blocks ~~will~~shall be by M-Systems, Wago, Wilkerson, or Allen-Bradley.
- e. Temperature Switch: Temperature switch ~~will~~shall be used to monitor internal panel temperature for high temperature conditions. Range ~~will~~shall be 0 – ~~250-120~~ degrees F. Provide cooling fans.
- f. Interior Lighting: Provide all control panels with a fluorescent interior light of the same approximate width of the control panel located along the top of the panel. Provide light with ~~an integrated door switch on latch side of opening~~ ~~a separate light switch.~~
- g. UPS: Provide an uninterruptible power supply sized for 150% of calculated load with sufficient battery backup time for 30 minutes of operation. Provide American Power Conversion or Best Power Products.
- h. Selectors and Pushbuttons: Provide corrosion resistant selectors and pushbuttons by Allen-Bradley ~~or Square-D.~~

~~4.~~ ~~45.~~ Wet Well Level Measurements Pressure Transmitter

- a. Pressure measuring Systems shall be of two-wire, differential pressure cell type and produce a signal directly proportional to and linear with

input pressure. The pressure transmitter shall be a Rosemount 3051CG4A22AIAM5B4.

- b. The microprocessor-based signal converter/transmitter shall have the following attributes:
 - 1) Covert signal from the d/p cell to a standardized 4-20mA signal into a minimum of 700 ohms.
 - 2) A 2-line LCD display for value on top line and units on the bottom line.
 - 3) NEMA 4X aluminum housing sealed with O-rings.
 - 4) Self-diagnostics and automatic data checking.
 - 5) Tolerate ambient temperature operating limits of -20 to +140 degrees F.
- c. Process connection: ¼ NPT
- d. Performance: the pressure metering system shall conform to the following requirements:
 - 1) Accuracy: 0.20% of calibrated span
 - 2) Ambient Temperature effect: less than +/- 0.5 of calibrated span at maximum span for 100 degree F change.

6 Wet Well Measurements

- a. Provide continuous (analog) wet well level measurement by use of ~~a reactive air cell~~ bubbler system. Mount bubbler system components (compressors, Rosemont pressure transmitter, valves, etc.) in control panel. Mount air cell 6 inches above the wet well floor. Use 304 or 316 SS tubing for all piping.
- b. Use differential pressure transmitter for pressure (level) measurement on the bubbler system. Use Rosemont model 1151 smart pressure transmitter ~~or Endress & Hauser model PMD-230~~. Provide 0.5 inch NPT block and shutoff valves. Provide 0.5 inch NPT ~~three-valve~~ manifold for calibration.
- c. Use duplex air compressors with manual alternation ~~with receptacle inside the cabinet~~. Use WISA model 110 compressor or equal capable of supplying 5 psi air at 100 cfm.
- ~~d. Provide a normally open solenoid valve on the air supply line that can be used to build up pressure and supply a burst of air to clear the air cell periodically. Provide protection for controller.~~
- e.d. Provide float for high-high level alarm contact.

67 Record Drawings and Operations & Maintenance Documentation

- f. As-Built Drawings: Provide as-built drawings showing physical location of components. Provide loop drawings (end-to-end wiring diagrams) meeting the ISA S5.4 standards with minimum required items plus optional items. Provide three (3) copies of all drawings and an electronic version in AutoCAD latest version.
- g. Provide O & M Manuals for hardware.
 - 1) Cover equipment comprising the system in the hardware instruction manuals for all equipment including third party equipment, provided as part of the SCADA system. Provide instructions for operation and maintenance of the installed system, as well as operation and maintenance instructions for the individual equipment units comprising the system.
 - 2) Cover equipment comprising the system in the hardware instruction manuals for all equipment including third party equipment, provided as part of the SCADA system. Provide instructions for operation and maintenance of the installed system, as well as operation and maintenance instructions for the individual equipment units comprising the system.
 - 3) Standard hardware manuals ~~will~~ **shall** be acceptable, provided that errata sheets are included to reflect the specific equipment provided.
 - 4) Electronic CD-ROM hardware manuals are acceptable.
 - 5) Provide three (3) COPIES OF O&M manuals plus an electronic copy when available.
- h. Provide O&M Manuals for software.
 - 1) Provide complete, organized, and standardized documentation for operations center, RTUs, PLCs, and other software provided as part of the SCADA system. In general, structure the documentation such that each level develops a different degree of detail. Begin with a broad approach (Systems Manual), focus on smaller pieces of the overall system (Subsystem Documentation) and finally pinpoint the finest detail (Program Documentation).
 - 2) Fully annotate and document every PLC program.
 - ~~3)~~ Provide three (3) copies of software O&M manuals plus an electronic copy when available.

- a. Factory Acceptance Test (FAT): Fully test all SCADA components at the ~~Manufacturer's~~ ~~Contractor's~~ facilities prior to shipping, installing, programming, or reconfiguring the City's SCADA equipment. The purpose of the testing is to verify compliance with the specifications and correct deficiencies at the Contractor's facility and not in the field. Insofar as practical, test the functional, performance, and interface requirements. Test each control loop from terminal strips to the PLC.
- b. Site Acceptance Test (SAT): After installation, fully test all SCADA components to verify compliance with the specifications. Insofar as practical, test the functional, performance, and interface requirements. Test each control loop from the instrument or terminal strip, through the PLC, to the City's central SCADA system. Tune all control loops. Test all control strategies.
- c. Operational Availability Demonstrations (OAD): The OAD is a 90 day period of time during which the SCADA system ~~will~~shall be utilized by the CITY in day-to-day operations. Its purpose is to test the SCADA system stability and completeness over time. Start the OAD upon written notice from the CITY and after successful completion of field testing. The OAD is considered successful if the system availability is 99.8 percent or better. The OAD ~~will~~shall be restarted or repeated if availability is less than 99.8 percent. Final Completion ~~will~~shall not be granted until OAD is passed.

9 Programming and Configuration Services

- a. Configure the PLCs based on the configuration drawings, P&IDs, the Process Control Narratives and functionality as specified in other sections. Include all necessary constant and variables required to meet the Specifications whether shown on the drawings or not. Provide a fully functioning control system.
- b. The Contractor ~~will~~shall conduct coordination meetings at the City's site during the configuration and programming program on a periodic basis as needed but at least twice during the project. The purpose of the meetings is to solicit input from and coordinate activities with City personnel and the Engineer. The Contractor ~~will~~shall provide samples of PLC programs and present an update of current activities, a forecast of future activities, and discuss any problem areas.
- c. Use diagrams in ladder rung format for the PLC program documentation system. Show all input devices near the left "power rail" and all outputs near the right "power rail." The diagrams ~~will~~shall show all device codes and functional descriptions shown on the Drawings and ~~will~~shall also show PLC reference codes and I / O assembly codes, module numbers, and terminal numbers. Provide source code for all operator interface programming, amply annotated to explain the operation. Include I / O tag numbers in rung or device annotations. Use control strategy numbers to

identify PLC program sections. Alternative programming techniques may be used if approved in writing by the ~~City~~Water Department Director.

- d. Organize and structure all PLC programs to aid in software maintenance and modification. Organize each PLC program into a three-level “outline” structure consisting of strategies, equipment items (or sub-strategies), and “functions.” Each PLC strategy consists of the logic required by one strategy in the Process Control Narratives. Each PLC equipment item (or sub-strategy) ~~will~~shall consist of the logic associated with one piece of mechanical equipment (or associated with a logical subsection of a strategy). “Functions” ~~will~~shall be the smallest subdivision of programs and ~~will~~shall consist of functions, subroutines, or short algorithms requiring roughly five to ten rungs of ladder logic. Ladder logic ~~will~~shall be used for all PLC programming unless otherwise approved in writing by the ~~City~~Water Department Director.
- e. PLC programming ~~will~~shall be thoroughly documented. Each contact, coil, timer, function block, or other rung item ~~will~~shall be annotated in the program listing with: the internal item number (i.e., coil number, contact number, etc.); the external tags (where applicable); and a brief description of the item’s function. External tags ~~will~~shall be the input or output tag number from the PLC I / O schedule or, for points created in a PLC and transmitted to (or from) the central computer system, the tag number used in the central computer.

10 Provide a dial-up telephone list for use by the automatic alarm dialer. Provide a wall mounted telephone using the same dial-up line for operator convenience.

F. Standby Generator

- 1. Provide permanently installed, natural gas fueled Kohler or approved equal generator with automatic transfer switch, manual transfer switch, and load bank connection. Provide Crouse Hinds E0400-1686 Posi-lock load bank receptacles to test generator for output and generator break in (3 phase 4 wire). The design Engineer ~~must~~shall verify gas pressure with P.G.&E. and fuel demand with generator manufacturer prior to review of submittal. The engine manufacturer ~~must~~shall certify that the engine is designed to operate on natural gas and propane. Generator ~~will~~shall be shipped from the factory with City approved color. See attached single-line diagram for wiring.
- 2. Submit generator sizing calculations for City approval. Sizing calculations ~~will~~shall assume loading based on lead pump running, lag pump starting and full operation of all electrical equipment at the site. Generator ~~will~~shall run at 100% of name plate current for 4 hours on primary fuel supply using City owned load bank.
- 3. Provide automatic back-up propane fuel capability and 24 hour supply of fuel. Propane tank to be factory-painted with City approved color.
- 4. Obtain Fire Department approval for site of back-up fuel tank.

5. Provide instrumentation:
 - a) Generator voltage, frequency, and amp meters.
 - b) Oil pressure gauge.
 - c) Battery volt meter.
 - d) Temperature gauge.
 - e) Hour meter.
 - f) External battery with trickle charge.
 - g) Dry contacts for telemetry – showing generator running.
6. Provide automatic shut-off and alarms:
 - a) Low engine oil pressure.
 - b) High engine temperature.
 - c) Over speed.
 - d) Over crank.
7. Locate exhaust away from dry well ventilation and provide stainless steel rain cap. Insulate exhaust stack from generator enclosure or roofing material.
8. Provide sound attenuation as necessary to meet or exceed City noise standards for location. Attenuation may include silencers, insulation and /or enclosure. Provide ambient noise measurements and calculations demonstrating compliance.

G. Gas Monitoring System (if required)


1. Provide a permanent gas monitoring system in the dry well.
2. Monitoring system ~~will~~shall monitor for lack of oxygen, lower explosives limit, and hydrogen sulfide.
3. The monitoring system ~~will~~shall be tied to the telemetry system alarms.
4. Manufacturer ~~will~~shall be MSA or an approved equal.

H. Details Required on Improvement Plans:

1. Site Plan: Locations of power pole, transfer switch, emergency generator, emergency fuel supply, control panel, wet well, dry well, ground slab, driveway, fencing, water service, emergency suction / discharge boxes. Provide site grading and drainage details.
2. Wet well: Influent piping (standard inside drop manhole); suction piping (min. 6" off bottom of manhole); emergency suction line; bubbler line including connection hardware; water / alarm levels (pump on, pump off, low level, high level), redundant high water float switch.
3. Dry well: Pumps and piping; safety ladder, ladder light.
4. Emergency Power: Electrical details specified to include size and material of conduit, switch gear, telemetry compatibility. Electrical details ~~will~~shall include power source, meter location, cabinetry. Wiring diagrams ~~will~~shall depict connection to and between PG&E, transfer switch, emergency generator and dry well as shown n the attached single-line diagram.
5. Force main discharge details.

I. Record Drawings and Manuals:


1. Provide three (3) copies of record drawings and an electronic copy in AutoCAD latest version.
2. Provide three (3) copies of O & M Manuals plus an electronic copy when available.

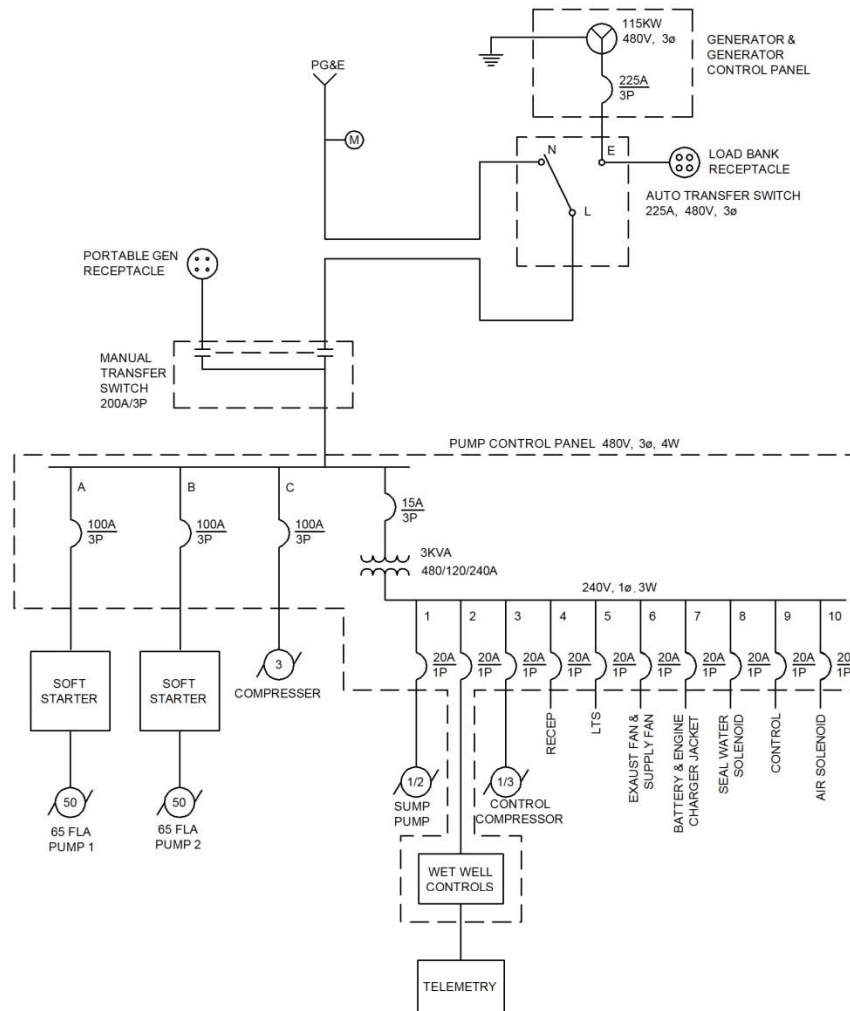

EXAMPLE SINGLE-LINE DIAGRAM

NOT TO SCALE

Appendix "D"
SEWAGE PEAK LOAD FACTOR VS. POPULATION
SEWAGE DESIGN FLOW CONTRIBUTION

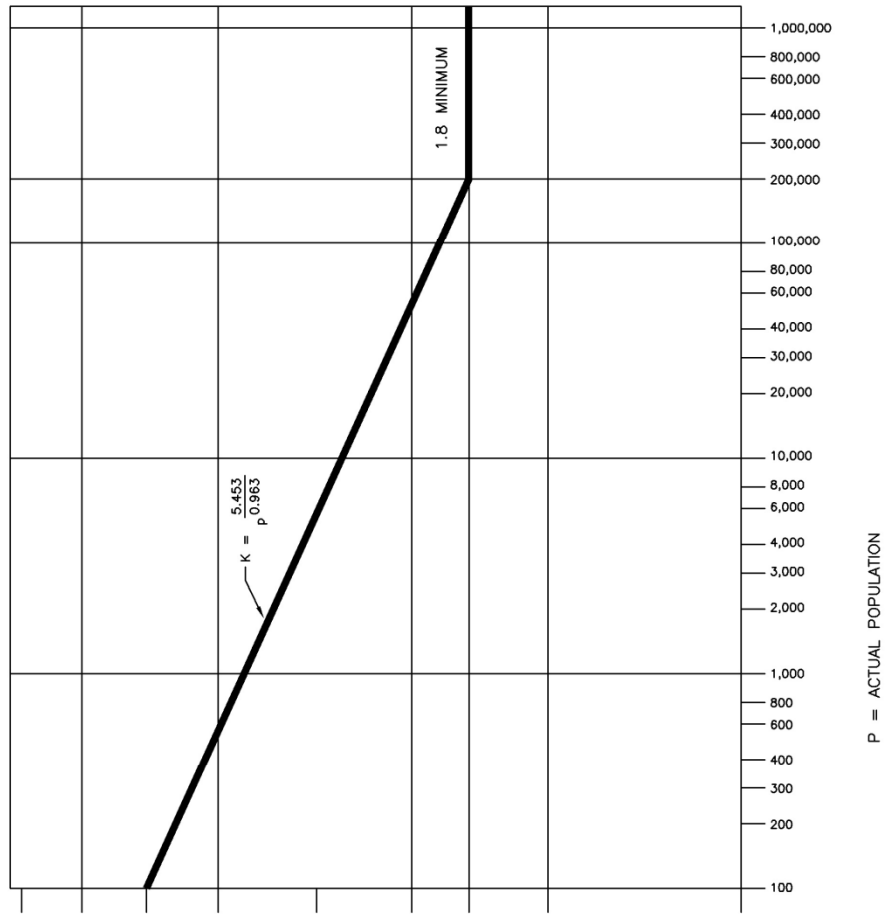

K = RATIO OF PEAK TO AVERAGE SEWAGE FLOW RATE = (PEAK LOAD FACTOR)

SEWAGE PEAK LOAD
FACTOR vs POPULATION

SEWER CONTRIBUTION ACCORDING TO ZONING AND USE

Zoning Area Type	Units per Acre	People Per Unit	People Per Acre	Description
R-1 R-1-9	4 (6.5 max)	3.25	13	Single Family Residential District
R-1-6 R-1-7.5	6 (7 max)	3.25	19.5	Single Family Residential District
R-2	8 (14 max)	3.25	26	Two Family Residential District
R-3 R-3-10 R-3-15 R-2 R-3-20 R-3-30 R-3-40	25 (29 max) B (10 max) 12 (15 max) 16 (20 max) 25 (30 max) 30 (43 max)	** ** ** ** ** ** **	55 to 81 19 to 26 29 to 39 38 to 52 57 to 81 82 to 98	Multiple Family Residential
R-4	30 (43 max)	**	82 to 98	Residential, Professional, Apartments, Office District
R-5	75 (110 max)	**	209 to 243	High Rise
R-R	--	--	16	Rural Residential
Hills	2 (3 max)	3.25	6.5	Hilly Areas – Residential
Mobile Home	9	2.5	22.5	Mobile Homes or Trailer Parks
Schools	--	Attendance	--	20 Gallons Per Person Per 24 Hours
Eating Establishments	--	Seating Capacity	--	40 Gallons Per Person Per 24 Hours
C-1	8	2	16	Commercial Store
U	--	--	16	Unclassified
A	--	--	16	Agriculture
M-1	--	--	16	Light Industrial

** Apartments:

Studio & one bedroom	1.9
Two or more bedrooms	2.25

** Condominium:



Studio & one bedroom	2.25
Two or more bedrooms	3.25

NOTE: The estimated densities shown above represent an average Contribution rate, and ~~must~~shall be increased in some situations.

2.



SANITARY SEWER STANDARD DRAWINGS

<u>Std. #</u>	<u>Title</u>	<u>Approved</u>
500	Standard Precast Concrete Manhole For Sanitary Sewer	June 2009
502	Shallow Manholes and Junction Structures for Multiple Laterals	June 2009
503	Inside Drop Manhole	Sept. 2002
504	Outside Drop Manhole	Sept. 2002
505	Mainline Cleanout Permanent	June 2009
506	Temporary Mainline Cleanout	June 2009
507	Abandoned Pipe Plug	Sept. 2002
508	Abandoned Manhole	Sept. 2002
512	Manhole Frame & Cover	Sept. 2002
513	4" & 6" Sewer Service Lateral and Cleanout	June 2009
513-A	4" & 6" Two Way Service Lateral and Cleanout	June 2009
515	Discharge For Private Force Main	Sept. 2002
516	Sewer - Water Main Crossing Details	Sept. 2002
517	Miscellaneous Pipe Installation Details	Sept. 2002
518	PVC Sewer Pipe Deflection Mandrel	Sept. 2002
519	Two Stage Grease Interceptor	June 2009
520	* Three Stage Sand & Grease Interceptor	June 2009
521	Sampling Manhole Exterior Use	Sept. 2002
522	Sampling Box Building Interior	Sept. 2002
523	Three Stage Grease Interceptor	June 2009
524	Control Sampling Manhole	Sept. 2002
525	Recreational Vehicle Disposal Facility	Sept. 2002
526	Food Facility Enclosure	Sept. 2002
527	Sewage Backwater Valve Assembly	June 2009

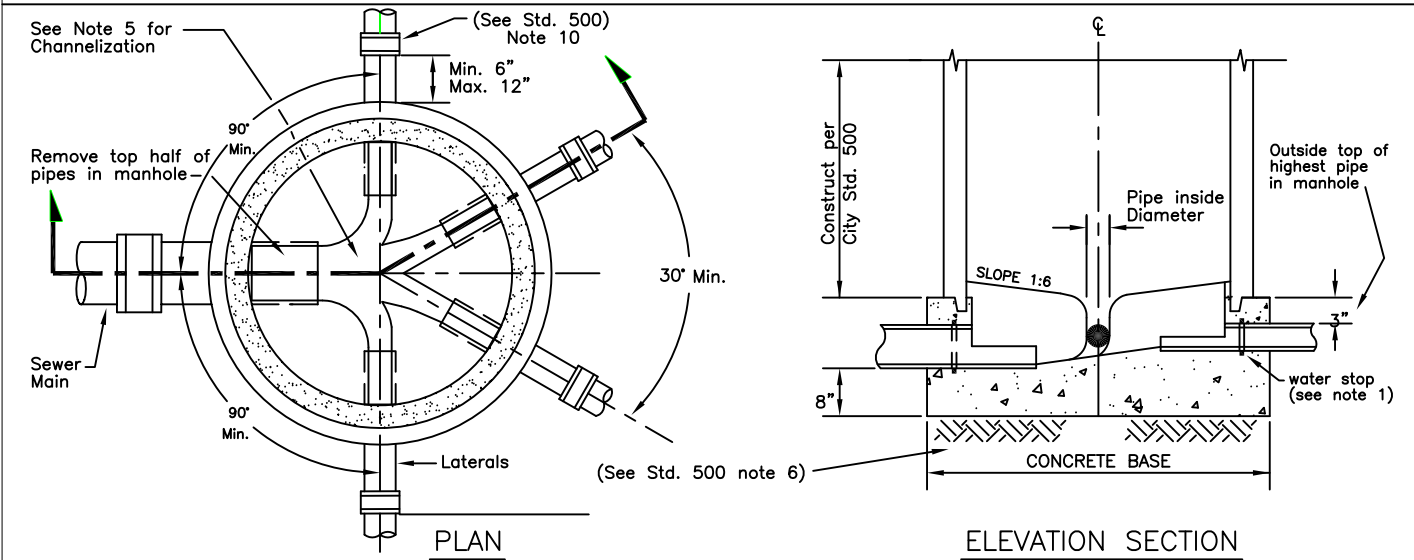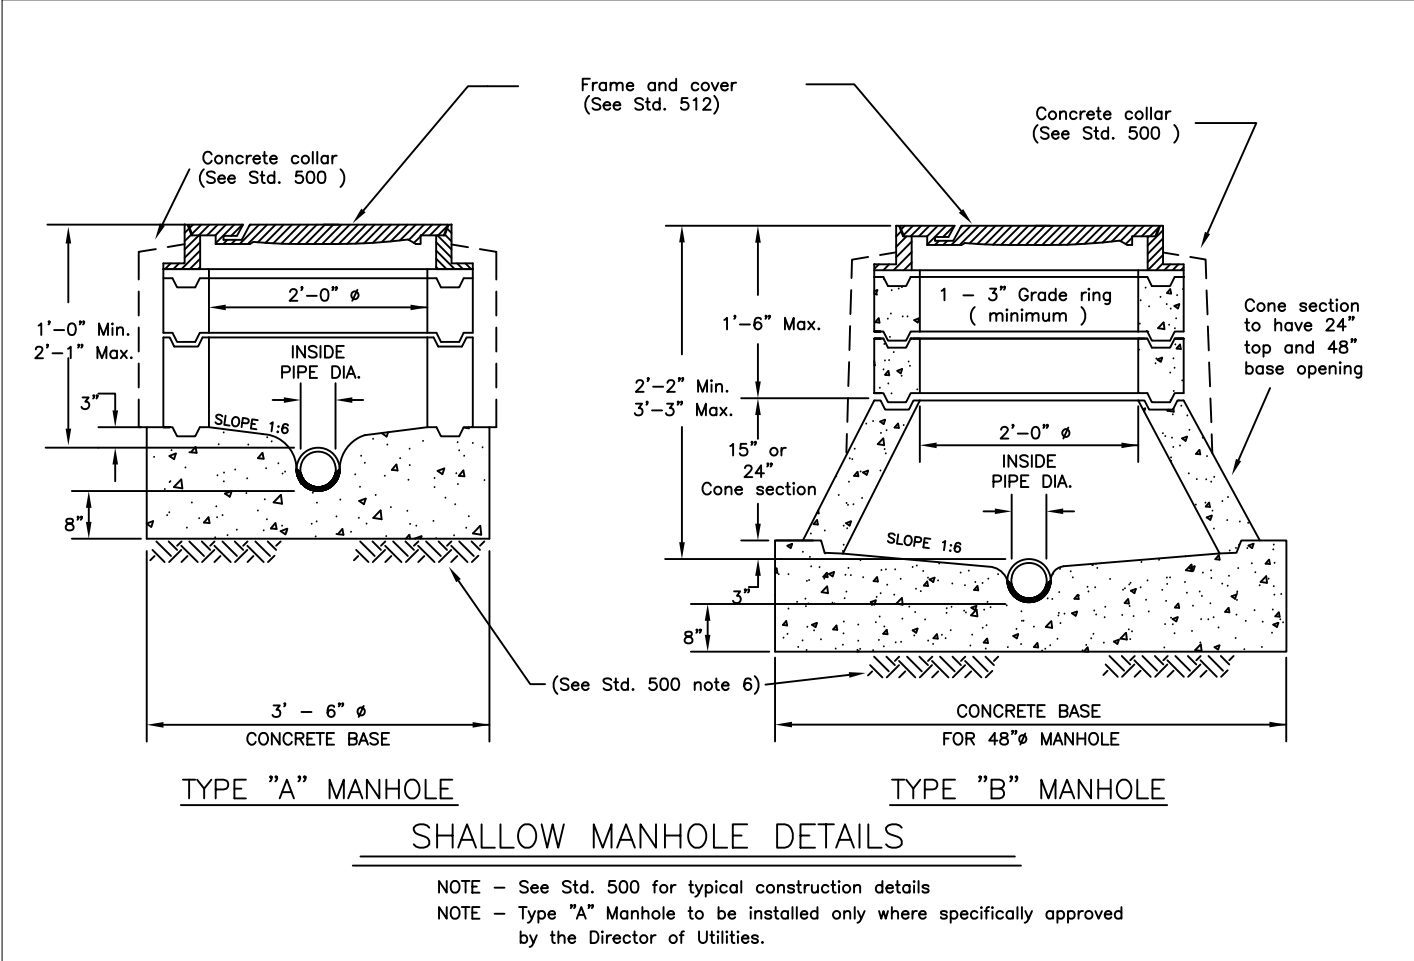


- NOTES:
1. An approved water stop shall be installed on all pipe entering or leaving a manhole and centered under manhole wall as shown.
 2. The elevations of the top of all pipes entering the manhole base block shall be the same.
 3. The maximum number of laterals to be connected to a manhole is (4) four.
 4. See Std. 500 for manhole construction details.
 5. The channels shall be formed to provide smooth flow through the manhole to the satisfaction of the City Engineer.
 6. Channels and laterals through the exterior of the base shall be constructed radially.
 7. Long radius sweeps may be needed outside of the manhole.

CITY OF SANTA ROSA		
SHALLOW MANHOLES		
JUNCTION STRUCTURES FOR MULTIPLE LATERALS		
SCALE: NONE	DATE: June 2009	
DWN: GC RR	APPROVED	FILE NO.
CHK: AA		STD.-502

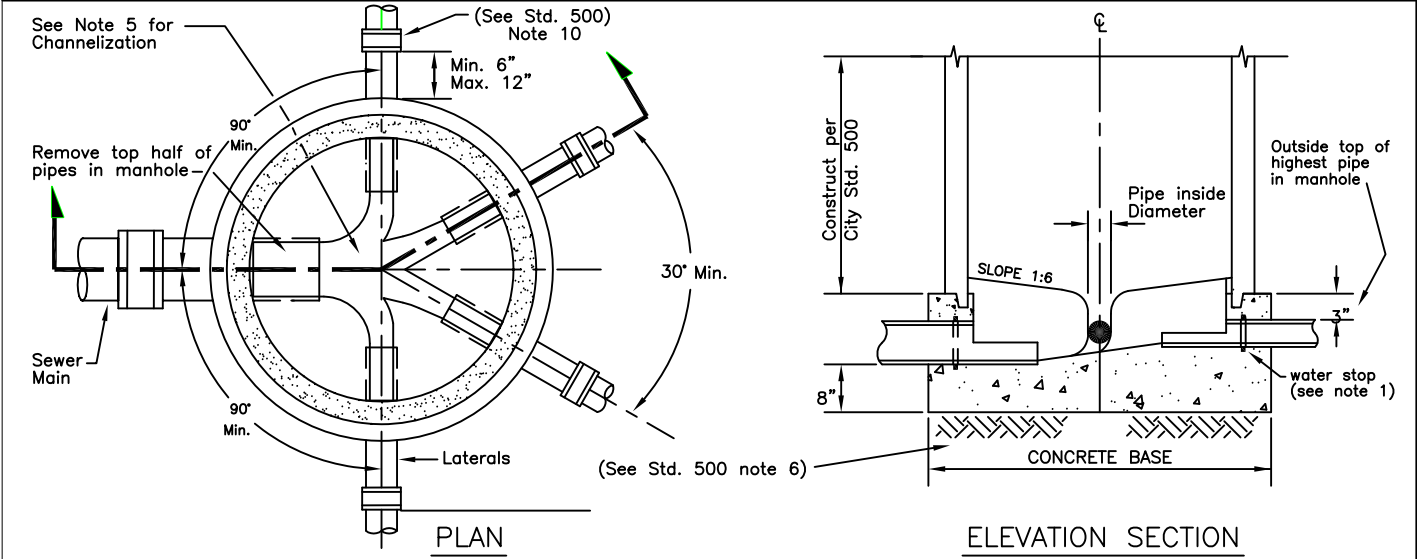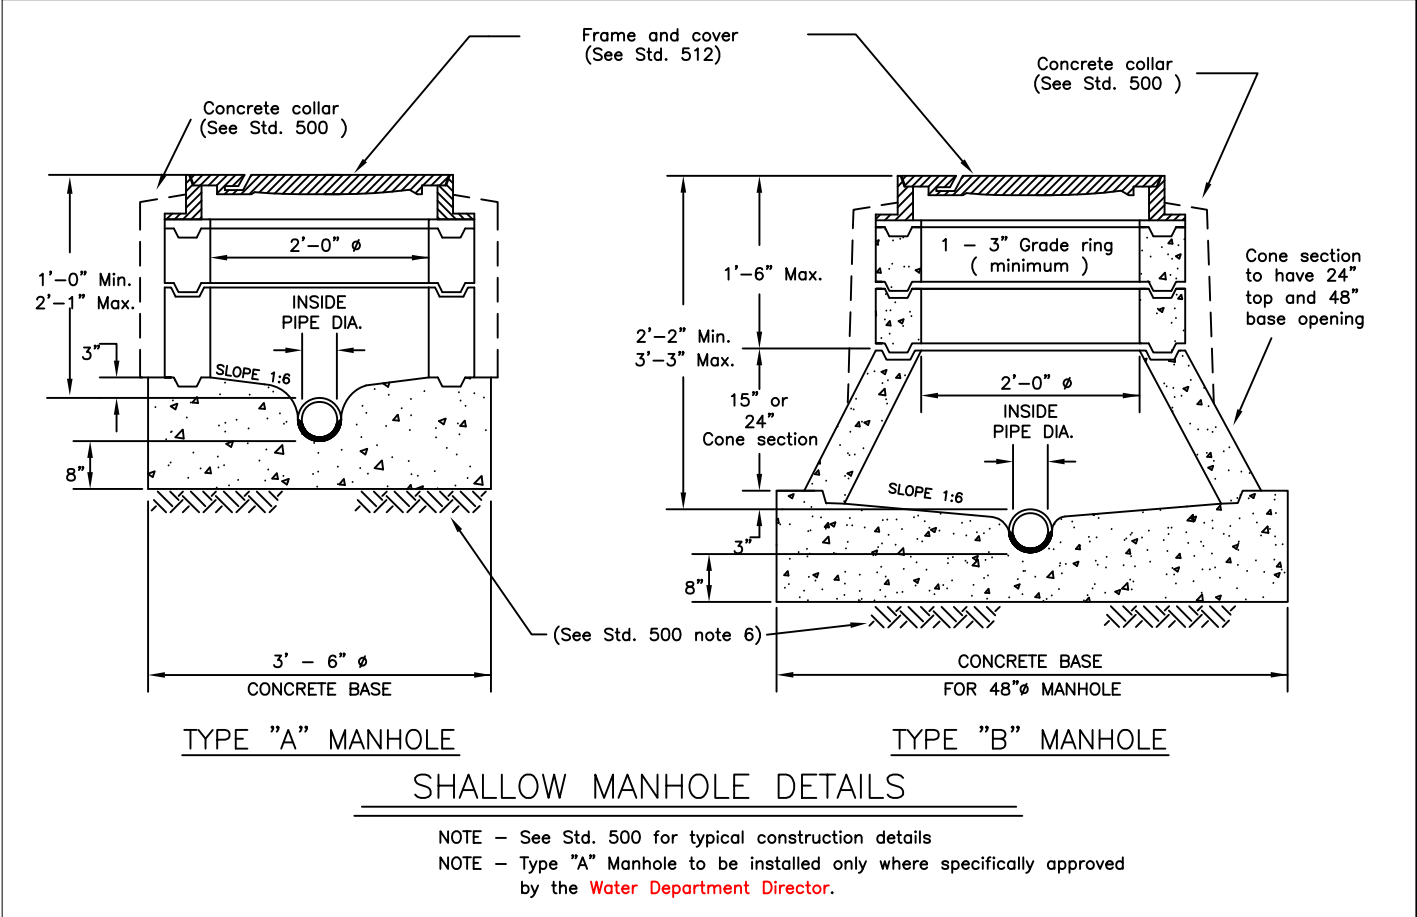

- NOTES:
1. An approved water stop shall be installed on all pipe entering or leaving a manhole and centered under manhole wall as shown.
 2. The elevations of the top of all pipes entering the manhole base block shall be the same.
 3. The maximum number of laterals to be connected to a manhole is (4) four.
 4. See Std. 500 for manhole construction details.
 5. The channels shall be formed to provide smooth flow through the manhole to the satisfaction of the City Engineer.
 6. Channels and laterals through the exterior of the base shall be constructed radially.
 7. Long radius sweeps may be needed outside of the junction structure.

CITY OF SANTA ROSA		
SHALLOW MANHOLES		
JUNCTION STRUCTURES FOR MULTIPLE LATERALS		
SCALE: NONE	DATE: Mar. 2016	
DWN: GC RR	APPROVED	FILE NO.
CHK: AA		STD.-502

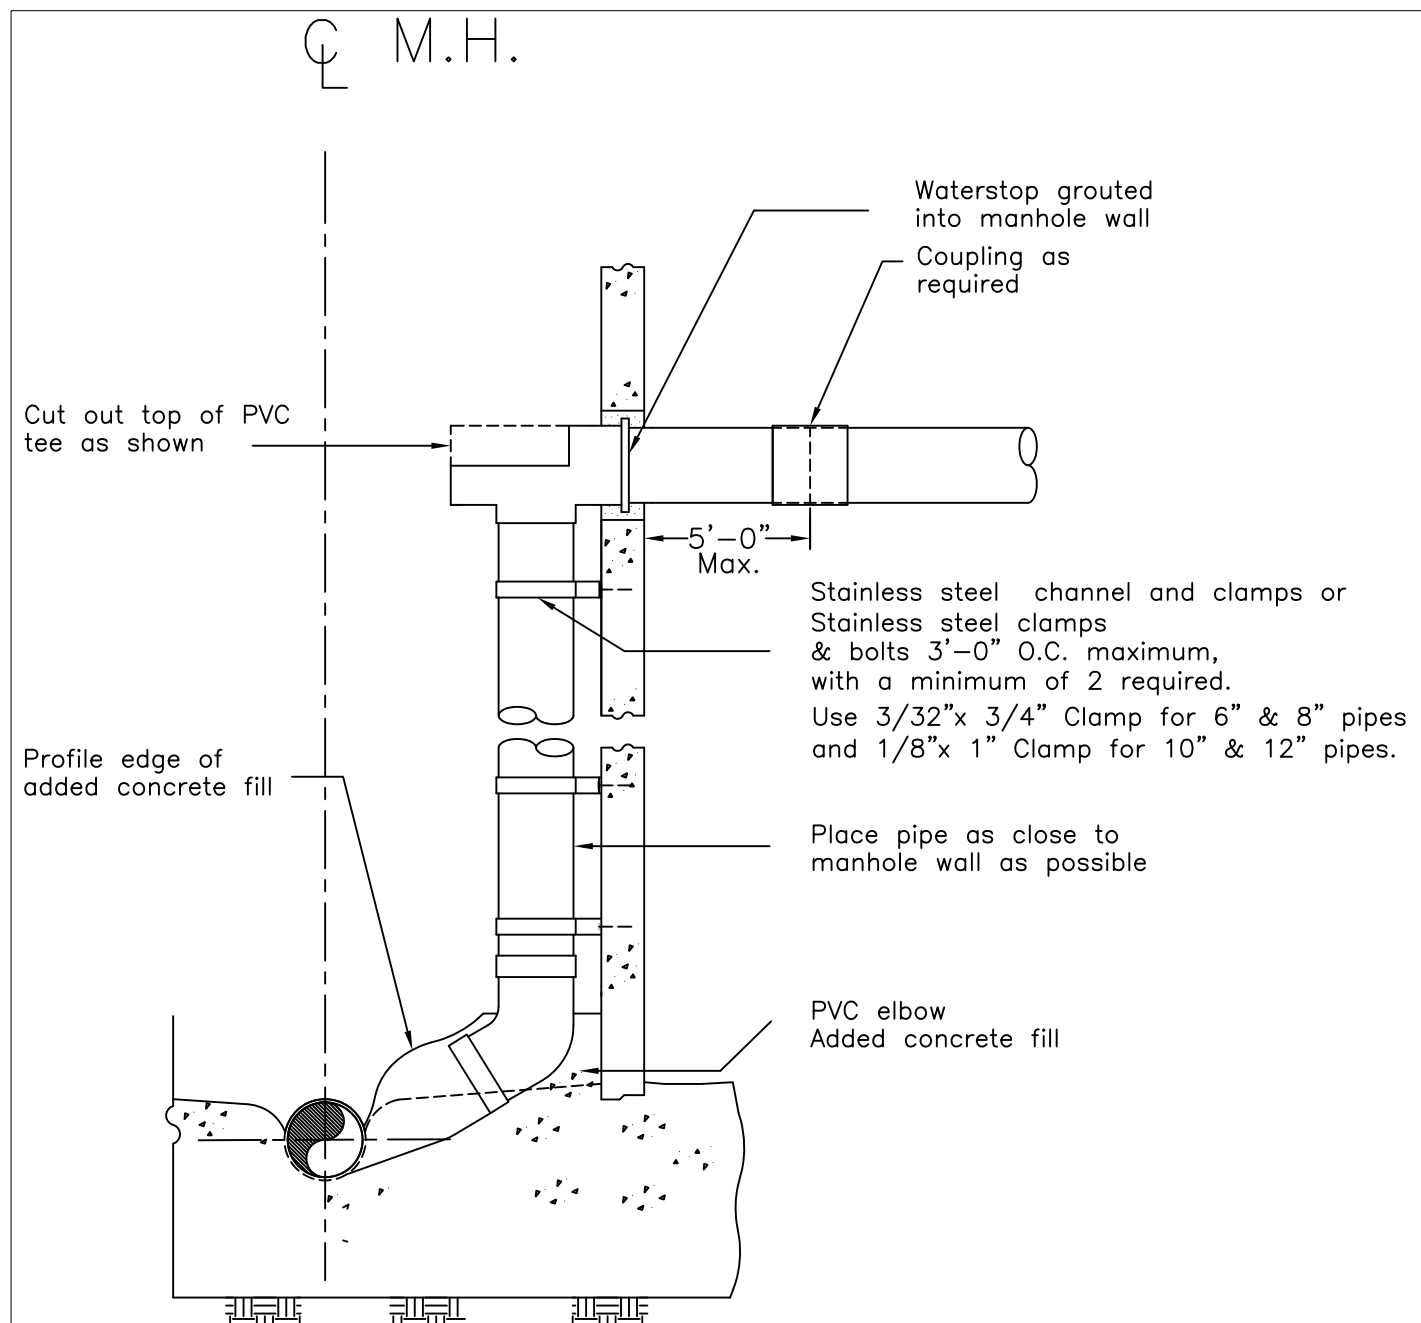

NOTES:


1. Manholes constructed using this standard shall be 60" in diameter and installed in conformance with Standard 500. Use 72" MH where there are two drop connections.
2. Enclose elbow in concrete. Form smooth channel with sweep to manhole flowline.
3. Install waterstop in accordance with manufacturer's instructions as shown.
4. PVC pipe and fittings shall have same nominal size and SDR rating as incoming pipes.

CITY OF SANTA ROSA

INSIDE
DROP MANHOLE

SCALE: NONE DATE: Sept.2002

DWN: RH APPROVED FILE NO.
CHK: G.C. STD.- 503

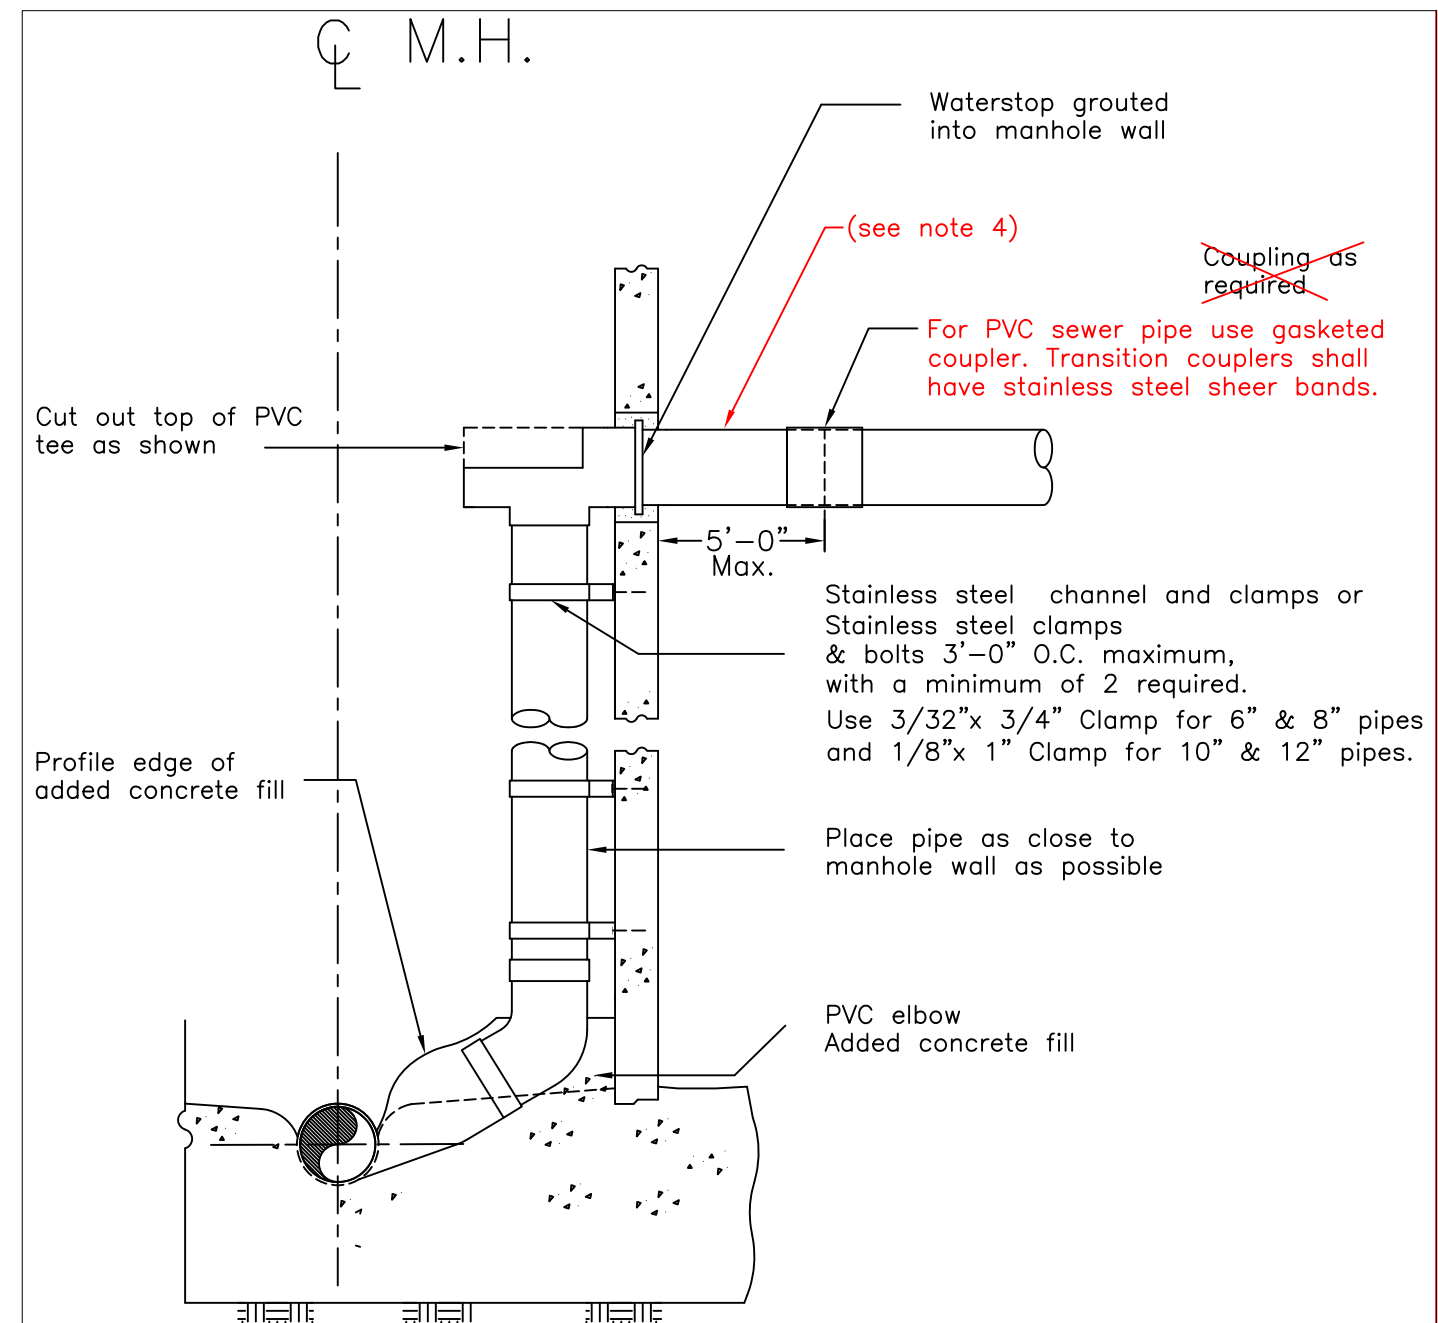

NOTES:


1. Manholes constructed using this standard shall be 60" in diameter and installed in conformance with Standard 500. Use 72" MH where there are two drop connections.
2. Enclose elbow in concrete. Form smooth channel with sweep to manhole flowline.
3. Install waterstop in accordance with manufacturer's instructions as shown.
4. Pipe shall be PVC SDR 26 unless otherwise approved, and shall be the same nominal size as incoming pipe.
5. All piping inside manhole used to construct the drop shall be SDR 26 solvent weld material. PVC primer and cement shall be per pipe manufacturer's instructions.

CITY OF SANTA ROSA

INSIDE
DROP MANHOLE

SCALE: NONE DATE: Mar. 2016


DWN: RH APPROVED FILE NO.
CHK: G.C. STD.- 503

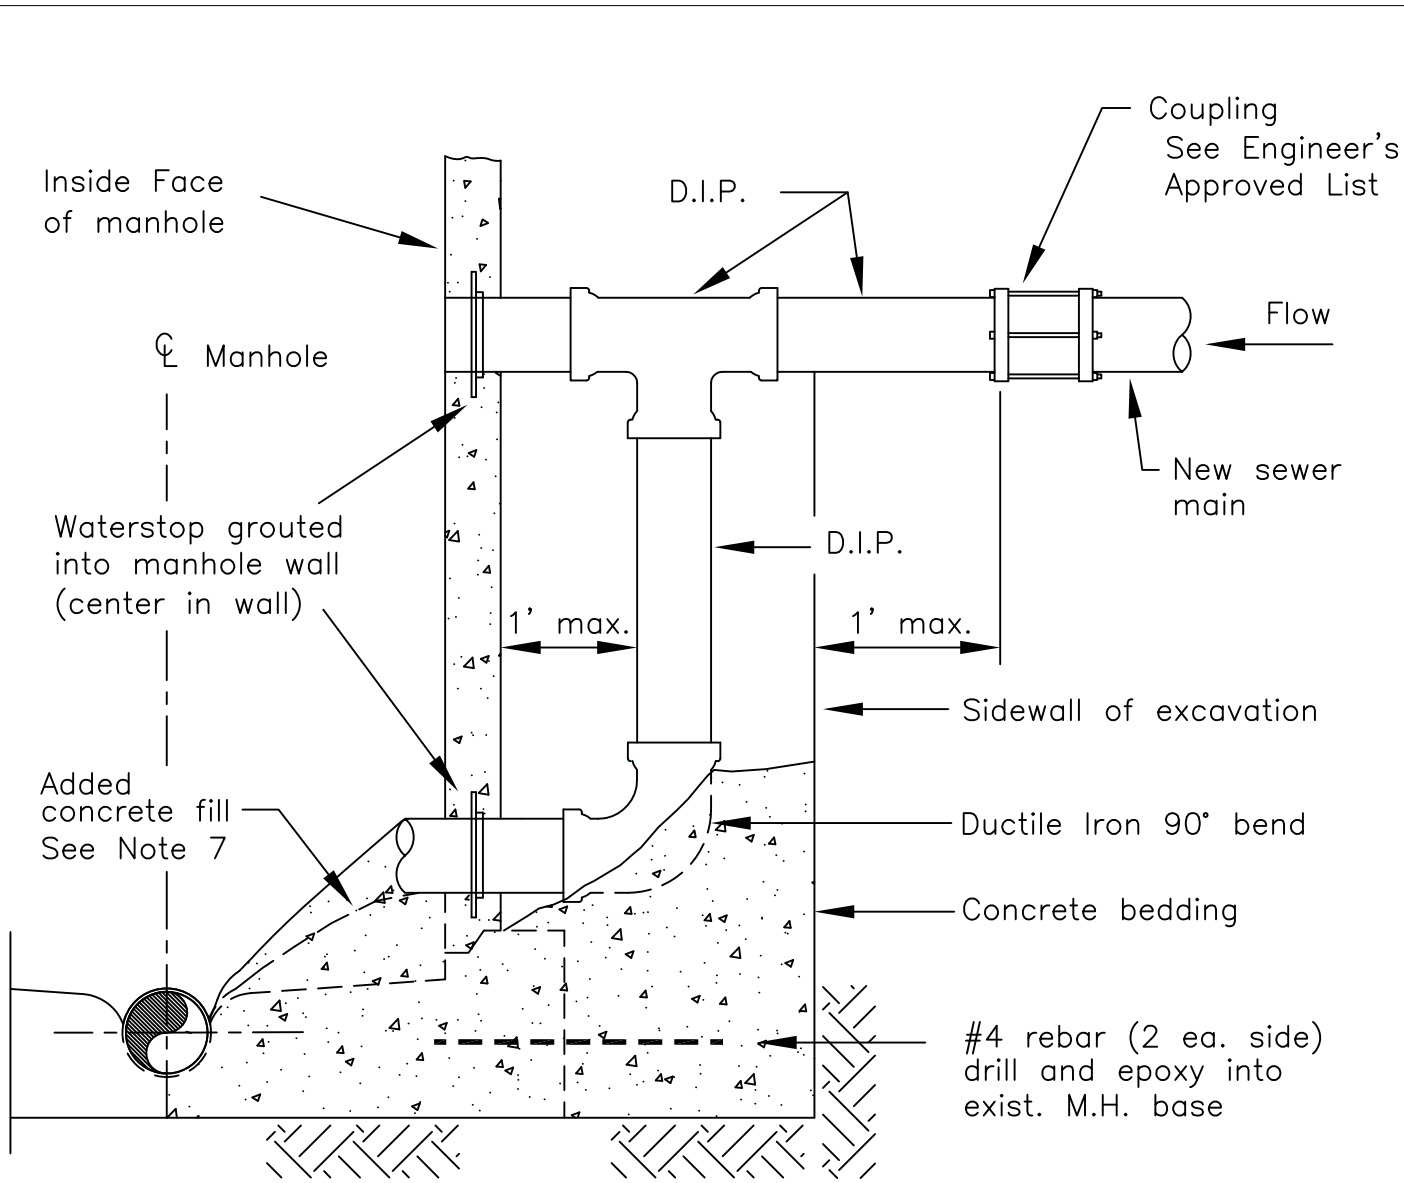

NOTES

1. Ductile iron pipe shall be pressure class 350 per AWWA C151.
2. Pipe and fittings shall be furnished with push – on or mechanical joints. Fittings shall conform to ANSI/AWWA C110/C153.
3. To be installed only where specifically approved by the Director of Utilities.
4. Drop inlet pipe and fittings shall be the same size as the incoming sewer main.
5. See Standard 503 for standard inside drop installation.
6. Install waterstop in accordance with manufacturer's instructions as shown.
7. Form smooth channel with sweep to manhole flowline.


CITY OF SANTA ROSA		
OUTSIDE DROP MANHOLE		
SCALE: NONE	DATE: Sept. 2002	
DWN: GC CHK: RH	APPROVED	FILE NO. STD.- 504

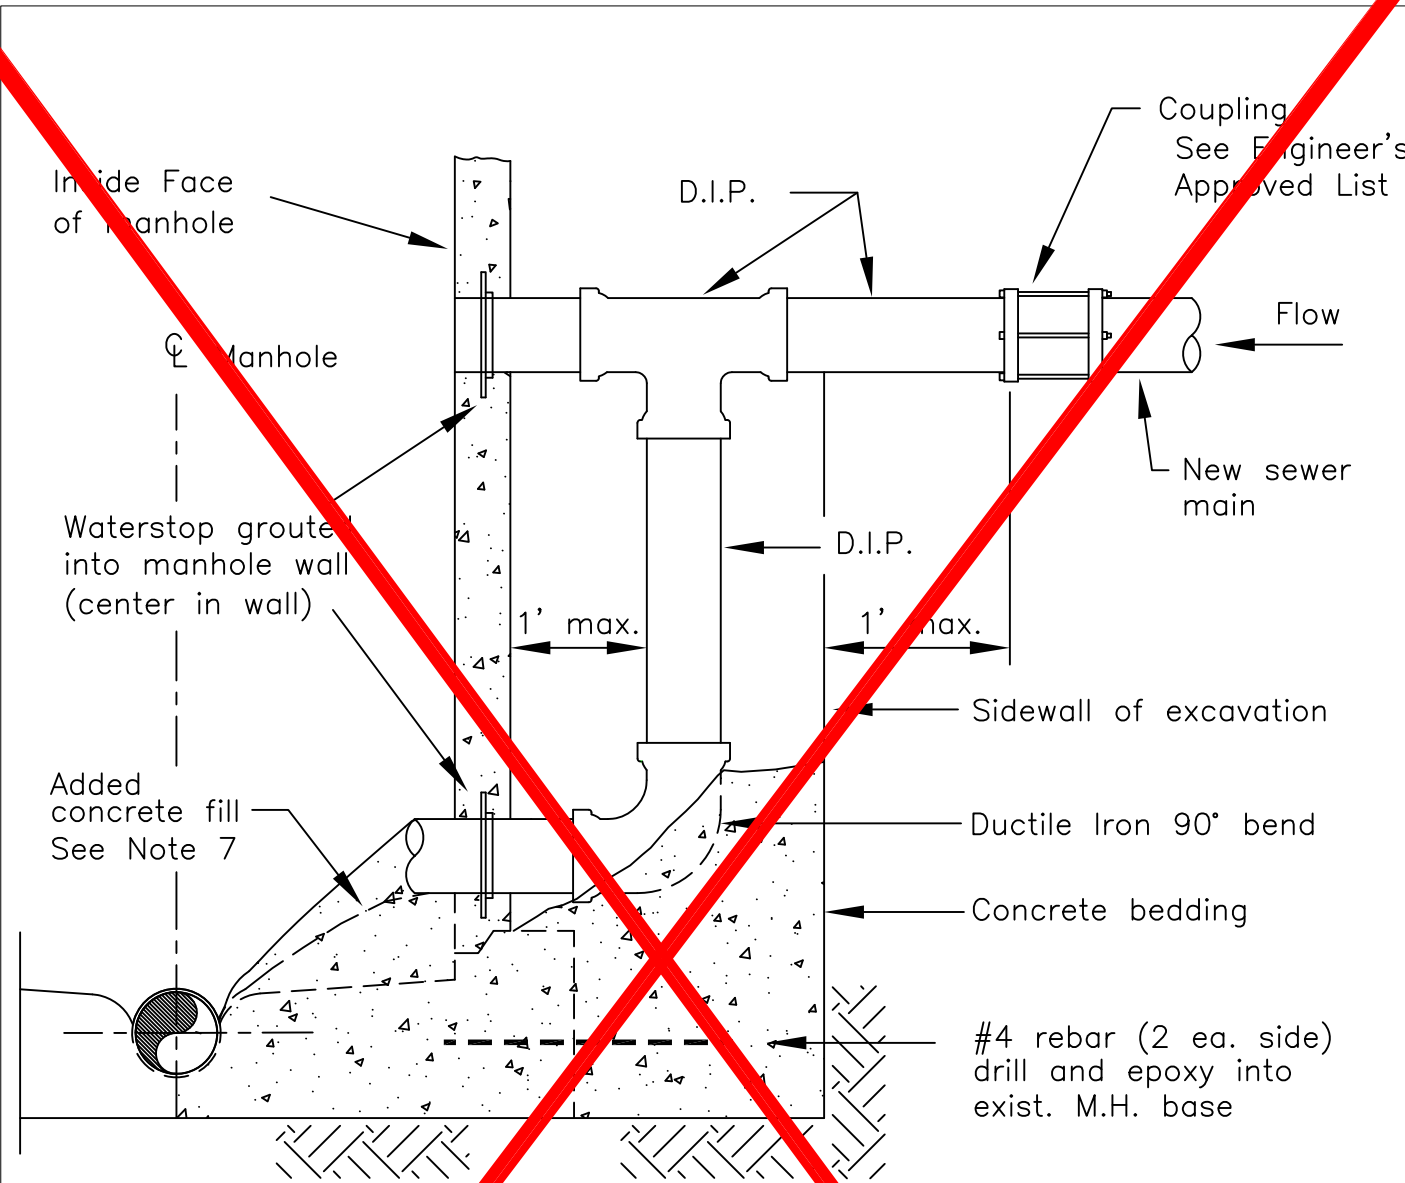

NOTES

1. Ductile iron pipe shall be pressure class 350 per AWWA C151.
2. Pipe and fittings shall be furnished with push – on or mechanical joints. Fittings shall conform to ANSI/WWA C110/C153.
3. To be installed only where specifically approved by the Director of Utilities.
4. Drop inlet pipe and fittings shall be the same size as the incoming sewer main.
5. See Standard 503 for standard inside drop installation.
6. Install waterstop in accordance with manufacturer's instructions as shown.
7. Form smooth channel with sweep to manhole flowline.


CITY OF SANTA ROSA		
OUTSIDE DROP MANHOLE		
SCALE: NONE	DATE: Sept. 2002	
DWN: GC CHK: RH	APPROVED	FILE NO. STD.- 504

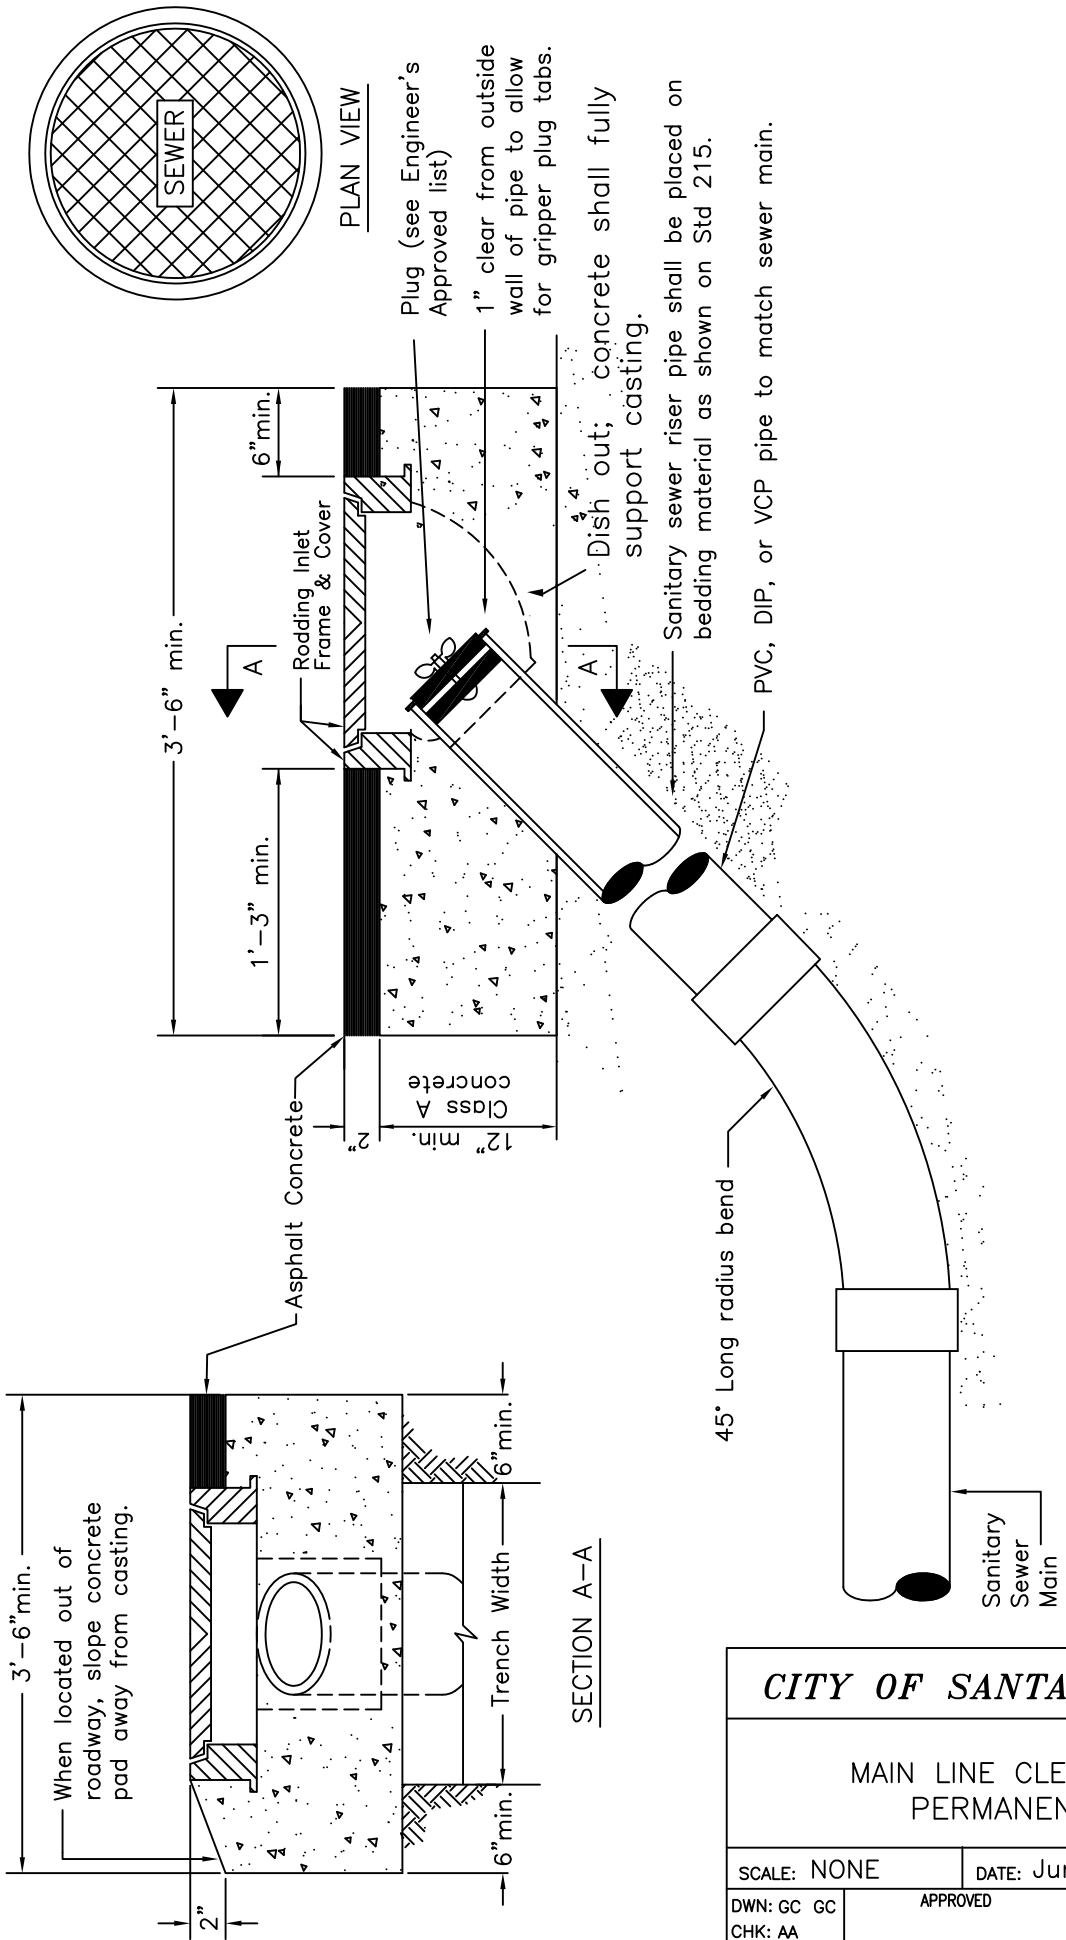

Note: To be used for main sizes 10" or less and where sewer main will not be extended.

MAIN LINE CLEANOUT
PERMANENT

SCALE: NONE		DATE: June 2009	
DWN: GC GC	APPROVED		FILE NO.
CHK: AA			STD.- 505

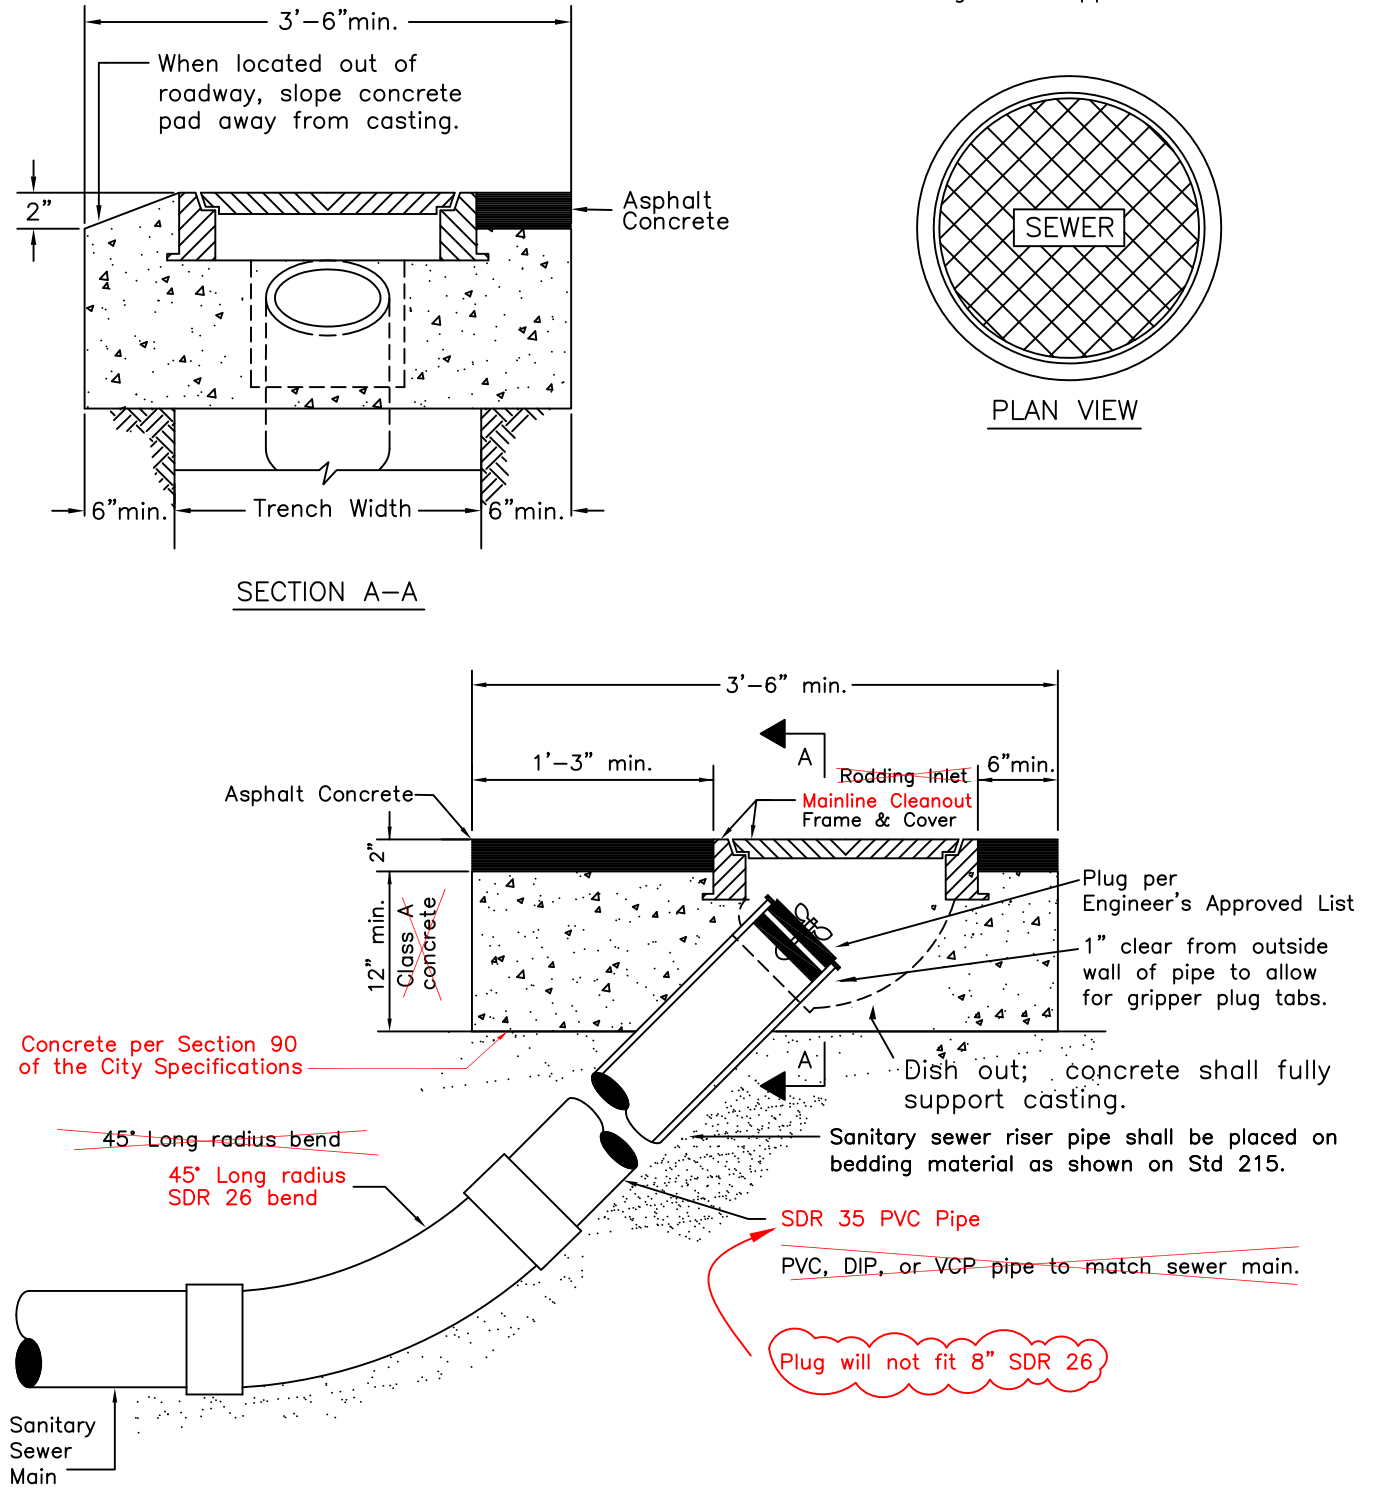


Note: To be used for main sizes 10" or less
and where sewer main will not be extended.

MAIN LINE CLEANOUT
PERMANENT

SCALE: NONE		DATE: Mar. 2016	
DWN: GC GC	APPROVED		FILE NO.
CHK: AA			STD.- 505

APPROVED BOX & COVER

See Engineer's Approved List.

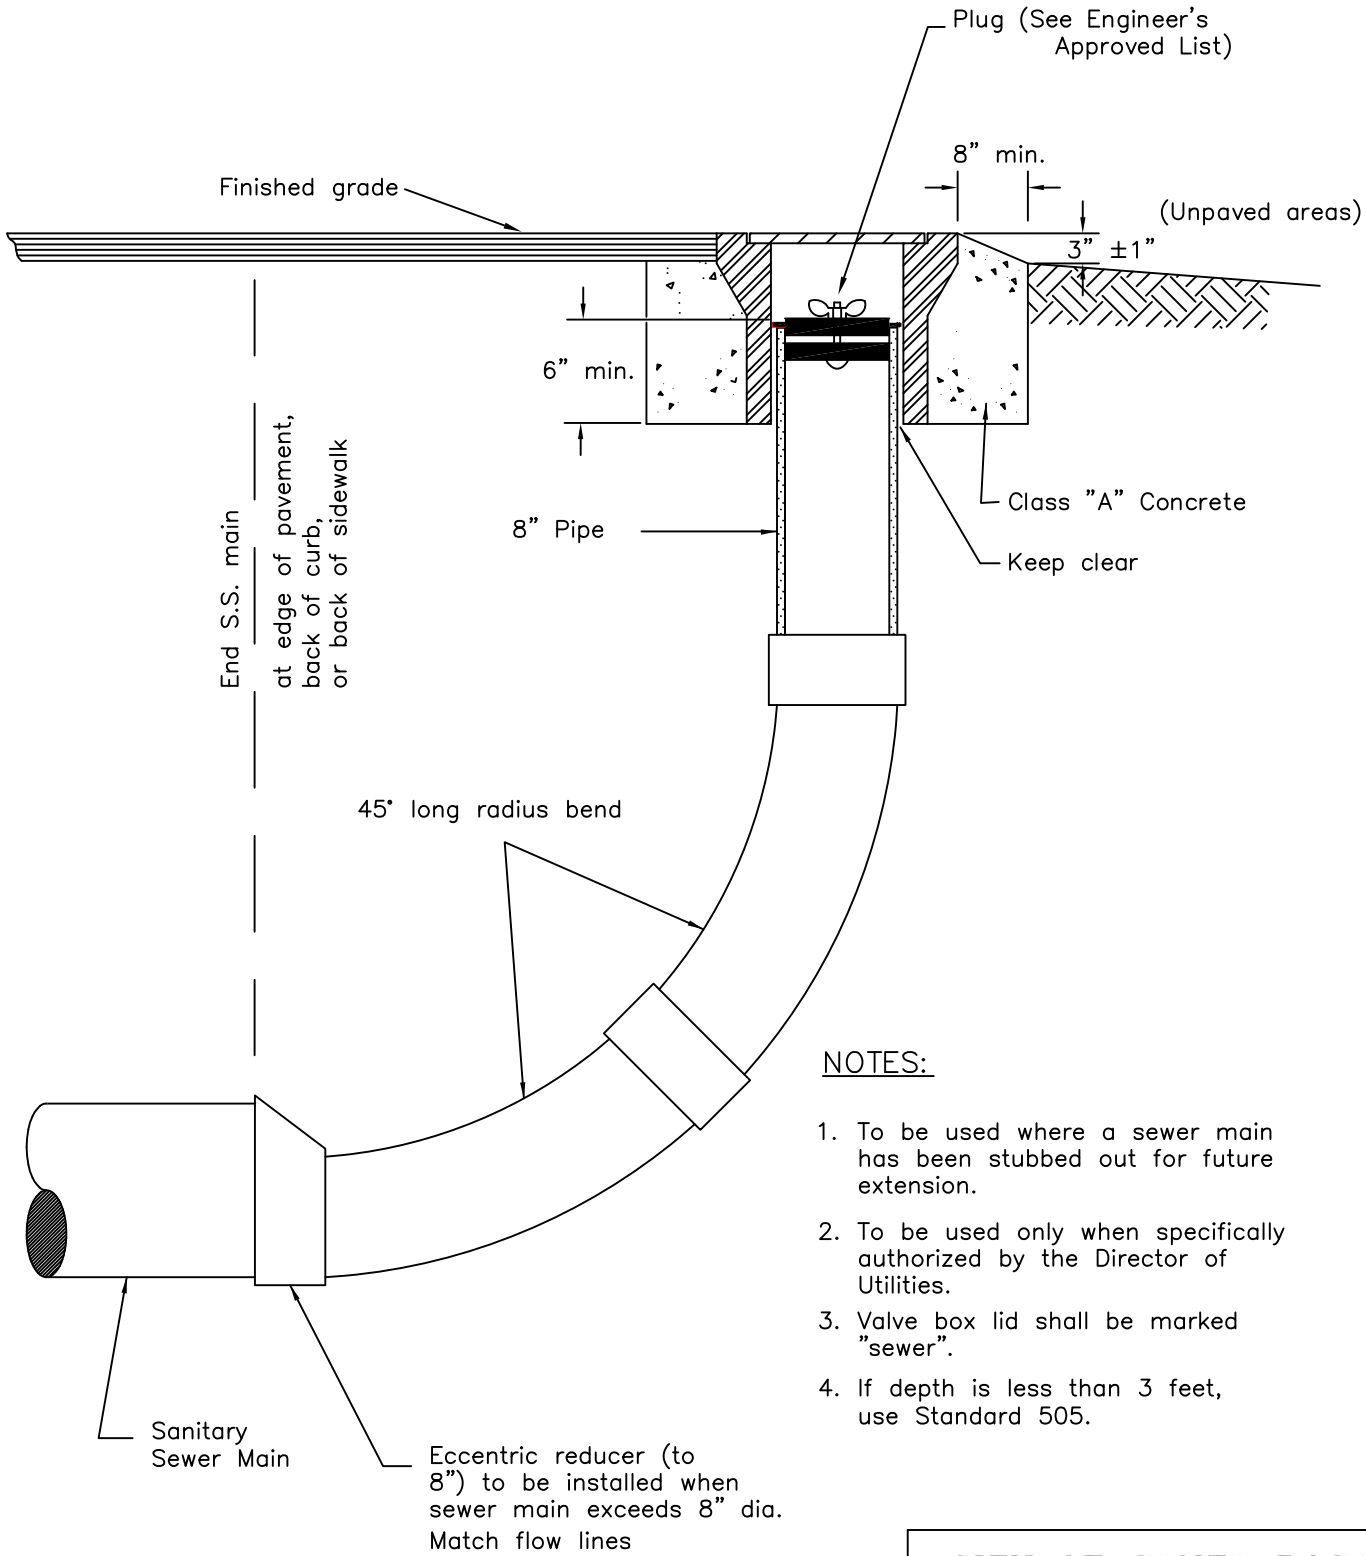


NOTES:

1. To be used where a sewer main has been stubbed out for future extension.
2. To be used only when specifically authorized by the Director of Utilities.
3. Valve box lid shall be marked "sewer".
4. If depth is less than 3 feet, use Standard 505.

CITY OF SANTA ROSA		
TEMPORARY MAINLINE CLEANOUT		
SCALE: NONE	DATE: June 2009	
DWN: GC RR CHK: AA	APPROVED	FILE NO. STD.- 506

APPROVED BOX & COVER


See Engineer's Approved List.

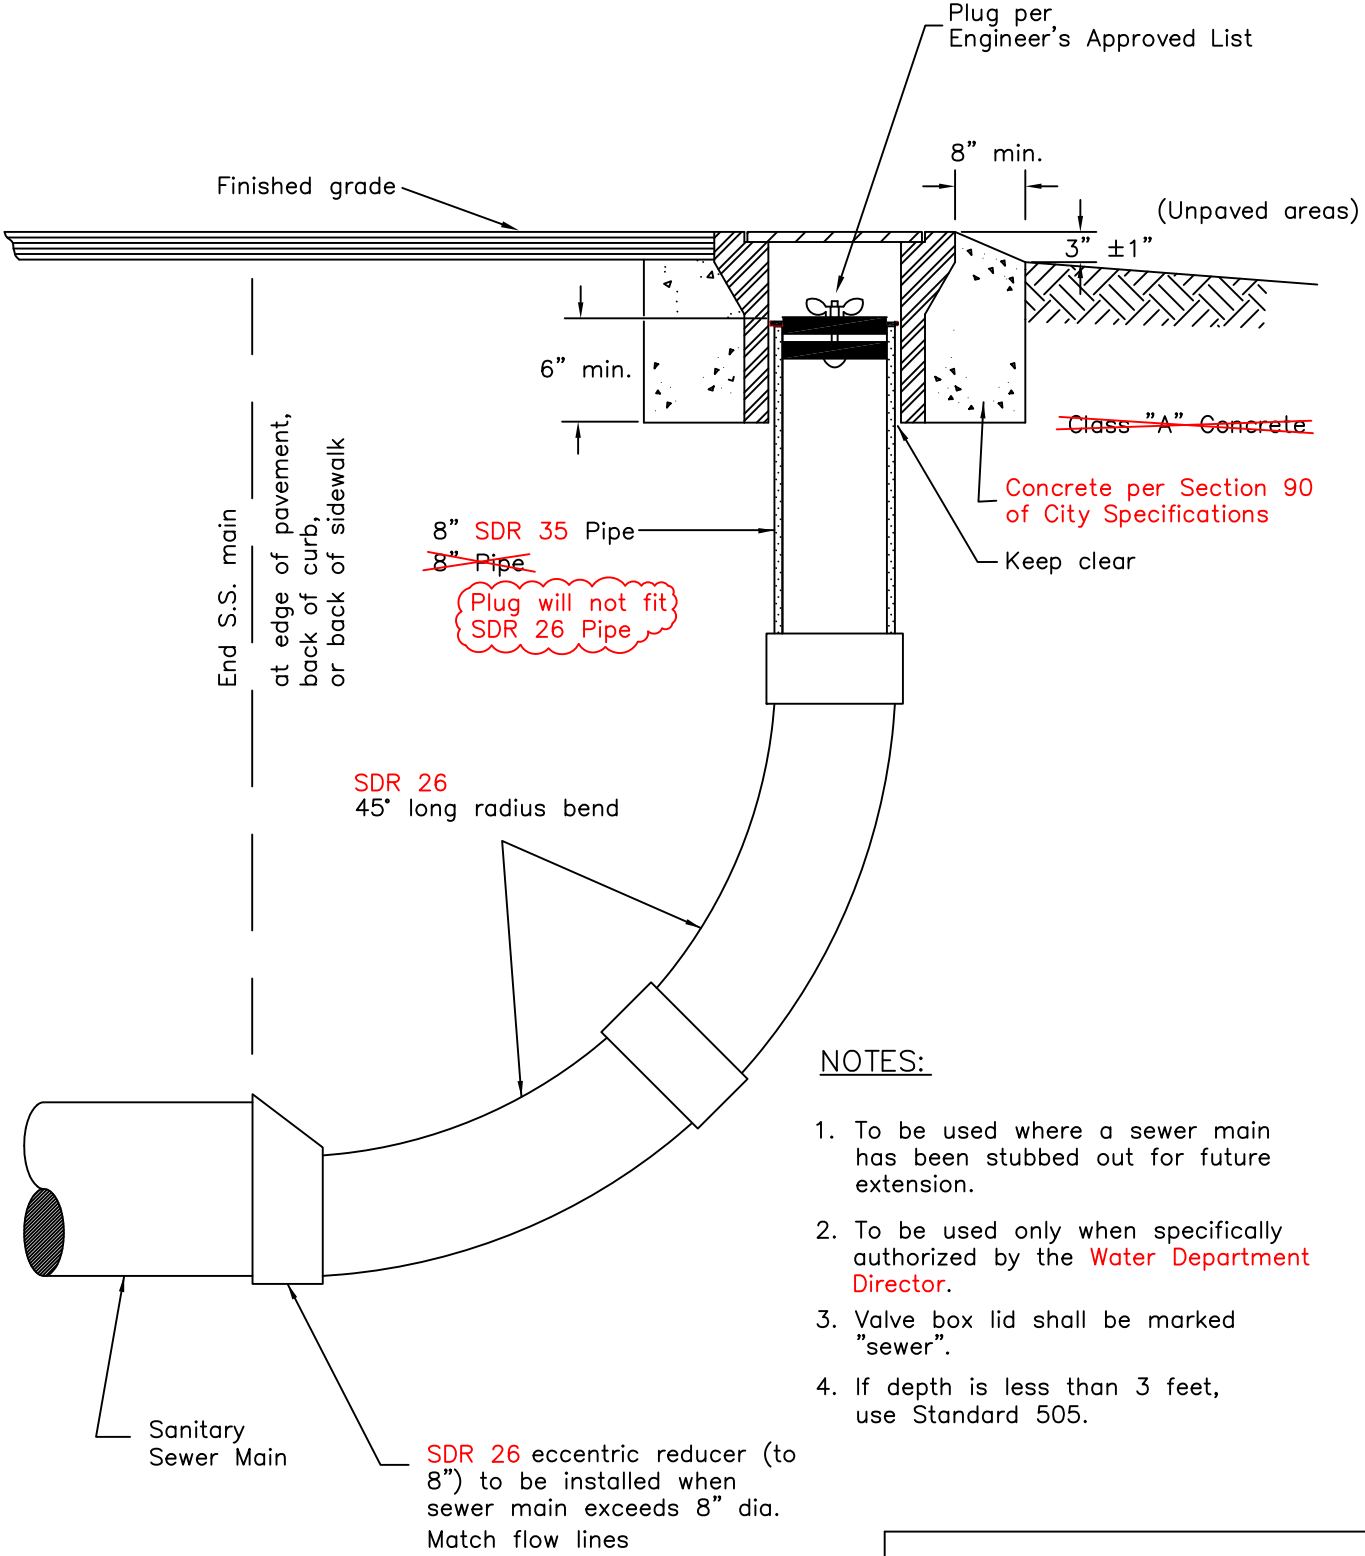


NOTES:

1. To be used where a sewer main has been stubbed out for future extension.
2. To be used only when specifically authorized by the **Water Department Director**.
3. Valve box lid shall be marked "sewer".
4. If depth is less than 3 feet, use Standard 505.

CITY OF SANTA ROSA		
TEMPORARY MAINLINE CLEANOUT		
SCALE: NONE	DATE: Mar. 2016	
DWN: GC RR CHK: AA	APPROVED	FILE NO. STD.- 506

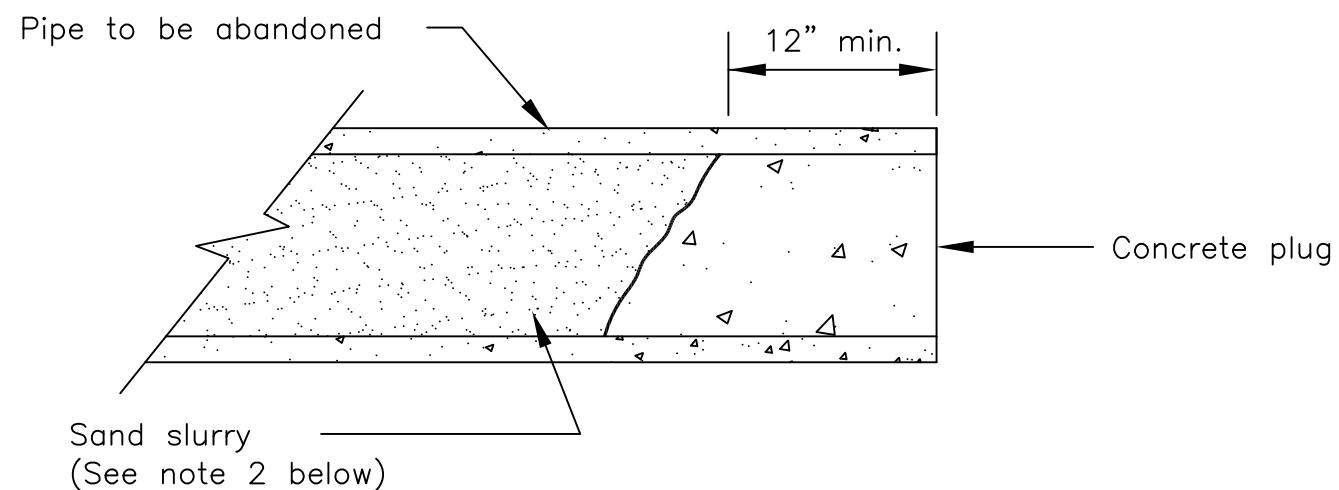

12" DIAMETER PIPE AND LARGER

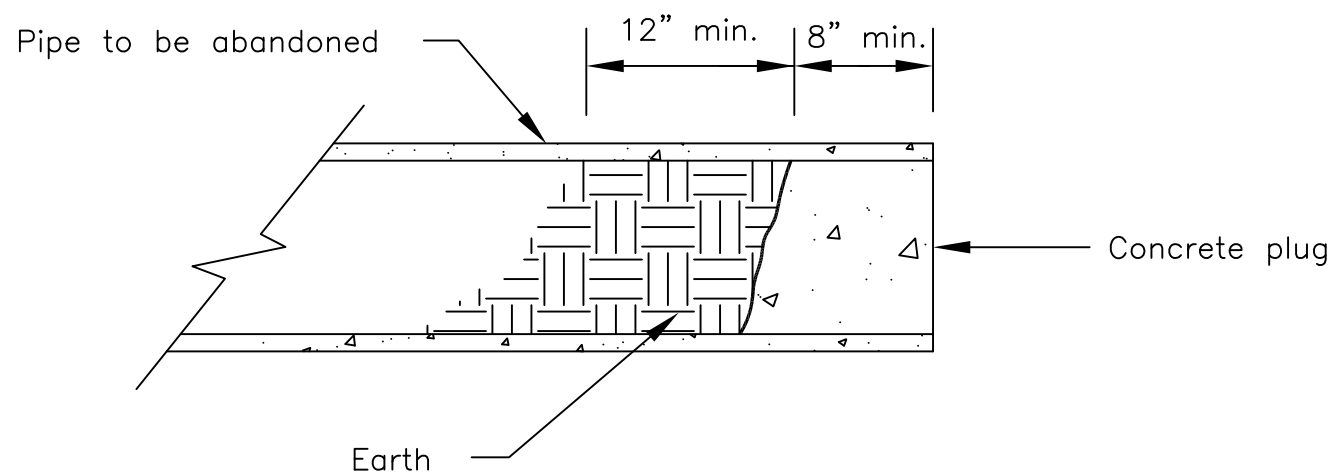

10" DIAMETER PIPE AND SMALLER

NOTES:


1. Pipe plugs shall be installed to the satisfaction of the Director of Utilities.
2. Abandoned pipes, 12" and larger, shall be broken into every 50' and shall be filled completely with sand slurry.

CITY OF SANTA ROSA


ABANDONED PIPE
PLUG

SCALE: NONE DATE: Sept.2002

DWN: GC CHK: RH APPROVED FILE NO. STD.- 507

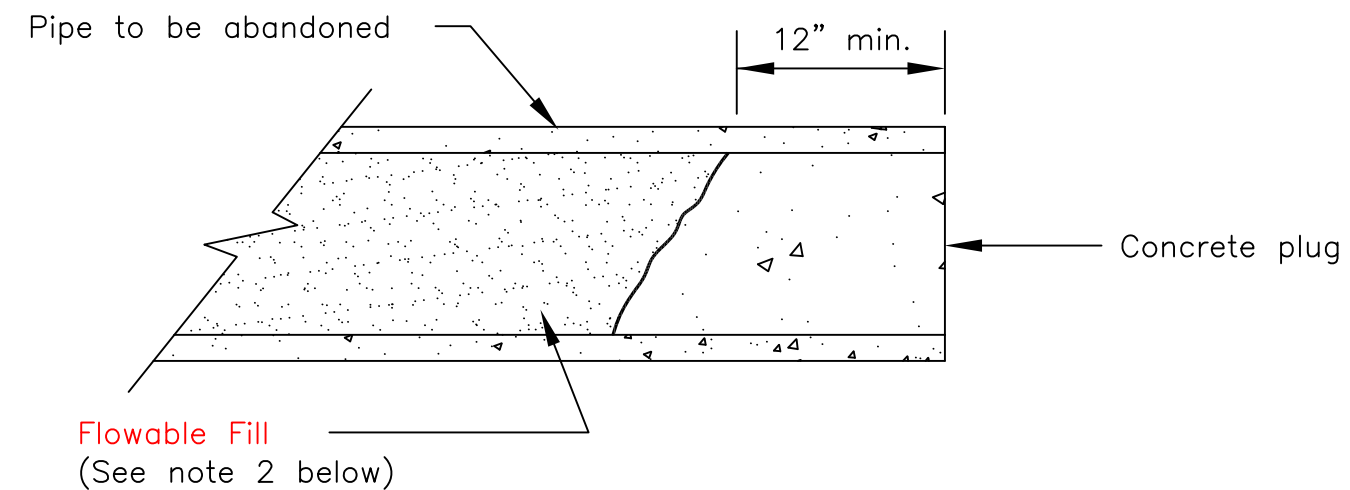

12" DIAMETER PIPE AND LARGER

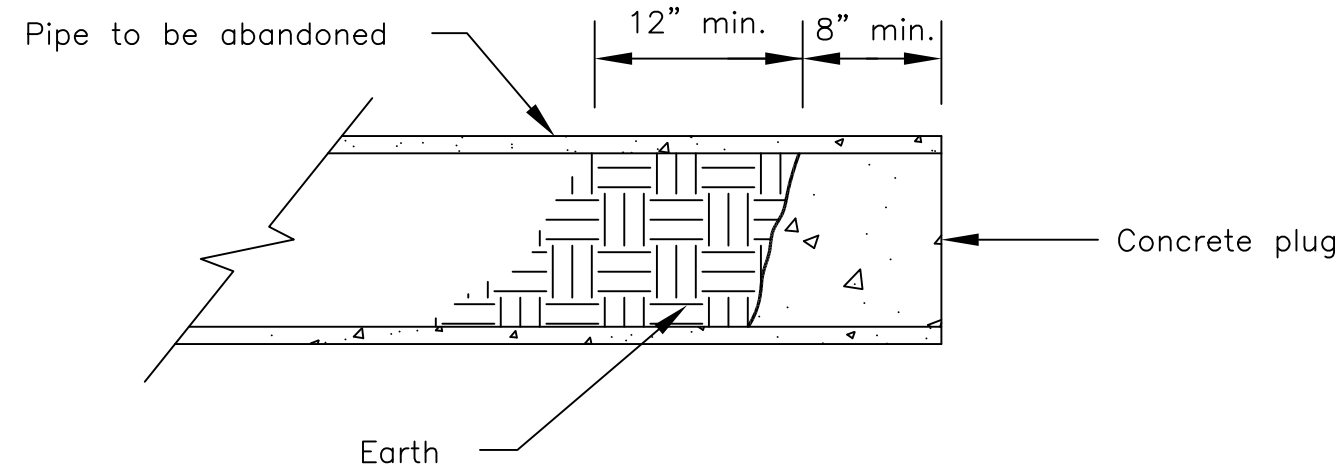

10" DIAMETER PIPE AND SMALLER

NOTES:


1. Pipe plugs shall be installed to the satisfaction of the **Water Department Director**.
2. Unless otherwise approved by the Director of Water abandoned pipes 12"Ø and larger shall be broken into every 50' and shall be filled completely with a flowable fill material approved by the City of Santa Rosa's Materials Engineer.

CITY OF SANTA ROSA

ABANDONED PIPE
PLUG

SCALE: NONE DATE: Mar. 2016

DWN: GC CHK: RH APPROVED FILE NO. STD.- 507

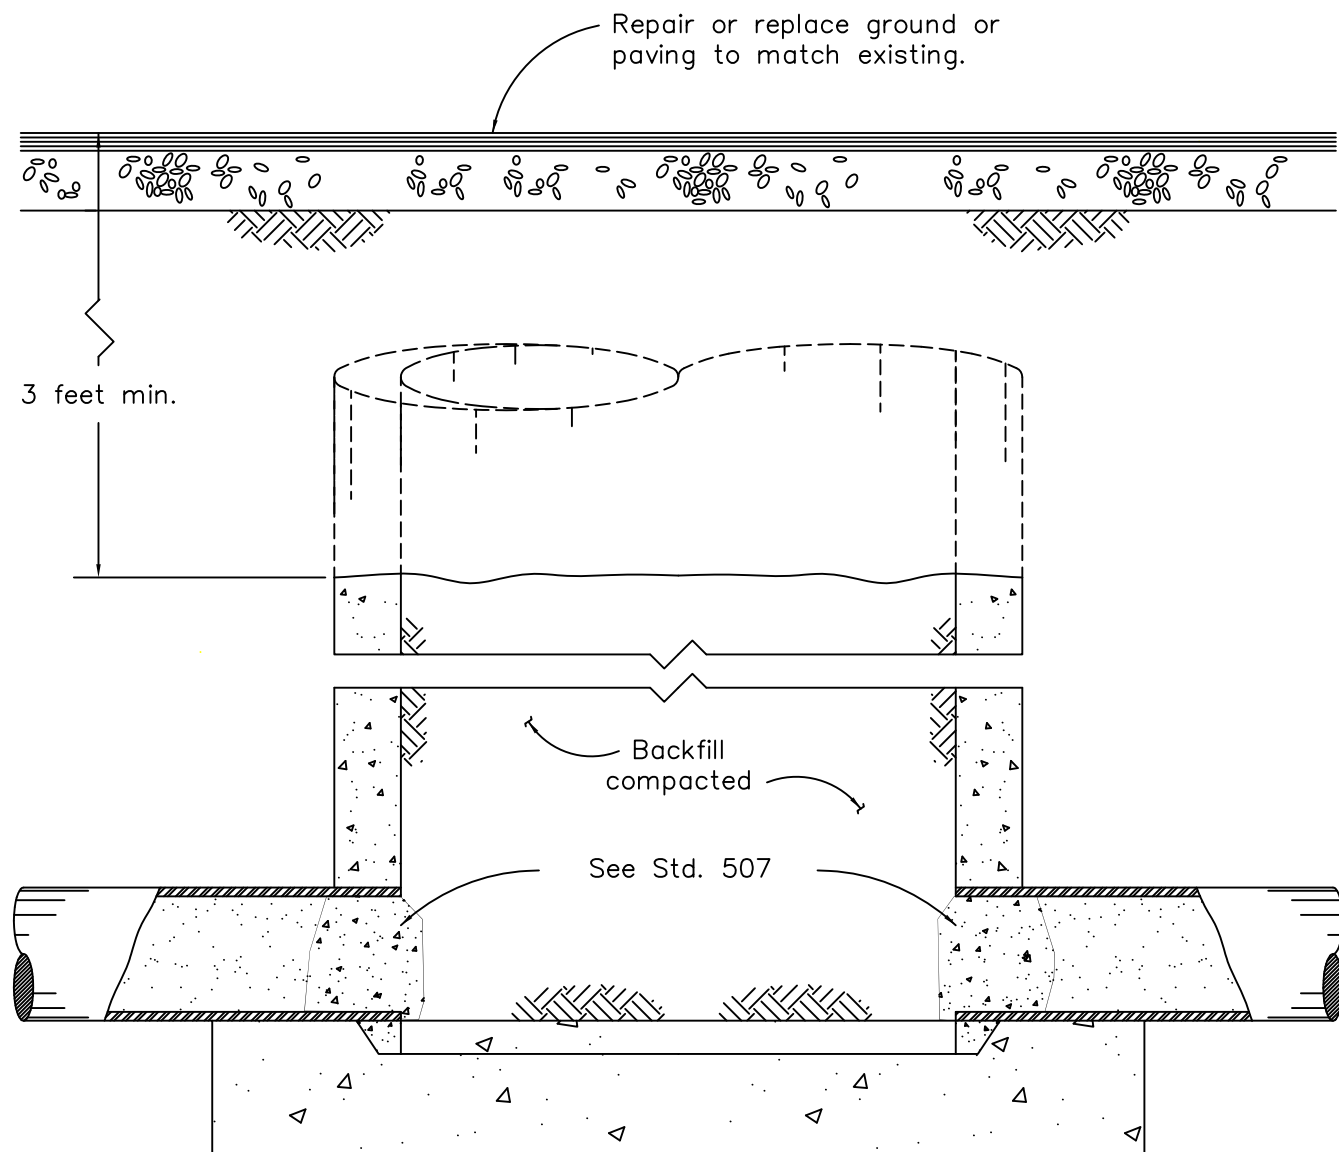

NOTES:


1. Remove frame, cover, taper and barrel sections as required to a minimum of 3' below finished grade.
2. After plugging all pipes in manhole, the remaining portion of the barrel section and all voids created by the removal of the upper portions of the manhole, shall be backfilled and compacted to 90% relative density. Use trench backfill or pipe bedding material per Std. 215.

CITY OF SANTA ROSA

ABANDONED MANHOLE

SCALE: NONE DATE: Sept.2002

DWN: AH APPROVED FILE NO. STD.- 508

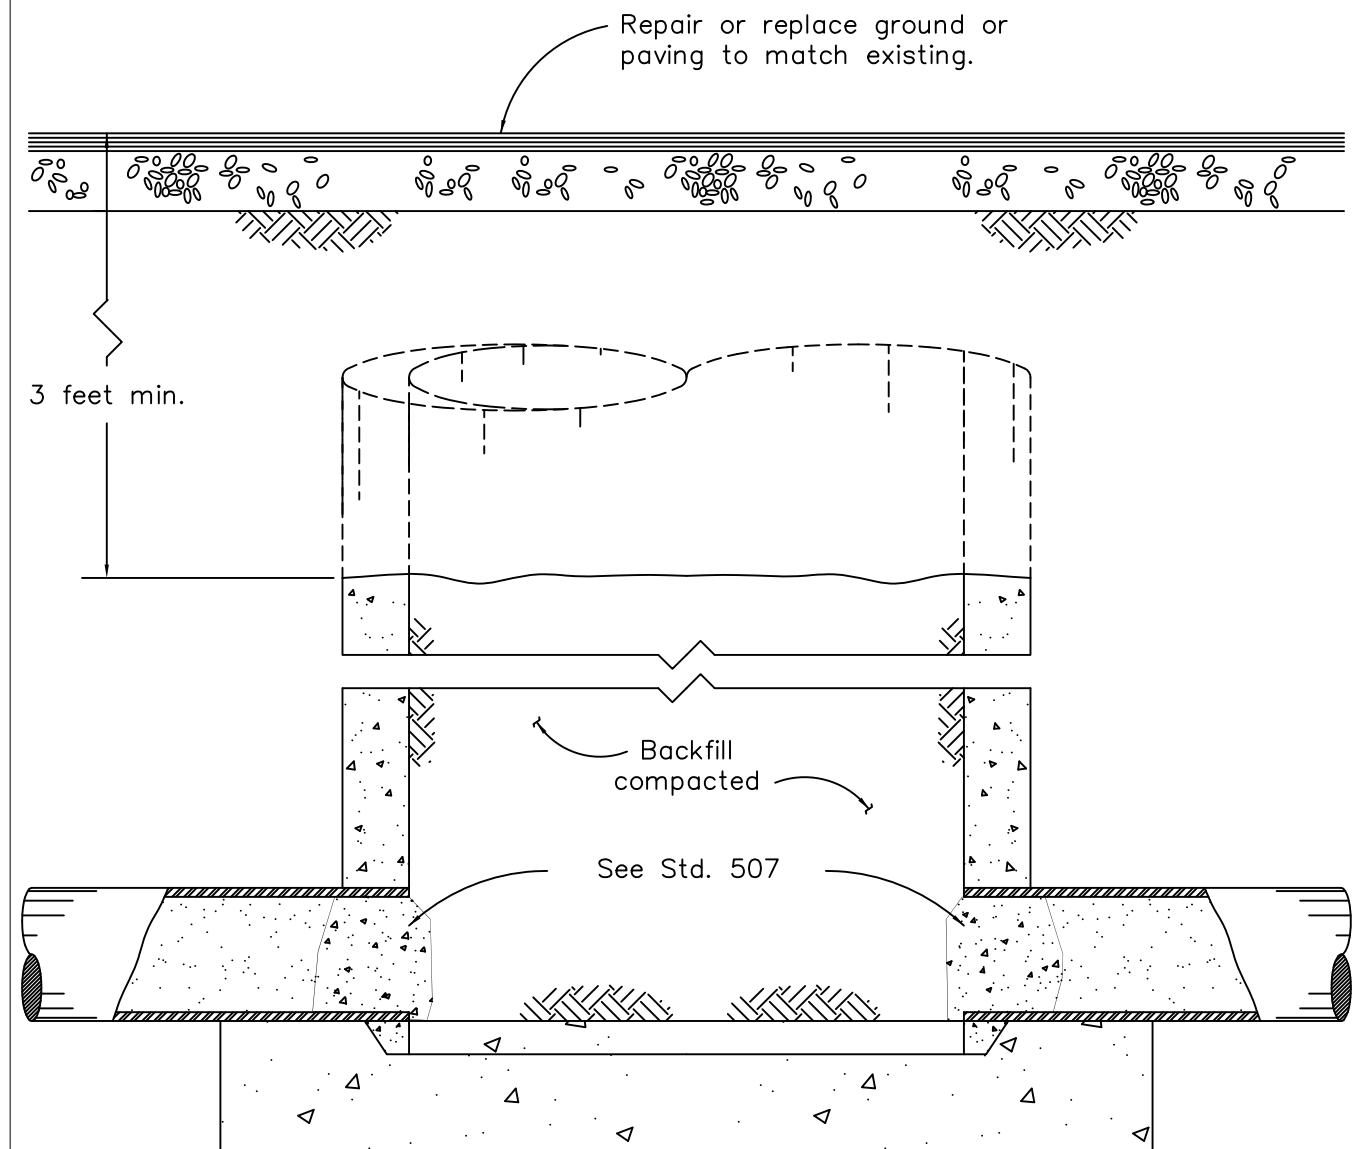

NOTES:


1. Remove frame, cover, taper and barrel sections as required to a minimum of 3' below finished grade.
2. After plugging all pipes in manhole, the remaining portion of the barrel section and all voids created by the removal of the upper portions of the manhole, shall be backfilled and compacted to 90% relative density. Use trench backfill or pipe bedding material per Std. 215.

CITY OF SANTA ROSA

ABANDONED MANHOLE

SCALE: NONE DATE: Mar. 2016

DWN: AH APPROVED FILE NO. STD.- 508

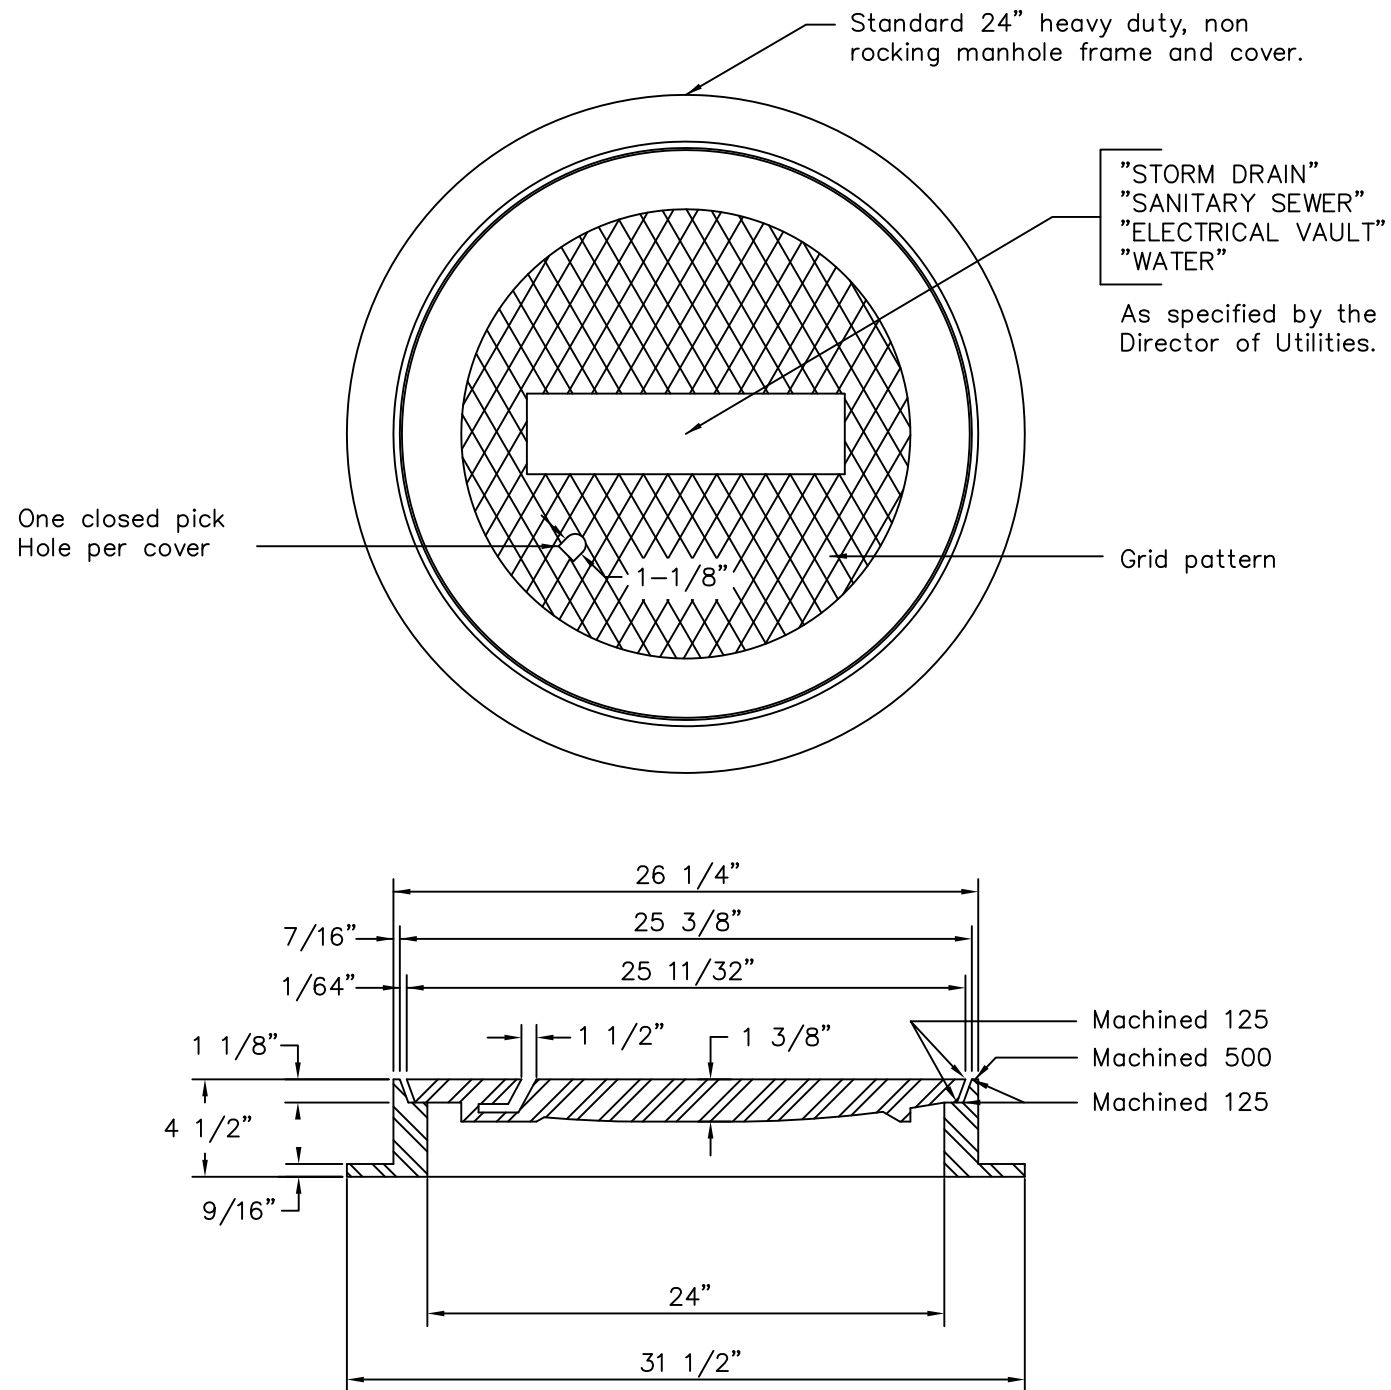

NOTES:

1. Specify sanitary sewer, storm drain, electrical vault, or water when ordering. All castings shall be dipped in approved ASPHALTUM or BITUMINOUS Paint.
2. All material used in manufacturing shall conform to A.S.T.M. designation A-48 Class 35 B, or of United States Government Specifications QQ1-652b.
3. Minimum weight components: Cover – 130 pounds
Frame – 135 pounds
4. Bolt down covers are required on all sewer mains located in easements, on school grounds, through parks, and on any trunk sewers larger than 12" in diameter. Coat the bolt threads on the final bolt up with "never cease" or teflon based pipe dope.


APPROVED MANHOLE FRAME & COVER

See Engineer's Approved List

CITY OF SANTA ROSA		
MANHOLE FRAME and COVER		
SCALE: NONE	DATE: Sept.2002	
DWN: AW CHK: RH	APPROVED	FILE NO. STD.- 512

APPROVED MANHOLE FRAME & COVER

See Engineer's Approved List

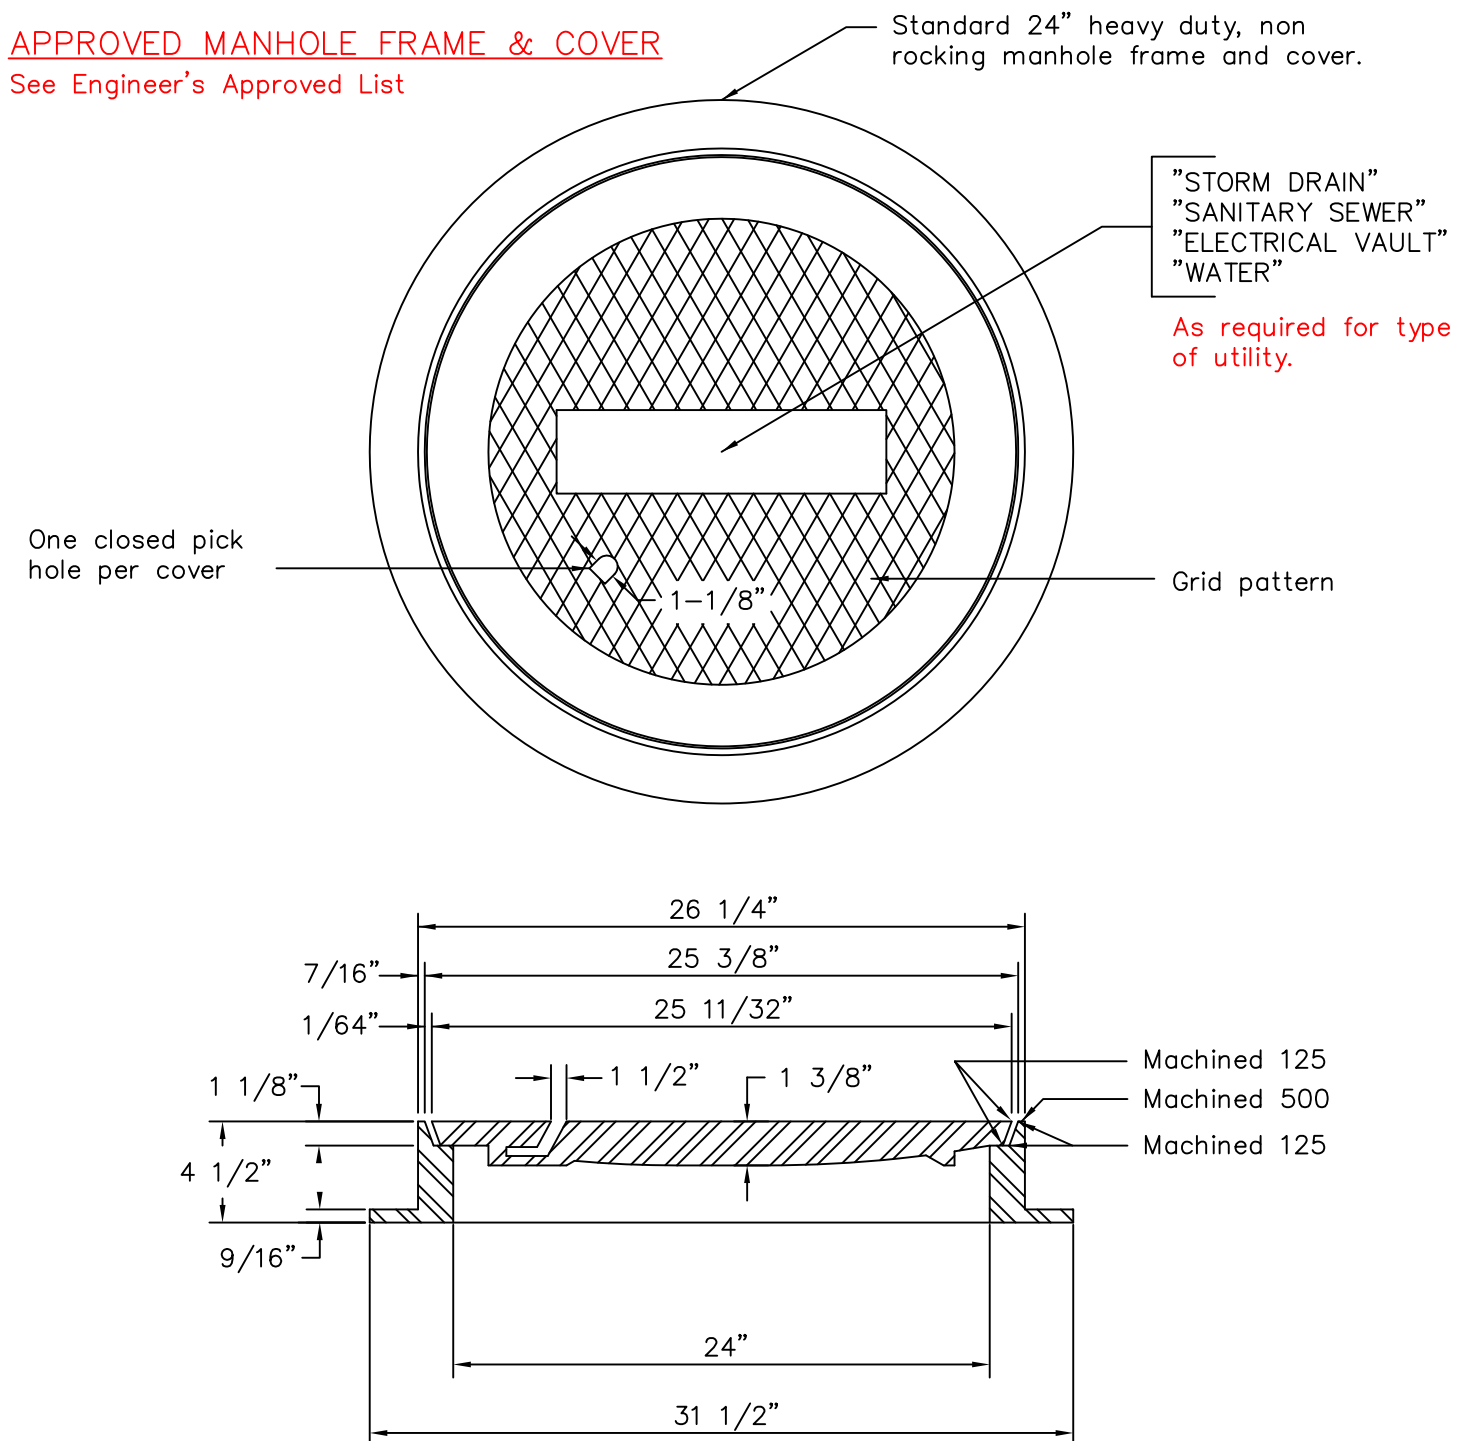


NOTES:

1. Specify sanitary sewer, storm drain, electrical vault, or water when ordering. All castings shall be dipped in approved ASPHALTUM or BITUMINOUS Paint.
2. All material used in manufacturing shall conform to A.S.T.M. designation A-48 Class 35 B, or of United States Government Specifications QQ1-652b.
3. Minimum weight components: Cover – 130 pounds
Frame – 135 pounds
4. Bolt down covers are required on all sewer mains located in easements, on school grounds, through parks, and on any manhole within 1000ft of a creek. Bolts shall be 1/2"Ø stainless steel with 3/4" hex head. Coat the bolt threads on the final bolt up with "anti-seize" or teflon based pipe dope.

CITY OF SANTA ROSA

MANHOLE FRAME and COVER

SCALE: NONE	DATE: Mar. 2016	
DWN: AW CHK: RH	APPROVED	FILE NO. STD.- 512

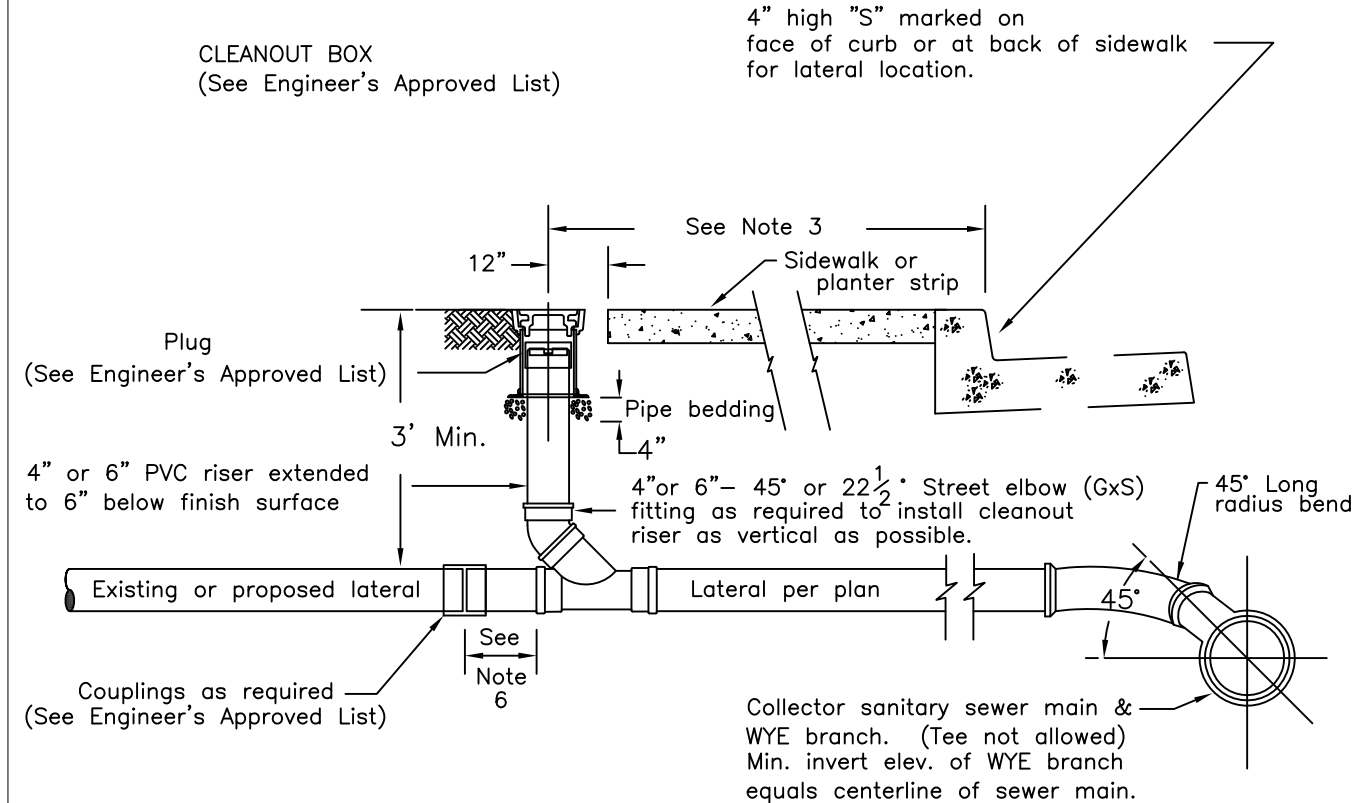

- NOTES:
1. The sewer service lateral shall be of sufficient depth to adequately serve the building site, and in no case shall be less than 3 FT. deep at the cleanout unless otherwise authorized by the Director of Utilities.
 2. Where problems are anticipated in providing sewer service to a given building site, the lateral invert at the cleanout shall be staked by the owner's engineer.
 3. Cleanout must be installed within the Public Right of Way or P.U.E. Cleanout to be installed 18" to 24" from the face of curb in the planter strip or 12" maximum behind a contiguous sidewalk. Where service is in driveway, install cleanout 18" to 24" behind apron.
 4. In cases where the cleanout installation conflicts with existing facilities, the contractor shall verify any alternate location with the Director of Utilities prior to installation.
 5. Minimum 2% slope for 4" laterals and a min. 1% slope for 6" laterals are required unless a variance is specifically approved by the Director of Utilities and the Building Official.
 6. A minimum of 12" when connecting to existing sewer lateral or extend to 1' behind P.U.E. or sidewalk for new construction.
 7. For new construction, install cap or plug at end of service lateral.
 8. Lateral material shall be PVC SDR 26 or SDR 35, or Ductile Iron pipe.
 9. Cleanout components shall be the same size as the lateral.
 10. Tap fittings on mains smaller than 12" may only be used under the approval of the Director of Utilities.

LATERAL CONNECTIONS TO EXISTING MAINS:

Main Size & Material	Connection Type	Couplings
6-10" ACP, VCP	Cut in PVC wye w/12" spools each end	Rubber w/Steel shear bands
6-10" PVC	Cut in PVC wye w/12" spools each end	Rigid slip couplings
6-10" DIP	Cut in DIP wye w/12" spools each end	DIP couplings
12" and larger	Tap fitting see Engineer's approved list	NA


CITY OF SANTA ROSA

4" & 6" SEWER SERVICE LATERAL and CLEANOUT

SCALE: NONE DATE: June 2009

DWN: GC RR APPROVED FILE NO. 513

CHK: AA

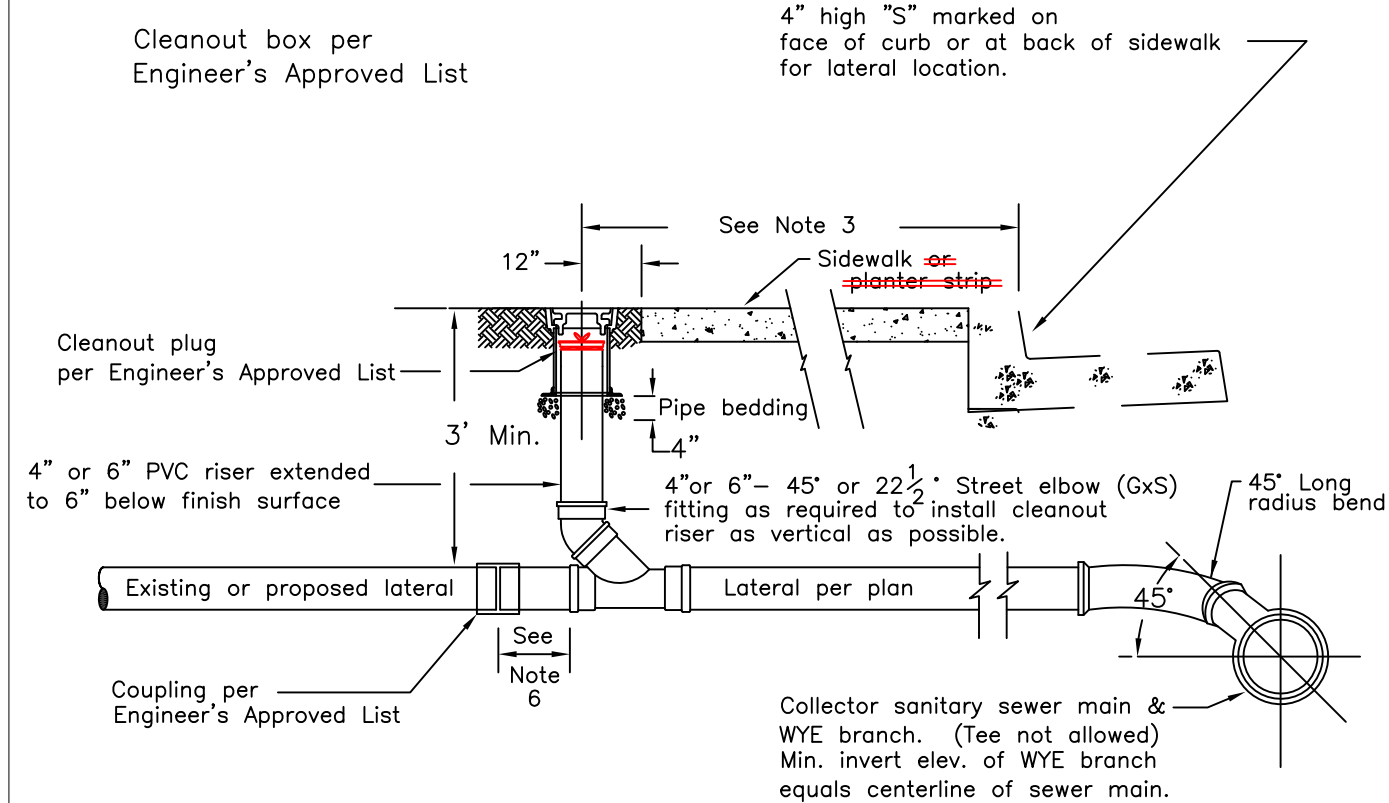

- NOTES:
1. The sewer service lateral shall be of sufficient depth to adequately serve the building site, and in no case shall be less than 3 FT. deep at the cleanout unless otherwise authorized by the Water Department Director.
 2. Where problems are anticipated in providing sewer service to a given building site, the lateral invert at the cleanout shall be staked by the owner's engineer.
 3. Cleanout must be installed within the Public Right of Way or P.U.E. Cleanout to be installed behind sidewalk or at back of P.U.E. Where lateral must be in a driveway, install cleanout at back of sidewalk.
 4. In cases where the cleanout installation conflicts with existing facilities, the contractor shall verify any alternate location with the City's Engineer prior to installation.
 5. Minimum 2% slope for 4" laterals and a min. 1% slope for 6" laterals are required unless a variance is specifically approved by the Water Department Director and the Building Official.
 6. A minimum of 12" when connecting to existing sewer lateral or extend to 1' behind P.U.E. or sidewalk for new construction.
 7. For new construction, cap or plug end of service lateral watertight.
 8. Lateral material shall be SDR 26 PVC or Ductile Iron pipe.
 9. Cleanout components shall be the same size as the lateral pipe, and all PVC fittings shall be SDR 26.
 10. Tap fittings on mains smaller than 12" may only be used under the approval of the Water Department Director.

LATERAL CONNECTIONS TO EXISTING MAINS:

Main Size & Material	Connection Type	Couplings
6-10" ACP, VCP	Cut in PVC wye w/18" spools each end	Rubber w/Steel shear bands
6-10" PVC	Cut in PVC wye w/18" spools each end	Rigid slip couplings
6-10" DIP	Cut in DIP wye w/18" spools each end	DIP couplings
12" and larger	Tap fitting see Engineer's approved list	NA


CITY OF SANTA ROSA

4" & 6" SEWER SERVICE LATERAL and ONE WAY CLEANOUT

SCALE: NONE DATE: Mar. 2016

DWN: GC RR APPROVED FILE NO. 513

CHK: AA

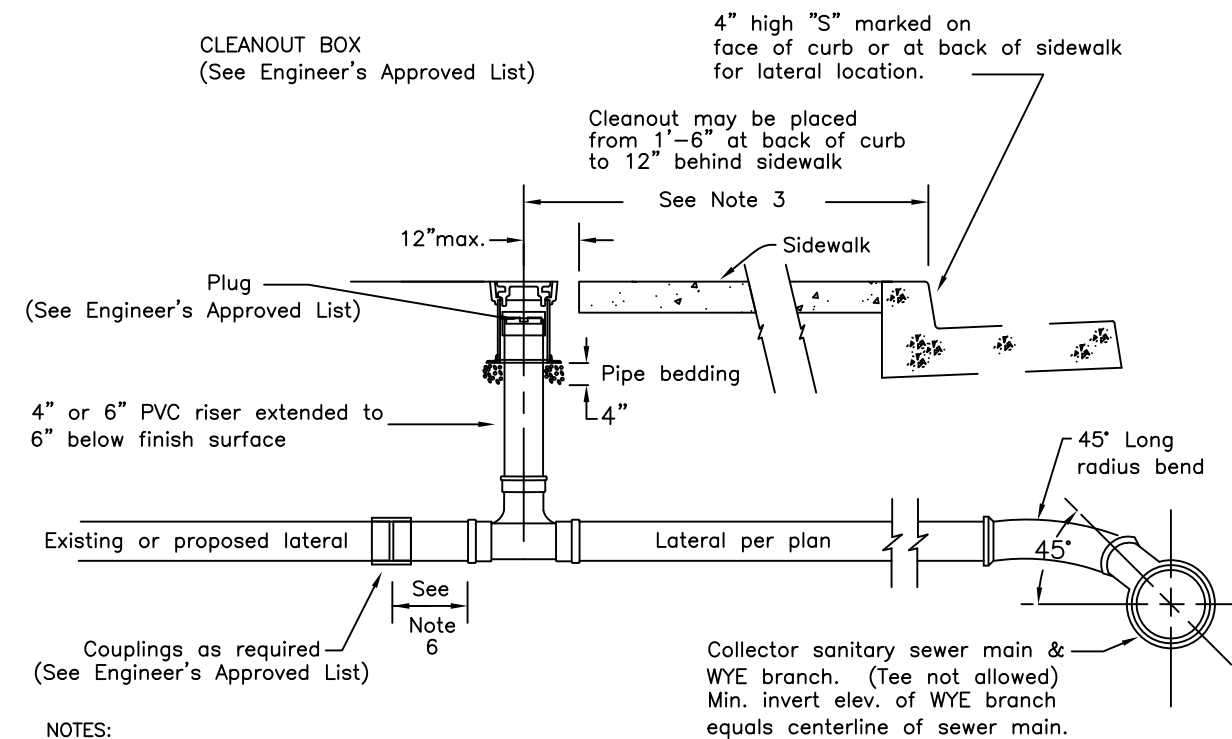


- NOTES:

1. The sewer service lateral shall be of sufficient depth to adequately serve the building site, and in no case shall be less than 3 FT. deep at the back of the P.U.E. unless matching existing conditions on rehabilitation projects or as otherwise authorized by the Director of Utilities.
2. Where problems are anticipated in providing sewer service to a given building site, the lateral invert at the back of the P.U.E. shall be staked by the owner's engineer.
3. Cleanout must be installed within the Public Right of Way or P.U.E. Cleanout to be installed 18" to 24" from face of curb in planter strip or 12" maximum behind a contiguous sidewalk. Where service is in driveway, install cleanout 18" to 24" behind apron.
4. In cases where the cleanout installation conflicts with existing facilities, the contractor shall verify any alternate location with the City Engineer prior to installation.
5. Minimum 2% slope for 4" laterals and a min. 1% slope for 6" laterals are required unless a variance is specifically approved by the Director of Utilities and the Building Official.
6. A minimum of 12" when connecting to existing sewer lateral or extend to 1' behind P.U.E. or sidewalk for new construction.
7. For new construction, install cap or plug at end of service lateral.
8. Lateral material shall be PVC SDR 26, SDR 35 or Ductile Iron pipe. Riser pipe shall be SDR 26 or SDR 35.
9. Cleanout components shall be the same size as the lateral.
10. For depths greater than 5 feet (at cleanout), install a one way cleanout per City STD 513.
11. Use a one way cleanout where the riser must be installed greater than 10' from vertical unless otherwise directed by the Engineer.
12. Where note says to "See Engineer's Approved List" refer to list for City STD-513

LATERAL CONNECTIONS TO EXISTING MAINS:

Main Size & Material	Connection Type	Couplings
6-10" ACP, VCP	Cut in PVC wye w/12" spoofs each end	Rubber w/Steel shear bands
6-10" PVC	Cut in PVC wye w/12" spoofs each end	Rigid slip couplings
6-10" DIP	Cut in DIP wye w/12" spoofs each end	DIP couplings
12" and larger	Tap fitting see Engineer's approved list	NA

<i>CITY OF SANTA ROSA</i>		
4" & 6" SEWER TWO WAY SERVICE LATERAL and CLEANOUT		
SCALE: NONE	DATE: June 2009	
DWN: DK RR CHK: AA	APPROVED	FILE NO. STD. 513 A

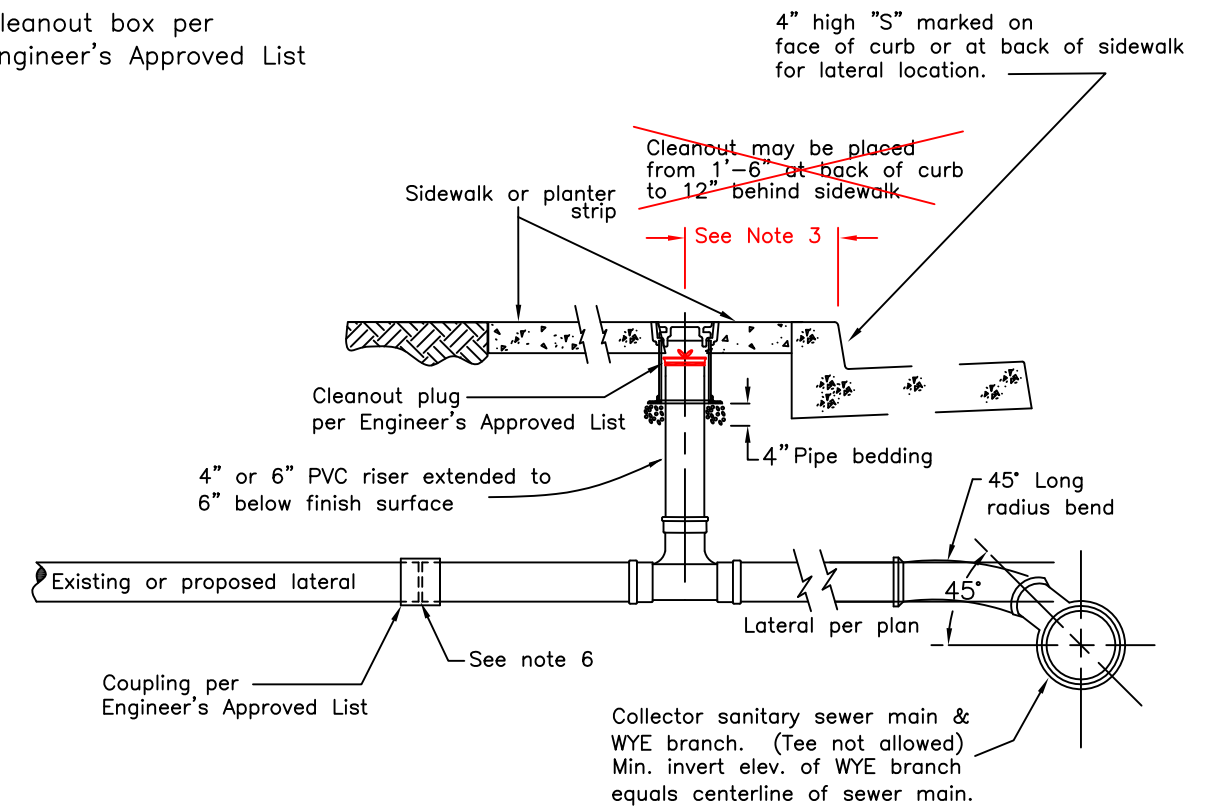


- NOTES:

1. The sewer service lateral shall be of sufficient depth to adequately serve the building site, and in no case shall be less than 3 FT. deep at the back of the P.U.E. unless matching existing conditions on rehabilitation projects or as otherwise authorized by the **Water Department Director**.
2. Where problems are anticipated in providing sewer service to a given building site, the lateral invert at the back of the P.U.E. shall be staked by the Owner's Engineer.
3. Cleanout must be installed within the Public Right of Way or P.U.E. Install 18" to 24" behind face of curb if field conditions allow. If unable to install 18" to 24" behind face of curb, install behind sidewalk to a maximum of 12". Where service is in driveway, install at back of sidewalk.
4. In cases where the cleanout installation conflicts with existing facilities, the contractor shall verify any alternate location with the City's Engineer prior to installation.
5. Minimum 2% slope for 4" laterals and a min. 1% slope for 6" laterals are required unless a variance is specifically approved by the Water Department Director and the Building Official.
6. If connecting to an existing lateral, tie in at a minimum of 12" behind sidewalk or P.U.E. If new construction, and property lateral is not yet installed, extend to 1' behind sidewalk or P.U.E. and cap or plug watertight.
7. Lateral material shall be SDR 26 PVC or Ductile Iron pipe. Riser pipe shall be SDR 26 or 35.
8. Cleanout components shall be the same size as the lateral pipe, and all PVC fittings shall be SDR 26.
9. If cover, at cleanout, is 5' or greater, or riser pipe must be installed more than 5' from vertical, construct sewer lateral per STD-513 with one way cleanout behind sidewalk or P.U.E.
10. Where note says to "See Engineer's Approved List" refer to list for City STD-513

LATERAL CONNECTIONS TO EXISTING MAINS:

Main Size & Material	Connection Type	Couplings
6-10" ACP, VCP	Cut in PVC wye w/18" spools each end	Rubber w/Steel shear bands
6-10" PVC	Cut in PVC wye w/18" spools each end	Rigid slip couplings
6-10" DIP	Cut in DIP wye w/18" spools each end	DIP couplings
12" and larger	Tap fitting: see Engineer's approved list	NA

CITY OF SANTA ROSA		
4" & 6" SEWER TWO WAY SERVICE LATERAL and TWO WAY CLEANOUT		
SCALE: NONE	DATE: Mar. 2016	
DWN: DK RR CHK: AA	APPROVED	FILE NO. STD. 513 A

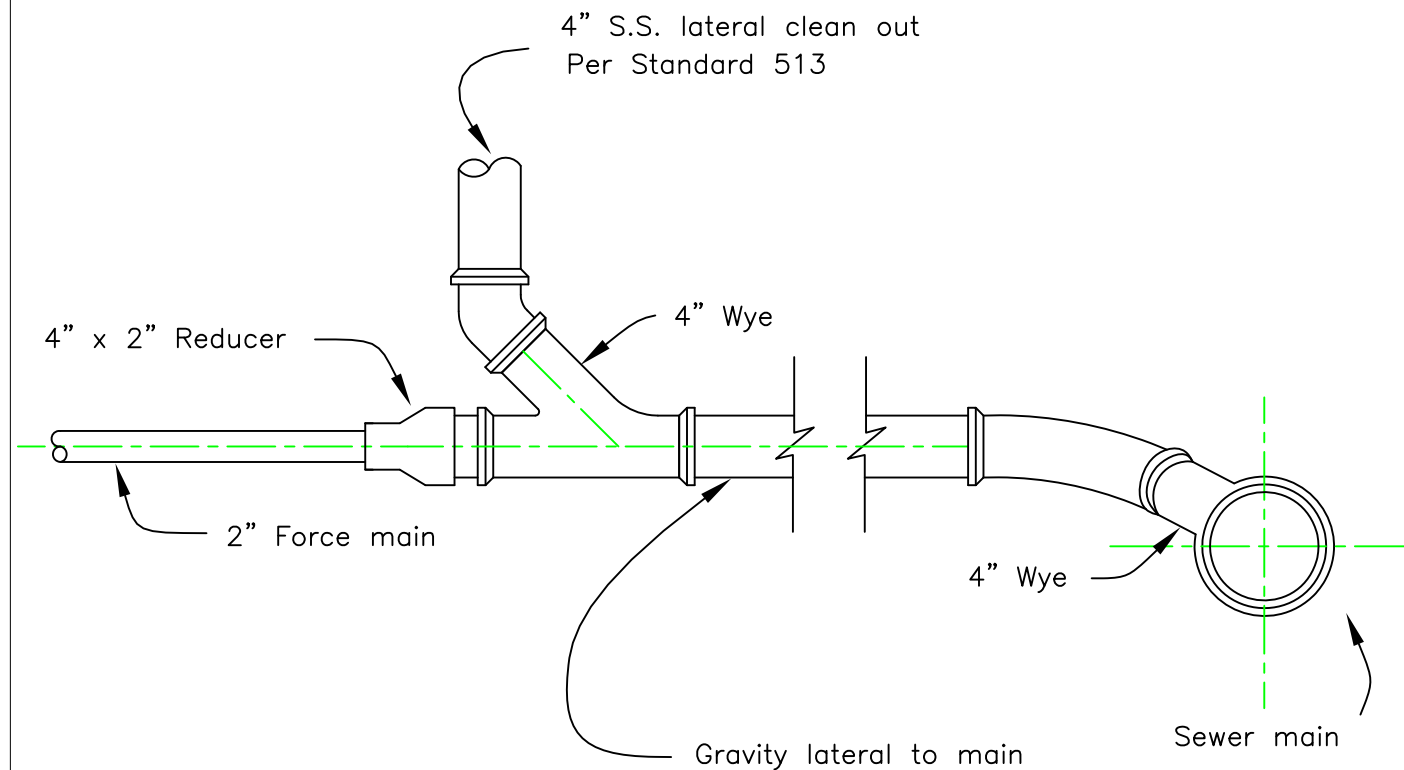

NOTES


1. Must be used for all private sewage lift station discharges. No discharges may be made directly to the collector sewer, trunk sewer, or manhole.
2. Any alternate design must be approved by the Director of Utilities.
3. Construction details, slope and materials conform to Std. #513.

CITY OF SANTA ROSA

DISCHARGE for
PRIVATE FORCE MAIN

SCALE: NONE DATE: Sept. 2002

DWN: GC	APPROVED	FILE NO.
CHK: RH		STD.- 515

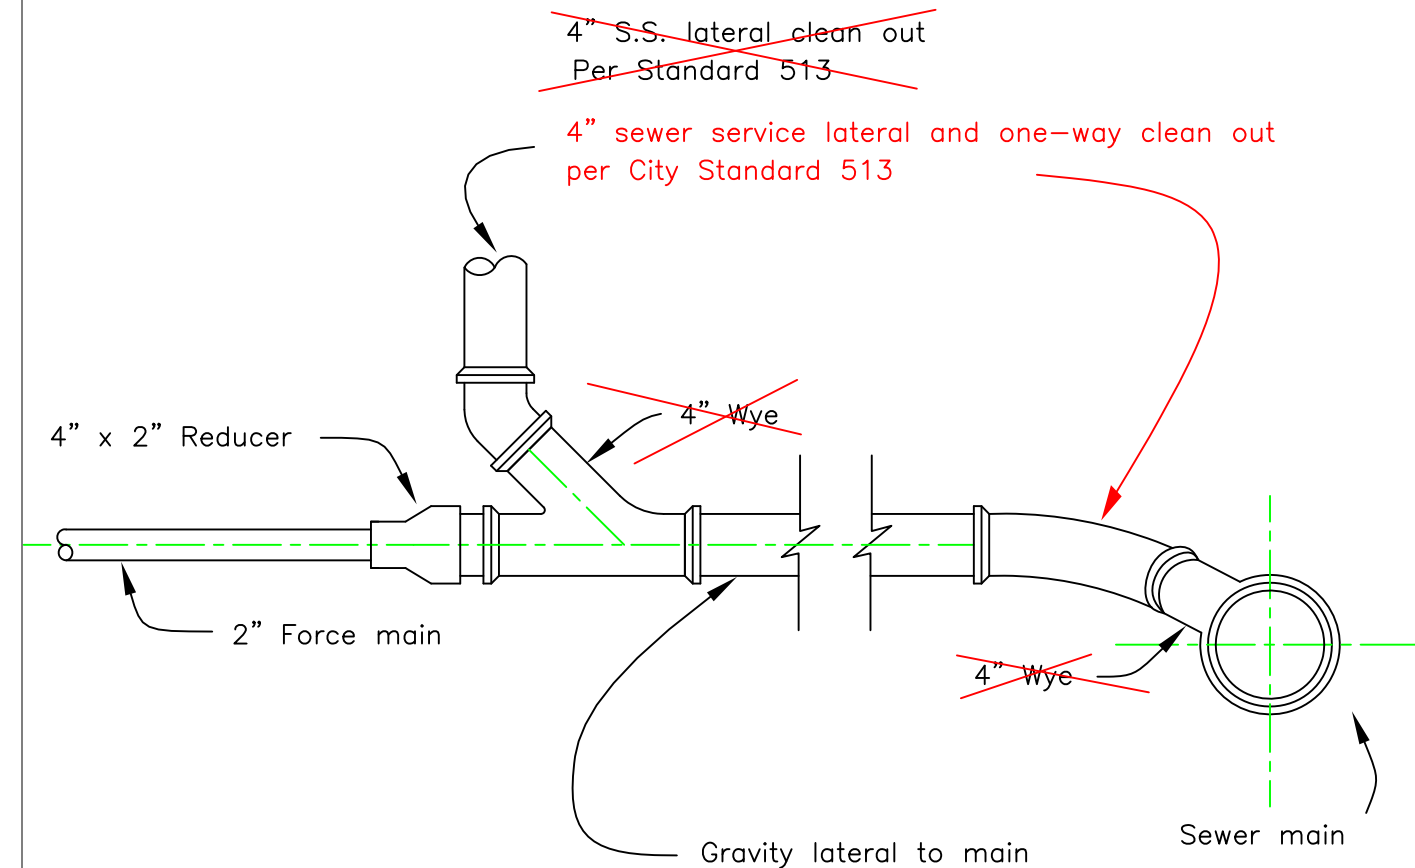

NOTES


1. Must be used for all private sewage lift station discharges. No discharges may be made directly to the collector sewer, trunk sewer, or manhole.
2. Any alternate design must be approved by the Water Department Director.
3. Construction details, slope and materials conform to STD-513.

CITY OF SANTA ROSA


DISCHARGE for
PRIVATE FORCE MAIN

SCALE: NONE DATE: Mar. 2016

DWN: GC	APPROVED	FILE NO.
CHK: RH		STD.- 515

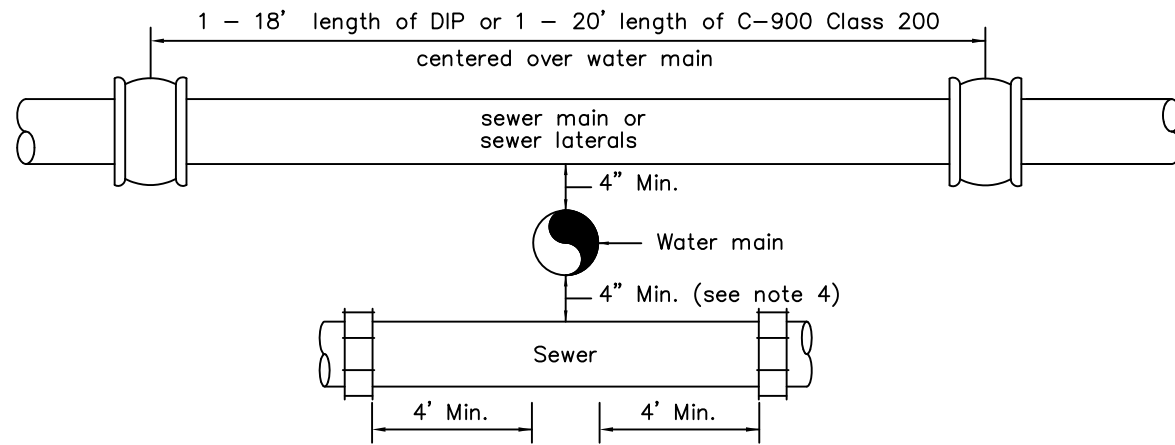

SEWER OVER OR UNDER WATER

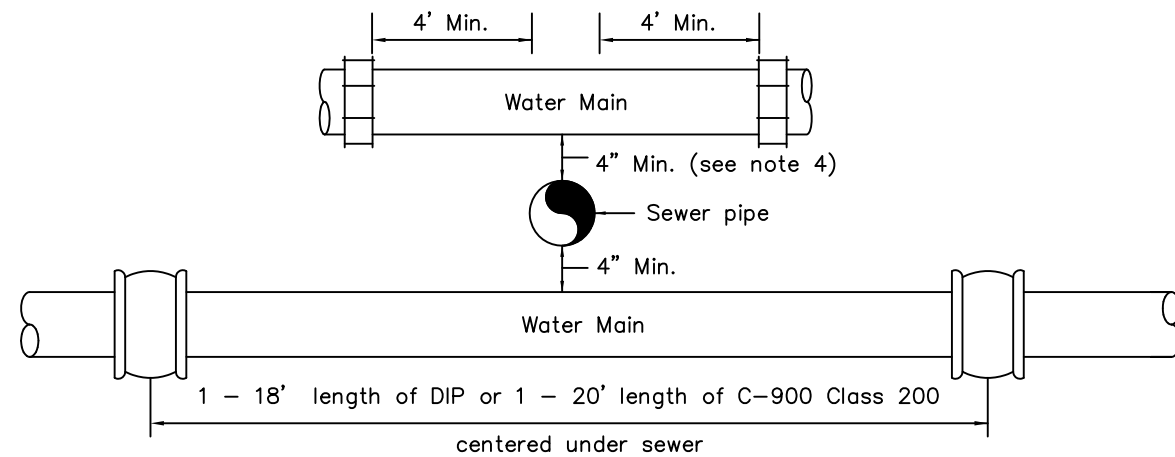

WATER OVER OR UNDER SEWER

NOTES:

1. All installations shall conform to the State of California Dept. of Health Services "Criteria For The Separation of Water Mains & Sanitary Sewers".
2. This Standard applies to pipes less than 24" in diameter. All crossings of larger diameter shall be as approved by the Director of Utilities.
3. All new Ductile Iron shall be wrapped in polyethylene per City of Santa Rosa Construction Specifications.
4. Per State Std.'s, a min. 4" clearance is required where sewer crosses below a water main. Where there is 1' or more vertical clearance, no special installation is required.
5. Any pipe / pipe crossings with less than 6" vertical clearance shall be padded with styrofoam, felt expansion joint material, or other expansive materials between pipes as approved by the Director of Utilities.


APPROVED COUPLINGS
See Engineer's Approved List

CITY OF SANTA ROSA


SEWER-WATER MAIN
CROSSING DETAILS

SCALE: NONE DATE: Sept.2002

DWN: APPROVED FILE NO.
CHK: RH STD.- 516

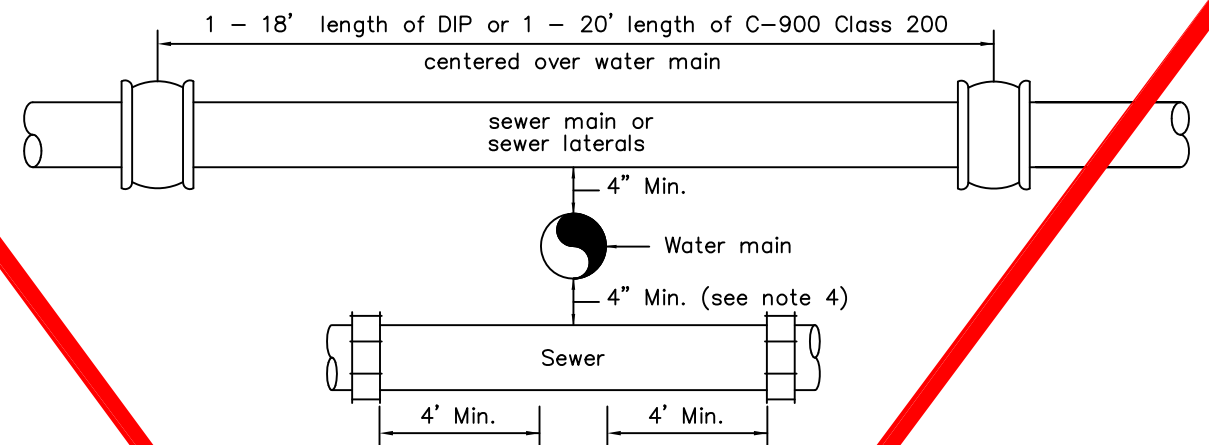

SEWER OVER OR UNDER WATER

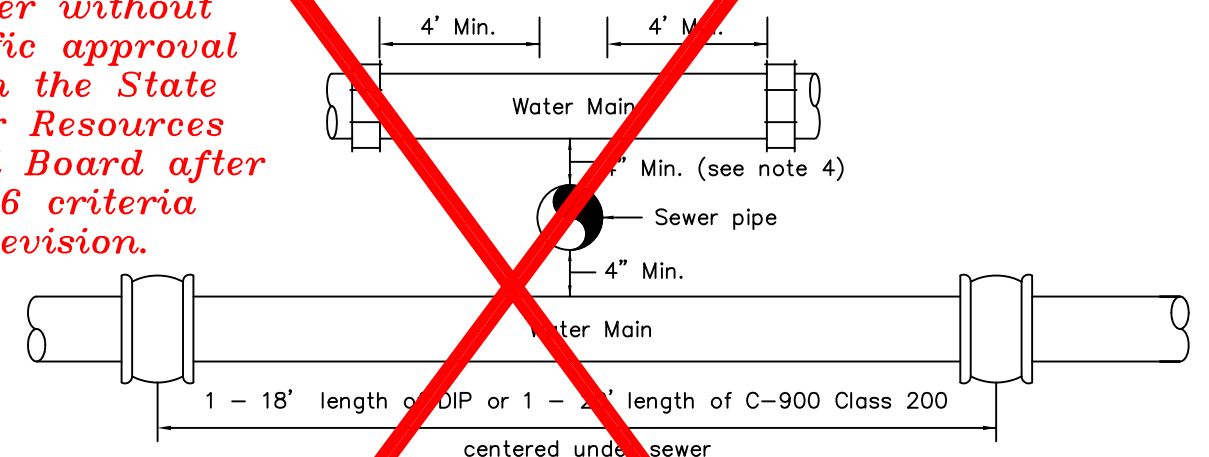

WATER OVER OR UNDER SEWER

NOTES:

1. All installations shall conform to the State of California Dept. of Health Services "Criteria For The Separation of Water Mains & Sanitary Sewers".
2. This Standard applies to pipes less than 24" in diameter. All crossings of larger diameter shall be as approved by the Director of Utilities.
3. All new Ductile Iron shall be wrapped in polyethylene per City of Santa Rosa Construction Specifications.
4. Per State Std.'s, a min. 4" clearance is required where sewer crosses below a water main. Where there is 1' or more vertical clearance, no special installation is required.
5. Any pipe / pipe crossings with less than 6" vertical clearance shall be padded with styrofoam, felt expansion joint material, or other expansive materials between pipes as approved by the Director of Utilities.

APPROVED COUPLINGS
See Engineer's Approved List


CITY OF SANTA ROSA

SEWER-WATER MAIN
CROSSING DETAILS


SCALE: NONE DATE: Sept.2002

DWN: APPROVED FILE NO.
CHK: RH STD.- 516


Not allowed any longer without specific approval from the State Water Resources Control Board after 2016 criteria revision.

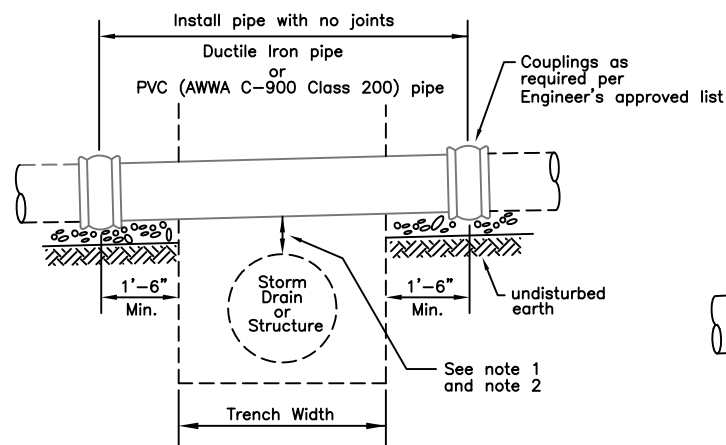


INSTALLATION OVER
PIPE OR STRUCTURE

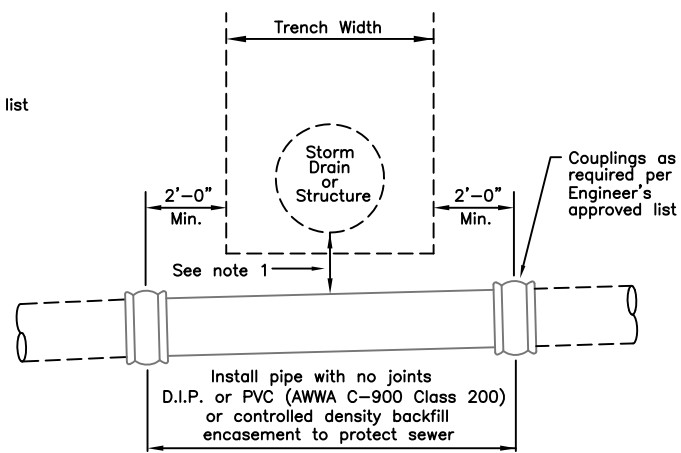


INSTALLATION UNDER
PIPE OR STRUCTURE

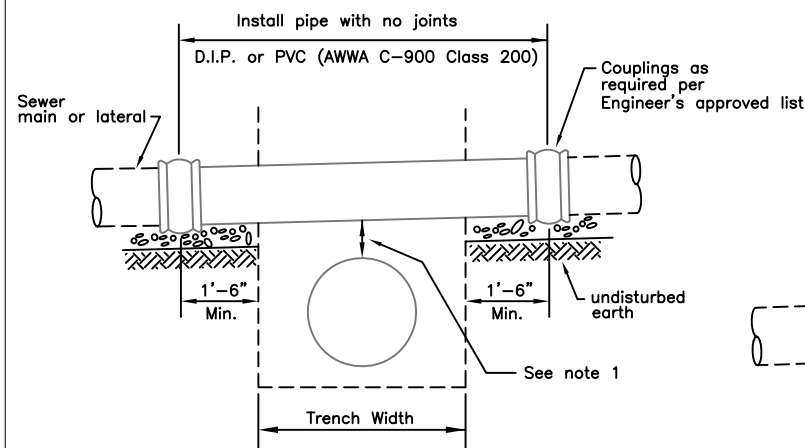

INSTALLATION OF PIPE OR STRUCTURE
UNDER SANITARY SEWER

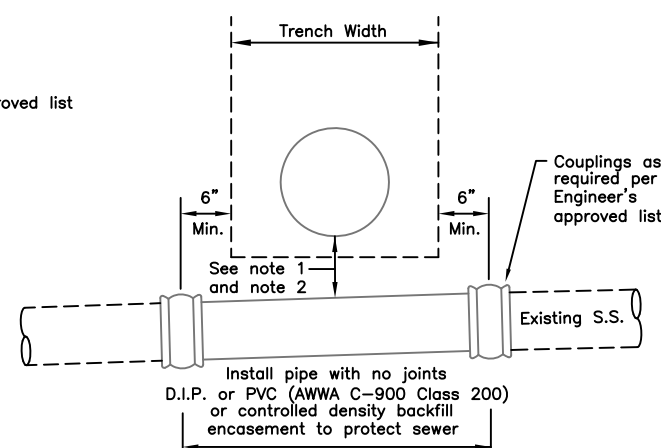

INSTALLATION OF PIPE OR STRUCTURE
OVER SANITARY SEWER

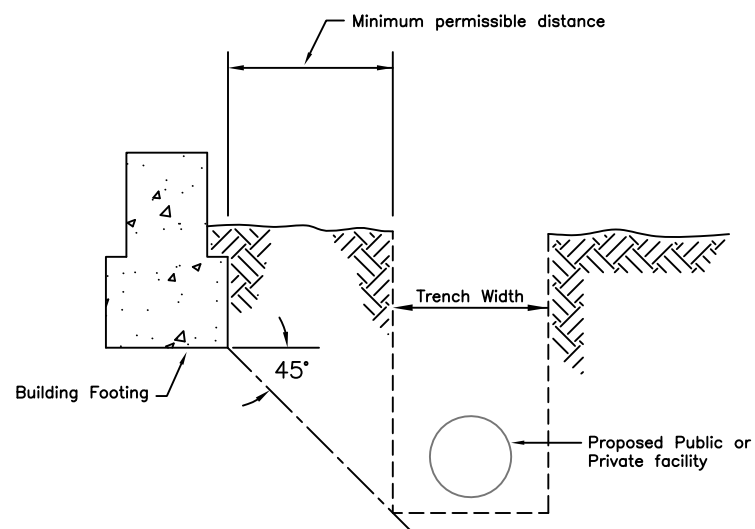

DETAIL OF BUILDING SETBACK
FROM UNDERGROUND UTILITY

* NOTE: REQUIRED PER UNIFORM PLUMBING CODE SECTION 315.1

NOTES:

- 1" minimum vertical clearance is required between pipes. Where clearance is less than 6", install felt expansion material or styrofoam between pipes.
- This installation detail is required only if clearance is less than 1'.
- Ductile Iron pipe shall be encased in polyethylene film per City of Santa Rosa Construction Specifications.

CITY OF SANTA ROSA

MISCELLANEOUS PIPE
INSTALLATION DETAILS


SCALE: NONE DATE: Sept.2002

DWN: GC
CHK: RH


APPROVED

FILE NO.

STD.- 517

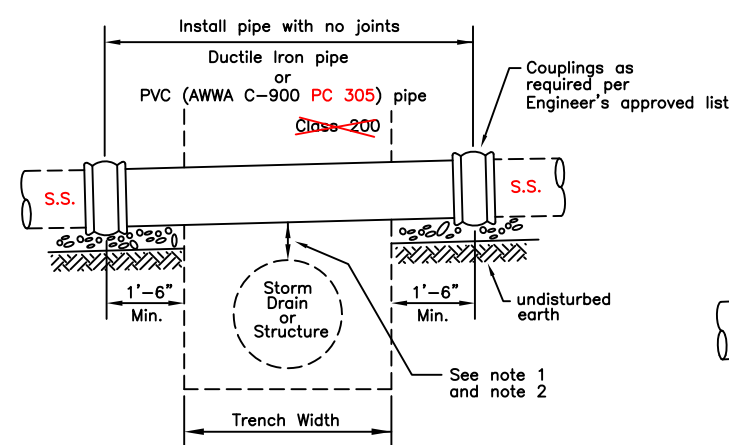


INSTALLATION OVER
PIPE OR STRUCTURE

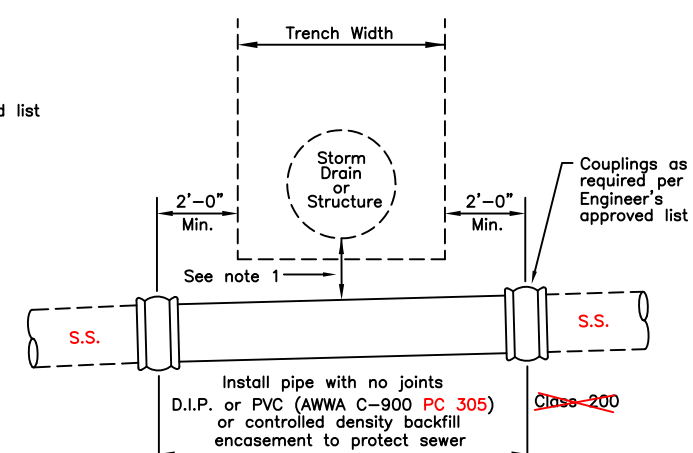


INSTALLATION UNDER
PIPE OR STRUCTURE

S.S. = Sanitary Sewer

KEEP ABOVE BOX.
Changed "Existing Sewer to "S.S."
because criteria should apply to
new installations as well.

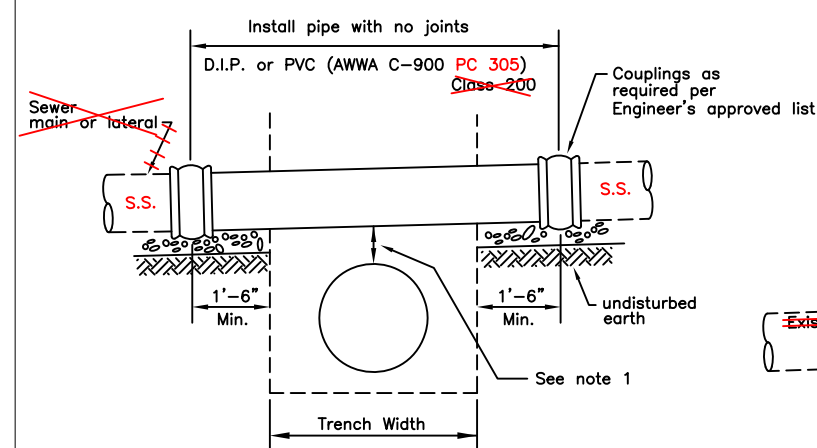


INSTALLATION OF PIPE OR STRUCTURE
UNDER SANITARY SEWER

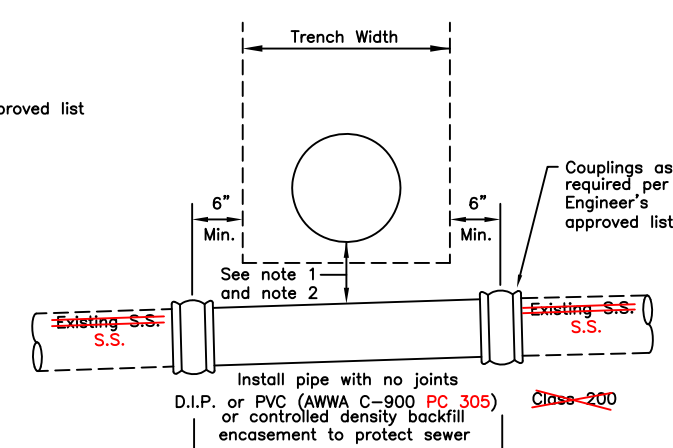

INSTALLATION OF PIPE OR STRUCTURE
OVER SANITARY SEWER

NOTES:

- 1" minimum vertical clearance is required between pipes. Where clearance is less than 6", install felt expansion material or styrofoam between pipes.
- This installation detail is required only if clearance is less than 1'.
- Ductile Iron pipe shall be encased in polyethylene film per City of Santa Rosa Construction Specifications.
- Sewer/Water separation criteria are not part of this City Standard. See Appendix "A" of the City's Water Distribution System Design Standards.

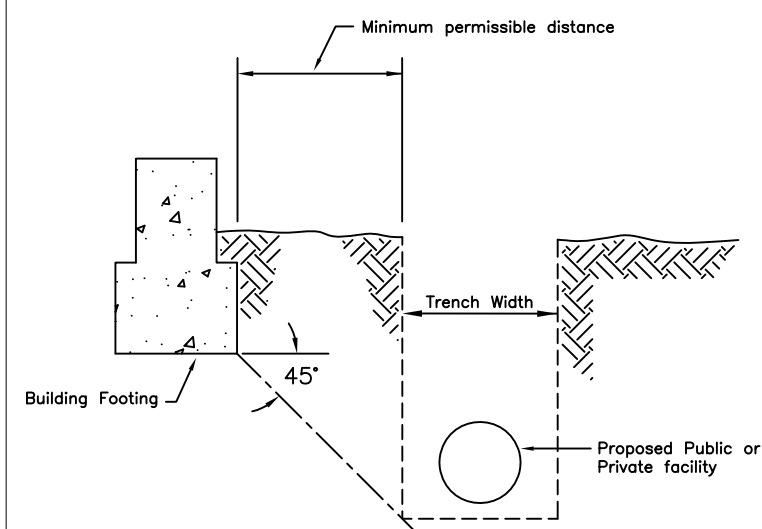

DETAIL OF BUILDING SETBACK
FROM UNDERGROUND UTILITY

* NOTE: REQUIRED PER CA UNIFORM PLUMBING CODE SECTION 314.1 315.1 2013 Rev.

CITY OF SANTA ROSA

MISCELLANEOUS PIPE
INSTALLATION DETAILS


SCALE: NONE DATE: Mar. 2016

DWN: GC
CHK: RH

APPROVED

FILE NO.

STD.- 517

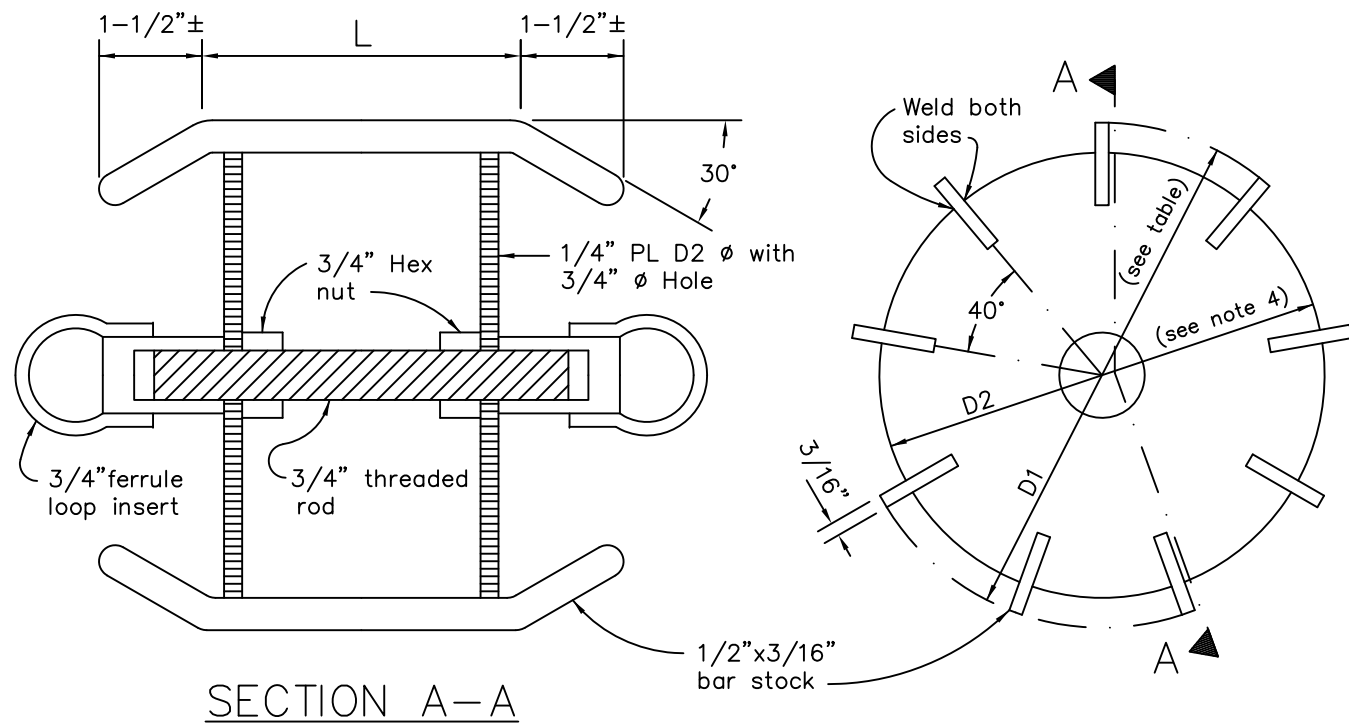

		MANDREL DIAMETER (D-1) SEE NOTE 3	
		5% DEFLECTION	
Nom. Pipe Dia.	L	SDR 35	SDR 26
6	6"	5.619	5.503
8	8"	7.524	7.366
10	10"	9.405	9.207
12	12"	11.191	10.961
15	15"	13.849	13.559

NOTES:


1. Mark all materials with ASTM specification number, SDR number and deflection.
2. The 1/2" Bar Stock on edge provides clearance to pass small amounts of soil which may be in pipe.
3. Mandrel diameter has been calculated based on section 306-1.2.12 of the "Greenbook" Standard Specifications for Public Works Construction and or dimensions given in Table 1 of ASTM Standard D3034.
4. Plate diameter shall be 1" less than the mandrel diameter.

CITY OF SANTA ROSA

PVC SEWER PIPE
DEFLECTION MANDREL

SCALE: NONE DATE: Sept.2002

DWN: GC APPROVED FILE NO.
CHK: RH STD.- 518

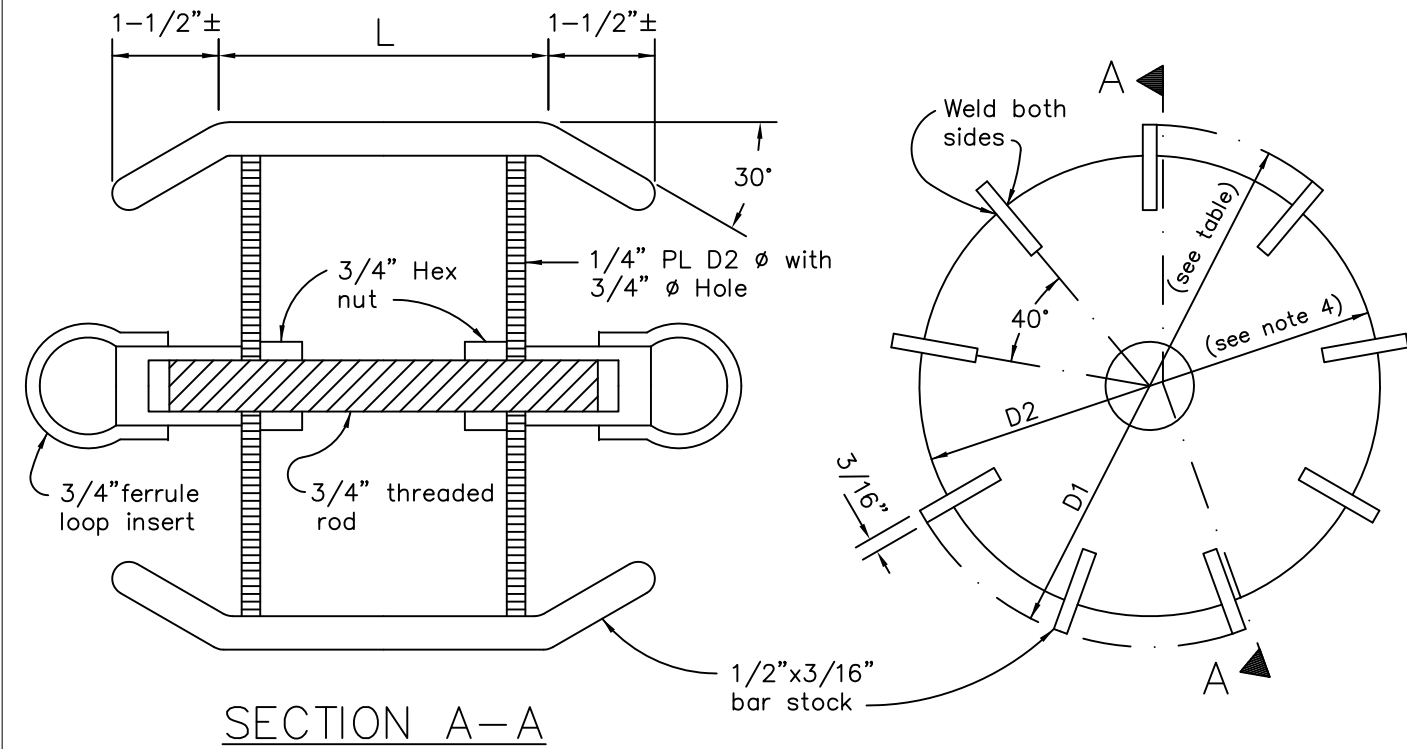

		MANDREL DIAMETER (D-1) SEE NOTE 4	
		5% DEFLECTION	
Nom. Pipe Dia.	L	SDR 35	SDR 26
6	6"	5.619	5.503
8	8"	7.524	7.366
10	10"	9.405	9.207
12	12"	11.191	10.961
15	15"	13.849	13.559
>15	*	*	*

NOTES:

1. Mark all materials with ASTM specification number, SDR number and deflection.
2. Plate diameter shall be 1" less than the mandrel diameter.
3. The 1/2" Bar Stock on edge provides clearance to pass small amounts of soil which may be in pipe.
4. Mandrel diameter has been calculated based on section 306-1.2.12 of the "Greenbook" Standard Specifications for Public Works Construction and or dimensions given in Table 1 of ASTM Standard D3034.
5. Alternative designs that match the deflection dimensions shown may be submitted for review.


*Request required mandrel dimensions from City.

CITY OF SANTA ROSA


PVC SEWER PIPE
DEFLECTION MANDREL

SCALE: NONE DATE: Mar. 2016

DWN: GC APPROVED FILE NO.
CHK: RH STD.- 518

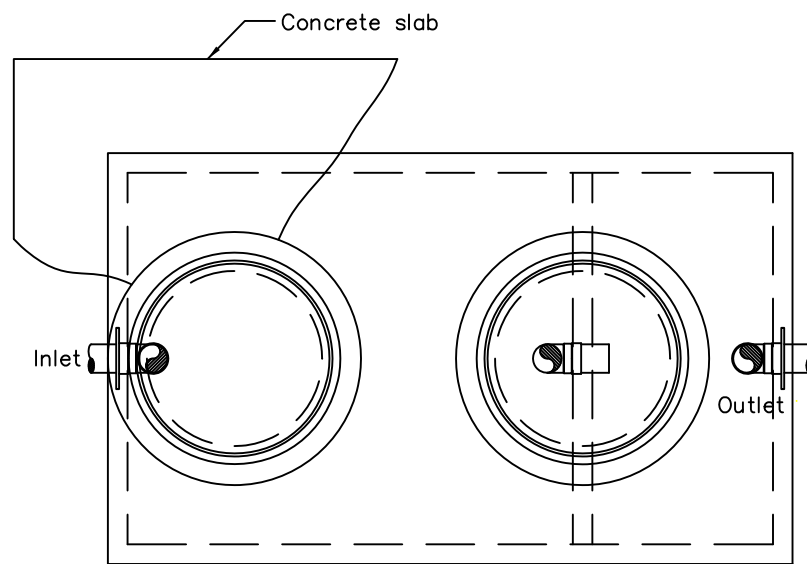

PLAN

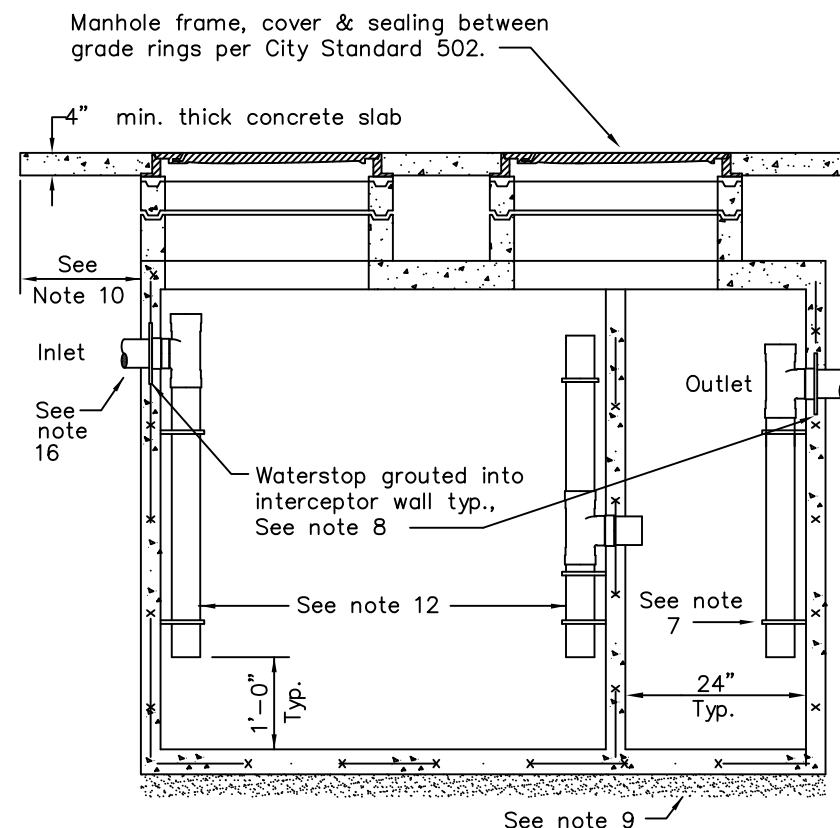

SECTION


Notes:

1. Pre manufactured tank shall be per Engineer's approved list.
2. All grease interceptors shall be located outside public right-of-way except with written approval of the Director of Public Works.
3. Grease interceptors shall be located outside of buildings in a location accessible to wastehauler pumper. Location subject to the approval of the Director of Utilities.
4. Tank capacity to be determined at the time of permit application.
5. Alternate design by a Registered Engineer may be substituted for review by the City.
6. Interceptor to be used in conjunction with "Sampling Manhole" per City Std. 521.
7. Stainless steel clamp and bolts 3'-0" o.c. max. (typ.) min. 2 req'd.
8. A waterstop consisting of a standard manhole adapter gasket as supplied by the pipe manufacturer shall be grouted into the interceptor wall near the center of the inlet and outlet walls.
9. Place 3" min. bedding material per City Standard 215.
10. Concrete slab to extend min. 24" beyond all sides of tank in traffic areas.
11. Install interceptor per manufacturer's specifications.
12. Pipe and fittings to be 4" schedule 40 PVC DWV.
13. All surface water must drain away from manholes.
14. All waste must enter through inlet fittings only.
15. Protective coating shall cover all internal surfaces and meet the criteria of ASTM-309.
16. Invert grades of inlet and outlet pipes to be provided by design Engineer.


CITY OF SANTA ROSA

TWO STAGE GREASE INTERCEPTOR

SCALE: NONE	DATE: June 2009
DWN: GC BB	APPROVED
CHK: AA	FILE NO. STD.- 519

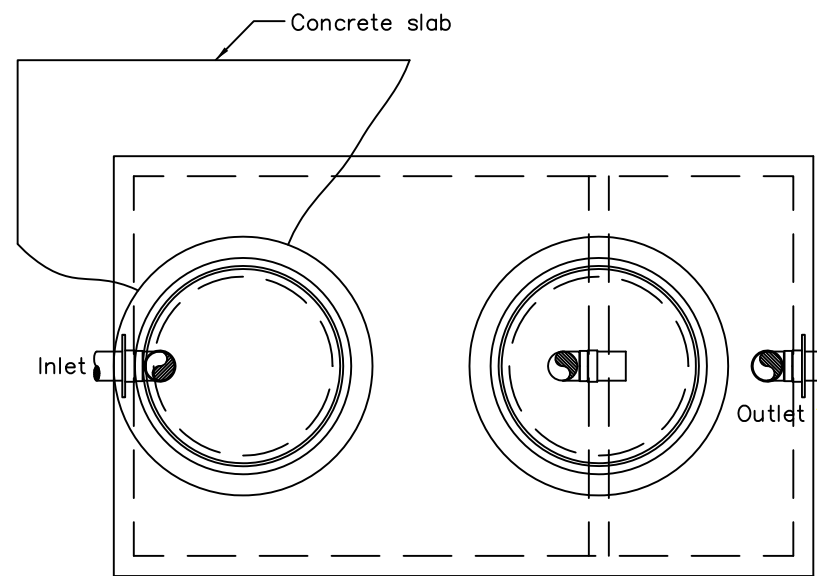

PLAN

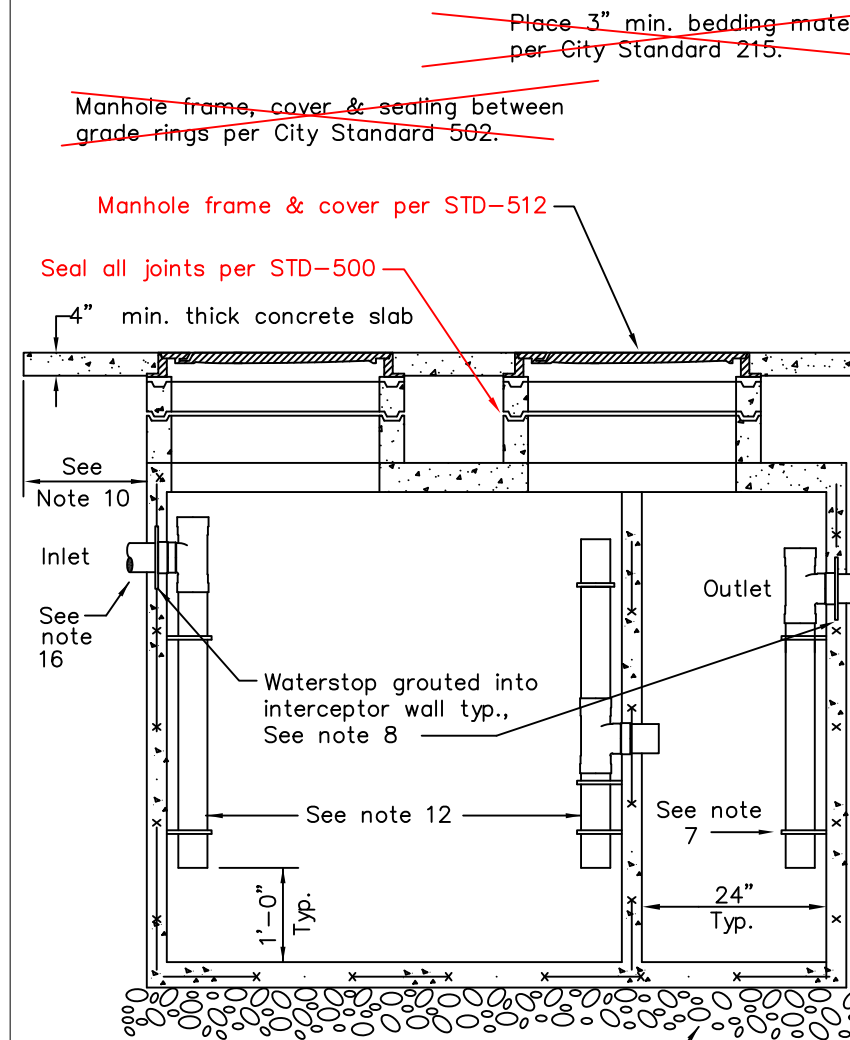

SECTION


Notes:

1. Pre manufactured tank shall be per Engineer's approved list.
2. All grease interceptors shall be located outside public right-of-way except with written approval of the Director of Public Works.
3. Grease interceptors shall be located outside of buildings in a location accessible to wastehauler pumper. Location subject to the approval of the **Water Department Director**.
4. Tank capacity to be determined at the time of permit application.
5. Alternate design by a Registered Engineer may be substituted for review by the City.
6. Interceptor to be used in conjunction with "Sampling Manhole" per City Std. 521.
7. Stainless steel clamp and bolts 3'-0" o.c. max. (typ.) min. 2 req'd.
8. A waterstop consisting of a standard manhole adapter gasket as supplied by the pipe manufacturer shall be grouted into the interceptor wall near the center of the inlet and outlet walls.
9. Place on 6" bed of 3/4" drain rock consolidated per STD-215.
10. Concrete slab to extend min. 24" beyond all sides of tank in traffic areas.
11. Install interceptor per manufacturer's specifications.
12. Pipe and fittings to be 4" schedule 40 PVC DWV.
13. All surface water must drain away from manholes.
14. All waste must enter through inlet fittings only.
15. Protective coating shall cover all internal surfaces and meet the criteria of ASTM-C309.
16. Invert grades of inlet and outlet pipes to be provided by design Engineer.

CITY OF SANTA ROSA


TWO STAGE GREASE INTERCEPTOR

SCALE: NONE	DATE: Mar. 2016
DWN: GC BB	APPROVED
CHK: AA	FILE NO. STD.- 519

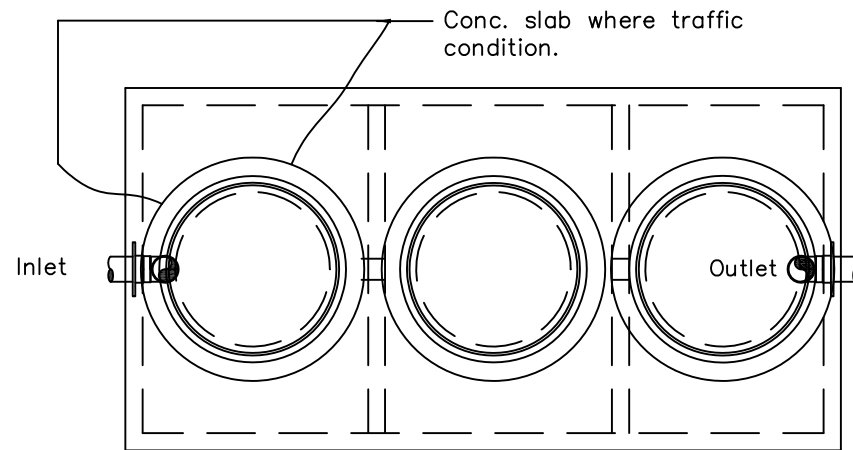

Note:
All waste must enter through inlet fitting only.

PLAN

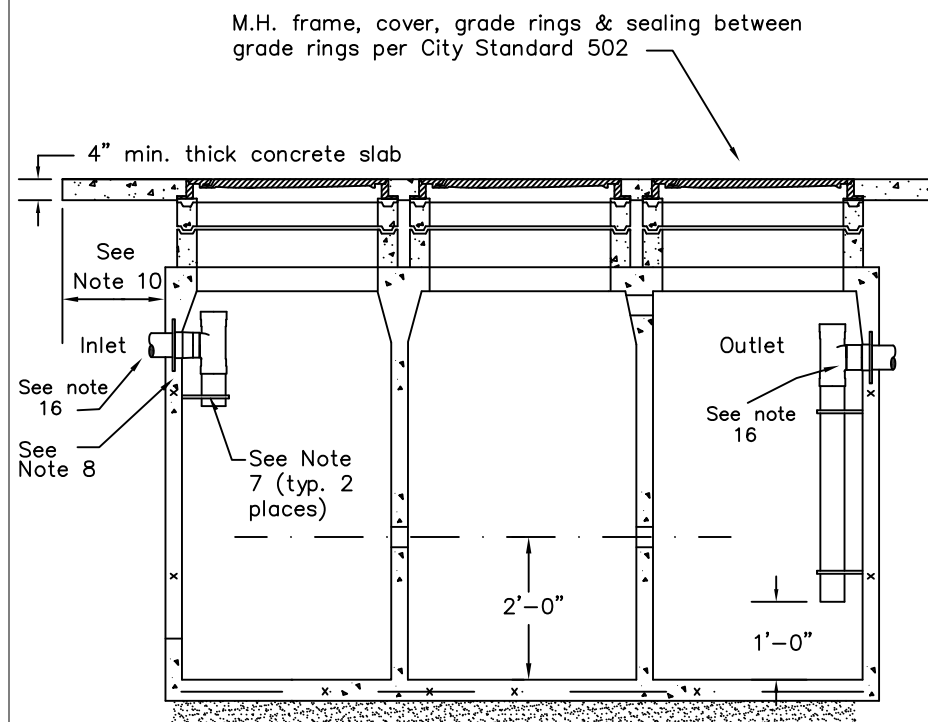

See note 9

SECTION


Notes:

1. Pre manufactured tank shall be per Engineer's approved list.
2. All grease interceptors shall be located outside public right-of-way except with written approval of the Director of Public Works.
3. Grease interceptors shall be located outside of buildings in a location accessible to wastehauler pumper. Location subject to the approval of the Director of Utilities.
4. Tank capacity to be determined at the time of permit application.
5. Alternate design by a Registered Engineer may be substituted for review by the City.
6. Interceptor to be used in conjunction with "Sampling Manhole" per City Std. 521.
7. Stainless steel clamp and bolts 3'-0" o.c. max. (typ.) min. 2 req'd.
8. A waterstop consisting of a standard manhole adapter gasket as supplied by the pipe manufacturer shall be grouted into the interceptor wall near the center of the inlet and outlet walls.
9. Place 3" min. bedding material per City Standard 215.
10. Concrete slab to extend min. 24" beyond all sides of tank in traffic areas.
11. Install interceptor per manufacturer's specifications.
12. Pipe and fittings to be 4" schedule 40 PVC DWV.
13. All surface water must drain away from manholes.
14. All waste must enter through inlet fittings only.
15. Protective coating shall cover all internal surfaces and meet the criteria of ASTM-309.
16. Invert grades of inlet and outlet pipes to be provided by design engineer.

CITY OF SANTA ROSA


**THREE STAGE
SAND AND GREASE
INTERCEPTOR**

SCALE: NONE		DATE: June 2009	
DWN: RH RR	APPROVED	FILE NO.	
CHK: AA		STD.- 520	

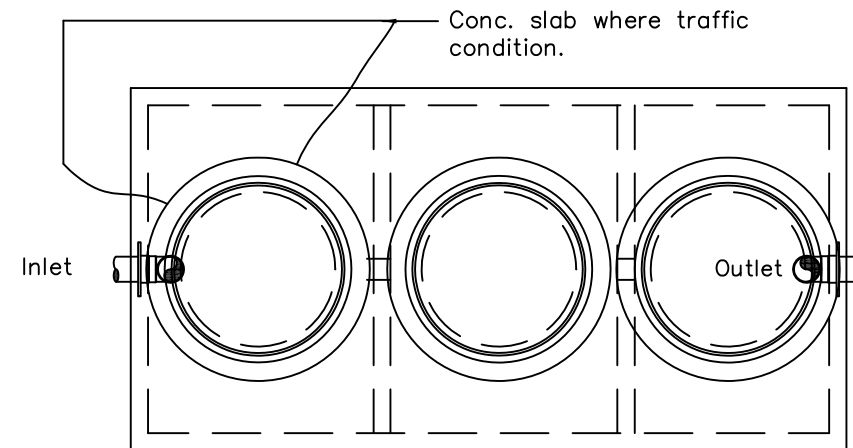

~~Note:
All waste must enter through inlet fitting only.~~

~~PLAN~~

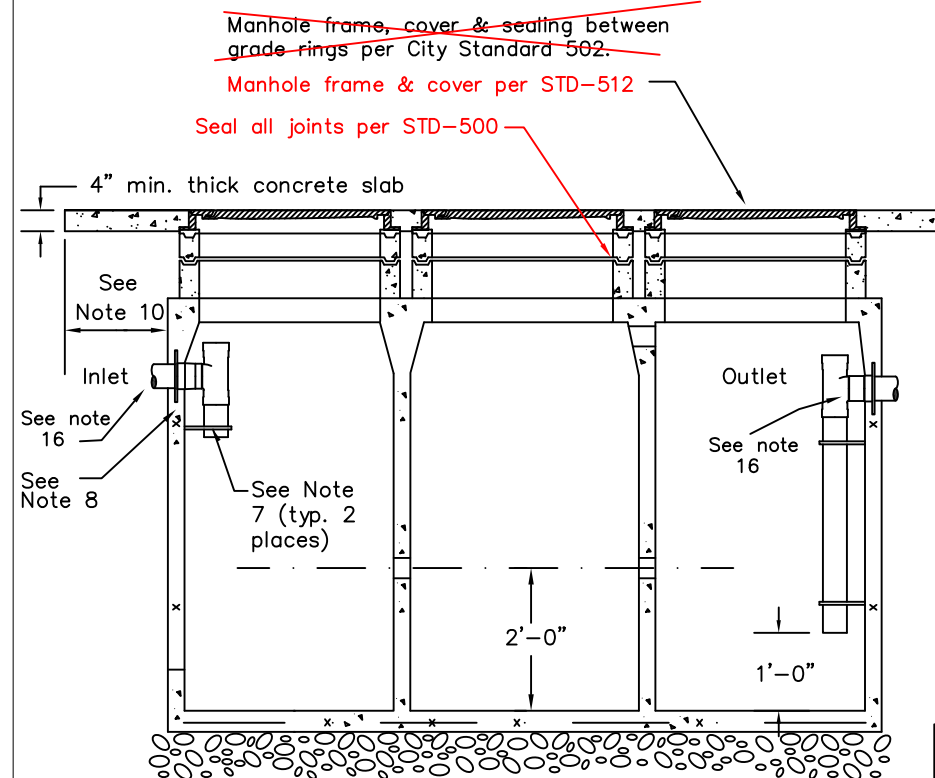

See note 9

SECTION


Notes:

1. Pre manufactured tank shall be per Engineer's approved list.
2. All grease interceptors shall be located outside public right-of-way except with written approval of the Director of Public Works.
3. Grease interceptors shall be located outside of buildings in a location accessible to wastehauler pumper. Location subject to the approval of the **Water Department Director**.
4. Tank capacity to be determined at the time of permit application.
5. Alternate design by a Registered Engineer may be substituted for review by the City.
6. Interceptor to be used in conjunction with "Sampling Manhole" per City Std. 521.
7. Stainless steel clamp and bolts 3'-0" o.c. max. (typ.) min. 2 req'd.
8. A waterstop consisting of a standard manhole adapter gasket as supplied by the pipe manufacturer shall be grouted into the interceptor wall near the center of the inlet and outlet walls.
9. Place on 6" bed of 3/4" drain rock consolidated per STD-215.
10. Concrete slab to extend min. 24" beyond all sides of tank in traffic areas.
11. Install interceptor per manufacturer's specifications.
12. Pipe and fittings to be 4" schedule 40 PVC DWV.
13. All surface water must drain away from manholes.
14. All waste must enter through inlet fittings only.
15. Protective coating shall cover all internal surfaces and meet the criteria of ASTM-**C**309.
16. Invert grades of inlet and outlet pipes to be provided by design engineer.

CITY OF SANTA ROSA


**THREE STAGE
SAND AND GREASE
INTERCEPTOR**

SCALE: NONE		DATE: Mar. 2016	
DWN: RH RR	APPROVED	FILE NO.	
CHK: AA		STD.- 520	

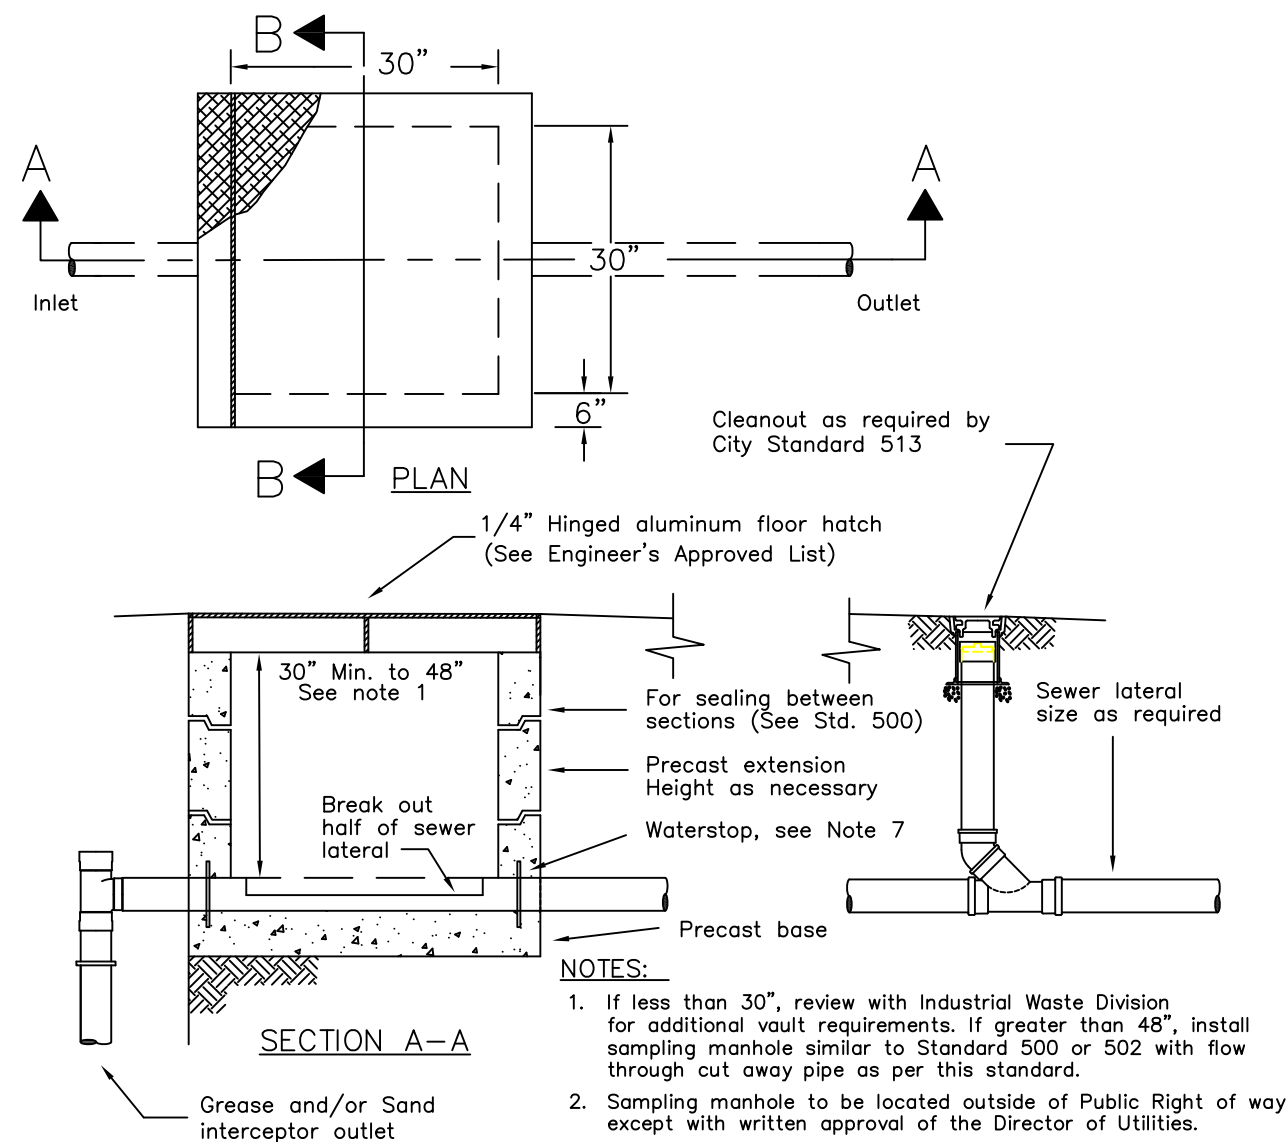

NOTES:

1. If less than 30", review with Industrial Waste Division for additional vault requirements. If greater than 48", install sampling manhole similar to Standard 500 or 502 with flow through cut away pipe as per this standard.
2. Sampling manhole to be located outside of Public Right of way except with written approval of the Director of Utilities.
3. An alternative design by a Registered Engineer may be submitted for review by the Utilities Department.
4. Location subject to the approval of the Director of Utilities.
5. Manhole shall be 30" x 30" inside dimension precast box with 24" x 24" hinged aluminum floor hatch.
6. All surface water must drain away from sampling manhole.
7. A waterstop consisting of a standard manhole adapter gasket as supplied by the pipe manufacturer to be grouted into the box wall near the center of the wall.

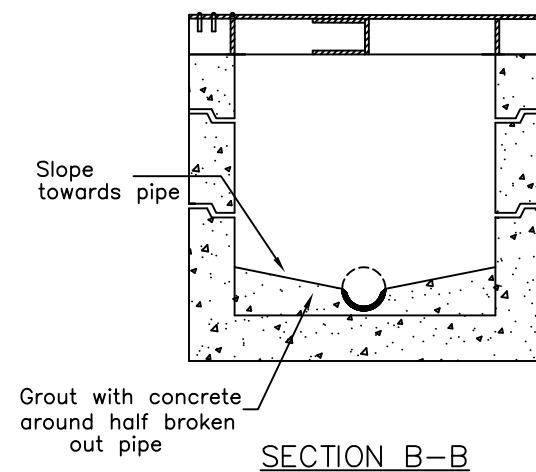


CITY OF SANTA ROSA

**SAMPLING MANHOLE
EXTERIOR USE**


SCALE: NONE DATE: Sept.2002

DWN: RH APPROVED FILE NO.
CHK: STD.- 521

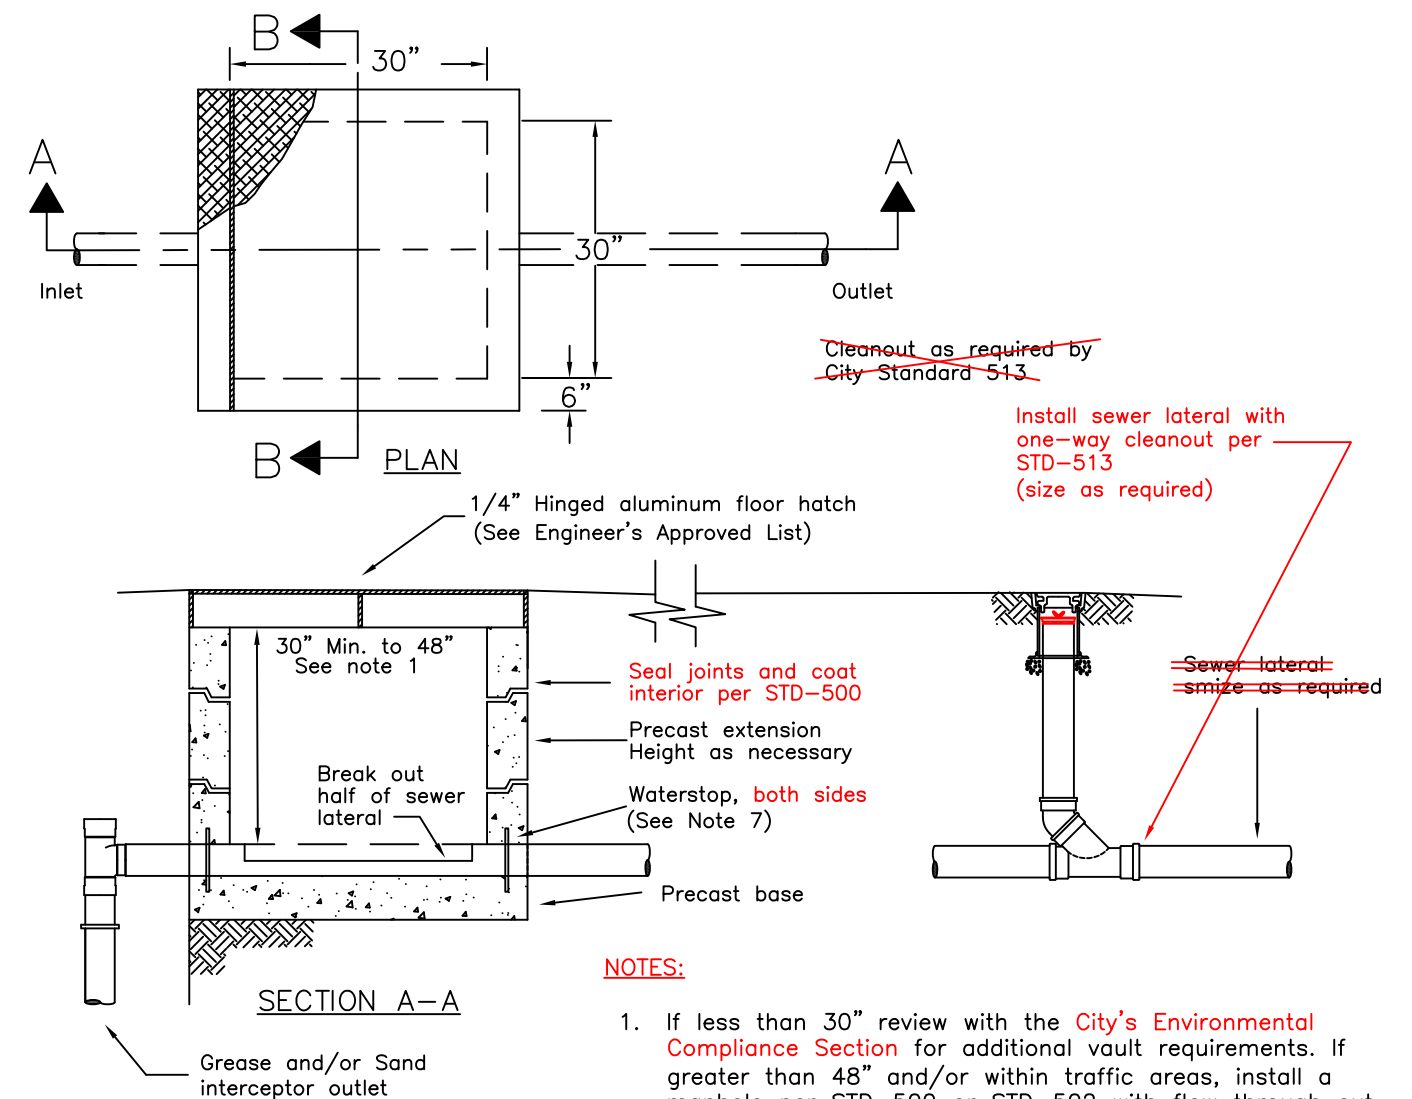

NOTES:

1. If less than 30" review with the City's Environmental Compliance Section for additional vault requirements. If greater than 48" and/or within traffic areas, install a manhole per STD-500 or STD-502 with flow through cut away pipe per this standard, and fitted with a frame and cover per STD-512.
2. Sampling manhole shall be located outside of public right of way unless approved, in writing, by the Water Department Director.
3. An alternative design by a Registered Engineer may be submitted for review by the Water Department.
4. Location subject to the approval of the Water Department Director.
5. Manhole shall be 30" x 30" inside dimension precast box with 24" x 24" hinged aluminum floor hatch or a manhole frame and cover per STD-512.
6. All surface water must drain away from sampling manhole.
7. A waterstop per the "Engineer's Approved List of Items" for STD-500 shall be centered and cast into the wall of the box.


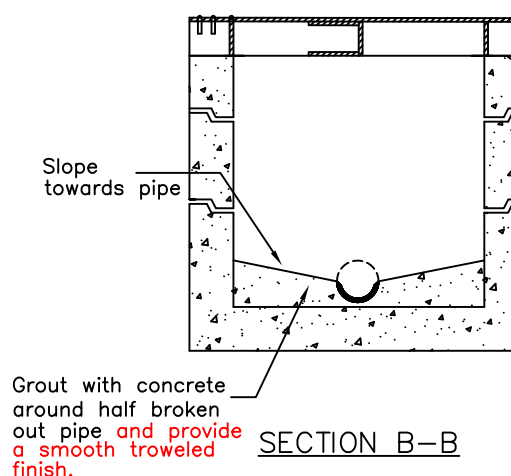


CITY OF SANTA ROSA

**SAMPLING MANHOLE
EXTERIOR USE**

SCALE: NONE DATE: Mar. 2016


DWN: RH APPROVED FILE NO.
CHK: STD.- 521

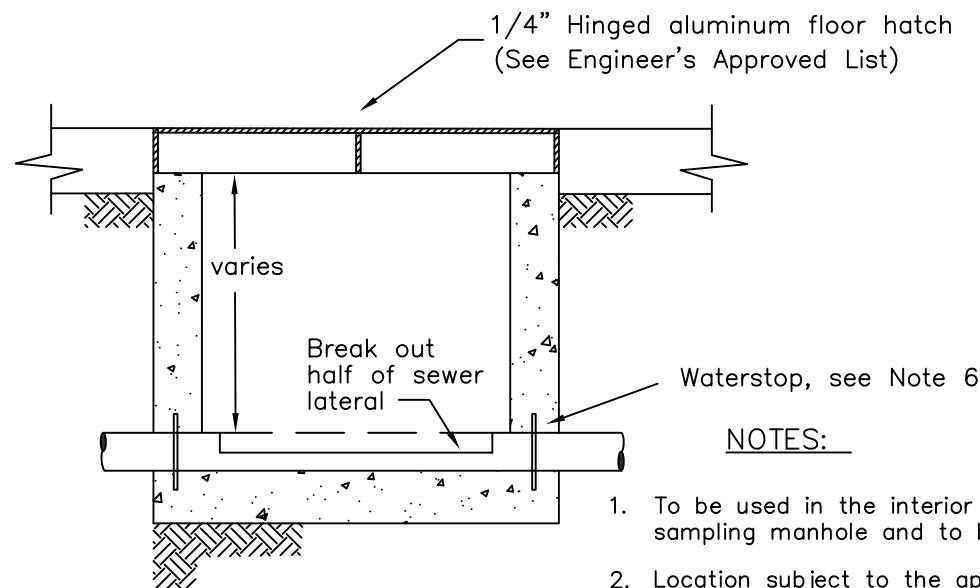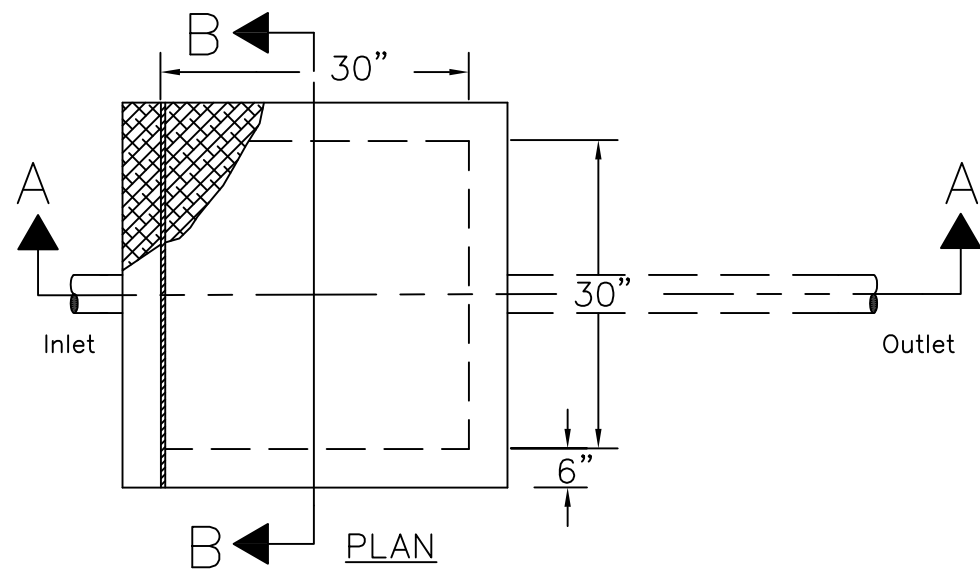

SECTION A-A



NOTES:

1. To be used in the interior of buildings in conjunction with sampling manhole and to be upstream of the sampling manhole.
2. Location subject to the approval of the Director of Utilities.
3. An alternative design by a Registered Engineer may be submitted for review by the Utilities Department.
4. Box shall be 30" x 30" inside dimension precast box with 24" x 24" hinged aluminum floor hatch.
5. All surface water must drain away from sampling box.
6. A waterstop consisting of a standard manhole adaptor gasket as supplied by the pipe manufacturer to be grouted into the box wall near the center of the wall.

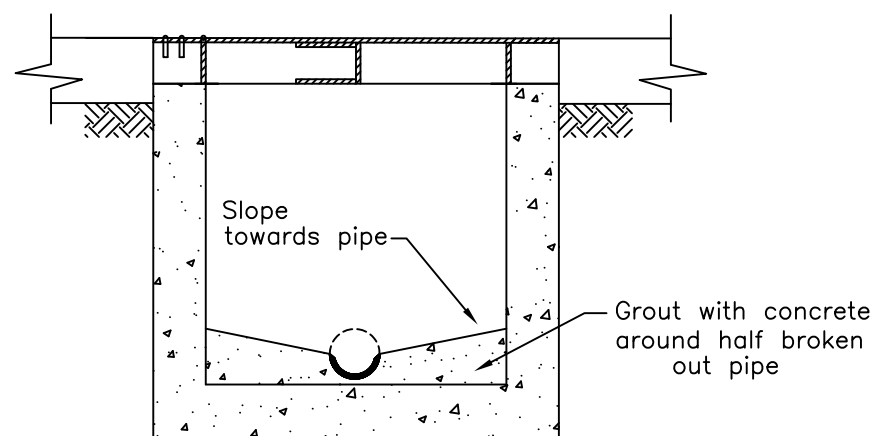

SECTION B-B


CITY OF SANTA ROSA		
SAMPLING BOX BUILDING INTERIOR		
SCALE: NONE	DATE: Sept.2002	
DWN: RH	APPROVED	FILE NO.
CHK: G.C.		STD.- 522

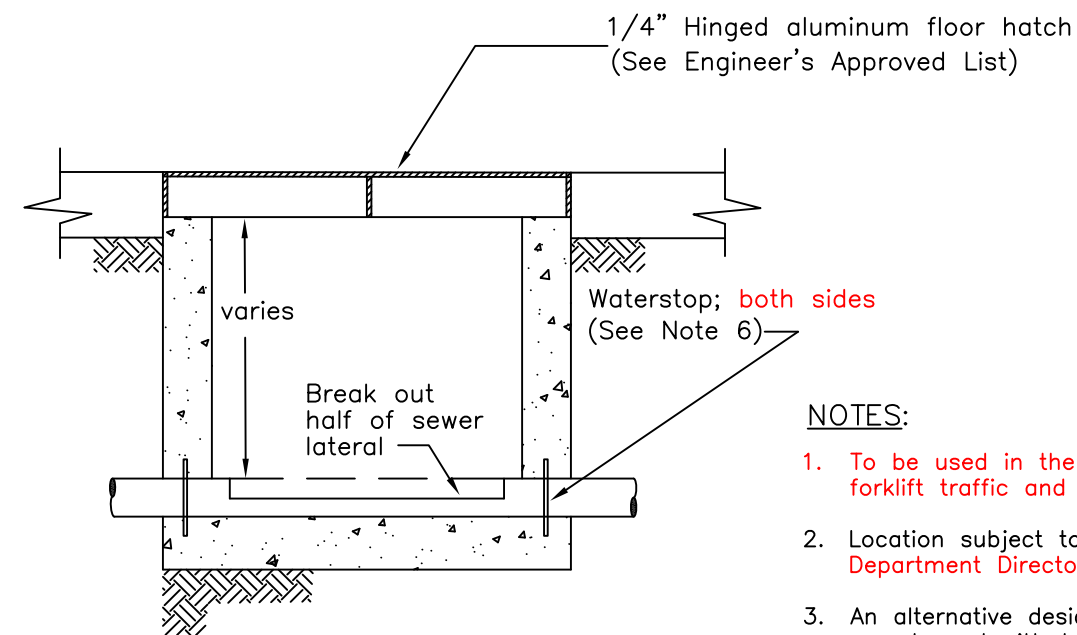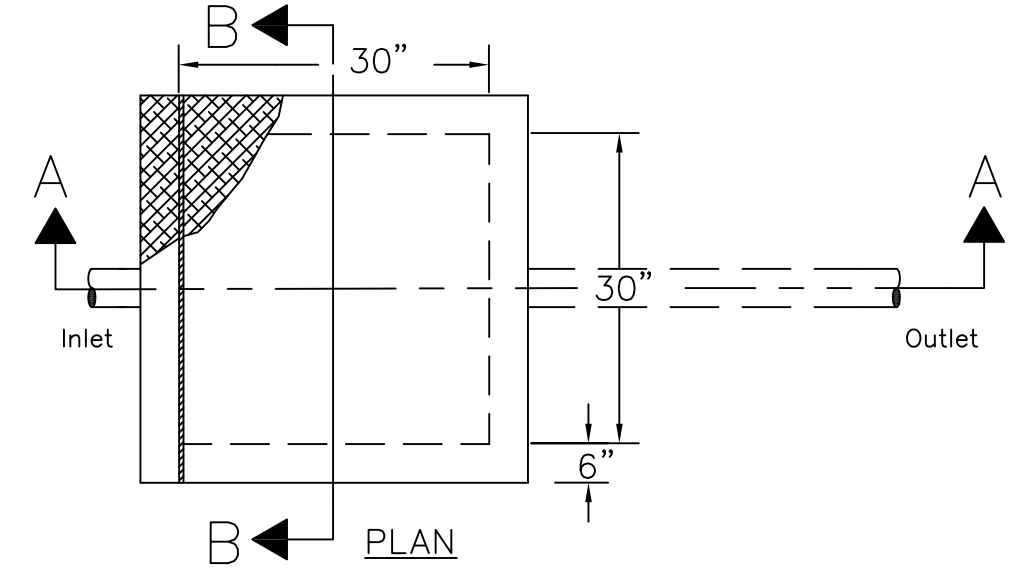

SECTION A-A

NOTES:

1. To be used in the interior of buildings, free of forklift traffic and accessible to City personnel.
2. Location subject to the approval of the Water Department Director.
3. An alternative design by a Registered Engineer may be submitted for review by the Water Department.
4. Box shall be 30" x 30" inside dimension precast box with 24" x 24" hinged aluminum floor hatch.
5. All surface water must drain away from sample box.
6. A waterstop per the "Engineer's Approved List of Items" for STD-500 shall be centered and cast into the wall of the box.

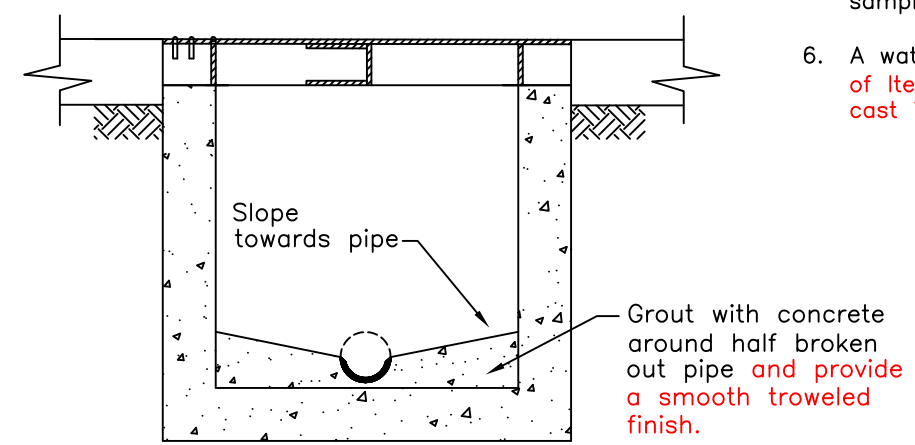


SECTION B-B

CITY OF SANTA ROSA		
SAMPLING BOX BUILDING INTERIOR		
SCALE: NONE	DATE: Mar. 2016	
DWN: RH	APPROVED	FILE NO.
CHK: G.C.		STD.- 522

Notes:

1. Pre manufactured tank shall be per Engineer's approved list.
2. All grease interceptors shall be located outside public right-of-way except with written approval of the Director of Public Works.
3. Grease interceptors shall be located outside of buildings in a location accessible to waste hauler pumper. Location subject to the approval of the Director of Utilities.
4. Tank capacity to be determined at the time of permit application.
5. Alternate design by a Registered Engineer may be substituted for review by the City.
6. Interceptor to be used in conjunction with "Sampling Manhole" per City Std. 521.
7. Stainless steel clamp and bolts 3'-0" o.c. max. (typ.) min. 2 req'd.
8. A waterstop consisting of a standard manhole adapter gasket as supplied by the pipe manufacturer shall be grouted into the interceptor wall near the center of the inlet and outlet walls.
9. 3" min. bedding material per City trench standards.
10. Concrete slab to extend min. 24" beyond all sides of tank in traffic areas.
11. Install interceptor per manufacturer's specifications.
12. Pipe and fittings to be 4" schedule 40 PVC DWV.
13. All surface water must drain away from manholes.
14. All waste must enter through inlet fittings only.
15. Protective coating shall cover all internal surfaces and meet the criteria of ASTM-309.
16. Invert grades of inlet and outlet pipes to be provided by design engineer.

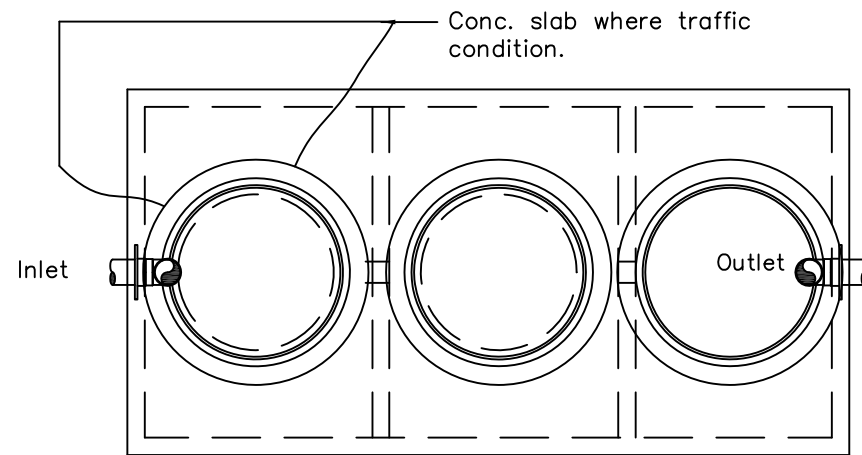


Note:

All waste must enter through inlet fitting only.

PLAN

M.H. frame, cover, grade rings & sealing between grade rings per City Standard 502

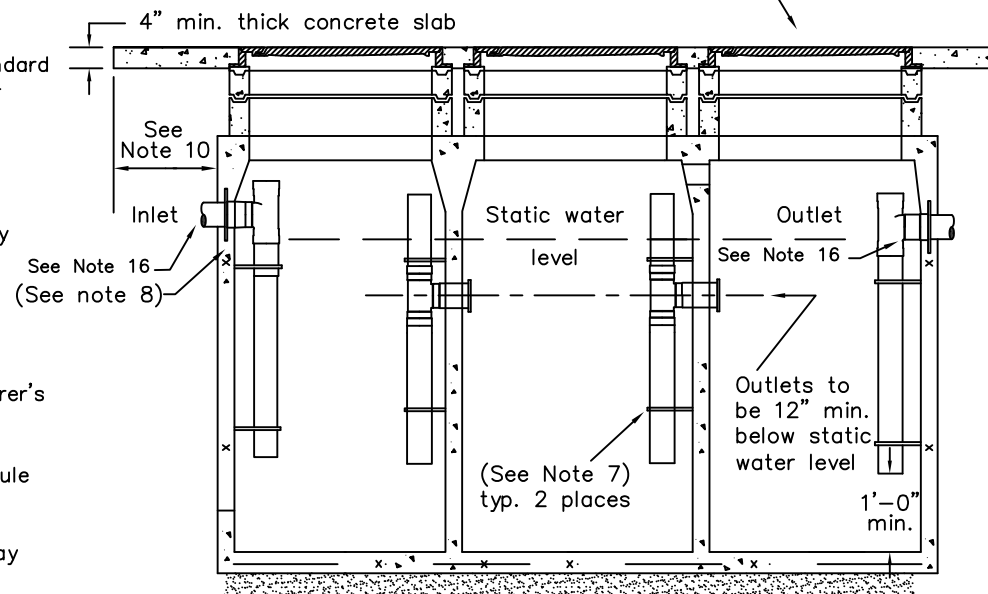


(See note 9)

SECTION

CITY OF SANTA ROSA

**THREE STAGE
GREASE
INTERCEPTOR**

SCALE: NONE DATE: June 2009
DWN: RH RR APPROVED FILE NO.
CHK: AA STD.- 523

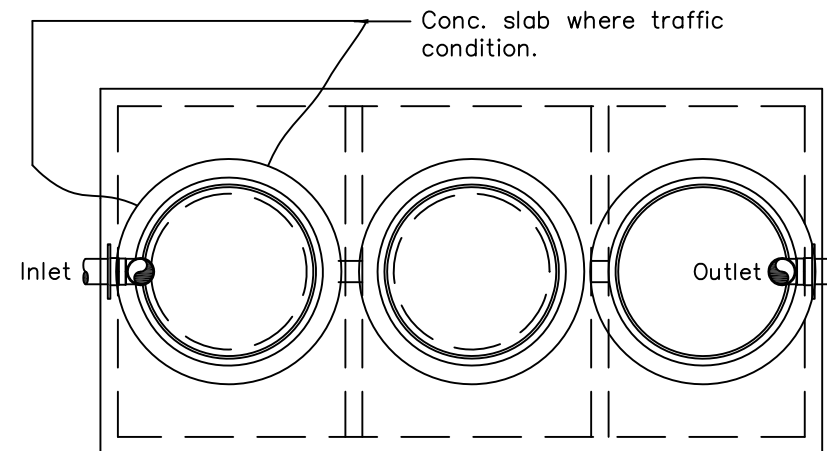

PLAN


Note:

All waste must enter through inlet fitting only.

~~M.H. frame, cover, grade rings & sealing between grade rings per City Standard 502~~

Manhole frame & cover per STD-512

Seal all joints per STD-500

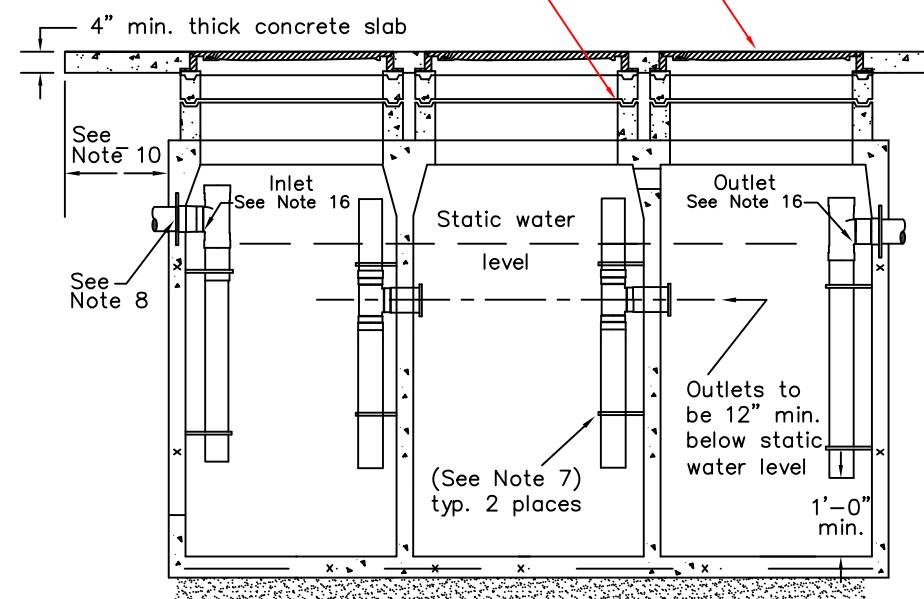

(See note 9)

SECTION

Notes:

1. Pre manufactured tank shall be per Engineer's approved list.
2. All grease interceptors shall be located outside public right-of-way except with written approval of the Director of Public Works.
3. Grease interceptors shall be located outside of buildings in a location accessible to waste hauler pumper. Location subject to the approval of the **Water Department Director**.
4. Tank capacity to be determined at the time of permit application.
5. Alternate design by a Registered Engineer may be substituted for review by the City.
6. Interceptor to be used in conjunction with "Sampling Manhole" per STD-521.
7. Stainless steel clamp and bolts shall typically be installed 3'-0" o.c. max, and two per pipe min.
8. A waterstop, **per the Engineer's Approved List**, shall be centered and cast into inlet and outlet wall penetrations.
9. Place on 6" bed of 3/4" drain rock, consolidated per STD-215.
10. Concrete slab to extend min. 24" beyond all sides of tank in traffic areas.
11. Install interceptor per manufacturer's specifications.
12. Pipe and fittings to be 4" schedule 40 PVC DWV.
13. All surface water must drain away from manholes.
14. All waste must enter through inlet fittings only.
15. Protective coating shall cover all internal surfaces and meet the criteria of ASTM-C309.
16. Invert grades of inlet and outlet pipes to be provided by Design Engineer.


CITY OF SANTA ROSA

**THREE STAGE
GREASE
INTERCEPTOR**

SCALE: NONE DATE: Mar. 2016
DWN: RH RR APPROVED FILE NO.
CHK: AA STD.- 523

~~8. A waterstop consisting of a standard manhole adapter gasket as supplied by the pipe manufacturer shall be grouted into the interceptor wall near the center of the inlet and outlet walls.~~

~~9. 3" min. bedding material per City trench standards.~~

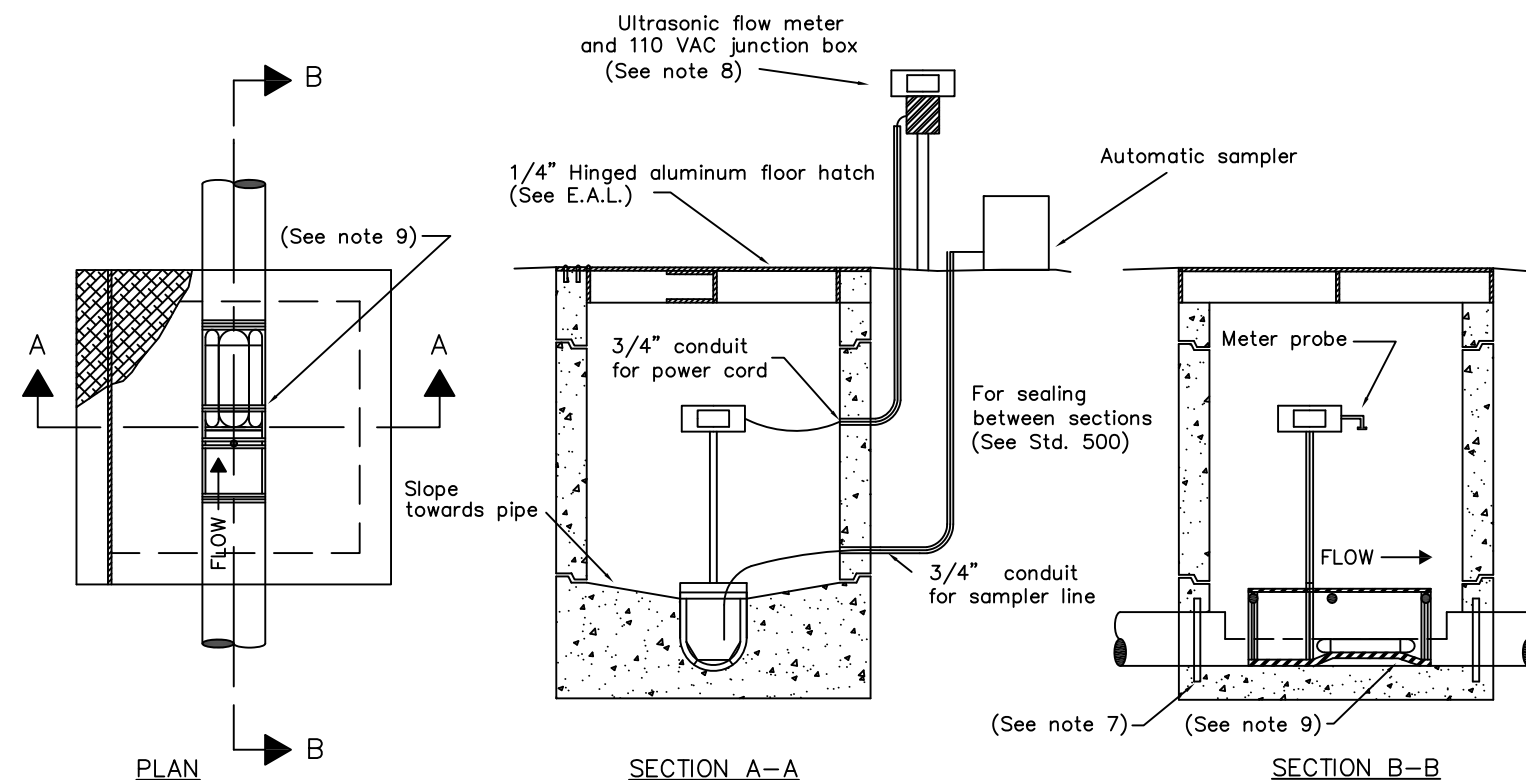

Notes:


1. If less than 30" , review with Environmental Services Division for additional vault requirements. If greater than 48", install sampling manhole similar to Standard 500 with flow through cut away pipe as per this standard.
2. Sampling manhole to be located outside of public right-of-way except with written approval of the Director of Utilities. The sampling manhole shall be situated in a secure location.
3. An alternative design by a Registered Engineer may be submitted for review by the Utilities Department.
4. Location subject to the approval of the Director of Utilities.
5. Manhole shall be 30" x 30" inside dimension precast box with 24" X 24" hinged aluminum floor hatch.
6. All surface water must drain away from sampling manhole.
7. A waterstop consisting of a standard manhole adapter gasket as supplied by the pipe manufacturer to be grouted into the box wall near the center of the wall.
8. Install 110 VAC Junction box for 4-20MA to provide pulse output for flow proportional sampling.
9. Install a Palmer Bowlus, Parshall Style flume, or approved equal per manufacturer's recommendations. Flume shall be placed in the center of the box.

CITY OF SANTA ROSA

CONTROL SAMPLING MANHOLE

SCALE: NONE DATE: Sept.2002

DWN: RH APPROVED FILE NO. STD.- 524

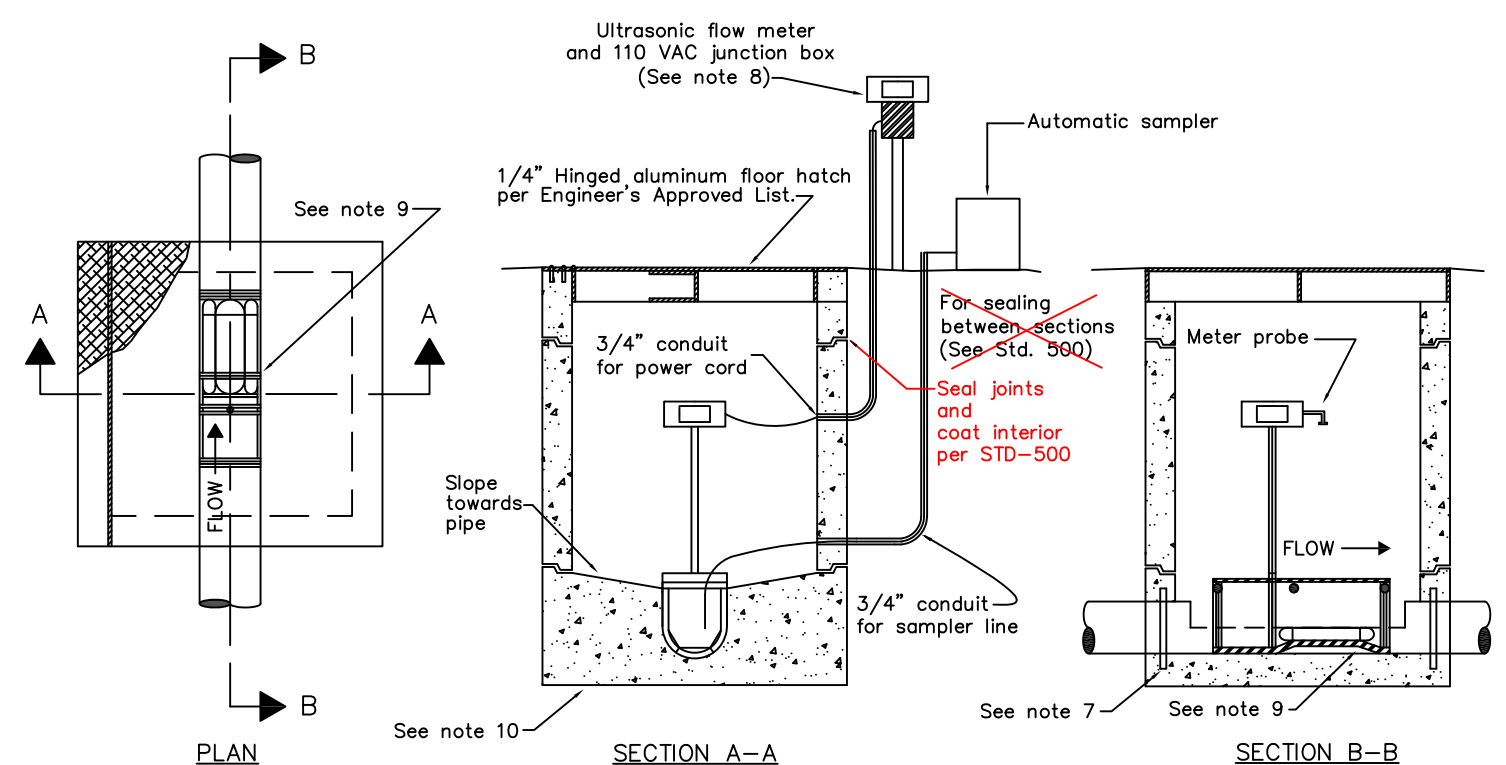

Notes:

1. If less than 30" , review with the City's Environmental Compliance Section for additional vault requirements. If greater than 48", install sampling manhole similar to Standard 500 with flow through cut away pipe as per this standard.
2. Sampling manhole to be located outside of public right of way except with written approval of the Water Department Director. The sampling manhole shall be situated in a secure location.
3. An alternative design by a Registered Engineer may be submitted for review by the City's Environmental Compliance Section.
4. Location subject to the approval of the Water Department Director.
5. Manhole shall be 30" x 30" inside dimension precast box with 24" X 24" hinged aluminum floor hatch. Hatch shall be H20 rated if approved location has potential for wheeled traffic.
6. All surface water must drain away from sampling manhole.
7. A waterstop per the "Engineer's Approved List of Items" for STD-500 shall be centered and cast into the walls of the box as shown.
8. Install a City approved secondary measuring device and flow recorder equipped with a 110 VAC Junction box for 4-20MA to provide pulse output for flow proportional sampling.
9. Install an approved primary flow device flume and weir, or an approved equivalent per manufacturer's recommendations. The primary flow device shall be placed in the center of the box.

CITY OF SANTA ROSA


CONTROL SAMPLING MANHOLE

SCALE: NONE DATE: Mar. 2016


DWN: RH APPROVED FILE NO. STD.- 524

CONCRETE PAD


Reinforced with
6" x 6" / 10 x 10
welded wire fabric

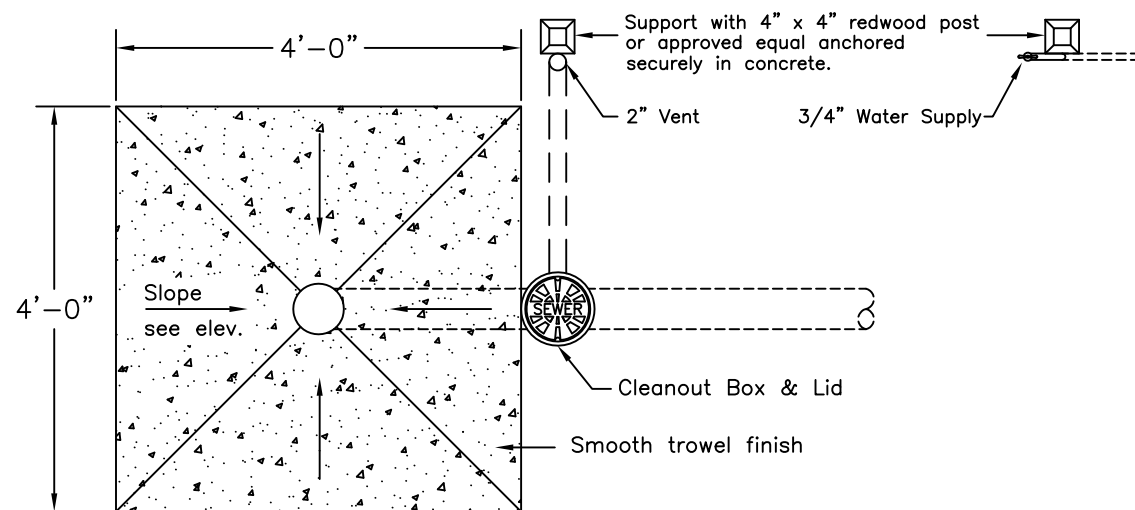

PLAN VIEW

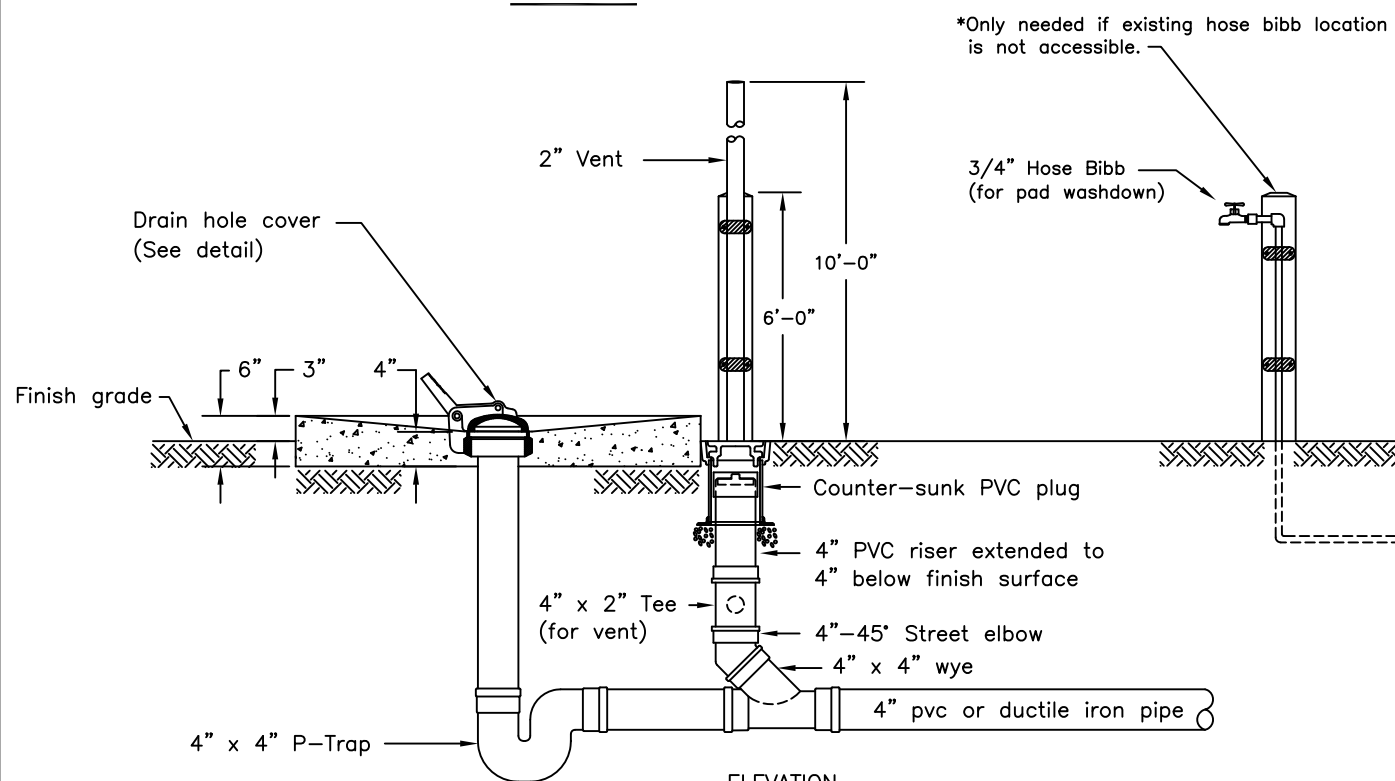

ELEVATION

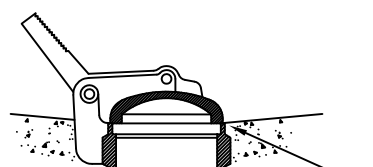

Cast cover in slab so lip of opening
is flush for washdown.

VAREC Fig. 46 drain hole cover assembly
foot operated, cast iron body, bronze cover,
or an approved equal.

DRAIN HOLE COVER DETAIL

NOTES:

1. Must install Reduced Pressure Backflow Prevention Device on water service prior to installation of this disposal facility. See Std. 876.
2. See Std. 514 & Engineer's approved list for cleanout box and cover.

CITY OF SANTA ROSA


**RECREATIONAL VEHICLE
DISPOSAL FACILITY**

SCALE: NONE DATE: Sept. 2002


DWN: GC APPROVED FILE NO.
CHK: STD.- 525

CONCRETE PAD


Reinforced with
6" x 6" / 10 x 10
welded wire fabric

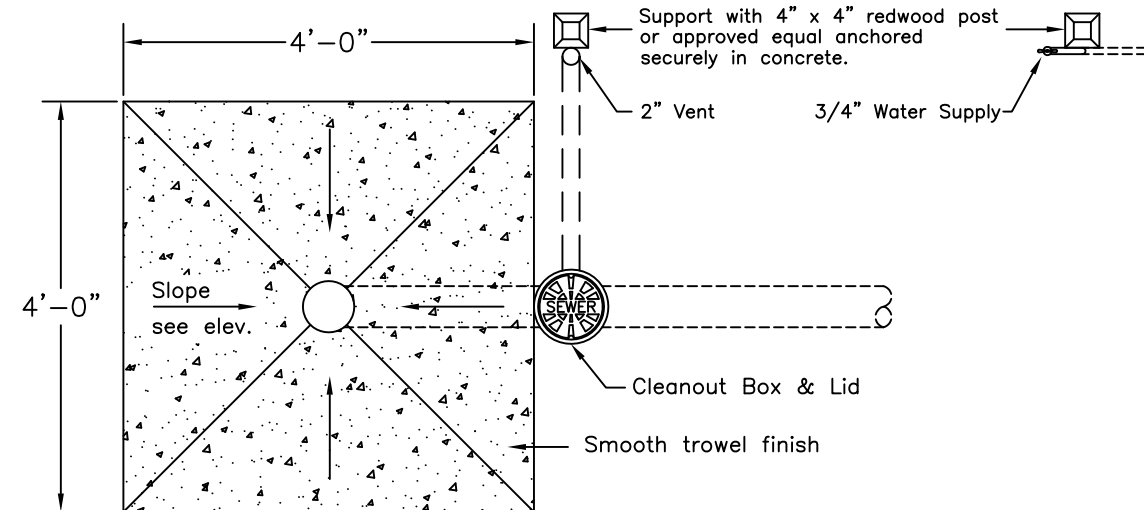

PLAN VIEW

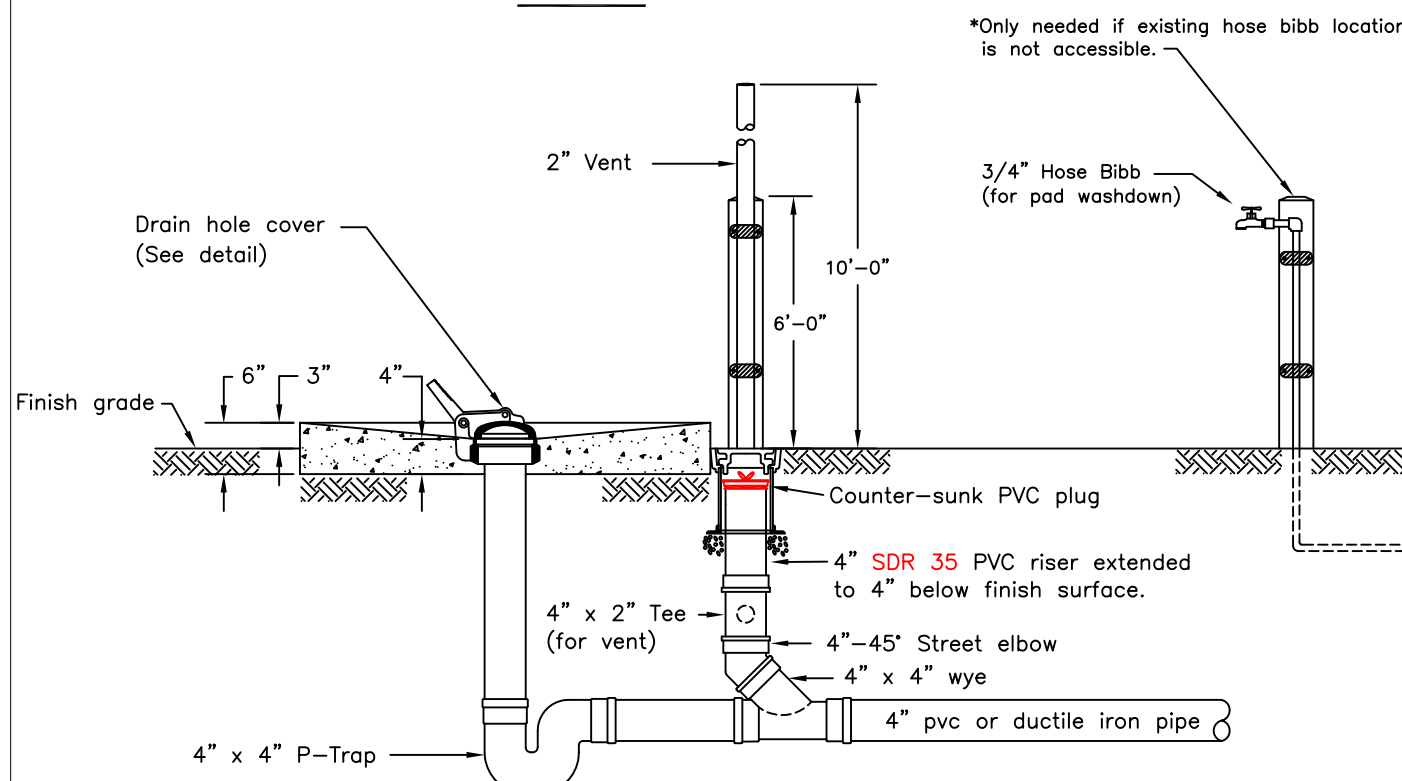

ELEVATION

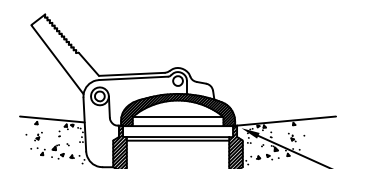

Cast cover in slab so lip of opening
is flush for washdown.

VAREC Fig. 46 drain hole cover assembly
foot operated, cast iron body, bronze cover,
or an approved equal.

DRAIN HOLE COVER DETAIL

NOTES:


1. Must install Reduced Pressure Backflow Prevention Device (RP) per STD-876 on water service, and have passing certification test, prior to installation of this disposal facility.
~~See Std. 876.~~
~~Std. 514~~
2. See STD-513 & Engineer's approved list for cleanout box and cover.

CITY OF SANTA ROSA

**RECREATIONAL VEHICLE
DISPOSAL FACILITY**


SCALE: NONE DATE: Mar. 2016

DWN: GC APPROVED FILE NO.
CHK: STD.- 525

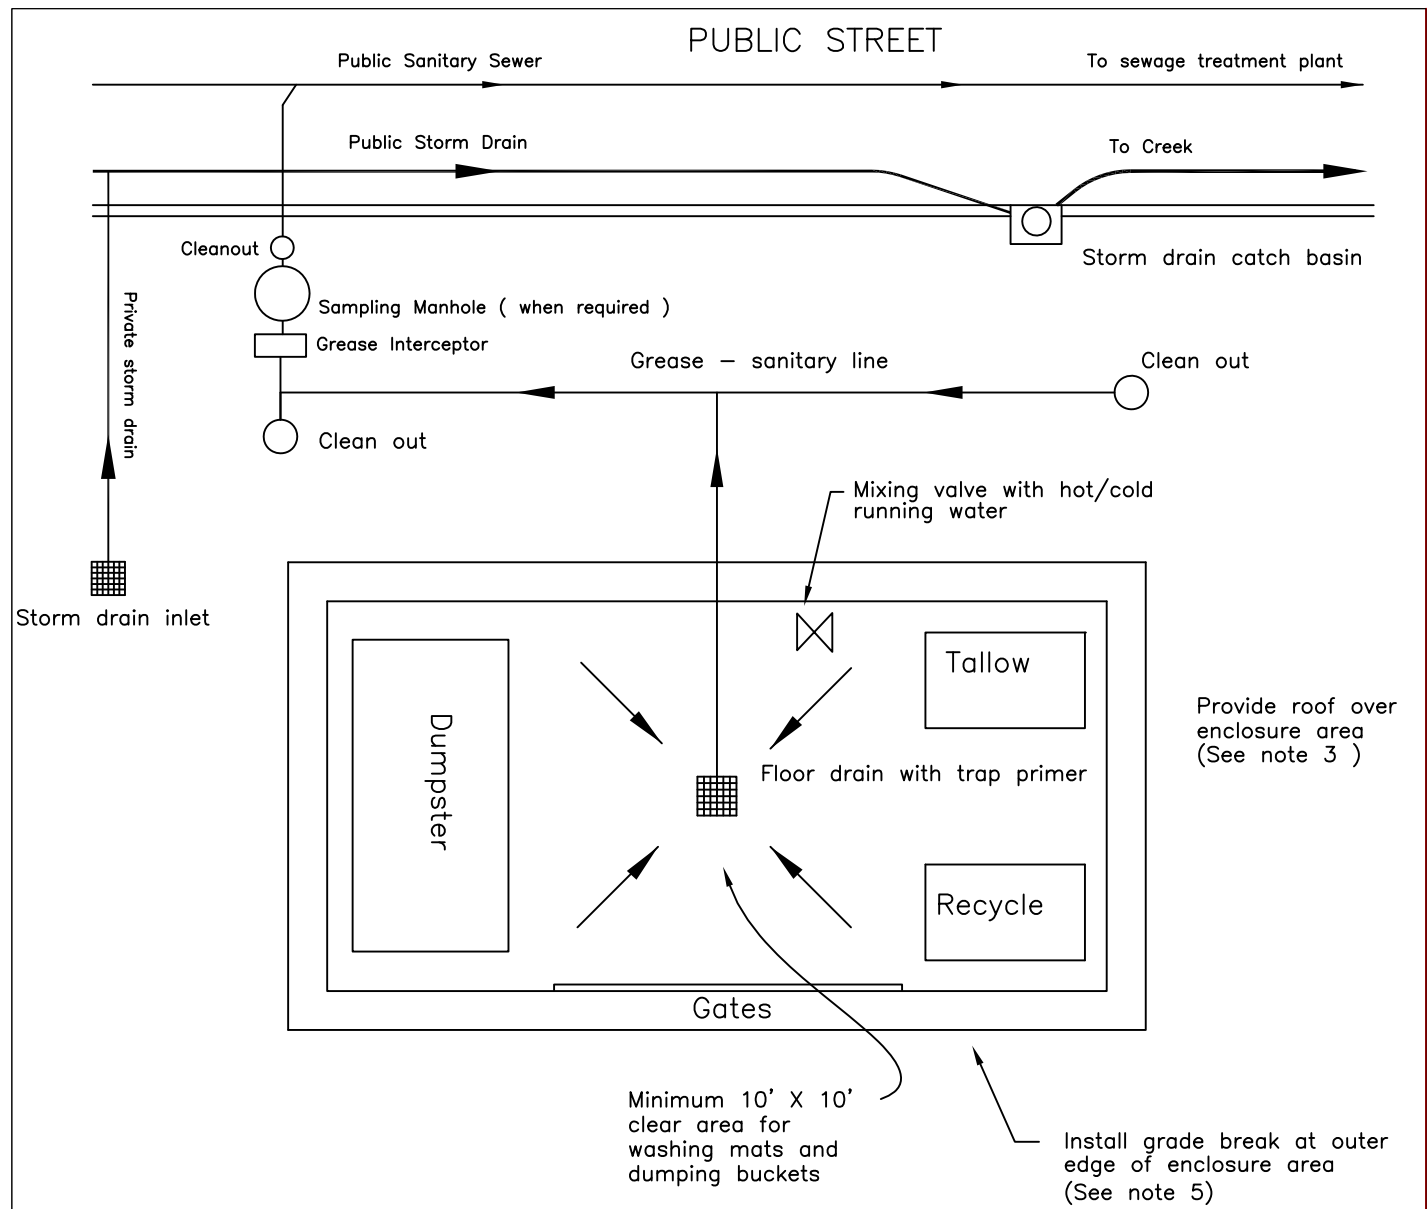



- NOTES:
1. All waste storage, recycling containers including dumpsters, tallow bins, and mat washing to be located in an enclosed area. The enclosure shall be designed to prevent any waste or garbage from entering the storm drain system, to contain spills within the enclosure, facilitate cleaning, and to prevent rainwater from entering the enclosure.
 2. Minimum height of enclosure shall be 7 feet.
 3. A roof structure is required to prevent rain water from entering the dumpsters, containers, or the sanitary sewer. Roof structure shall be high enough to allow clearance for opening dumpsters.
 4. The enclosure shall have a floor drain, with trap primer, and shall be connected to a grease interceptor which discharges to the sanitary sewer. The floor drain shall be connected to a minimum size interceptor equivalent to a Zurn Model Z1170, size 700 35/70 grease trap equipped with a flow control valve. size 700 35/70 grease trap equipped with a flow control valve.
 5. Finished surfaces surrounding enclosure shall provide drainage away from enclosure.
 6. All Food Facility Enclosures require a Building Permit and Design Review approval from the Community Development Department. The enclosure shall conform to all provisions of the California Fire Code and California Building Code. Enclosure walls and roof must be designed by an licensed architect, civil engineer or structural engineer.

CITY OF SANTA ROSA		
FOOD FACILITY ENCLOSURE		
SCALE: NONE	DATE: Sept.2002	
DWN: RH	APPROVED	FILE NO.
CHK:		STD.- 526

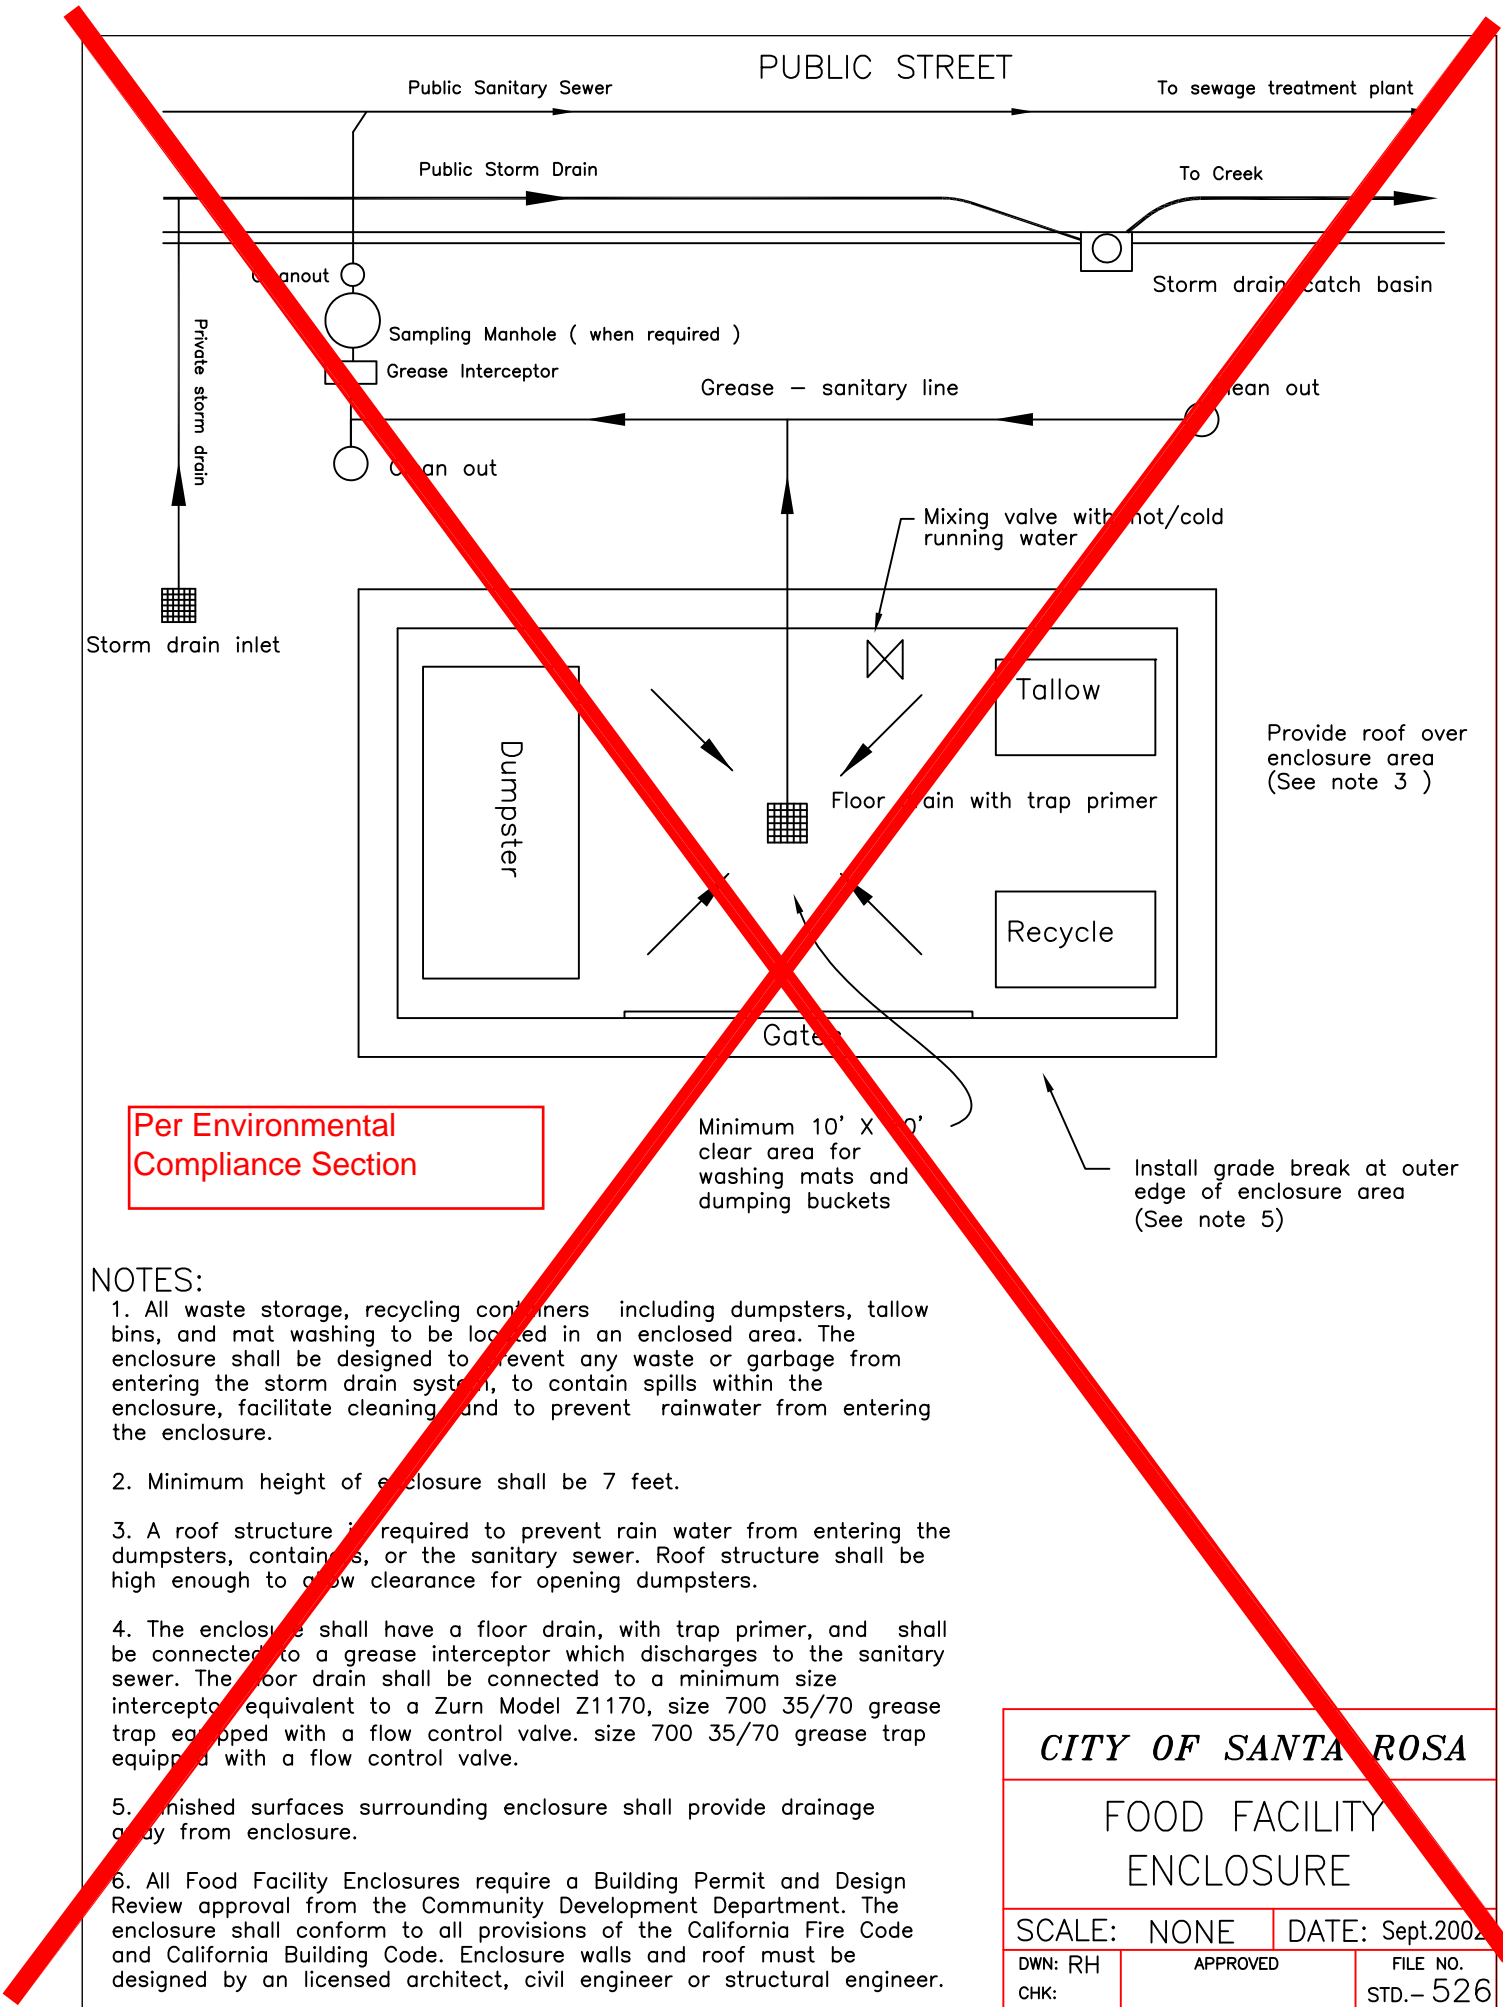

- NOTES:
1. All waste storage, recycling containers including dumpsters, tallow bins, and mat washing to be located in an enclosed area. The enclosure shall be designed to prevent any waste or garbage from entering the storm drain system, to contain spills within the enclosure, facilitate cleaning, and to prevent rainwater from entering the enclosure.
 2. Minimum height of enclosure shall be 7 feet.
 3. A roof structure is required to prevent rain water from entering the dumpsters, containers, or the sanitary sewer. Roof structure shall be high enough to allow clearance for opening dumpsters.
 4. The enclosure shall have a floor drain, with trap primer, and shall be connected to a grease interceptor which discharges to the sanitary sewer. The floor drain shall be connected to a minimum size interceptor equivalent to a Zurn Model Z1170, size 700 35/70 grease trap equipped with a flow control valve. size 700 35/70 grease trap equipped with a flow control valve.
 5. Finished surfaces surrounding enclosure shall provide drainage away from enclosure.
 6. All Food Facility Enclosures require a Building Permit and Design Review approval from the Community Development Department. The enclosure shall conform to all provisions of the California Fire Code and California Building Code. Enclosure walls and roof must be designed by an licensed architect, civil engineer or structural engineer.

CITY OF SANTA ROSA		
FOOD FACILITY ENCLOSURE		
SCALE: NONE	DATE: Sept.2002	
DWN: RH	APPROVED	FILE NO.
CHK:		STD.- 526

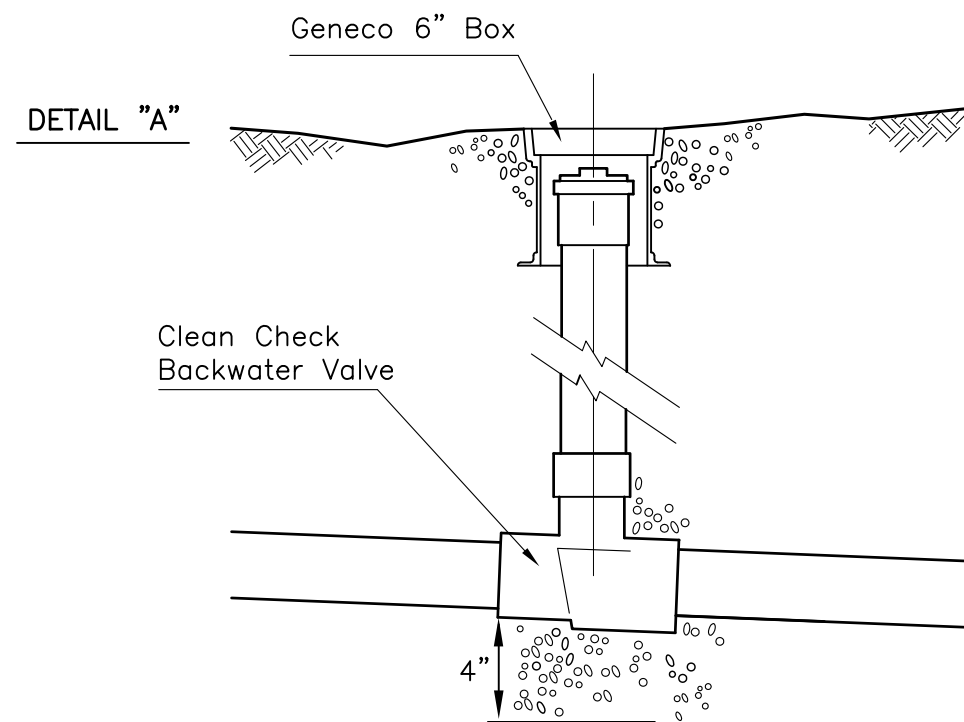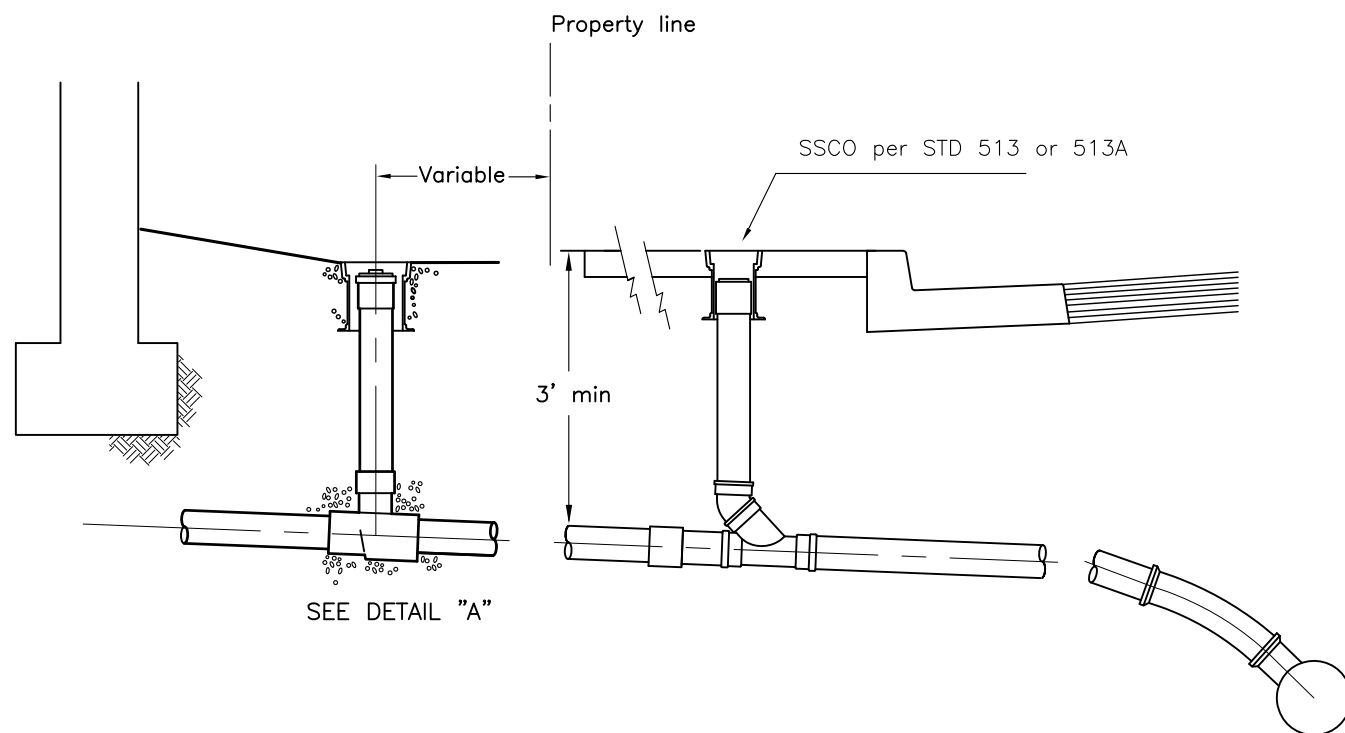


NOTES:

1. Sewage Backwater Valve Assembly to be installed on all laterals where the finish floor elevation is less than one foot above the first upstream manhole.
2. Property owner is responsible for the installation and maintenance of the sewage backwater valve assembly.
3. Use 4" extendable backwater valve if depth is greater than 24".

CITY OF SANTA ROSA

SEWAGE BACKWATER VALVE ASSEMBLY

SCALE: NONE	DATE: June 2009
DWN: RR	APPROVED
CHK: AA	FILE NO. STD. 527

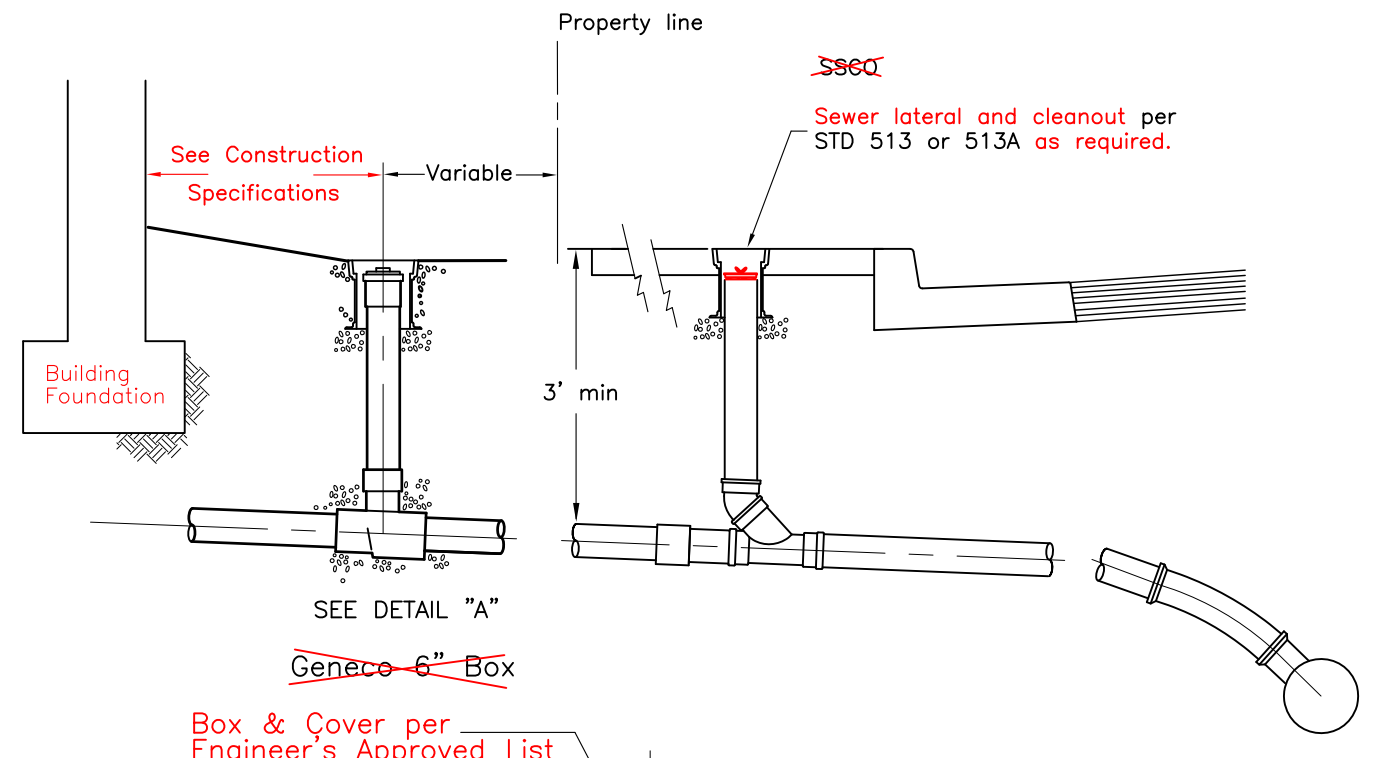

PVC or ABS Backwater Valve per Engineer's Approved List

1. Sewage Backwater Valve Assembly to be installed on all laterals where the finish floor elevation is less than one foot above the first upstream manhole.

DETAIL "A"

NOTES:

1. Sewage Backwater Valve Assembly to be installed on all laterals where cover is 3' or less at the main, or where the finish floor elevation is less than 1' above the first upstream manhole.
2. Property owner is responsible for the installation and maintenance of the sewage backwater valve assembly.
3. Use ~~4"~~ extendable backwater valve if depth is greater than 24".

CITY OF SANTA ROSA

SEWAGE BACKWATER VALVE ASSEMBLY

SCALE: NONE	DATE: Mar. 2016
DWN: RR	APPROVED
CHK: AA	FILE NO. STD. 527

SANITARY SEWER SYSTEM CONSTRUCTION STANDARD SPECIFICATIONS

SECTION 13071 — SANITARY SEWERS SYSTEM CONSTRUCTION

130-1.01 Description

All sanitary sewer system components and related items for new construction and rehabilitation projects shall be constructed in accordance with all applicable City Standards, the latest version of the Standard Specifications as they apply, and any modifications herein. Any proposed deviations must first be approved in writing by the Director of Santa Rosa Water.

The Contractor shall provide all means necessary, to the satisfaction of the Engineer, to ensure continuous service to all existing customers during and after work hours, weekends and holidays, including the installation of temporary lines and/or temporary pumping equipment. Sewage shall be controlled in a pipeline at all times and flows or leaks in the street or open ditches shall not be allowed.

The Contractor shall provide a full size set of sanitary sewer system “record plans” for their project to the Engineer within 7 calendar days from the final connection to the City’s sanitary sewer system. All deviations from the improvement plans shall be recorded on the plans in red ink.

Permanent paving shall not take place until all underground work is finished, except as otherwise noted, and the Engineer has given written notice of acceptance to the Contractor.

~~71~~130-1.02 Materials

Sewer pipe shall be ductile iron pipe (DIP), or SDR 26 polyvinyl chloride (PVC) pipe.

Per U.S. et al., ex rel. Hendrix v. J-M Manufacturing Co., Inc., et al., Case No. ED CV-06-0055-GW (C.D. of CA), the City of Santa Rosa is not currently accepting PVC pipe manufactured by J-M Manufacturing Co. or JM Eagle for installation on City projects.

The pipe manufacturer shall legibly mark pipe materials. Name and/or trademark of manufacturer, nominal pipe size and manufacturing standard reference number shall be printed on the pipe.

The Contractor shall use a single manufacturer for each of the following types of items supplied for their project unless otherwise approved by the Engineer;

- Pipe
- Fittings
- Manhole components
- Lateral cleanout plugs

For a list of approved manhole components see the “Engineer’s List of Approved Items”.

Lateral bends from the cleanout to main shall be SDR 26 PVC gasket x spigot long radius bends.

Couplers used to connect PVC pipe to PVC pipe shall be SDR 26 PVC gasketed type. Transition couplings shall have Series 300 stainless steel shear bands with a minimum thickness of .012". Couplers used for ductile iron pipe shall be per the City's Water System Standards.

Bolt-down lids, as required per City Standards, shall be equipped with minimum 1/2" stainless steel bolts with a 3/4" hex-head. All bolts shall receive an application of an anti-galling lubricant prior to installation.

The City reserves the right to reject any material that may be supplied for use, whether on the "Engineer's List of Approved Items" or not. If the City obtains information indicating that a listed item is not performing satisfactorily or is found to be defective, that item will be rejected and the Contractor shall submit a replacement for review at no additional cost to the City.

130-1.02A Material Submittals

The Contractor shall submit to the Engineer, in writing, a list of all materials proposed to be used on this project, and any supporting documentation and/or samples required by the Water Department.

For materials listed on the current "Engineer's List of Approved Items" the Engineer shall be provided with the name of the manufacturer and model/part number for all material proposed for this project.

For any proposed material not listed on the "Engineer's List of Approved Items" the Contractor shall provide to the Engineer, the name of the manufacturer and model/part number along with supporting documentation and/or samples that will allow the Engineer to make an informed decision on acceptance or rejection of the material.

The Contractor shall provide submittals to the Engineer for all manhole components and their proposed construction prior to the start of work. Manholes shall be constructed per an accepted submittal and any request and approval for alteration must be in writing.

~~71~~130-1.02BA Polyvinyl Chloride (PVC) Pipe

PVC solid wall sewer pipe and fittings for gravity sewers shall be made from all new, rigid, unplasticized polyvinyl chloride in accordance with ASTM D-3034 and ~~ASTM~~ F-679 and shall have a minimum pipe stiffness of 46 psi. Joints shall be gasketed and conform to the requirements of ASTM D-3139 and ASTM F-477.

All pipe shall have a home mark to indicate proper insertion ~~full penetration~~ of the spigot when the joint is made. Bevel and lubricate all field cut PVC pipe per manufacturer's instructions before joining. ~~It field cutting of pipe removes~~

All PVC pipe entering or leaving a concrete structure shall have an approved ~~standard~~ manhole

gasket ~~, as supplied by the pipe manufacturer,~~ firmly fitted ~~clamped~~ around the pipe exterior and cast into the structure base or near the structure wall center as a water stop.

71130-1.02CB Restrained Joint (PVC) Pipe and Fittings

Restrained joint PVC pipe and fittings shall conform to the requirements of ASTM D-2241. Joints shall be gasketed and conform to the requirements of ASTM D-3139 and ASTM F-477.

71130-1.02DC Ductile Iron Pipe

Ductile iron pipe shall be ~~cement lined~~, new pipe conforming to AWWA Standard C151/A21.51, pressure class. The pipe shall be furnished with rubber gasket push-on, or mechanical joints ~~ends~~, except where ~~otherwise~~ specified on the plans.

Ductile iron sewer pipe and fittings shall be lined with Protecto401 Ceramic Epoxy or an approved equivalent. The interior of the pipe and fittings shall not have been previously lined and the liner shall be applied by a certified applicator where the pipe and/or fittings are manufactured or at a certified off site coating facility approved by the pipe and/or fitting manufacturer. The pipe and/or fitting manufacturer shall be fully responsible for insuring the liner complies with all manufacturer's recommendations, including, but not limited to, pipe wall preparation, wet and dry film thickness, coating integrity and curing prior to shipment to jobsite.

Any request for substitution shall be accompanied by documentation showing a history of successful use in sanitary sewer systems and that the liner was applied by a certified applicator with a history of applying linings to the interior of ductile iron pipe and fittings.

All ductile iron pipe buried underground shall be encased in polyethylene film in the tube form. Polyethylene material and installation procedure for the encasement shall conform to ANSI/AWWA C105/A21.5. ~~-99 or most recent issue.~~

~~Couplings for connection to the sewer main shall be of a type approved by the City Engineer.~~

71130-1.02ED Ductile Iron Restrained Joint Fittings

Restrained joint fittings shall be ductile iron in accordance with applicable requirements of ~~ANSI~~/AWWA C111/A21.11 and ~~ANSI~~/AWWA C153/A21.53 of latest revision and shall be compatible with the type and pressure class of pipe used.

71130-1.03 Excavation, ~~and~~ Backfill and Resurfacing

Excavation and backfill shall conform to Standard 215, "Standard Trench Detail" of the City of Santa Rosa Standard Plans.

Trench resurfacing shall conform to Standard 215 unless otherwise specified elsewhere.

If existing utility crossings or other potential conflicts are shown on the plans or specified in other

contract documents, the Contractor shall pot hole said areas as well as proposed connection points to the City's sanitary sewer system prior to the start of pipe laying. If conflicts are discovered during this investigation the Engineer shall be notified immediately.

It is the Contactor's responsibility to ensure that sewer components are laid and bedded on sound, stable material. All existing material that has been disturbed shall be removed from the trench prior to installation of new material. The Contractor shall promptly notify the Engineer of any field conditions that may affect alignment and/or grade.

Abandoned utilities found to reside in a common trench with sewer components shall be removed and disposed of prior to the installation of any new sewer facility unless otherwise directed by the Engineer. Any exposed pipe ends on abandoned lines that remain shall be plugged per Standard 507.

All excavations shall be able to accommodate equipment and personnel required for backfilling and compaction testing. If, in the opinion of the Engineer, typical compaction methods cannot be used, the Engineer may require the use of a pneumatic Pogo Stick/Powder Puff type compactor at no additional cost to the City. Excavations around new and existing manholes shall be a minimum of 24 inches wider than the outside of the barrel section.

Blasting shall not be permitted unless first approved of, in writing, by the Building Department and the Director of Santa Rosa Water.

Control density fill (CDF) shall be placed at the locations shown on the plans and where cover is less than 3 feet. CDF shall conform to Standard 215. A material submittal is required. All excavations in a traveled way with CDF backfill shall be plated or otherwise safely covered to allow for safe passage during curing.

All stumps and large roots encountered during trenching operations shall be removed to the satisfaction of the Engineer.

Trenching operations shall be conducted in such a manner that will not disturb existing facilities. The Contractor shall incur all costs associated with repairs needed, in the opinion of and to the satisfaction of the Engineer, by any such damage due to their operations.

The trench shall be opened sufficiently ahead of the pipe laying operations to reveal obstructions. Trench crossings shall be provided as necessary to accommodate public travel and to provide convenient access to adjacent properties. Flow shall be maintained in any sanitary sewers, storm drains, water lines, or water courses encountered in trenching.

Cutting of Asbestos Cement Pipe (ACP) shall be done utilizing a Pipe Cutter (snapper), of the proper type and size for the intended use. A ratcheting hand snapper shall only be used on ACP sizes of 6 inch and smaller. The "snapper", and all appurtenances shall have been inspected by the Contractor to ensure that it is in good working order prior to use.

If field conditions require an alternative method for cutting the ACP, the alternative method shall

comply with all laws and requirements as specified by OSHA, the Contractor's State Licensing Board, and any other governing body for this type of work.

In all cases, cutting, handling and disposal shall be done per the above stated governing bodies. Cut pipe shall be properly enclosed as soon as possible after removed from the trench. ~~All cutting, handling and disposal of asbestos cement pipe shall be done in accordance with the Contractor's State Licensing Law and all applicable laws and regulations.~~

When the public works involved will exceed an estimated \$25,000 for the excavation of any trench or trenches five feet or more in depth, the Contractor shall, except for subdivisions, submit to the ~~City~~ Engineer for acceptance in advance of job excavation, a detailed plan showing the design of shoring, bracing, sloping, or other provisions to be made for worker protection from the hazard of caving ground during the excavation of such trench or trenches. If such plan varies from the shoring system standards established by the construction safety orders, the plan shall be prepared by a registered civil or structural engineer. A permit to do the above described work ~~must~~ shall be obtained from the State of California, Division of Industrial Safety. Proof of such permit shall be submitted to the Engineer prior to starting the trench work.

Unless otherwise specified, ~~E~~ excess ~~M~~ material from excavation shall become the property of the Contractor and shall be disposed of to the satisfaction of the Engineer. ~~If the work is in existing City streets the excess material shall be removed from the site daily unless it has been preapproved for reuse.~~

Prior to disposal of any materials or operation of any equipment on sites provided by the Contractor for disposal of excess trench excavation owned by him, the Contractor shall submit to the Engineer written authorization for such disposal of materials and entry permission signed by the owners of the disposal site and the required permits.

On projects to remove and replace existing sewer facilities and the existing sewer main is a material other than asbestos, the Contractor shall assume that approximately 15% of all existing sanitary sewer laterals to be replaced are constructed of asbestos cement pipe. Where the existing sewer main material is asbestos cement, it should be assumed that all laterals are asbestos cement pipe. All related disposal costs shall be the bourn by the Contractor.

All excavated material shall be removed from the jobsite at the end of each day unless otherwise approved by the Engineer.

71130-1.04 Existing Manholes

~~Existing manholes and clean outs located within the street right of way shall be adjusted to conform to finished pavement grades in accordance with the details shown on the plans.~~

~~Prior to the removal of an existing manhole frame, a platform shall be constructed in the manhole above the top of the sewer to prevent any dirt or debris from falling into the sewer. The platform shall remain in place until all work on the manhole has been completed and the asphalt concrete has been placed around the manhole. Prior to the removal of the platform from the manhole, all~~

~~dirt and debris shall be removed.~~

~~Lowering of the manhole ring and cover shall be accomplished by the removal of existing concrete grade rings below the manhole ring or by removing the upper section of manhole barrel and substituting therefore a shorter section of barrel.~~

~~At the Contractors option, in lieu of removing and replacing barrel sections as above provided, the top of the existing upper barrel section may be trimmed and the taper section replaced on such trimmed surface provided, however, that such trimming shall not crack or otherwise damage the remaining portion of barrel section.~~

~~In the event that the portion of barrel section to remain is cracked or damaged or otherwise made unsuitable for use by such trimming, the entire section shall be removed and replaced with a new section of barrel.~~

~~Trimming of taper sections is not permitted.~~

~~All sections of the manhole shall be set in cement mortar or in approved gasket material. Trim excess gasket material and plaster inside joints smoothly. Manhole sections set in cement mortar shall be smoothly plastered inside and out.~~

~~After placing the surface course of asphalt concrete, all manholes and cleanouts shall be located and marked with white paint before the close of that working day.~~

~~Within two working days of paving, all manholes and clean out shall be adjusted to grade and inspected.~~

~~Existing grade adjustment rings in the adjustment of manhole frames shall become the property of the Contractor and, if undamaged and thoroughly cleaned of mortar, may be reused in the work. If not so used, they shall be disposed of away from the site of the work at the expense of the Contractor.~~

130-1.04 Trench Bracing and Shoring

All bracing and shoring shall conform to Section 7-1.02K(6) of the Standard Specifications or any later revision, and the Division of Industrial Safety Construction Safety Orders which are currently in use.

The Contractor shall take all necessary measures to protect the workers and adjacent areas and structures from the hazards of the trenching or excavation operations.

Trench sheeting or boxes shall be withdrawn in such a manner as to prevent caving at the walls of excavations or damage to piping or other structures. Sheeting shall be completely removed from the trench and no backfill shall be installed against the sheeting before it is removed.

Trenching operations shall be conducted in such a manner that will not disturb the existing curb,

gutter and existing utilities that are to remain in place.

71130-1.05 Pipe Laying

The Contractor shall provide the equipment, materials and personnel to maintain continuous sanitary sewer service to all customers, 24 hours a day and 7 days a week during construction, including but not limited to the installation of temporary lines and pumping equipment at no additional cost to the City unless otherwise specified. Any deviation from this requirement must first be approved by the Engineer.

Where ground water occurs, pumping shall continue until back filling has progressed to a sufficient height to prevent flotation of the pipe. Water shall be disposed of in such a manner as to cause no property damage or not be a hazard to public health.

Where construction consists of constructing a new main or extension of an existing main, the downstream end of the new main shall be securely closed with a tight fitting plug until the construction is accepted by the Engineer.

~~If the new sewer main is connecting to an existing main at a location other than an existing manhole, the Contractor shall pothole the existing sewer main to verify invert grades and locations.~~

Sewer pipe shall be installed on the alignment and grade as shown on the plans and in accordance with **applicable City Standards** and the Standard Specifications, or as directed by the Engineer. Existing sewer laterals shall be removed and replaced at the locations shown on the plans, or as directed by the Engineer.

Sewer pipe shall be laid in straight lines and on uniform rates of grade between points where changes in alignment or grade are shown on the plans. The interior of the pipe shall be free of foreign matter before lowering into the trench.

If proper separation between new sewer lines and water mains, per the latest guidelines from the California State Water Resources Control Board cannot be maintained, the Contractor shall inform the Engineer immediately to get direction, unless direction has already been provided in the contract documents. See Appendix "A" of the City of Santa Rosa Water Distribution System Design Standards for additional information and direction.

The pipe manufacturer's written instructions covering the installation of ~~his~~**their** pipe, and **any related materials**, shall be closely followed unless otherwise directed **or approved in writing** by the Engineer. ~~or these Special Provisions.~~ The trench shall not be backfilled until authorized by the Engineer. Pipe laying shall proceed upgrade with the spigots pointing in direction of flow. The invert of the pipe shall be set at required line and grade as determined from batter boards set not over 25 feet apart.

Electro-optical grade setting devices may be used provided that the device will be operated by a person proficient in its operation.

Any section of pipe found to be defective or which has had grade or joints disturbed shall be re-laid by the Contractor at ~~their~~^{his} expense.

Proper implements, tools and facilities satisfactory to the Engineer shall be provided and used by the Contractor for the safe and efficient execution of the work. All pipe, fittings and accessories shall be carefully lowered into the trench by means of derrick, ropes, or other suitable equipment in such a manner as to prevent damage to pipe and fittings. Under no circumstances shall pipe or accessories be dropped or dumped into the trench. The pipe and accessories shall be inspected for visible defects prior to lowering into trench. Any visibly defective or unsound pipe shall be replaced.

The line and grade of existing utilities shall not be altered. Any leakage caused in existing utilities by reason of the Contractor's operations shall be immediately repaired at the Contractor's expense.

Existing storm drains shall be supported or removed and replaced at the Contractor's option **and at no additional cost to the City**. In any case, the Contractor shall be responsible for maintaining the existing line and grade of the storm drains. If the ~~contractor~~^{Contractor} elects to remove and replace, ~~backfill~~ it shall be **done** in conformance with **all applicable City Standards and to the satisfaction of the Engineer**. ~~City STD Standard 215~~.

Existing water lines shall be supported in place with service maintained during construction. The Contractor shall be responsible for any damage to the water lines during construction and any damage resulting from improper backfilling.

Existing sewer lines shall be supported in place with service maintained during construction. The Contractor may, at ~~his~~^{their} option, remove and replace any sewer laterals which are not in use during construction. The Contractor shall be responsible for damage to sewer lines during construction and any damage resulting from improper backfilling.

Sewer lateral inverts shall be set above the midpoint of the sewer main **unless otherwise directed by the Engineer in writing**. Any lateral invert installed below the midpoint of the main without prior written approval shall be replaced and the lateral relayed at the Contractor's expense.

If the proposed sewer main is replacing an existing main but at a higher elevation, the Contractor shall submit a temporary connection plan to the Engineer for approval a minimum of 5 working days prior to start of work. The temporary connection plan shall include a schedule of work and will show how all existing flow will remain active. The Contractor shall continuously monitor the upstream manhole of any temporary connection.

Any temporary connections between new and existing sewer mains and/or manholes required for the progress of work shall be made with approved rigid piping and sheer band and/or gasketed couplings. If bends are required to make the connection, the bends shall be long radius bends unless otherwise approved.

Any proposed temporary main connection that may be in place longer than 24 hours, except those specified in Section 130-1.06 herein, shall be submitted to the Engineer for approval prior to

installation.

Both new and existing mains shall have the ability to be accessed individually for maintenance and emergency response by City personnel at all times. All temporary connection material shall be fully removed after its intended use.

Where a sewer main is to be installed in a pipe casing, installation shall be similar to City Standard 872 “Water Main Encasement and End Seal”, including joint restraints. All proposed material shall be submitted to the City for review and approval.

130-1.05A Abandon or Remove Existing Sanitary Sewer System Components

Abandonment of existing sewer components shall conform to applicable City Standards, specifically Standards 507 & 508, and any modifications specified in the contract documents.

Existing sewer system components shall be removed where shown on the Plans or to facilitate the progress of work. The Contactor must receive written approval from the Engineer prior to removing any component, fully or in part, that is active during construction. Any removed components from an active system shall be replaced with approved materials to the satisfaction of the Engineer.

When a sewer lateral is to be removed or abandoned in place that is connected to an existing main 12” and smaller that is to stay active, the connection shall be fully removed by cutting out a section of the main, at least 4 feet in length, and replacing the removed section with approved pipe and couplers. Where the lateral is to be removed or abandoned in place on a main 15” or larger, and the connection is by “break in” or tap, the lateral pipe and all appurtenances shall be removed from the main and an approved full circle stainless steel clamp installed over the penetration. The length of the full circle clamp shall provide a minimum of 2 inches of overlap over the penetration. The plugging or capping of connections on mains that are to stay active shall only be done with prior approval from the Director of Santa Rosa Water. Where a wye or tee fitting that is not a tapped fitting is installed on a trunk sewer, approval to plug or cap the wye or tee in an approved watertight manner is acceptable but the method and material must first be approved by the Water Department. When allowed, the cap or plug must be visible from the pipe interior when televising the main. Any plugging or capping of connections shall be noted on the record plans.

130-1.06 Sewer Laterals

Sewer laterals shall be installed or replaced at the locations shown on the Plans and in accordance with City Standards.

Unless replacing an existing sewer lateral, all laterals shall be designed and installed outside of driveways unless otherwise approved by the Director of Santa Rosa Water.

Unless otherwise specified, sewer laterals shall be installed with a two-way cleanout per City Standard 513A. unless conditions, as noted in the Standard, do not allow their use, or if otherwise specified in contract documents.

If field conditions require the installation of a one-way cleanout per the conditions called out in City Standard 513A, the cleanout shall be installed behind the sidewalk or at back of PUE, in accordance with City Standard 513, unless otherwise depicted on the Plans.

All two-way cleanouts shall be installed 18 to 24 inches behind face of curb unless otherwise shown on the Plans or approved by the Engineer.

Sewer lateral cleanouts installed in dirt or other soft landscaping, or in areas that may see traffic loads shall have a minimum 4" wide by 8" deep "round" concrete collar set on a compacted 4" layer of 3/4" drain rock. The top surface of the cleanout shall be installed 1/8" to 1/4" above grade with the collar sloped away and matching the surrounding grade at the perimeter.

Where a project involves the replacement of existing sewer laterals, the estimated locations of the existing laterals that are shown on the Plans are based on record information, television inspection, and field evidence. This information is available for review upon request. The City assumes no responsibility for the accuracy of this information or the inadvertent omission of any such information. Not all existing sewer laterals are guaranteed to be located through these means, the Contractor may, therefore encounter sewer laterals not shown on the Plans. The Contractor shall have the sole responsibility for determining the exact location for all existing laterals. During sewer mainline construction but prior to the installation of each individual new sewer wye on the main, the Contractor shall determine the exact location of the existing sewer lateral at back of sidewalk or PUE. Two acceptable methods of locating a sewer lateral at the back of sidewalk are:

1. Removing sidewalk and/or potholing by hand digging at the back of sidewalk to locate the existing lateral pipe a minimum of 24-hours prior to sewer main installation in that area;
2. Inserting a metallic electrician's "fish tape" into the existing lateral pipe after the pipe is exposed during sewer main excavation and tracing the "fish tape" to the back of sidewalk using a pipe and cable metal locator.

If the Contractor chooses to use method "2" above and cannot locate the existing sewer lateral at the back of sidewalk, they shall locate the lateral by potholing at back of sidewalk prior to the installation of the wye at the main.

Typically, each active sewer lateral found to exist shall be replaced, unless specifically deleted by the Engineer.

If a sewer lateral shown to be replaced appears to be inactive the Contractor shall notify the Engineer and then attempt to verify their conclusion.

All sewer laterals shall be installed perpendicular to the curb unless otherwise shown on the Plans or approved by the Engineer. Any lateral that is not installed perpendicular to the curb shall tracer wire installed in the following manner:

1. Wrap wire two times around wye connection at main and secure.

2. Lay both ends on top of and along the lateral to the cleanout and up the cleanout riser. Both ends of wire shall extend approximately 6 inches beyond riser.
3. Secure wire to top of lateral pipe at approximately 5 foot intervals. Ends of wire must be easily accessible inside the cleanout box.

For tracer wire specifications see Sanitary Sewer System Design Standards.

Any change in alignment needed from face of curb to back of sidewalk or PUE shall be accomplished using long radius bends. If the cleanout is installed 18 to 24 inches behind face of curb all alignment changes shall take place between the cleanout and the back of sidewalk or PUE. Any use of short bends in this area must first be approved by the Water Department.

Connections to existing laterals shall be made at back of sidewalk or PUE unless otherwise specified herein or depicted on the Project Plans. Prior to connecting, the Contractor shall investigate to see if there is an existing cleanout not already shown to be removed located beyond where the typical connection point would be and up to three feet behind the back of sidewalk. If an existing cleanout is discovered within these limits the Contractor shall remove it and any existing lateral piping as needed and then make the connection using approved pipe and couplings.

A 4" high letter 'S' shall be legibly inscribed in the face of new and existing curbs at the location of each lateral. Where bends are required behind the curb to make a connection an additional 'S' shall be legibly inscribed at the back of sidewalk where the connection to the existing lateral was made.

Whether shown to be installed on the plans or not, all sewer laterals that; have 3' or less cover at the connection to the main; or, that are connected to the main within 5 feet of an upstream manhole, shall have a same size as lateral "Clean Check PVC Extendable" or approved equivalent backwater valve installed. The valve shall be installed per Standard 527 within 5' of the building, if conditions allow. The exact location shall be determined in the field by the Engineer after the Contractor has located the onsite alignment of any existing lateral using a fish tape and pipe and metal locator or other approved method. Any valve installed onto an existing lateral shall have a minimum of 1 foot sections of approved pipe installed on both ends of the lateral and connected to the existing lateral with approved couplings. If installing a 6" valve, it shall be covered with a Christy G5 box, or approved equivalent set to grade with a lid marked "SEWER".

Active sewer laterals are to remain in service at all times, to facilitate this when removing and replacing an existing main the Contractor shall install a temporary connection between the new wye and the existing lateral until the new sewer lateral is constructed.

Plastic flex pipe may be used for temporary connections between active existing sewer laterals and the new wyes on the main. The flex pipe shall be the same size as the existing lateral pipe and shall be connected to the new wye and the existing lateral by means of an approved flexible sewer coupling. Squeezing the flex pipe and inserting it into the cut end of the existing lateral or into the lateral opening of the wye will not be allowed. All temporary connection material shall be removed from the trench prior to final compaction.

Temporary sewer lateral connections shall be replaced with permanent laterals after installation of the sewer mainline is completed for each block, or at a maximum of 20 calendar days, whichever is sooner.

Provide 1' minimum clearance between wyes on all sewer mains as measured between adjacent bell ends.

Sewer wyes installed at incorrect locations shall be removed and replaced with a 4' minimum length of pipe and approved couplings. Capping of wyes installed at incorrect locations will not be allowed. Prior to installing wyes on the main, the Contractor shall investigate to ensure that the proposed alignment of new laterals will not be in conflict with any other facilities, existing or proposed. The Contractor shall promptly notify the Engineer of any field conditions that prohibit installing the wye in accordance with City Specifications and/or Standards.

A minimum separation of 3' shall exist between new sewer laterals and existing water services. If this separation requirement cannot be met the Contractor shall notify the Engineer immediately for direction prior to continuing work on this lateral. In all cases, a minimum of 5' separation is required between new sewer laterals and new water services.

Sewer laterals constructed under existing curb, gutter and driveway culverts shall be accomplished by use of a trenchless method approved by the Engineer, unless otherwise specified. Boring under sidewalks and/or concrete filled planter strips will not be allowed. Boreholes shall be only large enough to allow for the size of pipe to be installed. If the Contractor's operations disturb the supporting soil, the Engineer may require the removal and replacement of any undermined curb, gutter or culvert; and/or the use of CDF backfill at the Contractor's expense. The limits of the curb and gutter replacement and any required dowelling will be at the discretion of the Engineer at the Contractor's expense.

The Contractor shall remove and replace existing sidewalk and concrete planter strips for the installation of sewer laterals to the nearest transverse score mark on both sides of the lateral. All concrete removed shall be backfilled and compacted level with temporary asphalt concrete or covered with 1" thick plywood, laid flat with ADA compliant tapers on both ends.

Where an excavation for a new sewer lateral occurs within the drip line of any tree the Contractor shall hand dig to protect tree roots as directed by the Engineer. Root pruning shall be done only when directed by the Engineer and shall be accomplished by use of sharp tools appropriate for the size of the root to be cut. Each cut shall be clean with no torn bark or splintered wood remaining on the root. At no time shall roots be pulled on by excavating equipment.

Existing irrigation facilities not shown on the plans may be encountered during sewer lateral installation. The Contractor shall repair any damage to existing irrigation facilities caused by their operations.

Where an existing sewer main is a material other than asbestos cement, the Contractor shall assume that approximately 15% of all existing sanitary sewer laterals to be replaced are constructed of asbestos cement pipe. Where the existing sewer main material is asbestos cement, it should be

assumed that all laterals are asbestos cement pipe. All related removal and disposal costs shall be the responsibility of the Contractor.

The Contractor shall notify and coordinate the replacement of individual sewer laterals with the effected resident or business.

71130-1.07 Sewer Structures

All active manholes shall be considered as confined spaces.

Manholes shall be constructed per an accepted submittal and any request and approval for alteration must be in writing.

Manholes shall be standard precast concrete manholes as detailed on ~~City STD~~ City Standard 500. Mains larger than 18" in diameter require 60" diameter manholes. ~~Precast concrete manhole bases must be from list approved by the City Engineer.~~

Manhole bases may be poured-in-place concrete on undisturbed earth. The bases shall be poured full thickness against the side of the manhole excavation or to dimensions shown on ~~City Std~~ Standard 500. The manhole excavation site shall be dewatered before pouring.

Pre-cast manhole bases, conforming to City Standard 500 in dimensions and the requirements outlined below for materials may be used. Such pre-cast bases shall be placed on a minimum 6" thick cushion of drain rock, as specified in ~~City~~ Standard 500. The drain rock shall extend a minimum of 6" beyond the outside edges of the base.

Precast manhole bases shall be constructed per ASTM C478. Concrete for cast-in-place manhole bases shall be Portland cement concrete in compliance with Section 90 of the City Standards and Specifications. ~~Concrete for manhole bases shall be class "A" Portland Cement concrete conforming to the applicable requirements of Section 90 of the Standard Specifications. The portland cement shall be Type V conforming to ASTM Designation: C-150 or low alkali Type II cement meeting the requirements for Type V cement.~~

If a new manhole is to be installed on an existing asbestos cement main, the Contractor shall remove all asbestos cement piping to a minimum of 12" beyond the manhole trench and into the mainline trench, any visible joints up to 36" beyond the manhole trench shall also be removed. All replacement materials shall be per City Standards, and all removed asbestos cement material shall be disposed of in accordance with all laws and regulations.

Except as noted below, or where otherwise specified, all manholes regardless of diameter shall have concentric tapered sections.

Prior to any work taking place in a new or existing manhole or other sewer structure, a platform shall be constructed in the manhole above the top of the sewer to prevent any dirt or debris from entering into the sewer line. The platform shall remain in place until all work on the manhole has been completed. All dirt and debris shall be removed from the platform prior to its removal.

Eccentric tapered sections shall be installed when the installation of an inside drop is required. Where a manhole has a single drop structure the opening of the eccentric tapered section shall be directly over the drop. Where multiple drops are required, the type of tapered section along with any needed alignment of the opening shall be determined by the Water Department.

Where the constructed height of a precast base does not allow for the installation of a tapered section due to rim to invert elevation constraints, the Contractor shall submit for a cast-in-place base for review. Slab sections shall only be considered where the height of a cast-in-place base will not allow for the installation of a tapered section.

Where steel reinforcement is required in manhole base construction, such reinforcement shall be furnished and placed as shown on the plans and in accordance with the applicable provisions of Section 52 of the Standard Specifications.

The base slab and initial riser section shall be connected with integrally poured concrete to create a watertight joint. Flow channels shall be constructed as shown on the plans. Changes in size and/or grade shall be made gradually in constructed channels, and changes in direction by shall have smooth curves with proper radiuses that direct flow toward the outlet pipe and minimizes turbulence. All finished surfaces shall be smoothly troweled with a steel trowel. All manhole barrels and taper section shall be precast concrete sections using Type V Portland cement complying with ASTM Designation: C 150 or low-alkali Type II cement meeting the requirements for Type V cement.

The 48" and 60" diameter barrels and taper sections shall be constructed in accordance with the applicable provisions of ASTM Designation: C 478 and shall be inspected by the Engineer to determine that the interior surfaces are smooth and free of cracks, chips, pockets or depressions.

Manhole frames and covers shall be in accordance with City-Standard 512. Tops of manhole frames and covers shall be set accurately to finished grade in paved streets and one-1 foot above finished grade in unimproved areas. The frames shall be evenly set on the manhole on a Portland cement mortar bed. Where manholes are set above finished grade, the earth shall be mounded up around the manhole in a neat and acceptable manner to the satisfaction of the Engineer.

The entire interior surface of all new manholes, and existing manhole being connected to, shall be coated including the flow channel down to the spring line after all pickup points, cracks and/or chips have been patched and existing surfaces prepared. Coating and patching materials shall be per the Engineer's List of Approved Items and shall be applied in accordance with the manufacturer's recommendations.

All joints in manholes shall be sealed by means of a preformed, self-bonding, self-sealing plastic gasket from the Engineer's List of Approved Items, such as "Ram-Nek", manufactured by the K.T. Snyder Company, Houston, Texas, or an approved equivalent. Joint seals shall be installed in full compliance with the manufacturer's current recommendations.

The interior surface of all sanitary sewer main line cleanouts (area under frame and cover and

around pipe), shall be troweled and brushed smooth and free of pockets or depressions.

Except as otherwise specified, all manholes on active mains shall be accessible at all times.

After placing the surface course of asphalt concrete, all manholes and cleanouts shall be located and marked with white paint before the close of that work day.

Within two working days of paving, all manholes and cleanouts shall be adjusted to grade and inspected.

130-1.07A Existing Manholes

Existing manholes and clean outs located within the street right of way shall be adjusted to conform to finished pavement grades in accordance with the details shown on the plans.

When a new sewer pipe is connected to an existing manhole, the manhole shall be modified to accept the new size of pipe and grouted to form a new flow channel in the manhole base. The wall of the manhole shall be breached by core drilling, sawing, or other approved method that does not disturb the manhole. The Contractor shall seal the penetration with StopAQ™, SealGuard II, or an approved equivalent water stop, and shall grout the sealed penetration with a rapid set, high strength, non-shrink cementitious mortar to protect the sealer. The Contractor shall backfill the exterior of the manhole around the pipe penetration with concrete to stabilize the main and create a watertight connection.

When any modifications are made to a new or existing manhole, the Contractor shall use a bonding agent such as Sakrete Concrete Bonder and Fortifier, or approved equivalent, to adhere modification material to the existing structure.

Prior to the removal of an existing manhole frame, a platform shall be constructed in the manhole above the top of the sewer to prevent any dirt or debris from falling into the sewer. The platform shall remain in place until all work on the manhole has been completed. Prior to the removal of the platform from the manhole, all dirt and debris shall be removed.

Lowering of the manhole ring frame and cover shall can be accomplished by the removal of existing concrete grade rings below the manhole ring frame or by removing the upper section of manhole barrel and substituting therefore a shorter section of barrel.

At the Contractors option, in lieu of removing and replacing barrel sections as above provided, the top of the existing upper barrel section may be trimmed and the taper section replaced on such trimmed surface provided, however, that such trimming shall not crack or otherwise damage the remaining portion of barrel section and that the new joint can be sealed watertight.

In the event that the portion of barrel section to remain is cracked or damaged or otherwise made unsuitable for use by such trimming, the entire section shall be removed and replaced with a new section of barrel.

Trimming of taper sections is not permitted.

All sections of the manhole shall be set in cement mortar or in approved gasket material. Trim excess gasket material and plaster inside joints smoothly. Manhole sections set in cement mortar shall be smoothly plastered inside and out.

After placing the surface course of asphalt concrete, all manholes and cleanouts shall be located and marked with white paint before the close of that working day.

Within two working days of paving, all manholes and clean out shall be adjusted to grade and inspected.

Existing grade adjustment rings in the adjustment of manhole frames shall become the property of the Contractor and, if undamaged and thoroughly cleaned of mortar, may be reused in the work. If not so used, they shall be disposed of away from the site of the work at the expense of the Contractor.

71130-1.08 Testing of Sewers

Testing of all portions of the sewer including manholes is required, and it's the Contractor's responsibility to coordinate all testing and inspections with the Engineer.

The Contractor, at their option, may conduct testing at any time during construction, however, final inspection and testing for acceptance shall take place only after all sewer facilities have been installed and all trenches backfilled and compacted, including roadway base rock as specified elsewhere in these specifications.

~~For either exfiltration or infiltration test, the maximum leakage shall not exceed 250 gallons per inch of pipe diameter per mile per 24 hours as measured over a period of 30 minutes minimum. Should the leakage exceed the maximum allowable rate, the contractor shall repair, overhaul, or rebuild the defective portion of the sewer line to the satisfaction of the Engineer at no additional cost to the City. After repairs have been completed by the Contractor, the line shall be retested as specified above, all at no cost to the City.~~

Manholes, ~~after all inlets and outlets have been plugged,~~ shall be filled with water to the rim of the frame casting and shall lose no more than 2 inches over a period of 30 minutes.

Even though the test for leakage is within the prescribed limits, the Contractor shall repair any obvious leaks.

~~The test shall be performed after the line has been laid and all backfill placed and compacted, including roadway base rock as specified elsewhere in these specifications. The Contractor, at his their option, may test the line at any time during construction. However, the final test for acceptance shall be made only after all backfill is in place and compacted.~~

~~In the event that the exfiltration test prescribed above is impractical due to wet trench conditions,~~

~~these portions of the sewer line where such conditions are encountered will be tested for infiltration. The Engineer shall determine whether the exfiltration or infiltration test will be used.~~

~~Even though the test for leakage is within the prescribed limits, the Contractor shall repair any obvious leaks.~~

In lieu of the water test, testing of sewer manholes may be done by vacuum testing as specified herein. If the vacuum testing method is used, all manholes shall be tested for leakage in accordance with ASTM C 1244-93 as modified herein.

Vacuum testing shall not take place until all permanent paving is complete.

Installation and operation of vacuum equipment and indicating devices must be in accordance with manufacturer's recommendations and performance specifications, which must be provided by the manufacturer and approved by the Engineer. The equipment must be capable of testing the entire manhole, including the cast iron frame and grade adjustment rings.

All new or rehabilitated sanitary sewer manholes shall be tested unless otherwise directed by the Engineer. If the manhole fails the test, the manhole shall be repaired and retested at the Contractor's expense. If manhole joint sealants are compromised during the vacuum test, the manhole must be disassembled and the joint sealants replaced. If there is reason to believe that the manhole has been disturbed after the initial vacuum test, additional tests may be requested by the Engineer and performed at the Contractor's expense.

The Contractor may pre-test manholes at any time during construction. Any pre-test results are solely for the Contractor's use and shall not be accepted as the final test.

Testing shall be done in the following manner:

1. All lift holes and joints shall be grouted and the entire manhole, including grade rings, sealed prior to testing.
2. All pipes entering the manhole shall be temporarily plugged, taking care to securely brace the pipes and plugs to prevent them from being drawn into the manhole.
3. The test head shall be placed in accordance with the manufacturer's recommendations. The test unit shall be braced against the manhole frame and not the grade ring(s) or taper.
4. The vacuum gauge and test equipment used for this test shall be supplied by the Contractor and shall be operated per manufacturer's specifications by qualified personnel. Accuracy and calibration of the gauge shall be certified by a reliable testing firm at six month intervals, or when requested by the Engineer.

A vacuum of 10 inches Hg (4.91 PSI) of mercury shall be drawn on the manhole, the valve on the vacuum line of the test head closed, and the vacuum pump shut off. The time it takes the indicator gauge to drop from 10 inches Hg (4.91 PSI) to 9 inches Hg (4.4 PSI) shall be measured. The

manhole will pass the vacuum test if the time is greater than shown in the following table:

Minimum Test Time Based On Manhole Diameter (sec.)

<u>Manhole Depth in Feet</u>	<u>Manhole Diameter in Inches</u>			Time in Seconds
	48	60	72	
0-4	10	13	16	
4-8	20	26	33	
8-12	30	39	49	
12-16	40	52	67	
16-20	50	65	81	
20-24	59	78	97	
24-30	74	98	121	

After the vacuum test, manholes shall be visually inspected for leaks and defects and repaired as required by the Engineer.

For either exfiltration or infiltration test on sewer lines, the maximum leakage shall not exceed 250 gallons per inch of pipe diameter per mile per 24 hours as measured over a period of 30 minutes minimum. Should the leakage exceed the maximum allowable rate, the contractor shall repair, overhaul, or rebuild the defective portion of the sewer line to the satisfaction of the Engineer at no additional cost to the City. After repairs have been completed by the Contractor, the line shall be retested as specified above, all at no cost to the City.

In the event that the exfiltration test prescribed above is impractical due to wet trench conditions, these portions of the sewer line where such conditions are encountered will be tested for infiltration. The Engineer shall determine whether the exfiltration or infiltration test will be used.

Low pressure air testing may be used on sewer lines in lieu of water testing at the option of the Contractor. Water testing may still be required by the Engineer for certain installations.

The following procedure shall be used for low pressure air testing:

1. Clean pipe to be tested by propelling a snug fitting inflated rubber ball through the pipe with water. Remove any debris.
2. Plug all pipe outlets with suitable test plugs. Brace each plug securely.
3. If the pipe to be tested is submerged in ground water, insert a pipe probe, by boring or jetting, into the backfill material adjacent to the center of the pipe, and determine the pressure in the probe when air passes slowly through it. This is the back pressure due to ground water submergence over the end of the probe. All gauge pressures in the test should be increased by this amount.
4. Add air slowly to the portion of the pipe installation under test until the internal pressure is raised to 5.0 p.s.i.g.

5. Check exposed pipe and plugs for abnormal leakage by coating with a soap solution. If any leakage is observed, bleed off air and make necessary repairs.
6. After an internal pressure of 5.0 p.s.i.g. is obtained, allow at least two minutes for air temperature to stabilize, adding only the amount of air required to maintain pressure.
7. After the two minute period, disconnect the air supply and start stopwatch. The pressure of 5.0 p.s.i.g. shall be maintained for 5 minutes.
8. As an alternate, the contractor may request the air testing procedure as presented in Section 306-1.4.4 of the ~~1997~~2012 edition of the "Greenbook" Standard Specifications.

After pipe installation and placement and compaction of backfill, but prior to placement of pavement, all PVC pipe shall be cleaned and then mandrel tested for obstructions, such as, but not limited to, deflections, joint offsets and lateral pipe intrusions. A rigid mandrel, conforming to City Standard 518 shall be pulled through the pipe by hand. The minimum length of the circular portion of the mandrel shall be equal to the nominal diameter of the pipe. All obstructions encountered by the mandrel shall be corrected by the Contractor. Obstructions due to deflection shall be corrected by replacement of the over-deflected pipe. Mechanical re-rounding is not permitted.

If a section of pipe fails to meet the mandrel test and is reinstalled and fails the second time, said section(s) of pipe shall be replaced with an approved rigid pipe material.

The contractor shall furnish mandrel as shown on the City Standards.

The Contractor shall retest PVC pipe using a mandrel conforming to City Standard 518 eleven (11) months after recordation of Notice of Completion of a Public Works Sewer Contract or after the acceptance by the City Council of a subdivision. Any pipe which fails to pass the mandrel test shall be replaced at the expense of the Contractor. The City reserves the right to determine the longitudinal limits of any pipe that is required to be replaced. Pipe replacement shall be guaranteed by the project maintenance bond.

130-1.09 Televising Inspection

Prior to scheduling televising inspection work, all sanitary sewer construction, and any other underground work which, in the opinion of the Director of Santa Rosa Water, has the potential to impact sanitary sewer work, shall be installed, their trenches compacted, and all other testing and inspections completed and accepted. Final paving over the work shall not take place until all underground work, including television inspection, is completed and accepted by the Engineer.

The Contractor shall hire an independent television inspection service to perform a closed circuit television inspection of all newly constructed sewers lines, including laterals from the main to the cleanout, and if lateral line is a replacement, from cleanout to connection point of the existing lateral.

The Contractor shall notify the Engineer in writing 2 working days in advance of the date for television inspection. The Engineer or their authorized representative shall be given the opportunity to be present during the inspection. Upon receipt of the completed televising inspection digital video files and written logs, the Engineer shall be allowed 10 working days to review the video records and logs before giving written notice of acceptance and/or deficiencies of the lines to the Contractor.

The Contractor shall supply plans and specifications for this work to the televising subcontractor with manhole and mainline cleanout numbers, street names, addresses and any other information required to facilitate the work.

During this inspection, the Contractor or their authorized representative shall be present to observe the televising inspection. Acceptance of any portion of the sanitary sewer work shall not be given in the field at the time of televising.

The Engineer shall only receive video and written logs for areas not known by the Contractor to need correction. If while conducting the initial television inspection in the field, the General Contractor or their authorized representative discovers areas that need correction, these corrections shall be made and the area televised again prior to submitting the logs to the Engineer for review. If footage of video that is not required for inspection, such as; areas known to need repair, stationary video footage in sanitary sewer lines other than where required and footage not of sanitary sewer facilities, the submittal will be rejected.

Any damage to facilities or obstruction to service caused by the televising operations shall be corrected immediately by the Contractor at no cost to the City.

The Contractor shall obtain permission from the Engineer prior to the removal of any manmade or natural obstruction needed to complete this work. Any item removed shall be replaced in kind to the satisfaction of the Engineer, and will be done at the Contractor's expense.

All lines shall be flushed clean with a high-pressure commercial sewer flusher unit or by balling prior to televising. If required to televise an existing line it may be necessary to remove roots, grease or other obstructions prior to flushing per these Special Provisions. The equipment shall be appropriate for the type of obstruction being removed and shall not damage the pipe in any way. All debris shall be trapped at the first downstream manhole and removed. Debris will be hauled to an appropriate disposal site at the Contractor's expense.

After flushing and prior to televising, an approved source of water will be discharged into the upstream manhole or mainline cleanout until water flows out of the downstream manhole. This is to be done no more than 24 hours before the video inspection takes place. High pressure flushing of the line is not to be considered as a substitute for this requirement. This shall be done to insure that all dips or sags are filled before televising, if the sanitary sewer has live flow, the Engineer may waive this requirement. Live flows that are greater than the depth of the gauge shall be temporarily plugged upstream and bypass pumped to allow for proper televising.

The televising of all lines shall be recorded in a digital color format that does not require the use

of specialized equipment and/or programs not already in use by the City's Engineering Department. Video files shall be on non-rewritable DVD disc(s) or flash drive(s), and shall be delivered to the Engineer along with computer program generated written inspection logs. The video files and written logs shall become the property of the City of Santa Rosa. Every televised run (manhole to manhole, manhole to mainline cleanout, and laterals) shall be recorded as a separate video file, with the name of the file being the manhole and/or mainline cleanout numbers for the main, and the property address for the lateral. A lateral file shall consist of the run from the clean out to the connection at the main and the run from the clean out to the connection of the existing lateral.

A pan and tilt color camera shall be used for all video inspection of main lines and shall be one specifically designed and constructed for such inspections. The camera shall be mounted on adjustable skids, a tractor, or when approved by the Engineer, a raft to keep it in the center of the pipe. Lighting for the camera shall be supplied by a lamp on the camera, capable of being dimmed or brightened remotely from the control panel. The lighting system shall be capable of lighting the entire periphery of the pipe. The camera shall be operative in 100% humidity conditions and shall have a minimum of 330 lines of resolution. The camera equipment shall produce a continuously monitored color picture, which will have the resolution capability to discern small hairline cracks and other minor and major defects in the sanitary sewer line. The camera equipment shall be capable of producing digital still pictures for permanent record as required. The camera shall be self-propelled or pulled by a cable winch from the downstream manhole, through the line along the axis of the pipe, at a uniform rate of 1/2 foot per second maximum.

Where infiltration in the sanitary sewer line is suspected, the camera shall be stopped for at least 30 seconds in the area of question and the camera shall pan and/or tilt as needed to ascertain that infiltration is occurring and the possible cause. The camera shall stop at all lateral connections, defects, sags, etc for a period of at least 10 seconds and the camera shall pan and/or tilt as needed so that all portions of the connection or defect that is visible from within the main line can be completely inspected.

Each pipe run between manholes being inspected may be required to be isolated from the remainder of the line by the use of a line plug to insure total viewing of the inside periphery of the pipe. The inspection shall be performed in a forward and/or backward direction according to line conditions at the time of the inspection. Every effort shall be made by the Contractor to televise in the same direction as the flow, especially during live flow conditions. The Engineer must approve any video inspection that goes against the flow.

Televising subcontractor personnel shall be in constant communication during the televising operation.

The Contractor shall keep a copy of the written logs on site that clearly show the exact location, in relation to the starting manhole/mainline cleanout or lateral cleanout, of each following item discovered during the television inspection; infiltration points, lateral locations, cracks, open/pulled joints, roots, broken or collapsed sections, grease, debris, location of dips (starting and ending footage plus depth), and any other discernible features. In addition to the items noted, the video and written logs shall also note; name of project, general contractor, date, line size, length

of section, manhole condition and live flow. Measurement for location of defects shall be at ground level by means of a metering device. Markings on the cable, or the like, which would require interpolation for depth of manhole or lateral cleanout will not be allowed. Measurement meters will be accurate to plus or minus one foot in a thousand and must show on video. A one-inch depth gauge pulled or pushed in front of the camera is required for all main lines up to and including 12 inch. For any line larger the Contractor shall verify required gauge size with the Engineer prior to scheduling television inspection. Measurement of laterals must be recorded on video and written log from bottom of cleanout to main and bottom of cleanout to connection at existing lateral.

~~The Contractor shall hire an independent television inspection service to perform a closedcircuit television inspection of all newly constructed sewers including laterals from the main to the cleanout. A video tape of the television inspection shall be produced and delivered to the Engineer in color VHS format, together with a typed log of the inspection.~~

The following conditions shall exist prior to the television inspection:

1. All sewer lines shall be in installed, backfilled and compacted;
2. All structures shall be in place, all channeling complete and all pipelines accessible from structures;
3. All other underground facilities, utility piping and conduit within two feet of the sewer main, shall be installed, **backfilled and compacted**;
4. ~~All compaction required shall be completed;~~
5. Pipelines to be **video** inspected shall **have been balled,** flushed and **all other testing completed and accepted, including the mandrel tested**;
6. ~~The final air or water test shall have been completed.~~
7. Immediately before the television inspection, run fresh water into the sewer until it passes through the downstream manhole.

All work performed must meet the quality and clarity standards set by the City of Santa Rosa and is subject to City review and rejection.

Deficiencies revealed by the television inspection, in the opinion of the Engineer, shall be repaired by the Contractor to the satisfaction of the Engineer. After all required repairs are completed the areas of repair shall be televised again at the Contractor's expense.

The Contractor shall be notified in writing of any deficiencies revealed by the television inspection that will require repair, following which, the Contractor shall excavate and make the necessary repairs and perform a television re-inspection. Television re-inspection shall be at the Contractor's expense.

~~When the above work has been completed, the Contractor shall notify the Engineer 48 hours in advance of the date for television inspection. During this inspection, the Contractor or his authorized representative shall be present to observe the video pictures as provided by the television camera.~~

Although the final determination for required repairs will be made by the Engineer, ~~the following video tape observations shall be considered~~ are typical defects found in the construction of the sewer pipelines and will require corrections prior to acceptance ~~whether or not there is a passing air test:~~

1. Off grade - 0.08 foot, or over, deviation from grade;
2. Separations over 1" in coupled together mainline pipe joints where the pipe is 8-inches in diameter or smaller, and 2"-inches or more in coupled together mainline pipe joints where the pipe diameters are 10-inch or larger; ~~using couplers;~~
- ~~2.3.~~ Separations over 1/2-inch in coupled together lateral piping;
- ~~3.4.~~ Any open joint or pulled ~~Joint~~ joint that is beyond manufacturers installation recommendations~~separations over 3/4"~~;
4. Offset joints;
5. Chips in pipe ends - none more than 1/4" deep;
6. Cracked or damaged pipe or evidence of the presence of an external object bearing upon the pipe (rocks, roots, etc.);
7. Infiltration;
8. Debris or other foreign objects;
9. Other obvious deficiencies when compared to Approved Plans and Specifications, these Standards and Standard Drawings.

The above list is not a complete list of items that may be considered as deficiencies. The final determination for any required repair shall be made by the Engineer.

~~The contractor shall be notified in writing of any deficiencies revealed by the television inspection that will require repair, following which the Contractor shall excavate and make the necessary repairs and request a television re-inspection. Television re-inspection shall be at the contractor's expense.~~

130-1.10 Bypass Pumping and/or Diversion

When bypass pumping and/or flow diversion is required to keep existing services active, the Contractor shall provide a system that furnishes and maintains all personnel, equipment, tools, power, piping and incidentals required to maintain existing sewer flows and services without interruption.

The Contractor shall submit a bypass pumping and/or diversion plan for review by the Engineer at least 10 working days prior to planned commencement of bypass pumping and/or diversion. The Engineer shall approve the bypass pumping plan before commencing any bypass pumping work. The Contractor shall notify the Engineer 2 working days prior to commencing with the bypass pumping operation.

Any proposed flow diversion plan that includes a temporary connection to existing sewer components shall also comply with Section 130-1.05 herein.

The bypass pumping plan shall include design flow, documentation of pump and discharge line capacities, manufacturer, and age. Bypass pumping plan shall also include shop drawings that identify pumping location(s) and methods with sufficient detail to assure that the work can be accomplished without sewage spills. The plans shall include an emergency discharge response plan to be followed in the event of a failure of the bypass pumping system.

All components of the bypass pumping system shall be sound attenuated and produce noise emissions in accordance with City noise ordinances. All pumps shall be set into or surrounded by spill containment devices.

Bypass pumping shall be done in such a manner as not to damage private or public property or create a nuisance or public menace. The pumped sewage shall be in an enclosed hose or pipe system that is adequately protected from traffic and shall be redirected into the sewer system.

The Contractor shall take all necessary precautions including constant monitoring of bypass pumping to ensure that no private residences or properties are subjected to sewage backup or spills. Dumping, leaks or free flow of sewage onto private property, gutters, streets, sidewalks, or into storm sewers or waterways is strictly prohibited.

Except as otherwise specified herein for testing purposes, the Contractor must receive written approval from the Engineer prior to the use of pneumatic test plugs or any other means for blocking sewer flows. The Contractor shall submit a flow blockage plan, for review by the Engineer, identifying at a minimum the following:

1. What devices and/or material will be used,
2. Depth of upstream manhole(s),
3. Location of existing lateral cleanouts and how they will be monitored,
4. Address of all parcels along with name and operating hours of all businesses located upstream of blockage to the next upstream manhole.

The Contractor shall also provide name and cell phone number of the employee(s) that will have the sole duty of monitoring all active blockages. If multiple lines are simultaneously blocked, the Contractor's submittal must show how each blockage is to be continuously monitored. For multiple blockages, and at no additional cost to the City, the Engineer may also require devices for each blockage to give audible and/or visual alarm of a pending overflow.

The Contractor shall be liable for all cleanup, damages and resultant fines in the event of a spill.

Subsequent to removal of bypass pumping and/or diversion system, the Contractor shall verify existing sewer flows are restored to pre-existing condition.

The Contractor shall allow up to 10 working days for response from the City for any request regarding sewer system flows.

~~71130-1.09 Trench Resurfacing~~

~~Trench resurfacing shall be as shown on Standard 215, "Standard Trench Detail" of the city City of Santa Rosa Standard Plans.~~



RECYCLED WATER STANDARDS

Adopted by the Santa Rosa City Council
Resolution No. ~~26962~~
~~October 23, 2007~~

TABLE OF CONTENTS

I. Recycled Water System Design Standards

II. Recycled Water System ~~Construction~~ Standard Plans

III. Recycled Water System Construction Standards Specifications Section 131 Recycled Water Construction

IV. Recycled Water System Engineer's List of Approved Items

RECYCLED WATER SYSTEM DESIGN STANDARDS

Table of Contents

I.	PURPOSE	1
	REQUIREMENTS FOR IMPROVEMENTS AND SUBDIVISION MAPS	
II.	1
III.	RECYCLED WATER MAINS – GENERAL	2
IV.	MATERIALS	3
	CONNECTION TO AN EXISTING PUBLIC RECYCLED WATER MAIN	
V.	5
VI.	ALIGNMENT.....	6
VII.	MAIN SIZING CRITERIA.....	7
VIII.	MINIMUM MAIN/LATERAL COVER	7
IX.	RECYCLED WATER VALVING	8
	SERVICE LATERALS AND METERS FOR IRRIGATION SERVICE	
X.	9
XI.	BACKFLOW DEVICES	11
XII.	PRESSURE	11
	SPECIALTY VALVES AND WATER SAMPLING	
XIII.	STATIONS.....	11
	SPECIAL CONDITIONS FOR DELINEATED FAULT ZONES	
XIV.	12
XV.	EASEMENTS	12
	ABANDONMENT OF RECYCLED WATER MAINS AND	
XVI.	SERVICES.....	13
XVII.	RECYCLED WATER PUMPING STATIONS	13
XVIII	RECYCLED WATER STORAGE FACILITIES	
.	CRITERIA.....	16
XIX.	ON-SITE DESIGN STANDARDS	20

RECYCLED WATER SYSTEM DESIGN STANDARDS

I. PURPOSE

This document provides procedures and guidelines for the preparation of plans and specifications for construction of urban recycled water facilities for the City of Santa Rosa. Adherence to these procedures and guidelines will reduce the time required for processing the plans. These guidelines do not include, but may reference, additional conditions that may be promulgated by all other pertinent ordinances, codes, and official policy set forth by the **City of Santa Rosa Utilities Water** Department or other departments of the City of Santa Rosa or other government agencies. These guidelines establish minimum acceptable design criteria. More stringent requirements may be imposed by the Director of **Utilities-Santa Rosa Water** based on specific project conditions.

Wherever the approval, discretion or opinion of the Water Department Director, or any other City staff, is called for herein, the project applicant shall submit a written request for the same. Variance requests must clearly identify the unusual circumstance that would warrant an exemption or waiver from the standards or specifications. The project applicant shall be responsible for providing any calculations or studies needed to support the proposal and for resolving specific design problems with the appropriate agencies, departments or divisions. Any final decision by City staff may be appealed pursuant to the City Code, but may be first directed to the Board of Public Utilities for a recommendation. ~~The design engineer's responsibilities include submitting a written request to the Director of Utilities for approval of any design concepts that differ from these criteria, verifying additional requirements imposed, performing any necessary calculations or studies, and resolving specific design problems with the appropriate agency, department, or division.~~

II. REQUIREMENTS FOR IMPROVEMENTS AND SUBDIVISION MAPS

- A. Provide a detailed utility plan showing onsite and offsite public and private recycled water systems, including mains, services, valves, and all other required appurtenances, and their connections to existing City -maintained recycled water facilities. Show the location, type, and diameter of public and private recycled water mains, **along with proposed system valves and service lateral placement.**
- B. Onsite recycled water facilities shall be clearly denoted in accordance with the requirements of the City's Recycled Water User's Guide.
- C. Annotate the local agency information sheet of the Subdivision Map with any information that is needed to notify property owners of requirements for connection to the City water system. These include, but are not limited to:
 1. Payment of fees prior to issuance of Building Permits,
 2. Lots requiring pressure regulating valves or booster pumps,

3. Backflow protection,
4. Public access requirements, such as gates or access roads.

The appropriate information may be obtained from ~~Utilities~~ the City's Water Engineering Department.

III. RECYCLED WATER MAINS – GENERAL

- A. Under no circumstances will cross-connection between the potable water system and the recycled water system be allowed.
- B. Public recycled water mains may not be designed outside the street right-of-way without **written approval from the** Director of **Santa Rosa Water**. ~~Utilities approval.~~
- C. In general, publicly maintained recycled water facilities will be designed only where they serve multiple ownership lots and where appropriate access for maintenance can be provided.
- D. Recycled water mains installed at a slope of 15% or greater ~~will~~**shall** be designed with restrained joints. The Design Engineer ~~must~~**shall** provide adequate drainage measures to protect the trench from erosion.
- E. Recycled water mains installed outside of any roadway, called "cross-country mains," ~~must~~**shall** have suitable access **for Water Department personnel and equipment**. In general, cross-country mains must be isolated with valves in the public right-of-way and must be identified with purple locating posts (Carsonite 492 CW-112 or approved equal) at approximate 500-foot intervals, at any angle point, and at the entrance to an easement. Stakes should have vandal-proof metal bottoms. Access requirements as established in Section XIV of the Sewer System Design Standards may be imposed on a project based on site conditions.
- F. For purposes of leak detection and maintenance access, no reinforced concrete may be designed over publicly maintained recycled water facilities. Un-reinforced concrete will be allowed under special circumstances such as crosswalks.
- G. Extent of recycled water main improvements will be as follows:
 - 1. Any off-site recycled water main improvements needed to serve the project must be shown on the improvement plans.
 - 2. In general, recycled water mains ~~must~~**shall** be designed at least across one half of the property frontage or to the last service connection, whichever is greater; or
 - 3. Where the project is required to provide new street improvements over the recycled water main alignment and the recycled water main will serve properties beyond the project limits, the recycled water main must be designed to cross the full property frontage or to the limits of the street improvements, whichever is greater.
- H. Streets with **potable** water, recycled water, and sewer mains must be at least 25 feet wide, face-of-curb to face-of-curb. Streets with recycled water and either sewer or potable water must be at least 20 feet wide, face-of-curb to face-of-curb. Streets with only a recycled water main must be at least 16 feet wide. No recycled water

mains may be installed in alleys.

I. Restrained Joints

1. For pipes with diameters ~~4~~612-inch and greater ~~, in areas where the system pressure is 90 psi or greater,~~ restrained joints shall be used, ~~in addition to concrete thrust blocking and harnesses,~~ at horizontal and vertical bends, ~~and at radial curves. and at flanges.~~ Restrained joints ~~will~~shall also be used on piping on either side of a restrained ~~and/or~~ blocked bend to provide restraint utilizing soil friction. A rational method, such as the DIPRA design program, will be utilized to determine restrained lengths.
2. For pipes with diameters 16-inch and greater, regardless of area pressure, restrained joints shall be used, in addition to concrete thrust blocking and harnesses, at horizontal and vertical bends, and at radial curves. Restrained joints shall also be used on piping on either side of a restrained and/or blocked bend to provide restraint utilizing soil friction. A rational method, such as the DIPRA design program, will be utilized to determine restrained lengths.
- ~~1.3.~~ For pipes with diameters 10-inch and smaller, restrained joints alone shall be used, where practical, at horizontal and vertical bends, and at radial curves. Restrained joints shall also be used on piping on either side of a restrained and/or blocked bend to provide restraint utilizing soil friction. A rational method, such as the DIPRA design program, will be utilized to determine restrained lengths.
- ~~2.4.~~ Restrained joints shall be ~~mechanical joint~~ ductile iron in accordance with the applicable requirements of the ~~ANSI/~~AWWA C111/~~A21.11~~ and ~~ANSI/~~AWWA C153/~~a21.53~~ of latest revision, ~~or an approve bell harness restraint,~~ and shall be compatible with the type and pressure class of pipe used.

J. Recycled water mains shall not be designed with laterals for fire hydrants, wharf heads, or other appurtenances that would allow recycled water to be used for other than approved uses unless expressly approved by the Director of ~~Utilities~~ Santa Rosa Water.

K. Recycled water mains shall not be designed with temporary connections unless expressly approved by the Director of ~~Utilities~~ Santa Rosa Water. When permitted, temporary connections shall be designed in accordance with this document.

L. Thrust Blocks

1. Regardless of restrained joint installations, thrust blocks shall be installed behind all tees, when connecting to existing mains, where existing restraints are not in place or are unknown, and anywhere where restrained joints alone are insufficient or not practical.
2. When used, thrust blocks shall be constructed in accordance with applicable City Water Distribution standards.

- ~~1. Thrust blocks, shall be used on pipe with diameters less than 16 inches at horizontal bends in accordance with City Standard 854.~~
- ~~2. Concrete anchor bolts for vertical bends in pipes with diameters 12 inches and less shall be in accordance with City Standard 853.~~
- ~~3. Harness installations for pipes with diameters 12 inches and less shall be in accordance with City Standard 852.~~
- ~~4. Harness installations flange fittings for pipes with diameters 12 inches and less shall be in accordance with City Standard 851.~~

- M. A combination of thrust blocking and restrained joints may be required in unique situations, **not already specified herein**, and/or as required by the City.

IV. MATERIALS

A. Labeling

1. Buried pipes and service laterals used for recycled water shall be clearly identified by using purple pipe with continuous wording “RECYCLED WATER – DO NOT DRINK” printed on opposite sides of the pipe. Where purple pipe cannot be used, the pipes shall be installed with warning tape.

2. The plastic warning tape shall be prepared with black or white printing on a purple field having the words, "RECYCLED WATER - DO NOT DRINK". The overall width shall be a minimum of 3 inches.
3. Warning tapes shall be installed directly on the top of the pipe longitudinally and shall be centered. The warning tape shall be installed continuous for the entire length of the pipe and shall be fastened to each pipe length by plastic tape banded around the pipe with fasteners no more than 5 feet apart. Taping attached to the sections of pipe before installation in the trench shall have flaps sufficient for continuous coverage.
4. All above grade recycled water pipe and service laterals must be labeled with the words "RECYCLED WATER – DO NOT DRINK" and color coded purple to differentiate recycled water pipelines from potable and other water pipelines. If purple identification tape is used to label the pipe and/or color code the pipe, the tape must be adhesive, permanent, and resistant to environmental conditions. Purple bands may also be painted around the circumference of the pipe at 10-foot intervals. Purple PVC pipe is not acceptable for color coding in exposed environments because the color will fade in the sunlight.
5. ~~No. 12 Insulated copper wire~~ Tracer wire in accordance with City Water Specifications except that it shall be purple in color. Tracer Wire shall be laid on top of and along entire length of all new buried pipes and tubing, and shall be extended to the surface at all valve locations, blow offs and meter boxes sufficiently for locator equipment to be attached.

B. ~~R~~Recycled water service laterals ~~1.52-inch~~ 4-inch diameter and smaller ~~will shall~~ be purple high density polyethylene (HDPE) tubing produced from PE4710 virgin HDPE ~~fusible polyvinyl chloride (PVC) pipe, Schedule 40,~~ or purple polyethylene coated type "K" copper tubing ~~unless otherwise directed.; Type K minimum. All other recycled water service laterals will be gasketed joint or fusible PVC pipe, Class 315 or greater.~~

C. Recycled Water Mains: 4-inch to 12-inch Diameter

1. Gasketed joint or fusible polyvinyl chloride (PVC) pipe, Pressure Class ~~150-235~~ DR18 minimum, per AWWA Standard C900.
2. Ductile iron pipe (DIP) fittings, Pressure Class 350, per AWWA Standard C151.
3. Where normal static mainline pressure exceeds 100 psi, pipe ~~shall be either PVC Pressure Class 305 DR 14 or DIP Pressure Class 350,~~ and fittings shall be rated for ~~250200~~ 200 psi minimum.
4. Ductile Iron Pipe (DIP) shall be used within delineated fault zones and ~~shall~~ extend to 100 feet outside each side of the delineated fault boundaries ~~with approved valves installed at the ends for isolation.~~

D. Recycled Water Mains: 16-inch and 18-inch Diameter

1. Gasketed joint or fusible polyvinyl chloride (PVC) pipe, Pressure Class 165 DR 25

minimum ~~for~~, per AWWA Standard ~~C900~~~~C905~~ or DIP Pressure Class 350.

2. Ductile iron pipe (DIP) fittings, Pressure Class 250 minimum, per AWWA Standards ~~C151~~ C110, C111 & C153.
3. Where normal static mainline pressure exceeds 100 psi, pipe and fittings shall be rated for 200 psi minimum.
4. Ductile Iron Pipe (DIP) shall be used within delineated fault zones and extend to 100 feet outside each side of the delineated fault boundaries.

E. Recycled Water Mains: 20-inch Diameter and Larger

1. Gasketed joint or fusible polyvinyl chloride (PVC) pipe, Pressure Class 165 minimum, per AWWA Standard ~~C900~~~~C905~~.
2. Tape-wrapped Steel Pipe per AWWA Standard C200, design pressure of 150 psi minimum.
3. Ductile iron pipe (DIP) and fittings, Pressure Class 250 minimum, per AWWA Standard C151.
4. Concrete cylinder pipe per AWWA Standard C303, design pressure of 150 psi minimum.
5. Ductile Iron Pipe (DIP) shall be used within delineated fault zones and extend to 100 feet outside each side of the delineated fault boundaries with approved isolation valves installed at both ends.

V. CONNECTION TO AN EXISTING PUBLIC RECYCLED WATER MAIN

- A. Under no circumstances will cross-connection between the potable water system and the recycled water system be allowed.
- B. Indicate a "hot tap" for connection of recycled water service laterals 2-inch in diameter and smaller.
- C. Indicate connection of pipes 4-inch - 12-inch in diameter with a hot tap or a cut-in tee in conformance with the provisions of the Water Distribution System Construction Standard Specifications Section ~~132~~~~99~~-1.20. Hot taps will be allowed only when no main line valves are required.
- D. Tie-ins to the existing City recycled water system must be inspected by a ~~Water~~~~Utilities~~ Department representative and the improvement plans must be so annotated.

- E. Size-on-size taps are allowed up to 8-inch diameter mains.
- F. In most major streets, or where the street surface is less than five years old, installation methods other than open cutting may be required. The Encroachment Officer or the City Engineer as appropriate will determine the requirements based on the condition of the existing street.

VI. ALIGNMENT

A. Horizontal

1. Except for crossings, a minimum horizontal distance of 4 feet ~~10 feet~~ clear shall be maintained between potable water mains and the recycled water mains and service laterals. ~~If a 10-foot horizontal separation is not feasible, a separation of at least 4 feet may be allowed subject to special construction conditions. (Designers should consult the City of Santa Rosa for specific design requirements.)~~ ~~If the horizontal distance specified is not feasible, the Designer shall comply with California Waterworks Standards, Article 1.5 "Waivers and Alternatives", or any later revision.~~ In no case is horizontal separation of less than 4 feet or construction in the same trench as potable facilities allowed.
2. The minimum horizontal separation from storm drains, gas, electrical, telephone and communications lines shall be 4 feet clear except at crossings.
3. Recycled water mains shall be designed a minimum of 5 feet from all structures, such as manholes or drop inlets.
4. Recycled water mains shall be designed a minimum of 3 feet clear from the lip of gutter and 5 feet clear from the edge of easements.
5. In the event that it is not possible to maintain the required separations and relative positions between recycled water mains and service laterals, potable water lines and sanitary sewer lines, special design shall be required and approved by the ~~Water Department~~ ~~Director.~~ ~~of Utilities.~~
6. Recycled water main crossings over or under other underground facilities will be designed as close to 90 degrees to the facility as possible. ~~If the other utility is a potable water main the minimum angle for a crossing shall be 45 degrees.~~
7. Recycled water mains shall be designed with service laterals perpendicular to the main.

B. Vertical

1. Recycled water mains shall be designed with the ability to generally drain to blow offs. Consult with the City of Santa Rosa for specific design

requirements.

2. Provide a minimum of 6 inches vertical separation from storm drains or other underground utilities such as telephone, communication, gas, or electrical conduit.
3. Pothole and survey utilities or other structures critical to vertical alignment.

4. Where it is necessary to lower or raise either the recycled water main or the existing potable water main because of a vertical conflict, the main that is smaller shall be chosen for the deviation; however, the deviation shall be such that the potable water main is placed above the recycled water main. If the recycled water main must go over an existing potable water main ~~the Designer shall submit the proposed “alternative” design to the State Water Board, Division of Drinking Water for review and approval per the California Waterworks Standards prior to submitting to from the Santa Rosa Water Director for review. Approval by the State Water Board’s Drinking Water Divison does not guarantee approval by the City. of Utilities is required, and a continuous (no joints or valves) section shall be used. It shall clear the potable water main by 12 inches and shall extend to 10 feet clear on either side of the potable water main.~~
5. Recycled water mains over or under other utilities shall be in accordance with Santa Rosa City Standards 855 and 856, except that PVC pipe shall be allowed with ductile iron fittings.

VII. MAIN SIZING CRITERIA

- A. Recycled water mains will be sized in accordance with the City’s predesign for the urban reuse system. Variation from the urban reuse system predesign will require special permission from the ~~Water Department Director. of Utilities.~~
- B. Recycled water mains will be sized based on a peaking factor of 10 applied to the annual average demand rate, and a maximum velocity of 5 feet per second.
- C. Recycled water mains shall be 4-inch diameter minimum.

VIII. MINIMUM MAIN/LATERAL COVER

- A. Depth of cover is defined as the distance from the top of the pipe to the final finished grade measured directly over the pipe. Minimum depth of cover shall be as follows:
 1. Service laterals shall have minimum cover as shown on City Standard Details.
 2. Mains of 4-inch, 6-inch ~~A~~ and 8-inch diameter shall have 36 inches of minimum cover.
 3. Mains of 12-inch diameter shall have 42 inches of minimum cover.
 4. Mains of 16-inch diameter or larger shall have 48 inches of minimum cover.
- B. When within 10 feet of separation from a potable water main, the depth of the recycled water pipe shall provide for 1 foot of vertical separation with the recycled water main beneath the potable water main.
- C. Where minimum cover is less than standard or greater than 8 feet, special

permission from the **Water Department** Director, ~~of Utilities~~ is required. Show mains with non-standard cover in profile on the Improvement Plans or Encroachment Permit applications. Where cover is less than the Standard, higher class pipe, ductile iron pipe, and use of controlled density fill may be required.

IX. RECYCLED WATER VALVING

A. Valves - General

1. A minimum of two (2) mainline valves are required for “T” intersections.
2. A minimum of three (3) mainline valves are required for cross intersections.
3. Any recycled water main that does not have a lateral connection will have valves at approximately 1,000-foot intervals.
4. Recycled water main valves must be located outside of concrete areas whenever possible to facilitate repairs.
5. Cross-country mains must be isolated with valves in the public right-of-way and must be identified with locating posts at 500-foot intervals, at any angle point and at the entrances to easements.
6. All valves must be tagged with a recycled water identification tag with the words “WARNING – RECYCLED WATER – NOT FOR DRINKING” on one side and “AVISO – NO ES PARA BEBER” on the other. Identification tags shall be permanent plastic tags affixed to the valve designed to withstand exposure to weather, sunlight, and immersion.

B. Gate Valves

1. Gate valves shall comply with City Standard 877.
2. Gate valves shall be ductile iron and shall conform to AWWA Standards C509 and C515 of the latest revision and shall be the resilient seat type with non-rising stem opening counter clockwise with O ring stem seal and suitable ends for connecting to the type of pipe or fitting used.
3. The working pressure rating of the gate valves shall meet or exceed the pressure rating of the pipe.
4. External bolts and nuts shall be 304 stainless.

C. Butterfly Valves

1. In general, butterfly valves will not be allowed without special permission from the **Water Department** Director, ~~of Utilities~~, and only when the depth of the main precludes the use of a gate valve.

2. Butterfly valves shall comply with City Standard 878.
3. Butterfly valves shall be flanged or mechanical joint type only and shall conform to AWWA Standard C504 of the latest revision and shall be the rubber seat type.
4. Valve discs shall rotate 90 degrees from the full open position to the tight shut position.
5. The valve seat shall provide a tight shut off at a pressure differential of 150 psi upstream and 0 psi downstream in either direction.
6. The valve operator shall be the traveling nut type.
7. Valve shall open with a counter-clockwise rotation of the operating nut.
8. External bolts and nuts shall be 304 Stainless.

D. Valve Boxes

1. Valve boxes shall be taken from the City Design and Construction approved list.
2. Valve stem riser shall be SDR 35 purple PVC pipe.
3. Valve boxes shall be purple and have a warning label permanently molded into the cover. Warning labels shall be constructed of a weatherproof material with the warning permanently stamped or molded into the label and having the words, "RECYCLED WATER - DO NOT DRINK".

X. SERVICE LATERALS AND METERS FOR IRRIGATION SERVICE

- A. Under no circumstances will cross-connection between the potable water system and the recycled water system be allowed.
- B. All service meters must be tagged with a recycled water identification tag with the words "WARNING – RECYCLED WATER – NOT FOR DRINKING" on one side and "AVISO – NO ES PARA BEBER" on the other. Identification tags shall be permanent plastic tags affixed to the valve designed to withstand exposure to weather, sunlight, and immersion.
- C. Conditioned developments will be provided City recycled water service via meters located at the frontage of a public street.
- D. The City may allow meters to be located on private street frontages and/or within public utility easements if the City ~~Water Department~~ ~~Utilities Dept.~~ evaluation concludes that it is reasonable under the circumstances. However, meters must be readily accessible.

- E. Design meter boxes out of traveled ways and a minimum of 10 feet from street trees whenever possible. Meter boxes shall be purple and have a warning label permanently molded into or affixed onto the cover with rivets, bolts, etc. Warning labels shall be constructed of a weatherproof material with the warning permanently stamped or molded into the label and having the words, "RECYCLED WATER - DO NOT DRINK".
- F. Base any required hydraulic calculations for the water meter and service lateral sizes on criteria from AWWA Manual M22 and submit to the **Water Department** Director ~~of Utilities~~ for approval. Service laterals shall be 1^{3/4}-inch diameter, minimum.
- G. The maximum velocity in recycled water service laterals from the main to the meter is 15 feet per second.
- H. Meter manifolds other than those shown in various City Standard Plans will be detailed on the plans and approved by the **Water Utilities** Department, Engineering Division.
- I. Multi-Family Residential (3 or more units)
 - 1. See Section X-L for irrigation meter requirements for any landscaped or common areas.
 - 2. All meters must be within public right-of-way or easements and multiple meters will be clustered where possible.
- J. Mobile Home Parks
 - 1. See Section X-L for common area irrigation meter requirements.
- K. Mixed residential and commercial uses must have separate meters.
- L. Irrigation
 - 1. Provide separate irrigation meters for landscaped areas of all commercial uses.
 - 2. Provide separate irrigation meters for common areas of all condominium, town home, PUD, apartment complexes, and mobile home parks.
 - 3. Provide reduced pressure backflow devices for all irrigation services. Backflow devices must be specified on the irrigation plan and must conform to City Standard 876 and current USC Approved List of Devices.
 - 4. Sizing of irrigation meters will be determined by the **Water Utilities** Department after reviewing the landscape plans. Irrigation meter size will be determined by the maximum flow required at the meter and will be based on AWWA criteria for meter sizing. Water demand purchased will be based on the estimated gallons required to maintain the planned landscape in a healthy condition for our climate. Along with landscape and irrigation plans, the applicant must submit the planned square footage of planted areas and categories of plants to be used as selected from the following:

- a. High water use plants: turf, annuals, and container plants;
- b. Moderate water use plants: ornamental trees, shrubs ground covers, and perennials primarily irrigated by sprinklers. (Note that there may be some use of drip or bubblers in this category but not a predominance.)
- c. Low water use plants: drought tolerant plants recognized as having a plant factor of 0.3 or less and irrigated primarily through drip emitters.

XI. BACKFLOW DEVICES

- A. Backflow Prevention shall be in accordance with the City's Recycled Water User's Guide and shall be required for the following applications:

APPLICATION	TYPE OF DEVICE
Buildings with Recycled Water for approved Dual Plumb uses	RP
Irrigation Systems w/ Booster Systems	RP
Irrigation System w/Chemical Feed	RP
Irrigation System w/Recycled Water impoundments on-site	RP
Irrigation System w/Supplemental Water from the Potable Water System	RP
RP = Reduced Pressure	

- B. All backflow devices must be tagged with a recycled water identification tag with the words "WARNING – RECYCLED WATER – NOT FOR DRINKING" on one side and "AVISO – NO ES PARA BEBER" on the other. Identification tags shall be permanent plastic tags affixed to the valve designed to withstand exposure to weather, sunlight, and immersion.

XII. PRESSURE

- A. Pressure
 1. Pressure Criteria
 - a. Operating pressure under peak hour demand shall not be less than 40 psi.
 - b. The maximum allowable static pressure is 100 psi.
 2. Pressure Regulation
 - a. Install pressure reducing valve installations where required by City to meet operating and static pressure standards.
 - b. All pressure reducing valves must be tagged with a recycled water identification tag with the words "WARNING – RECYCLED WATER – NOT FOR DRINKING" on one side and "AVISO – NO ES PARA BEBER" on the other. Identification tags shall be permanent plastic tags

affixed to the valve designed to withstand exposure to weather, sunlight, and immersion.

XIII. SPECIALTY VALVES AND WATER SAMPLING STATIONS

- A. Water sampling stations are required to provide representative sampling where indicated in the City's urban reuse predesign plans. The above grade cabinet must have a warning label affixed onto it with rivets, bolts, etc. Warning labels shall be constructed of a weatherproof material with the warning permanently stamped or molded into the label and having the words, "RECYCLED WATER - DO NOT DRINK".

- B. Air release and vacuum relief valves are required at substantial high points in the system such as hilltops, bridge crossings, and the upper end of dead legs. Air valves may be located below grade with above grade vent piping and drain to the sanitary sewer.
- C. Blowoffs shall be installed at substantial low points to facilitate draining of the system and shall be located within 150 feet of a sanitary sewer manhole. Local low points, such as utility crossings, will not require blowoffs. Blowoffs shall be in accordance with Santa Rosa City Standard 862.
- D. All manual control valves, electrical control valves, pressure reducing valves shall be installed below grade in a valve box. Air release valves can be vented below grade.
- E. All specialty valves and water sampling stations must be tagged with a recycled water identification tag with the words "WARNING – RECYCLED WATER – NOT FOR DRINKING" on one side and "AVISO – NO ES PARA BEBER" on the other. Identification tags shall be permanent plastic tags affixed to the valve designed to withstand exposure to weather, sunlight, and immersion.

XIV. SPECIAL CONDITIONS FOR DELINEATED FAULT ZONES

- A. Fault zones must be identified on improvement plans.
- B. Ductile iron pipe ~~must~~ shall be indicated on the improvement plans in delineated fault zones and extend to 100 feet outside each side of the delineated fault boundaries with isolation valves shown on both ends.

XV. EASEMENTS

- A. An easement must be provided over any public recycled water system when it is installed outside a public right-of-way.
- B. The easement must be a minimum of 15 feet wide if it only contains a recycled water main or 20 feet wide if it contains another facility, such as sewer, storm drain, or other utility. The easement will be dedicated as a "public recycled water easement" if it contains recycled water only. It will be dedicated as a "public utilities easement" if it contains other facilities as well.
- C. Easements must be configured to encompass all publicly maintained appurtenances, such as service laterals and meters and will be generally centered over the facility. Separate access easements may be required depending on site conditions. When recycled water mains are to be installed along a property line the easement will be wholly contained on one parcel.
- D. All property restrictions placed as a result of dedication of easements will be so noted on the Subdivision Map, or on the Easement Deed if the easement is not dedicated as part of a subdivision. Required notes are:

1. No structures may encroach on, above or below the surface of the ground in any public recycled water easement. This includes footing of foundations or eaves from the roof of any adjacent structure, pools, ponds, or outbuildings on slabs or foundations. Decks, sheds, or other structures that may be easily removed for maintenance of the water system may be allowed at the discretion of the **Water Department** Director. ~~of Utilities.~~
2. No trees may be planted in a public recycled water easement without first obtaining approval of the **Water Department** Director. ~~of Utilities.~~ Trees may be allowed to the extent that damage to the water system does not occur from root intrusion and adequate access can be provided for maintenance and repair vehicles.

XVI. ABANDONMENT OF RECYCLED WATER MAINS AND SERVICES

- A. Any existing recycled water mains and service laterals that will not be used must be abandoned and must be shown on the Improvement Plans with appropriate notation.
- B. For all abandoned recycled water services up to and including 2 inches, annotate to remove the valve and saddle and install a full circle clamp on main under **Utilities Department** inspection **by authorized City personnel.**
- ~~C. For flanged or mechanical joint tees, annotate the Improvement Plans to remove the valve and install a blind flange or mechanical joint plug under Utilities Department inspection.~~
- ~~D.C.~~ For all ~~push-on~~ tees, the tee, valve and concrete thrust block must be removed and the main repaired with approved pipe and ~~suitable~~ couplings, and so noted on the Improvement Plans.
- ~~E.D.~~ Valve boxes **and riser pipes** for abandoned valves must be removed and so noted on the Improvement Plans.
- ~~F.E.~~ Abandoned mains, **and** valves, ~~and risers~~ located within any street structural section or within any new trench must be shown on the Improvement Plans to be removed.
- ~~G.F.~~ Show all 12-inch diameter and larger recycled water mains to be abandoned within the public right-of-way as removed or broken every 50 feet and filled with **an approved flowable fill material.** ~~sand slurry.~~

XVII. RECYCLED WATER PUMPING STATIONS

- A. Pumps and Piping
 1. Pumps
 - a. Vertical turbine pumps shall be installed in stainless steel suction cans. The size and depth of the suction can as well as the location of the suction piping connection shall be in accordance with Hydraulic

Institute standards.

- b. The pumps shall not exceed 1800 revolutions per minute operating speed and shall be provided with mechanical seals.
- c. Pump motors shall be 480 VAC, 3-phase, with 1.15 service factor. Motors shall be open drip-proof or have water-proof enclosures.

2. Piping

- b. Pond intake piping shall be stainless steel, including intake screen.
- c. Pump isolation valves are required on the suction and on the discharge piping.
- d. Isolation valves shall be resilient seat gate valves.
- e. Provide rubber flapper check valves on the pump discharge piping at a minimum.
- f. No piping other than drain piping connection to pump cans shall be buried beneath the floor. Below grade piping shall be in pipe trenches with aluminum grating covering the trench.
- g. Each pump station shall be plumbed to have sodium hypochlorite injection capability.

B. Electrical Design & Emergency Power

1. Electrical Equipment (single feed)

- a. A minimum of one pump shall be driven by an adjustable speed drive (VFD).

2. The other pump motors shall have reduced voltage solid-state starters.

C. Surge Control

- 1. Hydrodynamic transient analyses shall be performed for each pump station to determine necessary surge control measures.

D. Instrumentation & Controls (I & C)

1. Supervisory Control And Data Acquisition (SCADA)

- a. The new system shall integrate with the City's existing system, which utilizes spread spectrum radio telemetry to a centralized server.
- b. Pumps normally shall be controlled by downstream reservoir levels.
- c. Primary telemetry is spread spectrum radio.
- d. Redundant communication paths between the pump station and the downstream reservoir are required.
- e. An electromagnetic flow meter shall be provided within the pump station.

E. Redundancy Requirements

1. Capacity

The pump station shall be designed such that it can meet design capacity with the largest pump out of service at the specified design capacity.

2. Electrical Redundancy

- a. No redundancy is required for electrical switch gear, motor control centers, or adjustable speed drives.
- b. Standby generators are not required, but the pump station shall have a transfer switch and receptacle of a type that would allow a direct connection of a City portable generator to the pump station.

F. Auxiliary System Redundancy (HVAC)

- a. Auxiliary systems can be constructed without redundant equipment.
- b. All pumps stations shall be provided with heaters.
- c. Ventilation shall be as required to keep the interior temperature within the allowable temperature range of electronic equipment housed within the building.

G. Site Requirements

1. Architectural

- a. The pumps and electrical equipment, including switch gear, motor control centers, and control panels shall be housed in masonry buildings.
- b. The floor of the building shall be a minimum of 6 inches above the surrounding exterior grade.
- c. Skylights shall be provided in the roof above the pumps for removal and installation of pumps.

2. Visual Impacts/Restrictions

- a. Building sites will be subject to City Design Review Board.
- b. Roofing materials shall match existing roofing materials in the area.
- c. Pump station shall be fenced.
 - i. Wrought iron decorative fence in urban settings.
 - ii. Others may be cyclone with or without slats.
- d. Entrance gates shall be provided.
 - i. Gate(s) shall be either rolling or double leaf swinging gates.
 - ii. Type of locks shall be determined based on type of fencing and gates selected.

3. City/County Noise Limits

In the City or in urban settings the pumps shall be housed in a building to mitigate noise and conform to the requirements of the City's noise ordinance.

4. Parking/Paving

- a. Paved areas shall be of sufficient size and located to allow crane access for pump removal.

- b. There shall be adequate paved area to turn around a pickup truck within the fenced area.
- 5. Security/Utilities/Lighting
 - a. There shall be covers on locks to prevent the cutting of the locks.
 - b. Ladder protectors shall be required wherever ladders are in exterior locations.
 - c. Type of yard lighting control may be manual, by photocell or on a timer.
 - d. Motion detector lights may be required.
 - e. Security cameras may be required.
 - f. Electric service shall be underground in urban areas but may be overhead in rural areas.
 - g. Intrusion alarms may be required.
- 6. Landscaping shall be required and shall be designed and installed per the City's Water Efficient Landscape Policy.

XVIII. RECYCLED WATER STORAGE FACILITIES CRITERIA

A. Hydraulic Considerations

- 1. Hydraulic Modeling shall determine capacity sizes for operational storage capacity only.
- 2. Emergency Storage Capacity and fire storage capacity shall not be included in the sizing of the recycled water storage facilities.
- 3. The High Water Elevation and Hydraulic Grade Line shall be determined by hydraulic analysis.
- 4. Tank connections shall be to the distribution system and "float" off system.

B. Siting Criteria

- 1. Hydraulic Modeling shall determine site locations and shall be coordinated with proposed distribution system piping alignments and location of major demands.
- 2. Evaluate Alternate Sites based on the following siting criteria.
 - a. Proximity to Distribution System and Sanitary Sewer
 - b. Hydraulic Effectiveness
 - c. Power Availability
 - d. Geotechnical Feasibility
 - e. Property Ownership And Land Acquisition
 - f. Construction Cost
 - g. Access Requirements
 - h. Surrounding Land Uses
 - i. Overflow Constraints
 - j. Environmental Constraints

- i. Biological Resources
- ii. Cultural Resources
- iii. Geology And Soils
- iv. Noise
- v. Land Use Planning
- k. Noise Impacts
- l. Visual Impacts
- m. Permitting Requirements

C. Right-of-Way Needs and Land Acquisition

- 1. Tank Sites shall be evaluated based on tank capacities developed during hydraulic evaluation.
- 2. Land Acquisition and easements required will be determined and included in the evaluation at each site.
- 3. Construction Easements may be required and will be evaluated on a case by case basis.

D. Tank Materials

- 1. Seismic/Structural design shall be in accordance with the Uniform Building Code Seismic Zone 4.
- 2. Welded steel tanks are required to be consistent with existing City water storage facilities. AWWA Standard D-100 shall be used to design welded steel tanks.
- 3. Footings shall be **designed by an Engineer specializing in structural design, and shall be** concrete ring wall footings unless local geotechnical conditions and final dimensions dictate otherwise. The tank shell ~~will~~ **shall** be anchored to the ring wall footing ~~to meet seismic design requirements unless this requirement is proven to be unnecessary given the dimensions~~ **unwarranted for a specific installation.**
- 4. Coatings for steel tanks shall comply with City tank coating standards.

E. City will consider need for cathodic protection on a case-by-case basis.

F. On-Site Piping

- 1. Inlet/Outlet piping for recycled water shall be a single pipeline from -the distribution system and shall enter the tank through the floor plate. To address seismic issues, piping connected to the tank will be adequately designed to accommodate differential settlement.
- 2. Pipeline Size will be determined by the final hydraulic analysis.

3. Valves

- a. Normally, a control valve or an altitude valve will not be provided.

4. Floor Drains shall be provided.
5. Overflow Pipe
 - a. An overflow pipe will be provided with an air gap to eliminate potential back pressure on the overflow pipe.
 - b. The overflow pipe shall be sized for maximum flows into the tank.
 - c. The tank overflow piping and shell nozzle shall be welded steel pipe.
 - d. Overflow shall have an air-break and drain by gravity pipeline to the nearest sewer, with lateral sized to limit flows based on capacity of receiving sewer main. **Water Department** Director ~~of Utilities~~ may waive this requirement at his/her discretion.

G. Site Requirements

1. Environmental/Geotechnical investigations shall be conducted after the initial reconnaissance of each selected tank site.
2. Visual Impacts/Restrictions shall be considered.
3. Fencing
 - a. Storage tanks shall be fenced.
 - b. Wrought iron decorative fence in urban areas.
 - c. Others may be chain link with or without slats.
4. Gates
 - a. Entrance gates shall be provided.
 - b. Gates shall be either rolling or double leaf swinging gates.
 - c. Types of locks shall be determined based on type of fencing and gates selected.
5. Paving/Parking
 - a. Provide a 10-foot paved access road around the tank for maintenance and inspections. Alternate road materials may be considered if appropriate.
 - b. Provide adequate paved area to park and turn a truck around within the fenced area.
6. Security/Utilities/Lighting
 - a. There will be covers on locks to protect against cutting.
 - b. Ladder protectors and/or anti-climb assemblies will be required for exterior ladders.
 - c. Yard lighting controls will be selectable as manual, by photocell or timer.
 - d. Yard lighting shall take into consideration impacts on adjacent parcels.
 - e. Security cameras may be required.
 - f. Intrusion alarms shall be required, including on roof hatches.
 - g. Motion detector lights may be required.

7. Landscaping may be required and shall be designed and installed per the City's Water Efficient Landscape Policy.

8. All site runoff will be collected and discharged to an appropriate location in accordance with City Standards.

H. Instrumentation & Control

1. Remote Telemetry Unit (RTU) shall be provided to transmit signals and alarms from the tank site to the City's central Supervisory Control and Data Acquisition (SCADA) system.
2. I/O shall include at a minimum, the following:
 - a. Tank water level
 - b. High water level alarm
 - c. Low water level alarm
 - d. Roof hatch intrusion alarm.

I. Water Quality

1. Internal Tank Piping shall be designed to induce mixing and eliminate short-circuiting.
2. Mixing/Recirculation options shall be investigated at each tank to eliminate dead zones. Options include:
 - a. separate piping configuration
 - b. recirculation pumping
 - c. proprietary piping manifolds to induce better water circulation.
3. Sample Locations shall be evaluated based on:
 - a. inlet and outlet piping
 - b. the tank shell
4. Chlorine Injection facilities shall be considered based on:
 - a. the distribution system water quality
 - b. operational considerations

J. Appurtenances/Accessories

Generally, all tank appurtenances shall be per the latest revision of AWWA Standard D100 although minor alterations may be required or allowed by Santa Rosa Water.

The following appurtenances shall be provided at the tank:

1. Man-ways - there shall be two (2) standard shell man-ways located at opposite sides of the tank.
2. Roof Hatches - there shall be two (2) roof ~~hatches for~~ access points to the tank interior and for use during maintenance operations.
 - a. ~~One hatch shall be located near the interior ladder for maintenance.~~

~~b. One hatch shall be located above the overflow funnel for visual inspection and maintenance access to the overflow pipe.~~

3. Ladders
 - a. A stainless steel interior ladder with Saf-T-Climb assembly shall be located on the inside wall at the roof hatch.
 - b. An intermediate platform may be provided depending on the height of the tank.
4. Roof vent(s) shall be designed to minimize dust and debris entry into the tank. The number and size will be based on maximum inflows into the tank as determined during final design.
5. Level Gages
 - a. An exterior float-type level gage will be located at a convenient location for easy visual inspection from the access road.
 - b. A level transmitter will be located on the side wall at an appropriate distance from the ground for the level signal to the RTU.
6. Water Sampling Assemblies shall be provided to enable sampling from one or more points within the tank similar the most recent potable water tanks constructed in the City.

K. Electrical

1. Power shall be provided by PG&E from local distribution grid. If access to the grid is not available, solar power will be considered.

XIX. ON-SITE DESIGN STANDARDS

- A. Design requirements for on-site facilities shall be in accordance with the latest version of the City's Recycled Water User's Guide.

II.

RECYCLED WATER SYSTEM
~~CONSTRUCTION~~ STANDARD
PLANS

RECYCLED WATER SYSTEM ~~CONSTRUCTION~~ STANDARD PLANS

Recycled water system ~~construction~~ standard plans shall be the same as the water distribution system standard plans ~~drawings~~ except as noted below. In no case shall the recycled water system construction standards deviate from the City's Recycled Water System Design Standards or the City's Recycled Water User's Guide without prior approval from the ~~Water Department~~ Director. ~~of Utilities.~~

Std. #	Title	RW Design Standards References
850	Typical System Restraint Lengths	New
851	Harness Installation for Flange Fittings	No changes
852	Harness Installation	No changes
853	Concrete Anchor Blocks for Vertical Bends	No changes
854	Concrete Thrust Blocks for Horizontal Bends	No changes
855	Water Main Lowering	Recycled water mains shall conform to RW Design Standards Sections III, IV and IV
856	Water Main Over Structure	Recycled water mains shall conform to RW Design Standards Sections III, IV and IV
857	Fire Hydrant and Lateral/Fire Hydrant Location	Not applicable for recycled water
858	Pumper Connection	Not applicable for recycled water
859	Temporary Blow-off and/or Metered Connection	Metered connections shall conform to RW Design Standards Sections IV, X and XIII
860	Temporary Metered Connection When Fire Flow is Required	Not applicable for recycled water
861	Permanent Blow-off with Harness	Service lateral, valve and meter box shall conform to RW Design Standards Sections IV, X and XIII
862	Full Size Blow-off	Valves, pipe and meter box shall conform to RW Design Standards Sections IV, IX, X and XIII
863A	3/4-inch & 1-inch HDPE Water Service Lateral	Service connections shall conform to RW Design Standards Sections IV and X
863B	1" Copper Water Service Lateral	Service connections shall conform to RW Design Standards Sections IV and X
863C	1-1/2" HDPE Water Service Lateral	Service connections shall conform to RW Design Standards Sections IV and X
863D	1-1/2" Copper Water Service Lateral	Service connections shall conform to RW Design Standards Sections IV and X
864	1-1/2" inch HDPE Dual Water Service Lateral	Not applicable for recycled water
865A	2" inch HDP Water Service Lateral for 1-1/2" or 2" Meter	Service connections shall conform to RW Design Standards Sections IV, IX and X
865B	2" Copper Water Service Lateral for 1-1/2" or 2" Meter	Service connections shall conform to RW Design Standards Sections IV, IX and X
866	4-inch Water Service Lateral for 3-inch Meter	Service connections shall conform to RW Design Standards Sections IV, IX and X
867	4-inch Water Service Lateral for 4-inch Meter	Service connections shall conform to RW Design Standards Sections IV, IX and X
868	6-inch Water Service Lateral for 6-inch Meter	Service connections shall conform to RW Design Standards Sections IV, IX and X
869	Combination Water Service Stub	Not applicable for recycled water
870	Combination Water Service	Not applicable for recycled water

871	Alignment of Water Mains & Placement of Mainline Valves	Recycled water mains and valves shall conform to RW Design Standards Sections VI and IX
872	Dirt Stop & Water Main Encasement & End Seal	Carrier pipe shall conform to RW Design Standards Section IV
874	Above Ground Double-Check Valve Backflow Device	Not applicable for recycled water
875	Below Ground Double-Check Valve Backflow Device	Not applicable for recycled water
876	Reduced-Pressure Backflow Device	Backflow devices shall conform to RW Design Standards Sections X and XI
877	Gate Valve	Valves shall conform to RW Design Standards Section IX
878	Butterfly Valve and Tapping Valve	Valves shall conform to RW Design Standards Sections V and IX
879	Above Ground Single Check Detector in Vault Assembly	Not applicable for recycled water
880	Double-Check Detector Fireline Backflow Assembly	Not applicable for recycled water
881	Pressure Reducing Valves	Vault cover shall be purple and labeled same as meter box cover; PRV assemblies shall conform to RW Design Standards Sections IV, V, IX, X and XII
882	Surge Anticipator Valve or Pressure Relief Valve	Not applicable for recycled water
883	Combination Air & Vacuum / Air Release Valve	Vault cover shall be purple and labeled same as meter box cover; valve assemblies shall conform to RW Design Standards Sections X and XIII
884	Water Meter for Private Non-residential Systems	Not applicable for recycled water
885	Water Meter for Private Process and Evaporative Lines	Not applicable for recycled water
886	Water Sampling Station	Sampling stations shall conform to RW Design Standards Sections IV, IX, X and XIII
887	4-inch Ductile Iron Multi-Service Manifold	Not applicable for recycled water
888	Above Ground Single Detector Check Assembly in Vault	Not applicable for recycled water
889	Water Service Anode	No changes

III.

**RECYCLED WATER SYSTEM
CONSTRUCTION STANDARDS
SPECIFICATIONS**

RECYCLED WATER SYSTEM CONSTRUCTION STANDARDS SPECIFICATIONS

SECTION 131 RECYCLED WATER SYSTEM CONSTRUCTION

Recycled water system construction standards specifications shall be the same as the water system construction standard specifications except that in no case shall the recycled water system deviate from the City's Recycled Water System Design Standards or the City's Recycled Water User's Guide without prior approval from the ~~Water Department~~ Director. ~~of Utilities.~~

IV.

ENGINEER'S LIST OF APPROVED ITEMS

RECYCLED WATER SYSTEM ENGINEER'S LIST OF APPROVED ITEMS

Recycled water system Engineer's list of approved items shall be the same as for the water system except that in no case shall the recycled water system deviate from the City's Recycled Water System Design Standards or the City's Recycled Water User's Guide without prior approval from the **Water Department** Director. ~~of Utilities.~~



CITY OF SANTA ROSA

WATER DISTRIBUTION STANDARDS SPECIFICATIONS

**Adopted by the Santa Rosa City Council
Resolution No. _____
< Month Day, Year >**

TABLE OF CONTENTS

1. Water **Distribution** System Design Standards
2. Water **Distribution** System Standard Plans ~~Construction Standards~~
3. Water **Distribution** System Construction ~~Standards~~ Specifications
Section 132 ~~99~~ Water ~~Main~~ **Distribution System**
4. Engineer's List of Approved Items **for the Water Distribution System**

WATER DISTRIBUTION SYSTEM DESIGN STANDARDS

Adopted by the Santa Rosa City Council

Resolution No.

Date:

TABLE OF CONTENTS

I.	PURPOSE	1
II.	REQUIREMENTS FOR IMPROVEMENTS AND SUBDIVISION MAPS	1
III.	WATER MAINS - GENERAL	2
IV.	MATERIALS.....	3
V.	CONNECTION TO AN EXISTING PUBLIC WATER MAIN.....	4
VI.	ALIGNMENT.....	45
	A. Horizontal	45
	B. Vertical.....	57
VII.	MAIN SIZING CRITERIA	67
VIII.	MAIN/LATERAL COVER.....	68
IX.	VALVING	79
X.	SERVICE LATERALS AND METERS FOR DOMESTIC AND IRRIG. SERVICE...810	
XI.	PUBLIC IMPROVEMENTS FOR PRIVATE FIRE SYSTEMS	114
XII.	PUBLIC FIRE HYDRANTS.....	1316
XIII.	BACKFLOW DEVICES (EXCEPT FOR FIRE LINES).....	1415
XIV.	PRESSURE.....	1518
XV.	SPECIALTY VALVES AND WATER SAMPLING STATIONS.....	1519
XVI.	SPECIAL CONDITIONS FOR DELINEATED FAULT ZONES	1619
XVII.	EASEMENTS	1620
XVIII.	ABANDONMENT OF WATER DISTRIBUTION SYSTEM COMPONENTS MAINS AND SERVICES	1721
APPENDIX AA@ - CRITERIA FOR THE SEPARATION OF WATER MAINS AND NON-POTABLE PIPELINES SANITARY SEWERS		1822
APPENDIX AB@ - BACKFLOW DEVICE REQUIREMENTS FOR SPECIFIC TYPES OF USE.....		3039

WATER DISTRIBUTION SYSTEM DESIGN STANDARDS

I. PURPOSE

To provide guidelines for the design of water utilities projects and thereby reduce the time required for processing the plans. These guidelines do not include, but may reference, additional conditions which may be promulgated by all other pertinent ordinances, codes, and official policy set forth by the ~~Utilities~~ Water Department or other departments of the City of Santa Rosa or other government agencies. These guidelines establish minimum acceptable design criteria. More stringent requirements may be imposed by the Director of ~~Utilities~~ Santa Rosa Water based on specific project conditions.

~~Portions of t~~These standards apply to ~~public~~ fire systems, ~~both public and private~~, and are intended as a general reference to aid in the design of the ~~entire~~ public water ~~distribution~~ system. Final designs are subject to approval ~~of by~~ the Fire Department.

Wherever the approval, discretion or opinion of the Water Department Director, or any other City staff, is called for herein, the project applicant shall submit a written request for the same. Variance requests must clearly identify the unusual circumstance that would warrant an exemption or waiver from the standards or specifications. The project applicant shall be responsible for providing any calculations or studies needed to support the proposal and for resolving specific design problems with the appropriate agencies, departments or divisions. Any final decision by City staff may be appealed pursuant to the City Code, but may be first directed to the Board of Public Utilities for a recommendation. ~~It is the responsibility of the design Engineer to initiate written requests to the Director of Utilities for approval of any design concepts that differ from these criteria, verify additional requirements imposed, perform any necessary calculations or studies, and resolve specific design problems with the appropriate agency, department or division.~~

II. REQUIREMENTS FOR IMPROVEMENT PLANS AND SUBDIVISION MAPS

- A. Provide a detailed utility plan showing onsite and offsite public and private water and fire protection systems, including mains, services, hydrants, and all other required appurtenances, and their connections to existing City-maintained water facilities. Show the location, type, and diameter of public and private water mains. Reference any existing fire hydrants within 300' of the project boundary. Show any wells, existing or to be abandoned. When a separate irrigation service is necessary, an irrigation plan is required per section X-O of these standards. (See section XI-B for submittal of plans for private fire systems.)
- B. Annotate the local agency information sheet of the Subdivision Map with any information that is needed to notify property owners of requirements for connection

to the City's water **distribution** system. These include, but are not limited to:

1. Payment of fees prior to issuance of Building Permits.
2. Lots requiring pressure regulating valves or booster pumps.
3. Backflow protection.
4. Public water access requirements, such as gates or access roads.

The appropriate information may be obtained from ~~Utilities~~**Santa Rosa Water** Engineering.

C. Miscellaneous specific items required on improvement plans are indicated throughout these Standards.

D. Before combustible materials may be delivered, stored or constructed on site, fire flow and access must be provided and approved by the Fire Department per current City Fire Code. In addition, public and/or private fire hydrants must be installed, flushed and operational **unless an alternant supply of water is onsite that has been approved by the City's Fire Department for this purpose**. This information must be included on all improvement plans. Provide any necessary calculations with the submittal of improvement plans or with the Tentative Map submittal to demonstrate adequate fire flows are available. Newly installed fire hydrants shall be flow tested per the methods described in NFPA 291, Chapter 4 and the results transmitted to the City ~~Utilities~~**Water** Department for inclusion into the Geographic Information System (GIS).

E. **Any known areas of contamination shall be delineated on the improvement plans.**

III. WATER MAINS - GENERAL

A. Public water mains may not be designed outside the street right-of-way without **approval from the** Director of ~~Utilities~~**Santa Rosa Water**.~~approval~~.

B. In general, publicly maintained water **distributions** systems ~~will~~**shall** be designed only where they serve multiple ownership lots and where appropriate access for maintenance can be provided.

C. Water mains installed at a slope of 15% or greater ~~will~~**shall** be designed with restrained joints. The Design Engineer must provide adequate drainage measures to protect the trench from erosion.

D. Water mains installed outside of any roadway, called ~~A~~**" cross-country mains"**,⁶ ~~must~~**shall** be Ductile Iron Pipe (DIP) and ~~will~~**shall** have suitable access **for maintenance by City personnel and vehicles**. ~~In general,~~⁶**Cross-country mains must**~~shall~~ be **designed and constructed with** ~~isolated with~~**isolation** valves **installed**

in the public right-of-way and ~~must~~ shall be identified with blue locating posts (Carsonite 492 CW-112 or ~~an~~ approved equivalent~~equal~~) at approximate 500' intervals, at any angle point, and at the entrance to an easement. Stakes should have vandal-proof metal bottoms. Access requirements as established in Section XIV of the **Sanitary** Sewer System Design Standards may be imposed on a project based on site conditions.

- E. For system reliability, to minimize pipe size, and to minimize the number of people affected by a system shutdown, either for domestic or fire protection purposes, no more than 100 residential units may be served by a single-feed water system. ~~A dual-feed (looping) public water system must~~ shall be designed to provide a secondary source of water to developments serving more than 100 units or in situations where a single feed does not have sufficient hydraulic and/or fire flow capacity~~providing it is hydraulically adequate. Where more than 100 units are to be served, a dual-feed (or Alooping@) public water system must be designed to provide a secondary source of water to the project.~~ Onsite private fire requirements, such as dual fire services and looping mains, will be determined by the Fire Department for residential and nonresidential developments.

- ~~E.F.~~ For purposes of leak detection and maintenance access, no reinforced concrete may be designed over publicly maintained water facilities. Unreinforced concrete will be allowed under special circumstances such as crosswalks, **sidewalks and driveways.**

- ~~E.G.~~ Extent of water main improvements will be as follows:

1. Any offsite water main improvements needed to serve the project must be shown on the improvement plans, including upgrades to existing mains that may be required as a result of a flow analysis or modeling effort.
2. In general, water mains must be designed at least across one-half of the property frontage or to the last service connection, whichever is greater; or where the project is required to provide new street improvements over the water main alignment and the water main will serve properties beyond the project limits, the water main must be designed to cross the full property frontage or to the limits of the street improvements, whichever is greater.

- H. Streets with both water and sewer mains must be at least 20 feet wide, face-of-curb to face-of-curb. ~~Streets having a width of 16 feet or less may only have one public utility. Public Water and public sewer mains may not be installed in alleys.~~

~~one utility only; at least 16 feet wide; no water or sewer mains in alleys.~~

IV. MATERIALS

- A. All materials used shall be lead free per California Health & Safety code, Section 116875.
- B. Service laterals, 1" through 4" in diameter, ~~will~~ shall be "blue" high density polyethylene (HDPE), "blue" polyethylene coated type "K" copper, Polyvinyl Chloride (PVC), or Ductile Iron Pipe (DIP) per applicable City Standards. See Section IV-C for material requirements of PVC laterals.
- ~~A.C.~~ ~~B.6"~~ service laterals, 8" and 12" public water mains and ~~4"12"~~ private fire system mains ~~will~~ shall be Polyvinyl Chloride (PVC) Pressure Class (PC) 235~~150~~, DR18 per AWWA Standard C900; minimum, or Ductile Iron Pipe Pressure Class 350 per AWWA Standard C151 minimum. Where the ~~normal~~ mainline static pressure ~~is exceeds~~ 100 psi or greater, or when required, by the Water Department Director per an approved alternative installation and/or waiver to the SWRCB Waterworks Standards, Ductile Iron Pipe or PVC ~~Pressure Class 200~~ PC305, DR14 ~~must~~ shall be used. *Note: Fire Department may also require DR14 pipe downstream of.*
- ~~B.D.~~ ~~C.16"~~ diameter water mains ~~will~~ shall be ~~Polyvinyl Chloride (PVC) Pressure Class PVC PC165, DR25 per AWWA Standard C905C900, DR25 with a pressure rating of 165 psi~~ or Ductile Iron Pipe per AWWA Standard C151, or as shown on plans and specifications. Where the ~~normal~~ mainline static pressure ~~is exceeds~~ 100 psi or greater, or when required by the Water Department Director per an approved alternative installation and/or waiver to the SWRCB Waterworks Standards, Ductile Iron Pipe or PVC PC235, DR18 per AWWA Standard ~~C905 C900, DR18 with a pressure rating of 235 psi~~ or Ductile Iron Pipe ~~must~~ shall be used.
- E. ~~D.20"~~ diameter and larger water mains ~~will~~ shall be concrete cylinder pipe, wrapped steel pipe, or Ductile Iron Pipe unless otherwise approved by the Director of Santa Rosa Water. ~~Department Director of Utilities.~~
- ~~C.F.~~ Where proposed improvements include a private fire system(s), all material shall be per NFPA Standards and City Fire Department approval.
- G. ~~E.~~ Asbestos cement pipe ~~will~~ shall not be allowed under any circumstances.
- H. Per U.S. et al., ex rel. Hendrix v. J-M Manufacturing Co., Inc., et al., Case No. ED CV-06-0055-GW (C.D. of CA), the City of Santa Rosa is not currently accepting

~~€900 or €905~~ PVC pipe manufactured by J-M Manufacturing Co. or JM Eagle for installation on City projects.

~~—No. 12 insulated wire shall be laid on top of and along the entire length of all new non-metallic pipes and be extended to the surface at all valve locations, blow offs and meter boxes sufficiently for locator equipment to be attached.~~

V. CONNECTION TO AN EXISTING PUBLIC WATER MAIN

- A. Indicate a “hot tap” for connection of service laterals 2" in diameter and smaller ~~unless a mainline valve is also to be installed for isolation.~~
- B. Indicate connection of pipes 4" - 12" in diameter with a hot tap or a cut-in tee in conformance with the provisions of the City’s Water Distribution System Construction ~~Standard~~ Specifications Section ~~13299~~-1.20. Hot taps will be allowed only when no main line valves are required.
- C. Design a cut-in tee if additional valves are required on the existing main. If the new main/lateral is larger than the existing main, the tee and main/lateral valve ~~will~~ **shall** be the size of the existing main unless it is hydraulically necessary to increase the tee and valve to the size of the new main/lateral.
- D. Tie-ins to the existing City water **distribution** system ~~must~~ **shall** be inspected by an ~~Utilities Dept.~~ **authorized City** representative and the improvement plans ~~must~~ **shall** be so annotated.
- E. ~~———~~ Size-on-size taps are allowed up to 8" **for cast iron, ductile iron and PVC mains** in accordance with the approved standards. **Size on size taps on asbestos cement mains, regardless of size, are not recommended and shall not be only be allowed without prior authorization from the Director of Santa Rosa Water. of Utilities.** 12" size-on-size taps are allowed only under emergency situations and with the specific approval of the Director **of Santa Rosa Water. of Utilities** ~~Santa Rosa Water.~~
- F. In most major streets, or where the street surface is less than five years old, installation methods other than open cutting may be required. The Encroachment Officer or the City Engineer, as appropriate, will determine the requirements based on the condition of the existing street.

VI. ALIGNMENT

The Design Engineer shall make every attempt to adhere to current SWRCB Waterworks Standards criteria for the separation of Water Mains and Non-Potable Pipelines. When a proposed alignment is not able satisfy these standards, a proposed alternative installation shall be submitted to the SWRCB "Drinking Water Division" for review and approval as specified in CCR Title 22, Section 64551.100 or any later revision. Once approved by the SWRCB, the proposal along with all documentation shall be submitted to the City of Santa Rosa Water Department for review and approval.

Approval by the SWRCB does not guarantee an approval by the Santa Rosa Water.

A. Horizontal

1. Alignment ~~will~~ shall be in accordance with the provisions of Standard 871 or as directed by the Engineer.
2. New water systems shall be designed as "Restrained Joint Systems" wherever possible minimizing the use of concrete thrust blocks and/or restraint harnesses except as otherwise specified herein, in the Water Distribution System Construction and Rehabilitation Specifications, or on the plans. The Design Engineer shall show system restraint lengths on the plans, and all restraint calculations shall be provided to the Engineer.
3. Installations of 90-degree bends shall only be installed where site constraints do not allow the installation of two 45-degree bends. Where two 45-degree bends are required per these specifications there shall be as much separation between the bends as practical for the design.
24. In general, the water distribution system shall be designed in straight segments parallel to the sanitary sewer or storm drain system, or to the curb line when no other utilities are present, so that future locating and maintenance is simplified. When deflection of the system is required, ~~T~~the minimum allowable radius of curvature for an 8" water main is 250 feet and for a 12" water main is 350 feet. Any deflection in mains larger than 12" must first be approved by the ~~Water Department~~ Director of Santa Rosa Water. ~~In situations such as streets that have smaller radius curves, the water system will shall be designed in straight segments parallel to the sewer or storm drain system so that future locating is simplified.~~
35. Conform to the latest revision of the State of California ~~Department of Health Services~~ ~~Public Health (CDPH)~~ Water Resources Control Board (SWRCB) "Criteria for the Separation of Water Mains and Non-Potable Pipelines ~~Sanitary Sewers~~" (See Appendix "A"), and any modifications

herein or as approved by both the SWRCB Division of Drinking Water and the Water Department Director ~~City Standard 516~~.

46. The minimum horizontal separation from storm drains, monuments, gas, electrical, and telephone lines ~~will~~ shall be 4 feet clear between facilities except at crossings.
57. The minimum clear horizontal separation from a metallic pipeline with an induced current or from an anode field ~~will~~ shall be 5 feet. Where ~~the~~ a new water line ~~main~~ is proposed to ~~will~~ be in proximity to an anode field, the Design Engineer shall submit a special design ~~will~~ shall be required for approval for review and approval by the ~~Water Department Director of Santa Rosa Water. of Utilities. Santa Rosa Water.~~
68. All public water mains ~~must~~ shall be designed a minimum of 5 feet from all structures, such as manholes or drop inlets. Provide a minimum of 3 feet separation from the lip of gutter to edge of pipe for ~~service connections and repairs~~ future connections and maintenance. ~~Water mains will~~ shall be designed The edge of water main pipes shall be designed a minimum of 5 feet from the edge of easements.
79. All water main trenches that are parallel to and deeper than the footing of any adjacent structure must be designed at least ~~forty five (45-)~~ degrees from the footing as required in the Uniform Plumbing Code. Any exceptions must first be approved in writing by the ~~Water Department Director of Santa Rosa Water. of Utilities Santa Rosa Water~~ and the ~~Chief Director of Building Official~~, and shall comply with all applicable Codes and Regulations. ~~Compliance.~~ (See City Std. 517)
810. Where dual water mains are designed, a minimum of 5 feet clear horizontal separation ~~will~~ shall be maintained unless otherwise approved by the ~~Water Department Director of Santa Rosa Water. of Utilities Santa Rosa Water.~~
911. In general, water main crossings over or under other underground facilities ~~will~~ shall be designed as close as 90E degrees to that facility as possible. Crossings of less than 45E degrees ~~will~~ shall only be approved when no other design is possible.

B. Vertical

1. Generally, provide a minimum of 6" vertical separation ~~between~~ from water mains and; telephone (non-fiber optic) and cable TV, and 12" vertical

separation between water mains and; storm drains, gas, electric, fiber optic lines, and Sonoma County Water Agency Aqueduct mains. ~~storm drains or other underground utilities such as telephone, cable TV, gas, or electric conduit.~~ When ~~the a~~ 6" minimum cannot be maintained, plans ~~will~~ shall indicate installation of felt expansion material, Styrofoam, or ~~an approved~~ equivalent between facilities. Other measures, such as the use of ~~concrete encasement,~~ controlled density backfill, or ductile iron pipe may be submitted for review and approval ~~of by~~ the ~~Water Department~~ Director of Santa Rosa Water. ~~. of Utilities.~~ ~~The~~ In all cases, and with written permission from the Director of Santa Rosa Water, the absolute minimum separation between water lines and other underground facilities, except sanitary sewer and storm drains ~~mains will~~ shall be 0.1'. For more guidance on water main and wastewater/storm drain line separations, see section VI-B-2.

2. Conform to the latest revision of the State of California ~~Department of Health Services State~~ Water Resources Control Board (SWRCB), ~~Public Health (CDPH)~~ "Criteria for the Separation of Water Mains and Non-Potable Pipelines ~~Sanitary Sewers~~" (See Appendix "A"), and any modifications herein or as approved by both the SWRCB Division of Drinking Water and the Water Department Director.
3. Comply with section VI-A-2.
4. Where dual water mains are designed, a minimum 1' clear vertical separation ~~will~~ shall be maintained.
5. Where the new water main will be in proximity to an anode field, ~~the Design Engineer shall submit a special design for review and will be required for approval by the Director of Utilities~~ Santa Rosa Water.

VII. MAIN SIZING CRITERIA

- A. Allowable nominal sizes for public water mains are 8", 12", and 16". ~~Mains larger than 16" must have specific approval of~~ Any main size other than those specified ~~shall~~ must first be approved by the ~~Water Department~~ Director of Santa Rosa Water. ~~of Santa Rosa Water. Utilities.~~
- B. Public water mains ~~must~~ shall be sized to meet minimum Fire Code requirements in addition to domestic and irrigation demands. Private fire protection mains ~~must~~ shall be sized to meet minimum Fire Code requirements (see Section XII-~~JL~~ for fire flow requirements).

- C. The minimum new public main size ~~is~~ shall be 8 inches. New public mains serving commercial, industrial and/or multi-family residential developments greater than two units ~~must~~ shall be a minimum of 12 inches. Existing mains that will serve such proposed uses must be upgraded as ~~needed~~ required to meet the current Fire Code.
- D. Analysis and design of water systems ~~will~~ shall be based upon the criteria listed in the City's Water Distribution System Master Plan where applicable. The ~~Water Department~~ Director of Santa Rosa Water Utilities may require an increased pipe size for overall system benefit. When the project is required to provide larger water mains than needed for the development, the applicant may apply to ~~Utilities engineering~~ Water Department Engineering for oversize reimbursement.
- E. Maximum flow velocity for new public or private water mains ~~is~~ shall be 10 feet per second, to be calculated by applying the demands from Section VII-B above.

VIII. MAIN / LATERAL COVER

- A. Cover is the distance from the top of the pipe to final finished grade measured directly over the pipe.
- B. Typically, the minimum standard depths of cover for public water mains ~~and private fire protection mains are~~ shall be:

Pipe Size	4" through 8"	10"	12"	16" or Larger
Cover (in.)	36"	40"	44"	48"

Service laterals shall comply with the above table unless otherwise specified or approved by the Water Department Director.

- C. Where minimum cover is less than standard or greater than 8', special written permission from the ~~Water Department~~ Director of Santa Rosa Water. ~~of Utilities~~ is required. ~~Show mains with nonstandard cover~~ All new water mains shall be shown in a profile on the Improvement Plans or Encroachment Permit applications. Where cover is less than the standard, Pressure Class 350 Ductile Iron Pipe is required, but in no cases shall a cover of less than 24" be approved.
- ~~D.~~ Where standard cover cannot be maintained, such as at the crossing of a water main with a sewer line ~~main~~ or any other utility line, the Design Engineer shall propose lowering or raising the water main utilizing either a gradual deflection (roping) of the water main pipe itself, without installed elbow fittings, and that does not exceed the manufacturer's recommended instructions for this type of installation, ~~n~~

~~undercrossing or overcrossing~~ or by utilizing ductile iron pipe with restrained mechanical joint type elbows. Where restrained joints are used to lower or raise the water main, all connected piping and appurtenances shall also be restrained, as needed, to safeguard all system components, new and existing, that may be affected. ~~will be chosen based upon the evaluation by the Developer's Engineer.~~ Evaluation by the Design Engineer ~~will~~ include, at a minimum, SWRCB "water main and non-potable pipelines criteria", the need for higher class pipe, use of controlled density backfill, ~~as~~ pipe encasement, ~~ability to meet California Criteria for Separation of Water Mains and Sanitary Sewers,~~ need for additional joint restraint beyond the lowering or raising, and the resulting need for combination air/and vacuum release valves (ARV). ~~This evaluation will shall be submitted to the Director of Santa Rosa Water of Utilities for review.~~ Raising of the water main will only be allowed where a lowering, in the opinion of the Water Department Director, is not practical for system maintenance or repair.

~~E.D.~~ The minimum cover for service laterals ~~will~~ shall be as shown on the appropriate City Standard Plan. Where service laterals have conflicts with other facilities, a detail or profile ~~must~~ shall be shown on the plans, or the plans ~~must~~ shall be sufficiently annotated to give clear direction for the installation.

~~F.E.~~ When designing a cut-in tee or cross for a service or main connection that is larger than the existing main, the new assembly ~~must~~ shall be shown at the minimum depth for the size of tee or cross per section VIII above. ~~herein, a~~ The depth shall also be sufficient to allow the valves to remain below the street subgrade, which may necessitate lowering the existing main.

IX. VALVING

- A. Valving at intersections ~~will~~ shall be in accordance with the provisions of Standard 871. A minimum of three ~~(3)~~ mainline valves are required for "T" intersections and four ~~(4)~~ valves are required ~~for cross~~ at four way intersections. A valve may not be required on any leg of a tee or cross intersection if another valve is within 250 feet, except as needed to isolate fire hydrants, fire lines, commercial or multi-unit services, or dialysis centers.
- B. All hydrants ~~must~~ shall be on separately valved sections of the public main, including firelines serving private hydrants.
- C. Any water main which does not have a fire hydrant, fire line, commercial or multi-unit service, or dialysis center lateral connection ~~will~~ shall have valves designed at approximately 1,000 foot intervals or as required by the Director of Santa Rosa Water. ~~of Utilities.~~

D. Water main valves ~~must~~ shall be designed outside of concrete areas wherever possible to facilitate repairs.

E. Cross-country water mains must be isolated with valves in the public right-of-way and shall be identified with locating posts at 500-foot intervals, at any angle point and at entrances to easements.

F. Gate Valves

1. Water gate valves shall comply with City Standard 877.
2. Water gate valves shall be ductile iron conforming to AWWA Standard C509 and/or AWWA C515 of the latest revisions and shall be resilient seat type with non-rising stem opening counter clockwise, with O-ring stem seal and suitable ends for connecting to the type of pipe or fitting used.
3. The working pressure rating of the water gate valve shall meet or exceed the pressure rating of the pipe.
4. External bolts and nuts shall be stainless steel grade 304 or better.
5. Shallow installations where the operating nut of the valve will be 6" or less below finished grade shall typically be avoided where possible. Where a shallow installation is not avoidable, in the opinion of the Director of Santa Rosa Water, the design shall call for installation of a horizontal gate valve unless otherwise approved in writing or directed by the Water Director.

G. Butterfly Valves

1. In general butterfly valves will not be allowed without special permission from the Director of Santa Rosa Water.
2. Butterfly valves shall comply with City Standard 878.
3. Butterfly valves shall be flanged or mechanical joint type only and shall conform to AWWA Standard C504 of the latest revision and shall be the rubber seat type.
4. Butterfly valve discs shall rotate 90 degrees from the full open position to the tight shut position.
5. Butterfly valve seat shall provide a ~~t~~ight shut off at a pressure differential of 150 psi upstream and 0 psi downstream in either direction.
6. The butterfly valve operator shall be the travelling nut type.

7. The butterfly valve shall open with a counter-clockwise rotation on the operating nut.
8. External bolts and nuts shall be 304 stainless steel.

X. SERVICE LATERALS AND METERS FOR DOMESTIC AND IRRIG. SERVICE

- A. Developments will be provided City domestic and/or irrigation water service via water meters located at the frontage of a public street.
- B. The City may allow meters to be located on private street frontages and/or within public utility/water easements if ~~a the City Utilities~~**Santa Rosa Water Department** evaluation concludes that it is reasonable under the circumstances. However, meters must be readily accessible **for reading and maintenance**.
- C. Design meter boxes out of traveled ways and a minimum of 10' from street trees whenever possible.
- D. ~~The Design Engineer shall utilize the latest edition of AWWA Manual M22, and any additional requirements by the City's Fire Department where applicable, for the sizing of service laterals and water meters. All hydraulic calculations and related documentation for proposed sizing shall be submitted to the Water Department for review and approval. Base any required hydraulic calculations for the water meter and service lateral sizes on criteria from the latest edition of AWWA Manual M22 and any additional requirements from the City's Fire Department, and submit to the Director of Santa Rosa Water Utilities for approval.~~
The Design Engineer shall utilize the latest edition of AWWA Manual M22, and any additional requirements by the City's Fire Department where applicable, for the sizing of service laterals and water meters. All hydraulic calculations and related documentation for proposed sizing shall be submitted to the Water Department for review and approval.
- E. The maximum velocity in domestic, irrigation, fire line, or combination water service laterals from the main to the meter ~~is shall be~~ 15 feet per second.
- F. Maintain a minimum 5' horizontal separation between water and sewer laterals.
- G. Meter manifolds other than those shown in various City Standards ~~Plans will shall~~ be detailed on the plans and **must be** approved by the ~~Utilities Department, Engineering Division~~**Engineer**.
- H. Residential (single units)
 1. Each lot ~~must shall~~ be separately metered.
 2. **Where conditions allow, A standard 1" install a dual water service lateral per Standard 864 is preferred when practical** to serve two single-family residential lots, providing each lot is less than 2 acres. **Upon approval by**

the Engineer, individual services may be installed where conditions are not practical for a dual water service lateral installation. ~~Otherwise, provide an individual 3/4" service lateral for a 5/8" x 3/4" meter for each lot.~~

3. Provide a ~~1"~~ 1-1/2" HDPE water service lateral with a ~~5/8"~~ 1" meter for any lot greater than 2 acres. The Santa Rosa Water Department may, at their discretion at specific sites, require the installation of a 1" copper water service lateral in place of the 1-1/2" HDPE.
4. Water service laterals shall not cross lots they do not serve.

I. Residential with Accessory Dwelling Unit(s) (ADU), formerly known as "second unit" (as defined in the City Zoning Code Section 20-03.111 Article 6), two SFDs on one lot, and Duplexes.

1. Each unit ~~must~~ shall be served by ~~separate~~ meter(s) in accordance with City Code.
2. If a new ADU ~~second unit~~ is constructed and the total water flow for both units exceeds the capacity and allowable velocity of ~~an~~ the existing 3/4" water service lateral, based on the criteria established in the latest edition of AWWA Manual M22, the service lateral ~~must~~ shall be upsized ~~to a 1"~~ to accommodate the additional flows as directed by Water Department Engineering staff. ~~the Director of Utilities. Otherwise~~ If first approved by the Director of Santa Rosa Water, the existing lateral may be utilized and an additional water service lateral installed to serve the ADU ~~second unit~~.
3. If the primary unit and the ADU ~~second unit~~ are to be constructed at the same time, design a ~~1"~~ 1-1/2" Dual water service per Standard 864 for the site. The Santa Rosa Water Department may, at their discretion at specific sites, require the installation of a 1" copper dual water service lateral in place of the HDPE. ~~service lateral for the a site.~~
4. The appropriate service lateral ~~must~~ shall be shown on the Public Improvement Plans and/or Encroachment Permit submitted for review and approval.

J. Multi-Family Residential (3 or more units)

1. For triplexes or lots with three PUDs, condominiums, or townhomes, individual meters ~~are~~ shall be required for each unit.
2. For multi-family developments of 4-99 units, whether rental units or

separate ownership units, design for an appropriately sized single master meter, a master meter for each building cluster, or individual meters for each unit.

3. For complexes of 100 units or more, metering ~~will~~ shall be designed as in (2) above, except that at least two metered connections ~~are~~ shall be required if the project is to be master-metered.
4. See Section X-O for irrigation meter requirements for any landscaped or common areas.
5. All meters ~~must~~ shall be within public right-of-way or easements and easily accessible, and multiple meters ~~will~~ shall be clustered where possible.

K. Mobile Home Parks

1. Mobile home parks that have rental spaces may have a master meter (two master meters if more than 100 spaces) or each unit may have an individual meter. Parks with individually-owned lots ~~must~~ shall have individual meters. When master meters are used, the mobile home park owner may sub-meter to the tenants at their own expense, providing they comply with P.U.C. Requirements.
2. Individual meters ~~must~~ shall be clustered and located within the public right-of-way or easement and located for ease of access.
3. See Section X-O for common area irrigation meter requirements.

L. Mixed residential and commercial uses ~~must~~ shall have separate meters.

M. Commercial

1. See Section X-O below for irrigation requirements.
2. A minimum 1-1/2" HDPE ~~1"~~ domestic service lateral is required for commercial use. The Santa Rosa Water Department may, at their discretion at specific sites, require the installation of a 1" copper water service lateral in place of the HDPE.
3. Critical uses ~~facilities~~ such as hospitals, jails, elderly care facilities, and others as determined by the Director of Santa Rosa Water Utilities, shall require at least two separate water services for domestic use that must be connected to separately valved sections of the public water distribution

system~~main~~.

N. Combination Services for Private Fire Service with Domestic and/or Irrigation Service

1. Only 6", 8" and 12" combination service laterals are allowed.
2. The combination service lateral ~~must~~ shall equal or exceed the size of the required fire line and ~~must~~ shall be hydraulically sized to provide adequately combined domestic, irrigation, and fire flows without exceeding the allowable velocity of 15 feet per second.
3. A minimum 8" combination service lateral ~~is~~ shall be required for lots with unknown commercial, multi-family, industrial and shopping centers uses where onsite hydrants are not likely to be required for development.
4. A minimum 12" combination service lateral ~~is~~ shall be required for lots with unknown commercial, multi-family, industrial or shopping center uses where onsite hydrants are likely to be required for development.

O. Irrigation

1. Provide separate irrigation meters for landscaped areas of all commercial uses.
2. Provide separate irrigation meters for common areas of all condominium, townhome, PUD, apartment complexes, and mobile home parks.
3. Provide reduced pressure (RP) backflow devices for all irrigation services. Backflow device types ~~must~~ shall be specified on the irrigation plan and ~~must~~ shall conform to City Standard 876 and the most current USC Approved List of Devices at time of installation.
4. Sizing of irrigation meters ~~will~~ shall be determined by the ~~Utilities~~ Water Department after reviewing the landscape plans. Irrigation meter size ~~will~~ shall be determined by the maximum flow required at the meter and ~~will~~ shall be based on the latest edition of AWWA manual M22's criteria for meter sizing. Water demand purchased ~~will~~ shall be based on the estimated gallons required to maintain the planned landscape in a healthy condition for our climate. Along with landscape and irrigation plans, the applicant ~~must~~ shall submit the planned square footage of planted areas and categories of plants to be used as selected from the following:

- ~~a.~~—High water use plants: turf, annuals, and container plants;
- ~~b.~~~~a.~~
- ~~c.~~—Moderate water use plants: ornamental trees, shrubs ground covers, and perennials primarily irrigated by sprinklers. (Note that there may be some use of drip or bubblers in this category but not a predominance.)
- ~~d.~~~~b.~~
- ~~e.~~~~c.~~ Low water use plants: drought tolerant plants recognized as having a plant factor of 0.3 or less and irrigated primarily through drip emitters.

XI. PUBLIC IMPROVEMENTS FOR PRIVATE FIRE SYSTEMS

~~A. The Utilities Department~~**Santa Rosa Water** is responsible for mapping private fire systems, including **their** hydrants, for the Fire Department and for assuring properly sized service **laterals**. Design plans showing private fire systems ~~must~~**shall** be submitted to the ~~appropriate Fire Department and/or Building jurisdiction~~ for **review and approval.**~~and;~~

~~1.) may be included with the Public Improvement Plans for the project, or~~

~~2.) copies of the approved plans may be submitted to Santa Rosa Water Utilities Engineering prior to requesting a meter set and activating the fire system.~~

~~A.B.~~ Generally, the lateral size ~~must~~**shall** be designed **to be** the same size or larger than the size required for the fire sprinkler system and/or the private hydrant system. **Caution** - onsite fire system design may necessitate changes to preapproved public improvements. The hydraulic calculations for laterals serving private fire systems ~~will~~**shall** be based on the required fire flow or the fire sprinkler demand, whichever is greater, combined with the peak domestic flow.

~~B.C.~~ All private fire systems that only serve onsite hydrants require aboveground single detector check valves in accordance with Standard ~~879~~**888**. Where aboveground installations are not reasonable due to site constraints, **in the opinion of the Water Department and Santa Rosa Fire**, design for single detector check valves in vaults per Standard ~~888~~**879**.

a. Double-check detector backflow assemblies **per Standard 880** are required for:

1. ~~All~~ connections serving commercial fire sprinkler systems; or
2. ~~any~~**Any** property with multiple fire service connections; or

3. ~~any~~Any fire line connections to properties with auxiliary water supply.

~~C.D.~~ Reduced-pressure detectors are required for:

1. ~~a~~Any fire line utilizing chemical additives such as antifreeze or fire suppressants; or
2. ~~any~~Any building where an extreme hazard exists.

~~D.E.~~ For one- and two-family residential fire sprinkler systems:

1. Where the multipurpose water system circulates for fire sprinklers and domestic supply, no backflow device is required.
2. Where the fire system does not circulate water with the domestic supply, double-check backflow assemblies must be designed where the fire system connects to the domestic system. Design the backflow assembly as close as possible to the water meter.
3. Where a fire sprinkler system is to be installed in a one or two ~~unit~~ family dwelling, design the service lateral from the street main to the water meter and the water meter to be 1" minimum. Larger size laterals and meters may be ~~permitted~~ required where hydraulic calculations indicate the need.

~~E.F.~~ The location of any Fire Department connection ~~must~~shall be approved by the Fire Department.

~~F.G.~~ Critical uses ~~facilities~~ such as hospitals, ~~detention centers~~, ~~jails~~, elderly care facilities, and others as determined by the Director of ~~Santa Rosa Water Utilities~~ and/or the Fire ~~Code Official~~, ~~Marshal~~, require at least two fire line service connections to separately valved sections of the public water main, so that service can be maintained in the event of a main line shutdown.

XII. FIRE HYDRANTS

- A. Generally, fire hydrants required onsite to serve one lot ~~will~~shall be private.
- B. Generally, fire hydrants required onsite to serve two or more lots ~~will~~shall be public.
- C. Design of hydrant locations ~~must~~shall meet the Fire Code requirements and ~~must~~ be approved by the Fire Department for logistics and by ~~Santa Rosa Water the~~

~~Utilities~~ Department for maintainability.

~~C.D.~~ Each fire hydrant ~~shall~~~~must~~ be on a separately valved 6" or larger main line section per City Standard 857.

E. Whenever possible, locate hydrants near street intersections.

~~G.F.~~ If it is not possible to locate near an intersection, locate the hydrant near a property line or where it will minimize interference with property use.

~~H.G.~~ Locate hydrants a minimum of 10' from roll down of driveways for commercial or multi-family sites and 5' from residential driveways.

~~I.H.~~ On streets with raised medians or with four or more travel lanes, design hydrants on alternate sides of the street per current City Fire Code. Each side of the street will be considered independently relative to hydrant placement per subsections XII-~~J.I~~ and XII-~~K.J~~.~~below.~~

~~J.I.~~ Residential property with one or two dwelling units - Typical locations

1. Design hydrants with a maximum spacing of 500'~~spacing~~, or as approved by the Fire Department. Design hydrants at a maximum spacing of 300' in ~~High Fire Severity Zones.~~ Wildland – Urban Interface Fire Areas as designated by the City Fire Department.
2. Generally, design hydrants at intersections and then evenly distribute hydrants throughout the project.
3. Specify "residential" hydrants per City Std. 857 on the plans.

~~K.J.~~ Commercial, Industrial, and Multi-family (3 or more units) - Typical locations

1. ~~1.~~—Generally, design hydrants at intersections or near driveway entrances and then evenly distribute hydrants throughout the project.
2. ~~2.~~—No portion of the exterior wall of the facility or building ~~may~~~~shall~~ be more than 400'~~150'~~ from the nearest hydrant as measured by an approved route around the building per the City Fire Code. Onsite fire hydrants and mains shall be provided where required by the Fire Department per City Ord. 4079~~3958~~.

~~2.3.3.~~ Specify "commercial" hydrants per City Std. 857 on the plans.

~~L.K.~~ Minimum fire flow required at all hydrants:

~~1.~~

1. Fire Flow is the flow rate of a water supply, measured at 20 pounds per square inch (psi) (138kPa) residual pressure, measured in the water main in the vicinity of the flowing hydrant, that is available for firefighting. (City Ord. 4079~~3852~~)

~~Fire flow as specified in the following subsections is defined as the amount of water available at 20 psi, where that pressure is calculated at the discharge outlet of the flowing hydrant.~~

~~1.2.2.~~ Single and two family residential uses require 1,500 gallons per minute flow, ~~except as in subsection L 4 of this section below.~~

~~2.3.3.~~ The required fire flows for schools, commercial, industrial, and multi-family residential (3 or more units) uses ~~will~~ **shall** be based on the City Fire Code. The water system ~~will~~ **shall** be designed so that 1,500 gpm is available from the hydraulically most demanding hydrant and the remaining flow required is available at the next most demanding hydrant(s), up to a maximum of 1,500 gpm per hydrant.

~~3. 4.~~ ~~The minimum required fire flow in High Fire Severity Zones is 2,500 gpm for all occupancies, including one and two family residential dwellings. System design will shall accommodate flow apportionment as in subsection L 3 above.~~

4. ~~5.~~ Fire flow requirements are under the jurisdiction of the Fire Department. The guidelines given above are general. Actual flow requirements ~~must~~ **shall** be verified with the Fire Department prior to submittal of plans. Calculations may be required by the Fire Department to verify the adequacy of the proposed design.

XIII. BACKFLOW DEVICES (EXCEPT FOR FIRE LINES)

A. Backflow devices ~~installations are shall be required to be designed~~ in accordance with State of California Title 17 and current City of Santa Rosa Code, Section 14-16, Backflow Regulations.

B. All backflow devices ~~must~~ **shall** be listed on the latest revision of the approved USC

Foundation for Cross-Connection Control and Hydraulic Research list.

- C. Design ~~the installation of~~ backflow assemblies as near as possible to the water meter as shown on Standards 874, 875 and 876.
- D. Backflow ~~preventors~~ ~~preventer~~ type ~~shall~~ ~~will~~ be designed in accordance with Appendix "B". For uses not listed contact ~~Utilities~~ ~~Santa Rosa Water~~ Engineering ~~or Water Quality~~.

XIV. PRESSURE

- A. To obtain water ~~distribution~~ system data for these calculations, contact ~~Utilities~~ ~~the City's~~ Engineering ~~Department~~. A fee ~~will~~ ~~shall~~ be imposed if flow testing is required.
- B. Mainline
 - 1. ~~1.~~—The minimum allowable static pressure in the system is 20 psi.
 - 2. The maximum allowable static pressure in the system is 120 psi.
 - 3. The maximum allowable pressure in a high-level zone is calculated by assuming the reservoir full. In the Aqueduct zone or other reduced pressure zones, calculate the pressure by using the high setting of the pressure regulating valve at the nearest aqueduct connection or system regulator.
 - 4. The minimum allowable pressure in a high level zone is calculated by assuming the reservoir drawn down 10' from the high water level. In the Aqueduct zone or other reduced-pressure zones, use the low setting of the pressure regulating valve at the nearest aqueduct connection or system regulator.
- C. Domestic service
 - 1. The minimum allowable pressure is 20 psi measured at the meter. If pressure measured at any faucet is less than 35 psi, a pressure booster system ~~is~~ ~~shall~~ ~~be~~ required.
 - 2. The maximum allowable pressure at a meter is 120 psi. If service pressure measured at any faucet exceeds 80 psi, a private pressure regulating device ~~is~~ ~~shall~~ ~~be~~ required.

XV. SPECIALTY VALVES AND WATER SAMPLING STATIONS

- A. Specific locations ~~will~~ shall be reviewed for each project by ~~Utilities~~ the City's Engineering Department.
- B. ~~Air release and vacuum relief valves are~~ A combination air and vacuum valve shall be required at substantial high points in the system such as over a hilltop or at the upper end of a dead end main.
- C. Design pressure reducing valves to maintain overall system balance and to maintain service pressure levels within the parameters established within these system design standards.
- D. Typically surge or pressure relief valves are to be designed near the low points of any high level pressure zone where discharge may be directed to an approved disposal system.
- E. Water sampling stations ~~are~~ shall be required to provide representative sampling within each pressure zone. At a minimum, one water sample station ~~is~~ shall be required in each pressure zone, at each reservoir and at pump stations.

XVI. SPECIAL CONDITIONS FOR DELINEATED FAULT ZONES

- A. Fault zones ~~must~~ shall be identified on improvement plans.
- B. Ductile iron pipe ~~must~~ shall be indicated on the improvement plans in delineated fault zones and extend to 100' outside each side of the delineated fault boundaries.
- C. Pumper connections or fire hydrants ~~will~~ shall be designed approximately 50' outside each side of the delineated fault zone. Gate valves ~~must~~ shall be designed between the fault zone and the fire hydrant/pumper connection.
- D. Mechanical joint double-ball Flextend assemblies with 8" expansion/contraction capability, as manufactured by EBAA Iron, Inc. of Eastland, Texas, or ~~an~~ approved ~~alternative equivalent~~, ~~must~~ shall be designed adjacent to each side of the fault zone.

XVII. EASEMENTS

- A. An easement ~~must~~ shall be provided over any public water system when it is installed outside a public right-of-way.

- B. The easement ~~must~~ shall be a minimum of 15' wide if it only contains a water main or 20' wide if it contains another facility as well, such as sewer, storm drain, or other utility. The easement will be dedicated as a "public water easement" if it contains water only. It will be dedicated as a "public utilities easement" if it contains other facilities as well.
- C. Easements ~~must~~ shall be configured to encompass all publicly maintained appurtenances, such as water service laterals, meters and fire hydrants and ~~will~~ shall be generally centered over the facility. Separate access easements may be required depending on site conditions. When water mains are to be installed along a property line the easement ~~will~~ shall be wholly contained on one parcel.
- D. All property restrictions placed as a result of dedication of easements ~~will~~ shall be so noted on the Subdivision Map or on the Easement Deed if the easement is not dedicated as part of a subdivision. Required notes are:
 - 1. No structures may encroach on, above or below the surface of the ground in any public water easement. This includes footing of foundations or eaves from the roof of any adjacent structure, pools, ponds or outbuildings on slabs or foundations. Decks, sheds, or other structures which may be easily removed for maintenance of the water system may be allowed at the discretion of the Director of Santa Rosa Water Utilities.
 - 2. No trees ~~may~~ shall be planted in a public water easement without first obtaining written approval of the Director of Utilities Santa Rosa Water. Trees may be allowed to the extent that damage to the water system does not occur from root intrusion and adequate access can be provided for maintenance and repair vehicles.

XVIII. ABANDONMENT OF WATER DISTRIBUTION SYSTEM COMPONENTS MAINS AND SERVICES

- A. Any existing water mains and service laterals larger than 2" that will not be used ~~must~~ shall be abandoned per Standard 507 and ~~must~~ shall be shown on the Improvement Plans with appropriate notation.
- B. For all abandoned water services up to and including 2", on water mains that are to remain active, annotate to remove the valve and saddle and install a full circle stainless steel clamp on the main under Utilities Department City inspection.
- C. For ~~flanged or mechanical joint~~ tees or crosses on water mains that are to remain active, annotate the Improvement Plans to show ~~remove~~ removal of the tee or cross,

~~the~~ any associated valve(s) and thrust blocks, and install a section of ductile iron pipe with approved couplers ~~a blind flange or mechanical joint plug~~ under Utilities DepartmentCity inspection.

~~D. For push-on tees, the tee, valve and concrete thrust block must be removed and the main repaired with approved pipe and suitable couplings, and so noted on the Improvement Plans.~~

D. Valve boxes and riser pipes for abandoned valves ~~must~~ shall be removed and so noted on the Improvement Plans.

E. Abandoned mains, valves and riser pipes located within any street structural section or within any new trench ~~must~~ shall be shown on the Improvement Plans to be removed.

F. Show all 12" diameter and larger water mains to be abandoned within the public right-of-way as removed or broken into every 50' and filled with an approved flowable fill~~sand slurry~~ per Standard 507.

G. Where a fire hydrant is to be abandoned, note that the hydrant barrel, break off riser, and check valve are to be removed, and the bury is to be capped or plugged in an approved manner, and the lateral abandoned at main per Standard 507~~as stated above~~. Abandonments of fire hydrants must first be approved by the Fire Department.

Appendix "A"

CRITERIA FOR THE SEPARATION
OF WATER MAINS AND ~~SANITARY SEWERS~~ NON-POTABLE PIPELINES

Current version no longer allowed by the State, a revised criteria is being worked on at State level.

Appendix "B"

BACKFLOW DEVICE REQUIREMENTS FOR SPECIFIC TYPES OF USE

BACKFLOW DEVICE REQUIREMENTS

APPLICATION	TYPE OF DEVICE
Auto Sales, Painting, Repair, Radiator work	RP
Auxiliary Water Supply (Contaminated Wells, etc.)	RP
Auxiliary Water Supply	DC
Auxiliary Water Supply (with 2 or more City Water Connections to Site)	DC/RP
Barber Shops	RP
Blood Banks	RP
Boiler Systems (any)	RP
Buildings with Booster Systems	DC
Buildings with 3 or more Stories or with fixtures 30 feet above the service	RP
Buildings with Sewage Ejectors	AG/RP
Buildings with Storage Tanks	DC/RP
Homes with Sewage Lift Stations	RP
Car Wash	AG/RP
Cement, concrete, Sand & Gravel Plants	RP
Chemical Storage or Processing Facilities	AG/RP
Dairy or Cold Storage	RP
Film Processing	RP
Fire Systems - Business/Residential (sprinklers with or without hydrants)	DC w/Det.Ck.

Fire Systems - w/Sprinkler in Hazardous Locations	AG/RP
Gas Stations	RP
Gray Water System	RP
Heating & Air Conditioning (Using Water)	RP
Hospital or Medical Facility (any) Convalescent or Long Term Care	RP
Irrigation Systems	RP

Irrigation System w/Chemical Feed	RP
Laboratories (Commercial or Research)	AG/RP
Laundry or Dry Cleaner	RP
Manufacturing or Processing (with Toxic Chemicals)	AG/RP
Medical or Dental Facility (any)	RP
Mobile Home Park	DC
Ornamental Pools, Ponds or Fountains	RP
Painting Auto Shops	RP
Printing Shops	RP
Radiator Shops (all)	RP
Radioactive Materials	AG/RP
Restaurant	RP/DC
Restricted or Classified Facilities	AG/RP
Schools	RP
Sewage or Storm Drain Facilities	AG
Spray Rigs (all types)	AG
Steam Cleaning Equipment (any type)	RP
Steam Generation	AG/RP
Swimming Pools (Public and Commercial)	RP


Tank Trucks or Chemical Spray Rigs	AG
Veterinary Clinics	RP
Warehousing & Storage	DC/RP
AG = Air Gap DC = Double Check RP = Reduced Pressure DC w/Det. Ck. = w/Detector Check	

WATER DISTRIBUTION SYSTEM STANDARD PLANS - DRAFT


<u>STD#</u>	<u>Title</u>	<u>Approved</u>
850	Typical System Restraint Lengths	Month Year
851	Harness Installation for Flange Fittings	Month Year
852	Harness Installation	Month Year
853	Concrete Anchor Blocks for Vertical Bends	Month Year
854	Concrete Thrust Blocks for Horizontal Bends	Month Year
855	Water Main Lowering	June 2009
856	Water Main Over Structure	June 2009
857	Fire Hydrant and Lateral	Month Year
858	Pumper Connection	Month Year
859	Temporary Blow Off and/or Metered Connection for Mains Under Construction	Month Year
860	Temporary Metered Connection when Fire Flow is Required	Month Year
861	Permanent Blow Off with Harness	Month Year
862	Full Size Blow Off	Month Year
863	3/4" & 1" Water Service Lateral	Sept. 2002
863A	1" High Density Polyethylene Water Service Lateral for 5/8" x 3/4" or 1" Meter	Month Year
863B	1" Copper Water Service Lateral for 5/8" x 3/4" or 1" Meter (Old STD-863)	Month Year
863C	1-1/2" High Density Polyethylene Water Service Lateral for 1" Meter	Month Year
863D	1-1/2" Copper Water Service Lateral for 1" Meter (Old STD-863B)	Month Year
864	1-1/2" 1" High Density Polyethylene Dual Water Service Lateral	Month Year
865	2" Copper Water Service Lateral for 1-1/2" or 2" Meter	June 2009
865A	2" High Density Polyethylene Water Service Lateral for 1-1/2" or 2" Meter	Month Year
865B	2" Copper Water Service Lateral for 1-1/2" or 2" Meter (Old STD-865)	Month Year
866	4" Water Service Lateral for 3" Meter	Month Year
867	4" Water Service Lateral for 4" Meter	Month Year
868	6" Water Service Lateral for 6" Meter	Month Year
869	Combination Water Service Stub	Month Year
870	Combination Water Service / 4" DI Multi-Service Manifold, 2 Sheets	Month Year

871	Alignment of Water Mains and Placement of Mainline Valves	Month Year
872	Dirt Stop & Water Main Encasement and End Seal	Month Year
874	Above Ground Double Check Valve Backflow Device	Month Year
875	Below Ground Double Check Valve Backflow Device	Month Year
876	Reduced Pressure Backflow Device	Month Year
877	Gate Valve	Month Year
878	Butterfly Valve and Tapping Valve	Month Year
879	Above Ground Single Check Detector Assembly (Old STD-888)	Month Year
880	Double Check Detector Fire Line Backflow Assembly	Month Year
881	Pressure Reducing Valves Assembly	Month Year
882	Surge Anticipator Valve or Pressure Relief Valve	Month Year
883	Combination Air and Vacuum/ Air Release Valve	Month Year
884	Water Meter for Private Non-Residential Systems	Month Year
885	Water Meter for Private Process and Evaporative Water Lines	Month Year
886	Water Sampling Station	Month Year
887	4" Ductile Iron Multi-Service Manifold	Month Year
888	Single Check Detector Assembly in Vault (Old STD-879)	Month Year
889	Water Service Anode	Month Year


RESTRAINED LENGTHS PROVIDED BY DESIGN ENGINEER SUPERSEDE THIS STANDARD

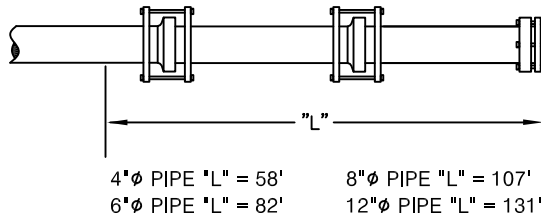

DEAD END & EACH SIDE OF A VALVE

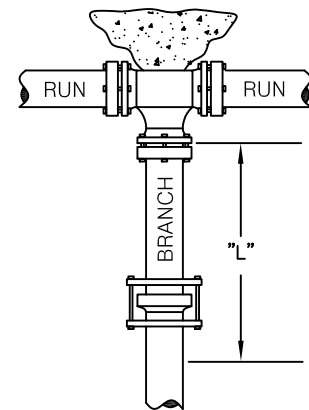


TEE

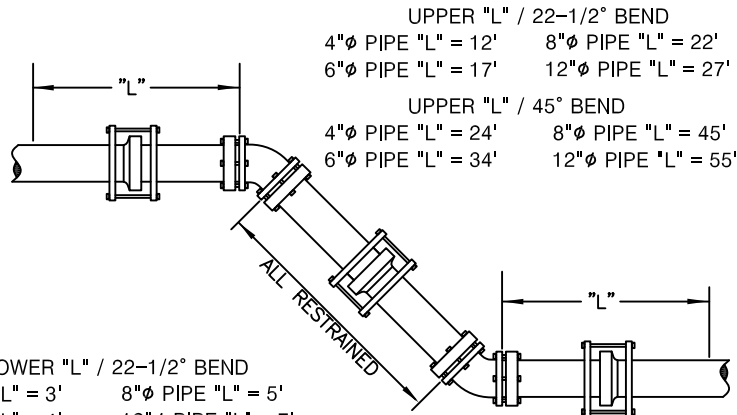

LOWER "L" / 22-1/2° BEND	
4"Ø PIPE "L" = 3'	8"Ø PIPE "L" = 5'
6"Ø PIPE "L" = 4'	12"Ø PIPE "L" = 7'

LOWER "L" / 45° BEND	
4"Ø PIPE "L" = 5'	8"Ø PIPE "L" = 10'
6"Ø PIPE "L" = 7'	12"Ø PIPE "L" = 12'

VERTICAL BENDS

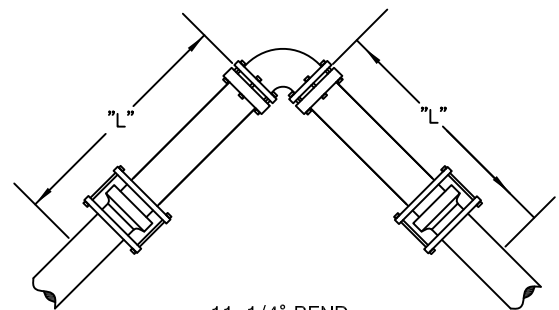

HORIZONTAL BENDS

NOTES:

- All joints within length "L" shall be restrained.
- All tees shall have a concrete thrust block per Standard 854.
- All four "branches" on a cross shall be restrained per the TEE branch length as shown.
- Lengths shown assumes all pipes are installed at City Standard minimum depths. For Vertical bends, low side length provided is for a 1' drop.
- Assumes safety factor of 1.5 and test pressure of 150psi.
- Assumes bedding and backfill is per Standard 215.
- Restraint shown is for new piping, when connecting to existing piping utilize the appropriate City Standards for proper system restraint.
- All joint restraints shall be per the Engineer's List of Approved Items or a City accepted submittal.
- Where main is 12"Ø or larger and area water pressure is 90 psi or greater, concrete thrust blocking per applicable City Standards, and restrained joints shall be installed.

NEW STANDARD

CITY OF SANTA ROSA



TYPICAL SYSTEM RESTRAINT LENGTHS

SCALE: NONE DATE:

DWN: DK
CHK: RS

APPROVED

FILE NO.
STD.- 850

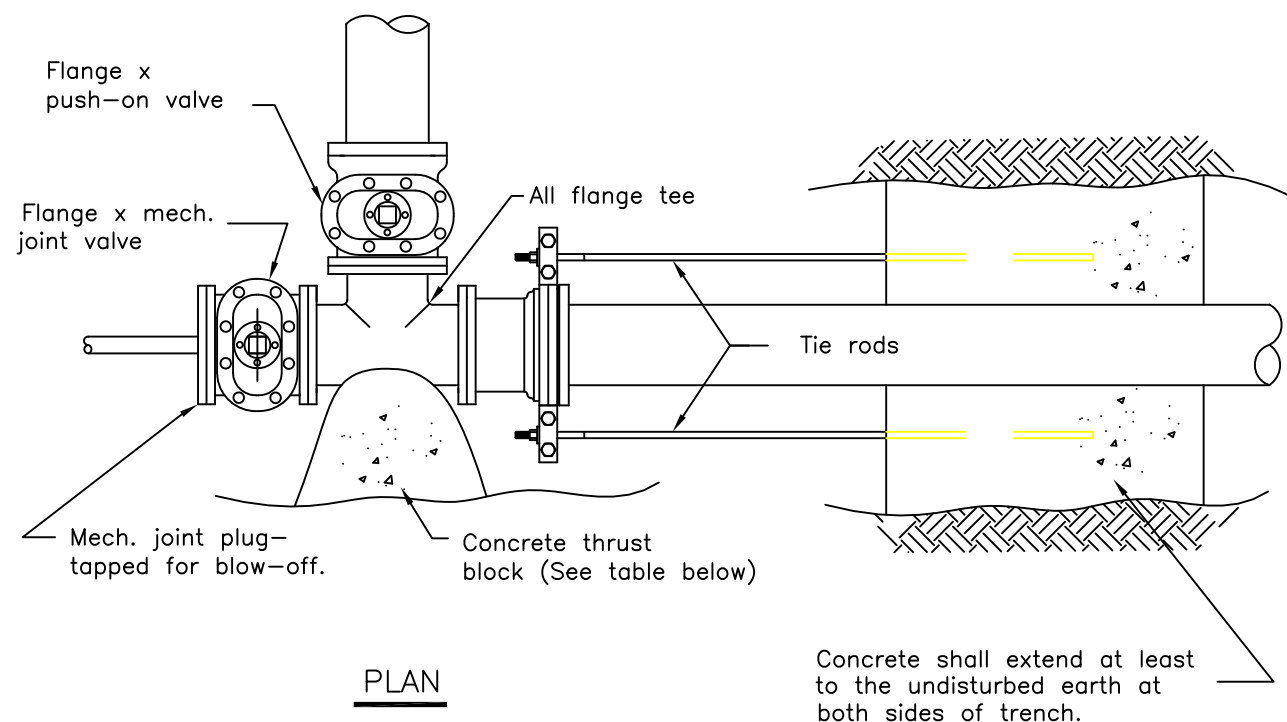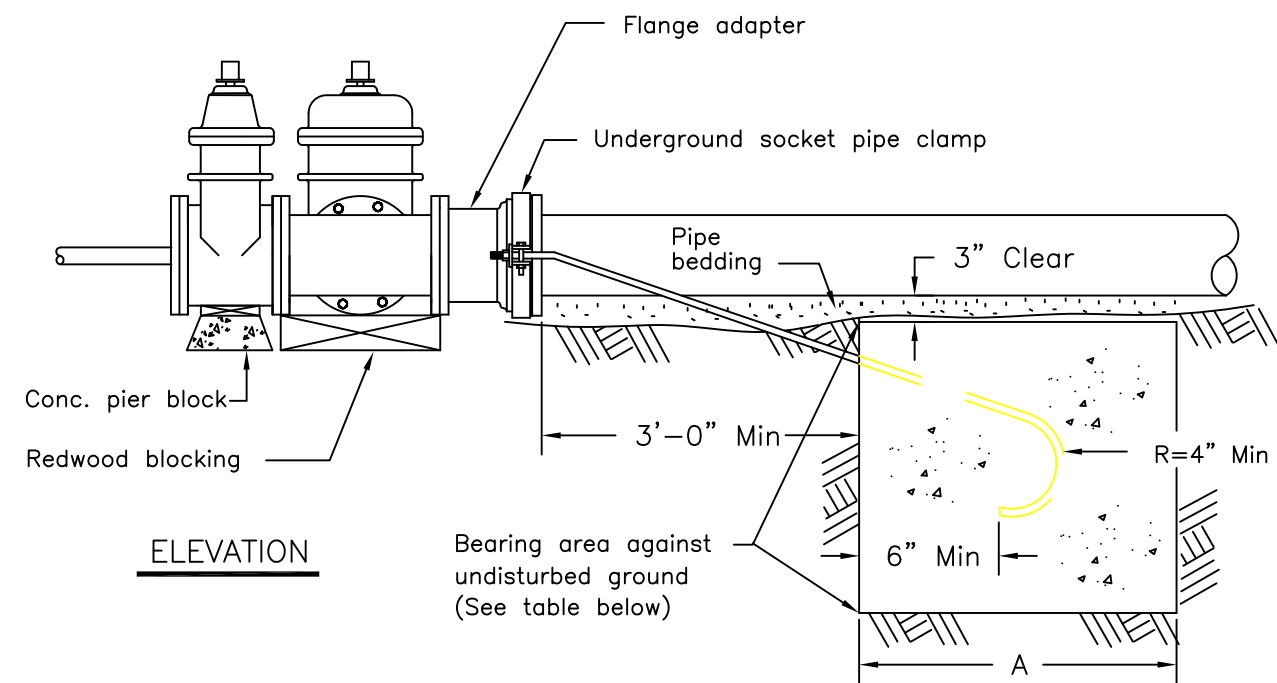



MINIMUM DIMENSIONS				
PIPE SIZE	TIE RODS	HARNESS BLOCK*	A	THRUST BLOCK**
6"	5/8"	4 Sq. Ft.	2'	4 Sq. Ft.
8"	3/4"	7 Sq. Ft.	3'	7 Sq. Ft.
12"	1-1/8"	15 Sq. Ft.	3'	15 Sq. Ft.
OVER 12" BY DESIGN ENGINEER				

* Bearing area below grade of pipe against undisturbed ground.
 ** Bearing area against undisturbed ground.

CITY OF SANTA ROSA

HARNESS INSTALLATION for FLANGE FITTINGS

SCALE: NONE DATE: Sept.2002
 DWN: W.H. APPROVED FILE NO.
 CHK: G.C. STD.- 851

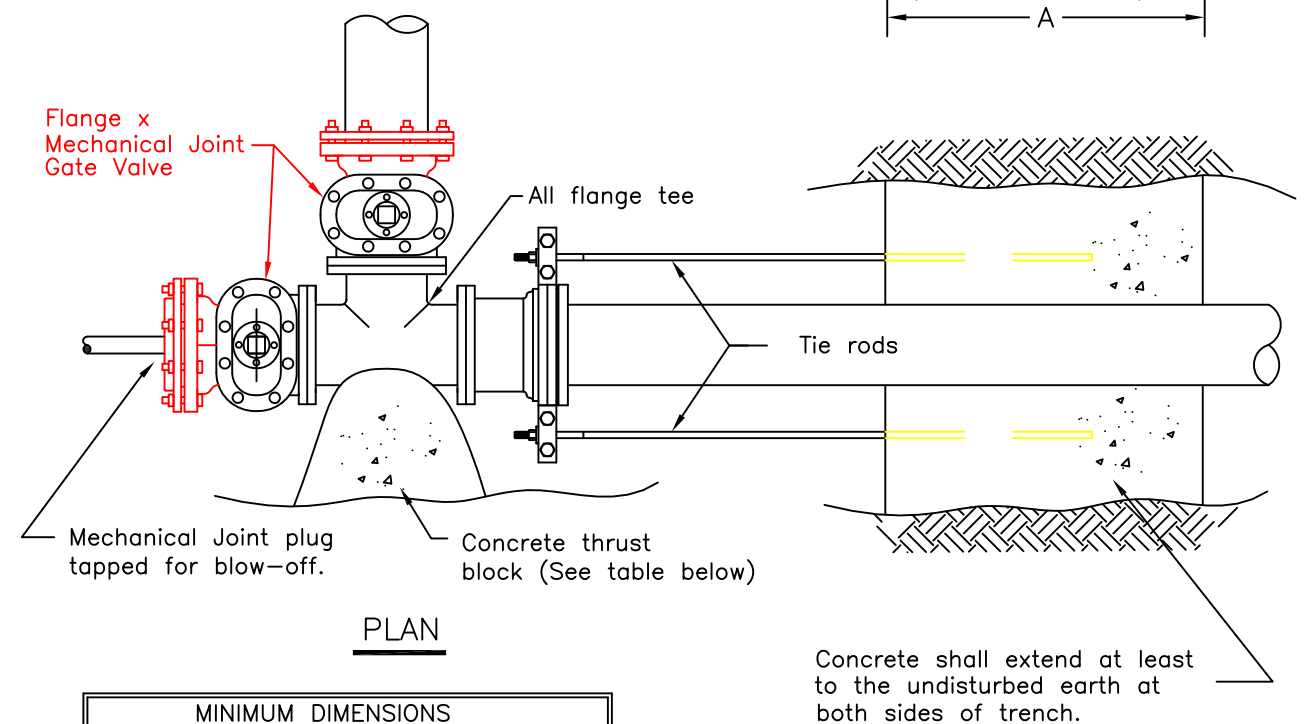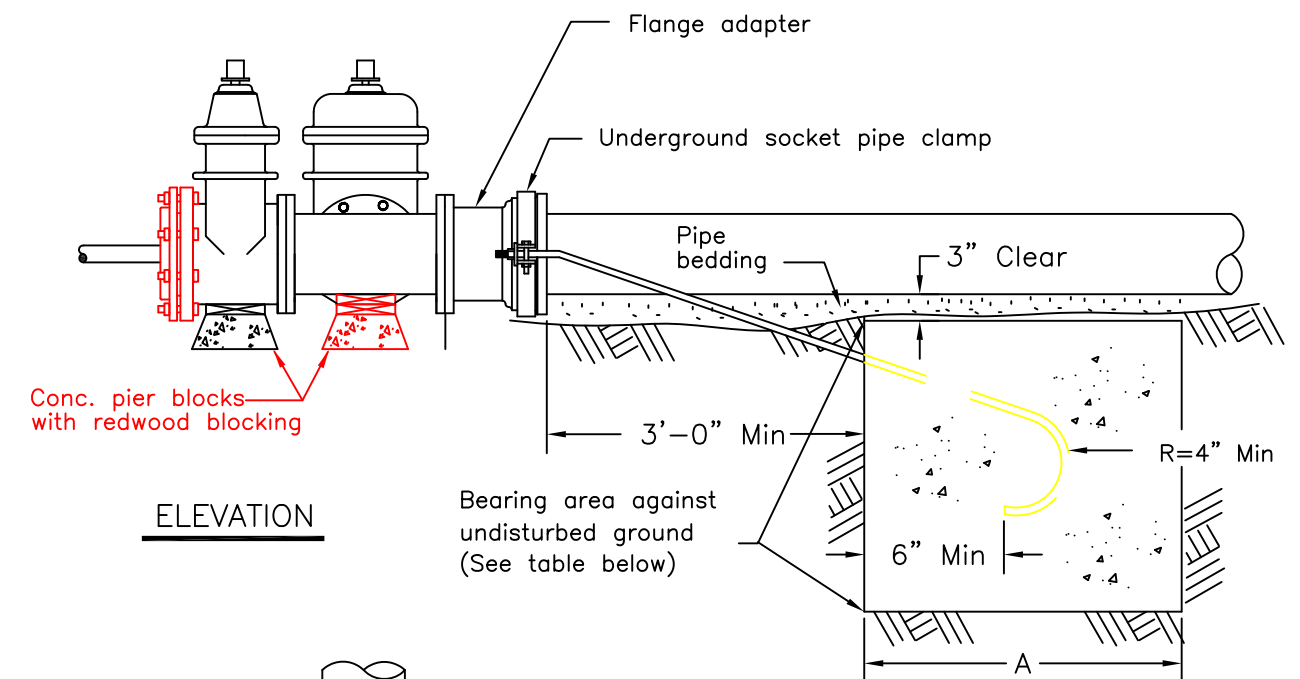

MINIMUM DIMENSIONS				
PIPE SIZE	TIE RODS	HARNESS BLOCK*	A	THRUST BLOCK**
6"	5/8"	4 Sq. Ft.	2'	4 Sq. Ft.
8"	3/4"	7 Sq. Ft.	3'	7 Sq. Ft.
12"	1-1/8"	15 Sq. Ft.	3'	15 Sq. Ft.
OVER 12" BY DESIGN ENGINEER				

* Bearing area below grade of pipe against undisturbed ground.
 ** Bearing area against undisturbed ground.


NOTE:

- Where possible, design a "Restrained Joint System" per City Standards and Specifications in place of, or in addition to harness & tie rods.
- All joints shown shall be restrained.


CITY OF SANTA ROSA

HARNESS INSTALLATION for FLANGE FITTINGS


SCALE: NONE DATE: Apr. 2016
 DWN: W.H. APPROVED FILE NO.
 CHK: G.C. STD.- 851

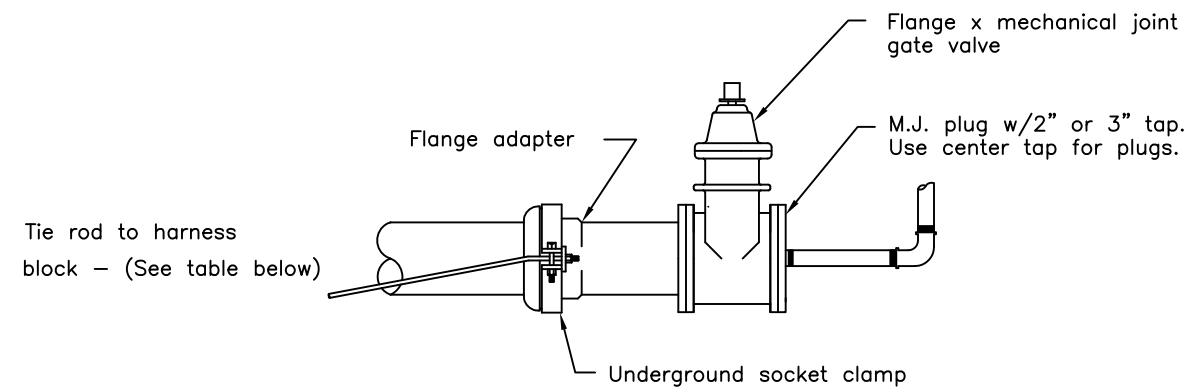

HARNESS FOR VALVE WITH PLUG

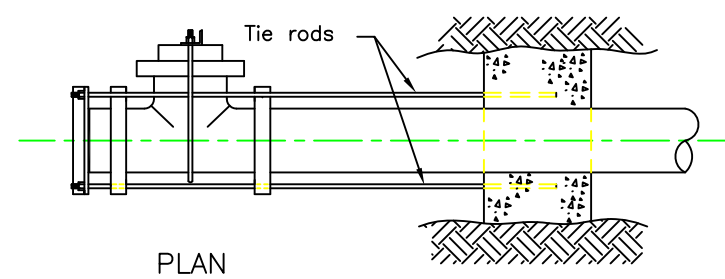

Concrete shall extend at least to the undisturbed earth at both sides of trench

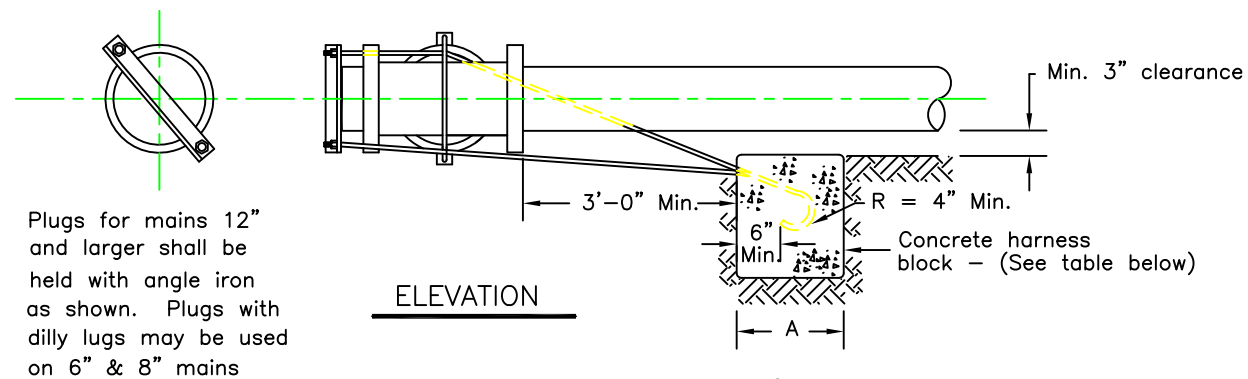

TYPICAL HARNESS

MINIMUM DIMENSIONS				
PIPE SIZE	TIE RODS	ANGLE IRON	* HARNESS BLOCK	A
6"	5/8"	3"x3"x1/4"	4 Sq. Ft.	2'
8"	3/4"	3 1/2"x3"x1/4"	7 Sq. Ft.	3'
12"	1 1/8"	4"x3"x1/2"	15 Sq. Ft.	3'
OVER 12" BY THE DESIGN ENGINEER				


* Bearing area below grade of pipe against undisturbed ground

CITY OF SANTA ROSA


**HARNESS
INSTALLATION**

SCALE: NONE DATE: June 2009


DWN: GC FILE NO. 852
CHK: APPROVED

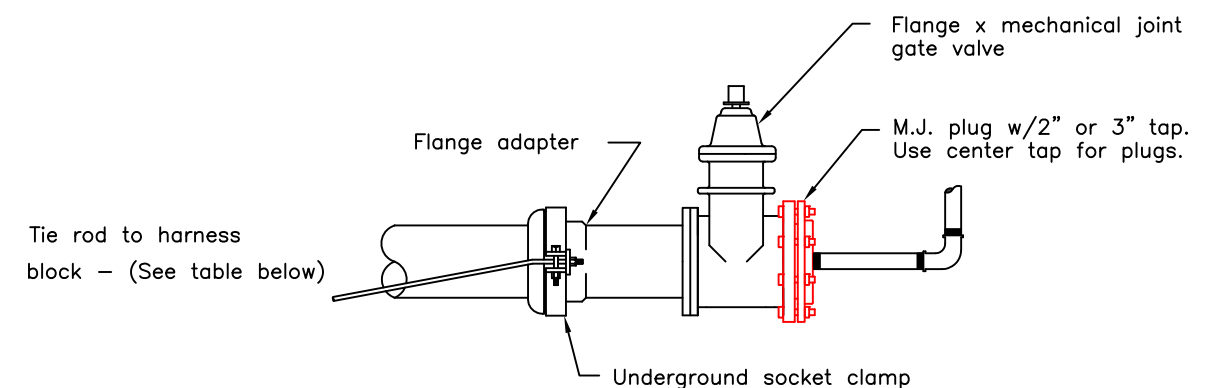

HARNESS FOR VALVE WITH PLUG

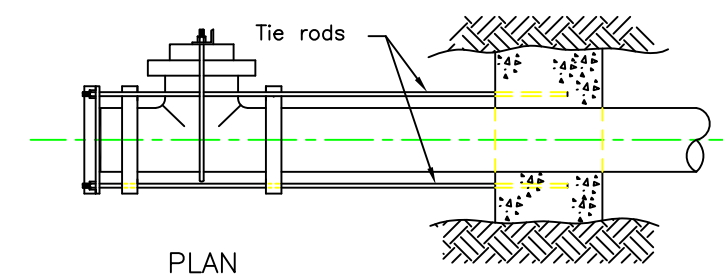

Concrete shall extend at least to the undisturbed earth at both sides of trench

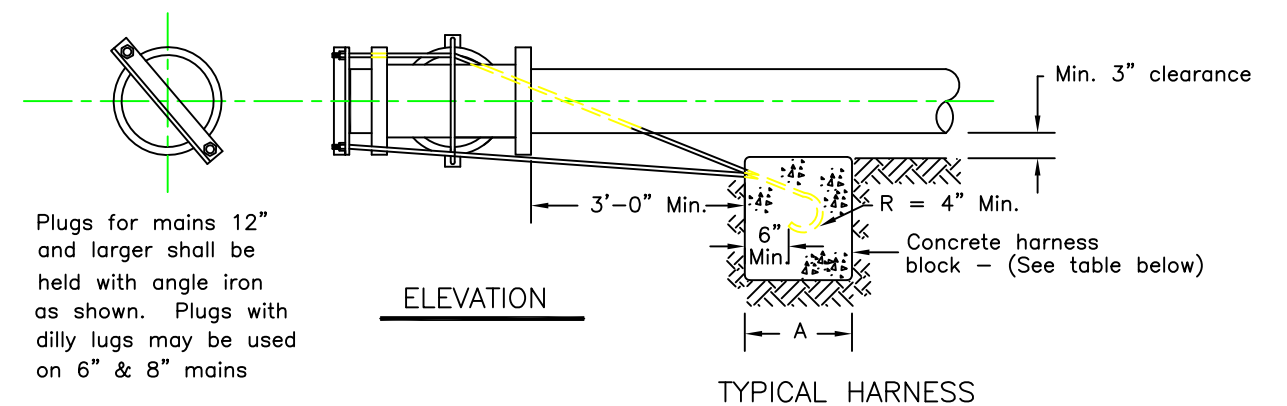

TYPICAL HARNESS

MINIMUM DIMENSIONS				
PIPE SIZE	TIE RODS	ANGLE IRON	* HARNESS BLOCK	A
6"	5/8"	3"x3"x1/4"	4 Sq. Ft.	2'
8"	3/4"	3 1/2"x3"x1/4"	7 Sq. Ft.	3'
12"	1 1/8"	4"x3"x1/2"	15 Sq. Ft.	3'
OVER 12" BY THE DESIGN ENGINEER				

* Bearing area below grade of pipe against undisturbed ground

NOTE:


Where possible, design a "Restrained Joint System" per City Standards & Specifications in place of, or in addition to harness & tie rods.

CITY OF SANTA ROSA


**HARNESS
INSTALLATION**

SCALE: NONE DATE: Mar. 2016

DWN: GC FILE NO. 852
CHK: APPROVED

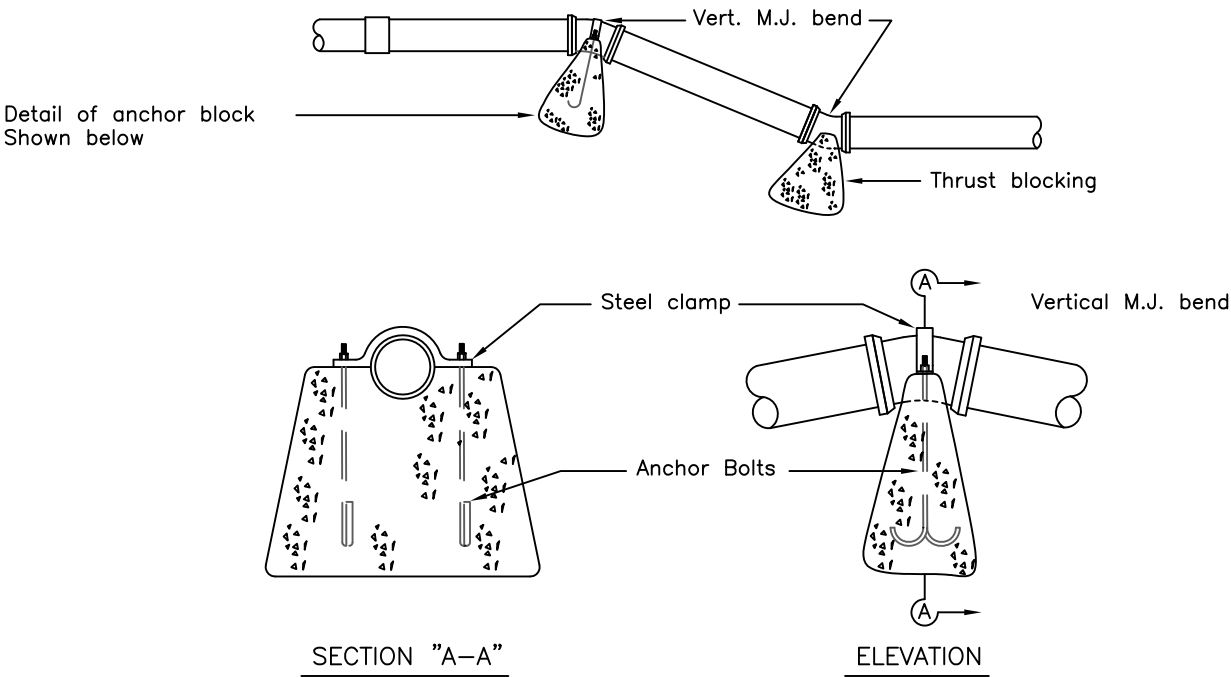

TYPICAL CONCRETE ANCHOR BLOCK FOR VERTICAL BEND

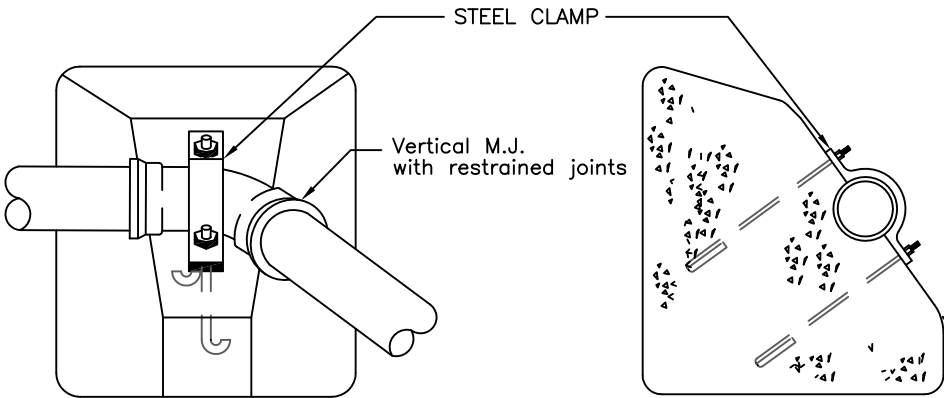


TYPICAL CONCRETE ANCHOR BLOCK FOR COMBINATION
HORIZONTAL – VERTICAL BEND

- NOTES:
1. Concrete anchor blocks shall be installed by the Contractor to withstand a thrust produced by the test pressure plus 50 p.s.i. Minimum dimensions for anchor bolts and clamps are listed in table below.
 2. Use mechanical restrained joints at all fittings.


PIPE SIZE	ANCHOR BOLTS	STEEL CLAMPS
6"	5/8"	3" X 1/4"
8"	3/4"	3-1/4"x1/4"
12"	1-1/8"	4" x 1/2"

For pipes greater than 12", design Engineer must submit calcs. To size anchor bolts & clamps.

CITY OF SANTA ROSA		
CONCRETE ANCHOR BOLTS for VERTICAL BENDS		
SCALE: NONE	DATE: Sept. 2002	
DWN: GC	APPROVED	FILE NO.
CHK:		STD.- 853

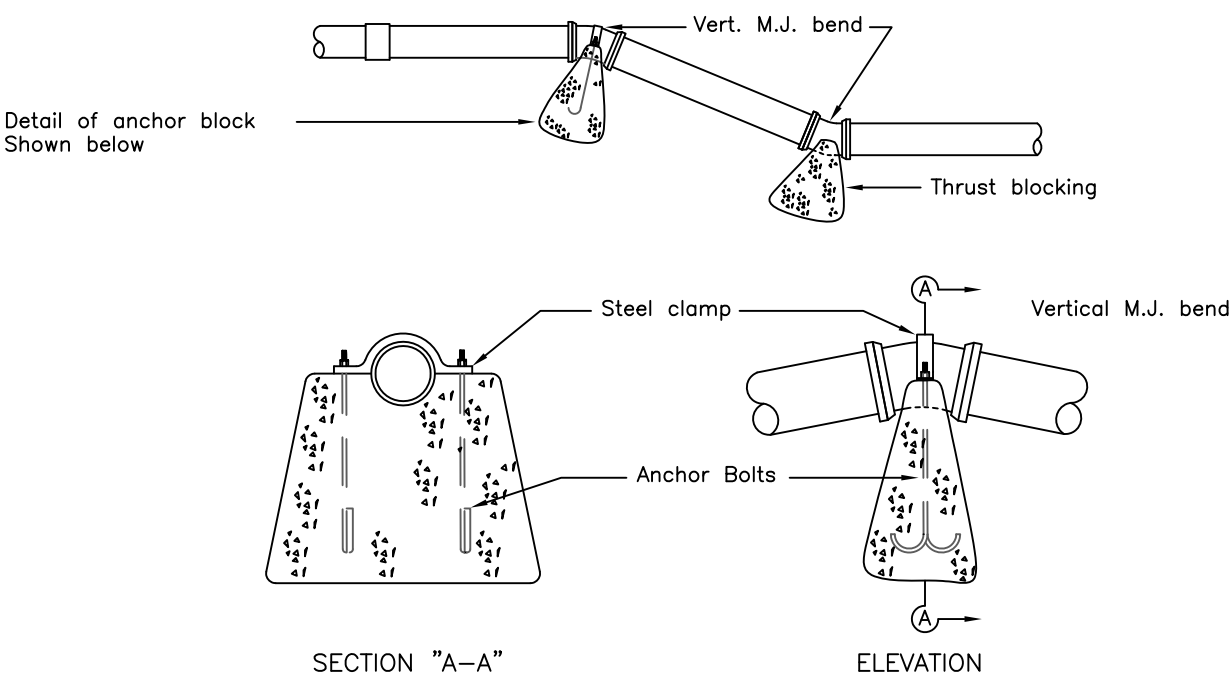

TYPICAL CONCRETE ANCHOR BLOCK FOR VERTICAL BEND

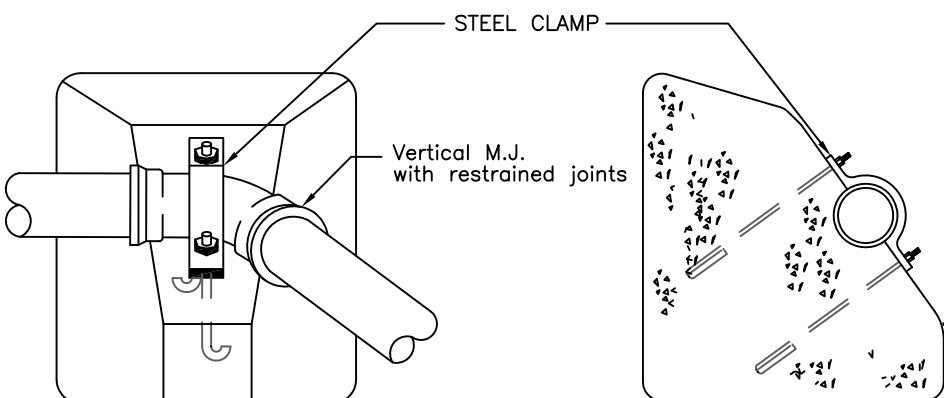

TYPICAL CONCRETE ANCHOR BLOCK FOR COMBINATION
HORIZONTAL – VERTICAL BEND


NOTES:

1. Where new and/or existing conditions allow, design a "Restrained Joint System" per City Standards and Specifications in lieu of, or in addition to anchor blocks as shown.
2. Concrete anchor blocks shall be installed by the Contractor to withstand a thrust produced by the test pressure plus 50 p.s.i. Minimum dimensions for anchor bolts and clamps are listed on Table 1.
3. For pipes greater than 12"Ø, bolts and clamps shall be properly sized by the Design Engineer, with calculations submitted to the City's Engineer.
4. Use mechanical restrained joints at all fittings.


TABLE 1

PIPE SIZE	ANCHOR BOLTS	STEEL CLAMPS
6"	5/8"	3" X 1/4"
8"	3/4"	3-1/4"x1/4"
12"	1-1/8"	4" x 1/2"


CITY OF SANTA ROSA		
CONCRETE ANCHOR BLOCKS for VERTICAL BENDS		
SCALE: NONE	DATE: Mar. 2016	
DWN: GC	APPROVED	FILE NO.
CHK:		STD.- 853

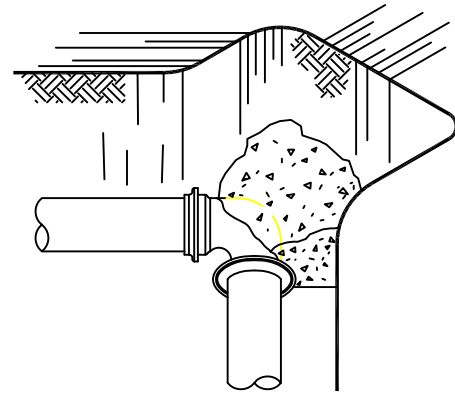


BEND
TYPICAL CONC. BLOCKING
SHOWN IN PERSPECTIVE.

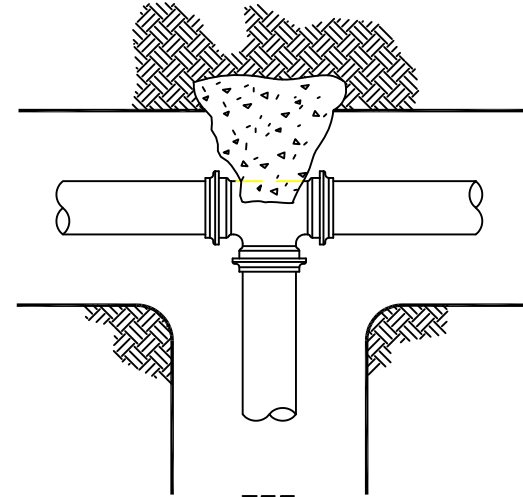

TEE

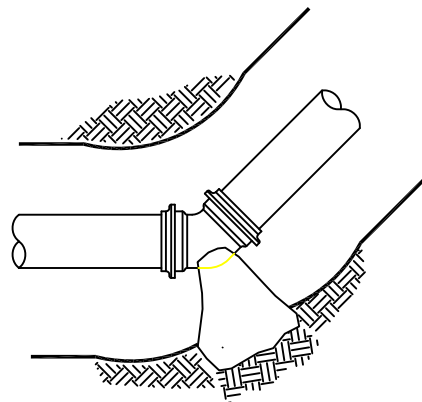

TYPICAL BEND

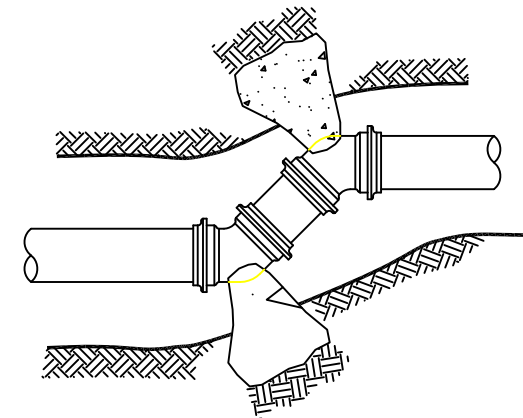

OFFSET

NOTES:

1. Safe bearing load of soil for horizontal thrust shall not be exceeded.
2. Concrete blocking, cast-in-place, to extend from bells of fittings to undisturbed soil and entire bearing area must be against undisturbed soil.
3. In using the Thrust Blocking Table below, assume 2000 P.S.F. bearing capacity unless otherwise shown on the plans. The Design Engineer shall specify thrust blocking requirements for all other soil bearing conditions.
4. For plugged leg(s) of tee or cross use harness type blocking as shown on STD. 852 and concrete blocking indicated in table below.

MIN. REQ'D BEARING AREA IN SQ. FT. PER 100 P.S.I. TEST PRESSURE*					
PIPE SIZE	SOIL BEARING CAPACITY(PSF)	TEES & DEAD ENDS	90° BENDS	45° BENDS	22-1/2° BENDS
6"	1000	4	6	3	2
	2000	2	3	2	1
8"	1000	7	10	5	3
	2000	4	5	3	2
12"	1000	16	22	12	6
	2000	8	11	6	3

* MULTIPLY NO. IN TABLE BY TEST PRESSURE & DIVIDE BY 100


For pipes greater than 12", Design Engineer must submit calculations to size concrete thrust blocks.

CITY OF SANTA ROSA


CONCRETE THRUST
BLOCKS for
HORIZONTAL BENDS

SCALE: NONE DATE: Sept.2002


DWN: GC
CHK: APPROVED
FILE NO.
STD.- 854

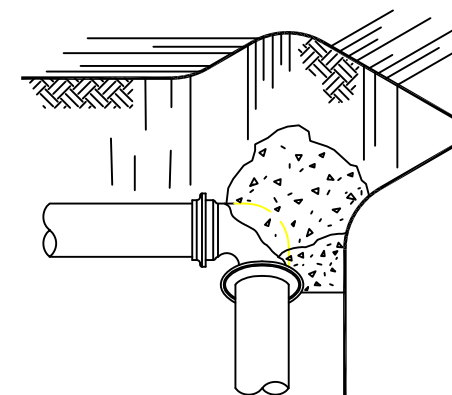


BEND
TYPICAL CONC. BLOCKING
SHOWN IN PERSPECTIVE.

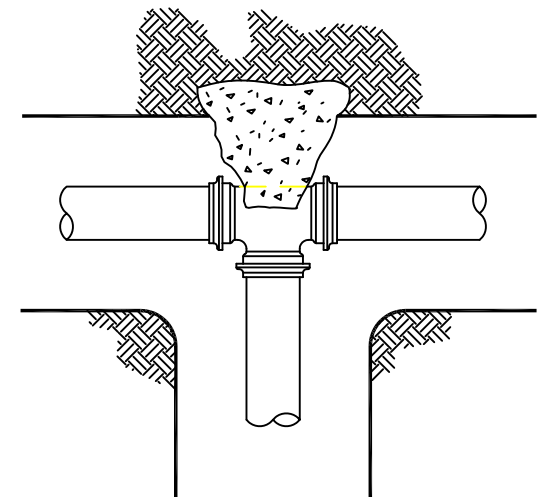

TEE

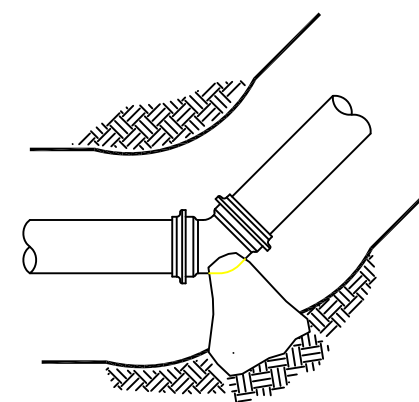

TYPICAL BEND

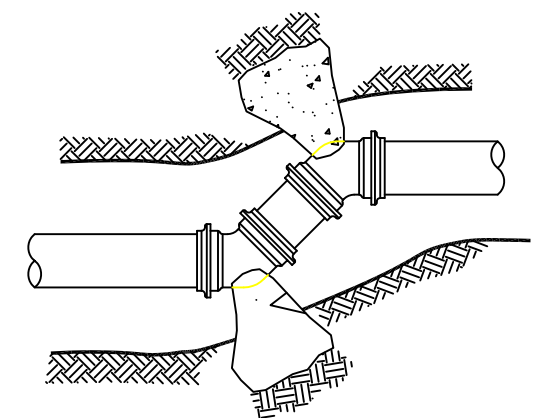

OFFSET

NOTES:

1. Where new and/or existing conditions allow, design a "Restrained Joint System" in lieu of or in addition to concrete thrust blocks as shown.
2. Concrete blocking shall be poured to extend from bells of fittings to undisturbed soil, and the entire bearing area must be against undisturbed soil. Bolts and nuts shall be protected and kept clear of concrete.
3. In using Table 1, assume 2000 P.S.F. bearing capacity unless otherwise shown on the plans. The Design Engineer shall specify thrust blocking requirements for all other soil bearing conditions.
4. Safe bearing load of soil for horizontal thrust shall not be exceeded.
5. See Water Distribution Construction Specification for fitting type requirements.
6. Install mechanical joint plug or blind flange on leg(s) of tee or cross installed for future use.
7. For pipes greater than 12", concrete thrust blocks shall be properly sized by the Design Engineer, with calculations submitted to the City's Engineer.

TABLE 1

MIN. REQ'D BEARING AREA IN SQ. FT. PER 100 P.S.I. TEST PRESSURE*					
PIPE SIZE	SOIL BEARING CAPACITY(PSF)	TEES & DEAD ENDS	90° BENDS	45° BENDS	22-1/2° BENDS
6"	1000	4	6	3	2
	2000	2	3	2	1
8"	1000	7	10	5	3
	2000	4	5	3	2
12"	1000	16	22	12	6
	2000	8	11	6	3


* MULTIPLY NO. IN TABLE BY TEST PRESSURE & DIVIDE BY 100

CITY OF SANTA ROSA

CONCRETE THRUST
BLOCKS for
HORIZONTAL BENDS

SCALE: NONE DATE: Mar. 2016


DWN: GC
CHK: APPROVED
FILE NO.
STD.- 854

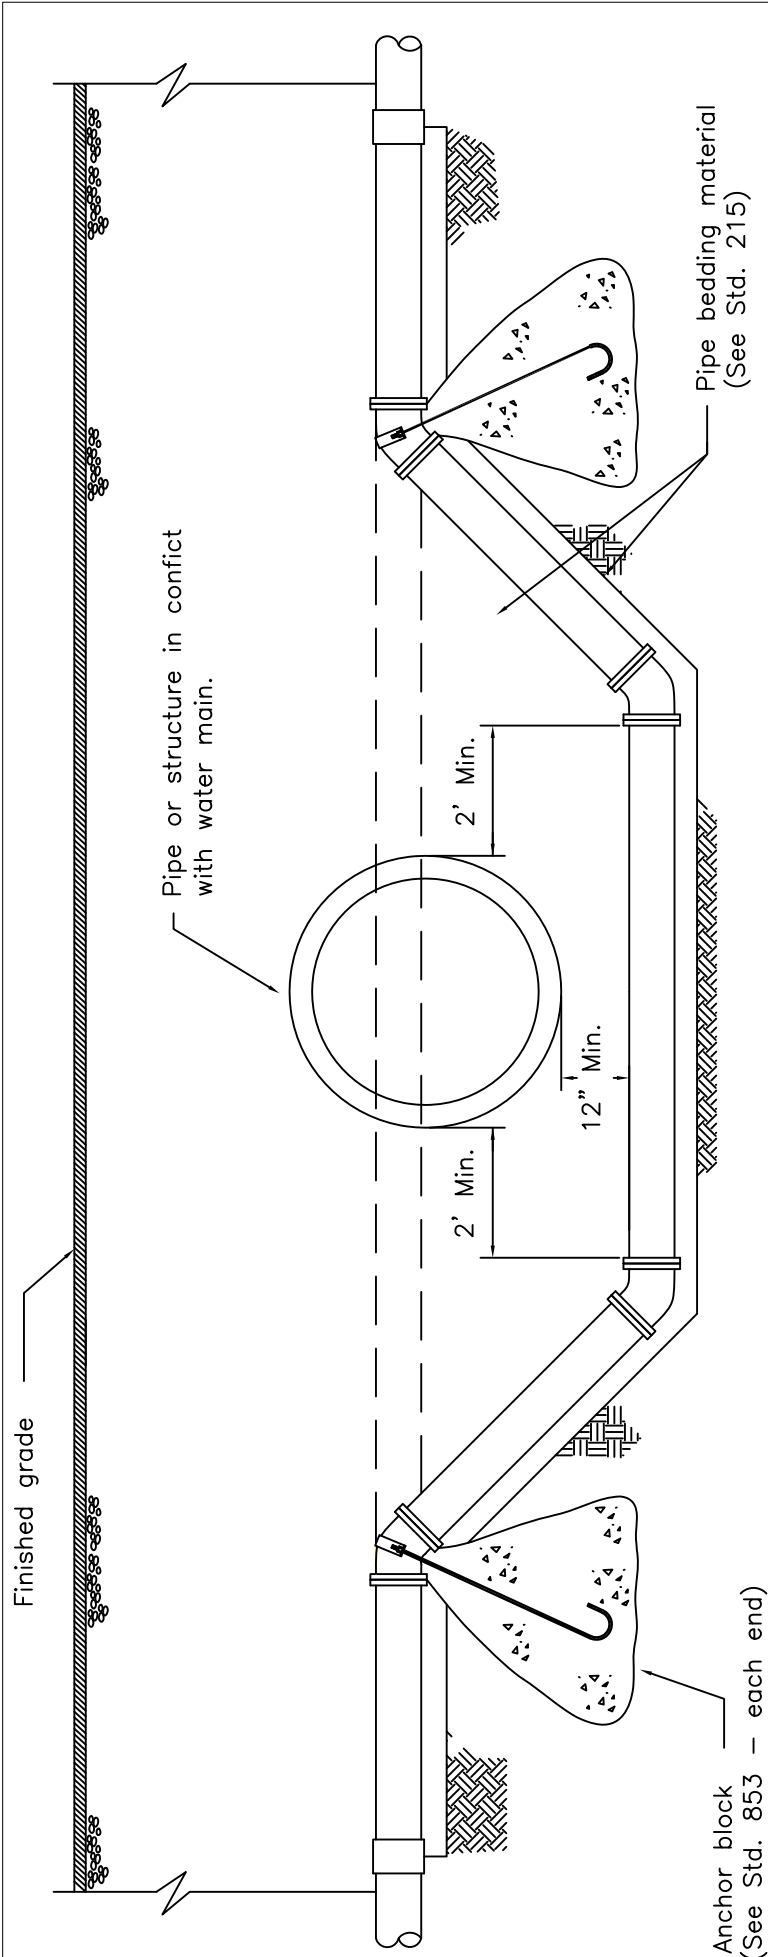

NOTES:

1. All pipe and fittings shall be ductile iron & shall be wrapped in polyethylene – per City of Santa Rosa Std. Construction Specifications.
2. Only mechanical joint fittings with restrained joints may be used.
3. All bends shall be 45° or 22–1/2° fittings.
4. If all new mains are being constructed, couplings are not required.
5. If installing a drop into an existing main, connections to cast iron, ductile iron or PVC pipe shall be made with mechanical joint solid sleeves. Flexible couplings shall be used when connecting to asbestos cement pipe.

CITY OF SANTA ROSA			
WATER MAIN LOWERING			
SCALE:	NONE	DATE:	June 2009
DWN: GC RR	APPROVED		FILE NO.
CHK: AA			STD.- 855

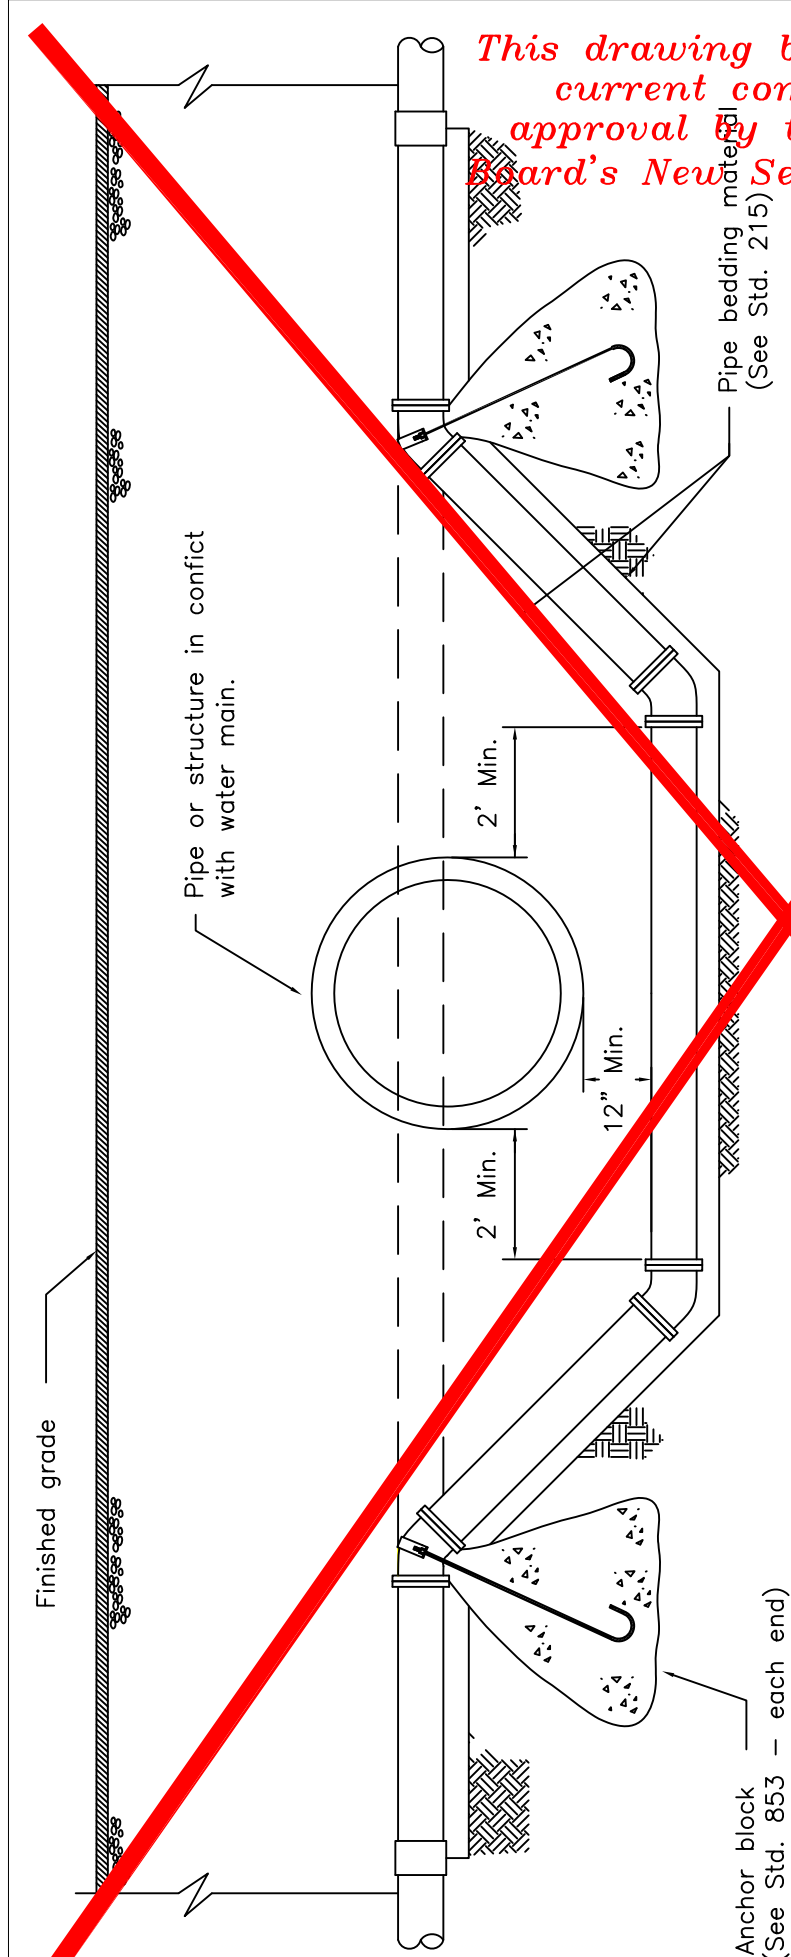


This drawing being revised for current compliance and approval by the State Water Board's New Separation Criteria

NOTES:

1. All pipe and fittings shall be ductile iron & shall be wrapped in polyethylene – per City of Santa Rosa Std. Construction Specifications.
2. Only mechanical joint fittings with restrained joints may be used.
3. All bends shall be 45° or 22–1/2° fittings.
4. If all new mains are being constructed, couplings are not required.
5. If installing a drop into an existing main, connections to cast iron, ductile iron or PVC pipe shall be made with mechanical joint solid sleeves. Flexible couplings shall be used when connecting to asbestos cement pipe.


<i>CITY OF SANTA ROSA</i>			
WATER MAIN LOWERING			
SCALE: NONE		DATE: June 2009	
DWN: GC RR		APPROVED	FILE NO.
CHK: AA			STD.- 855

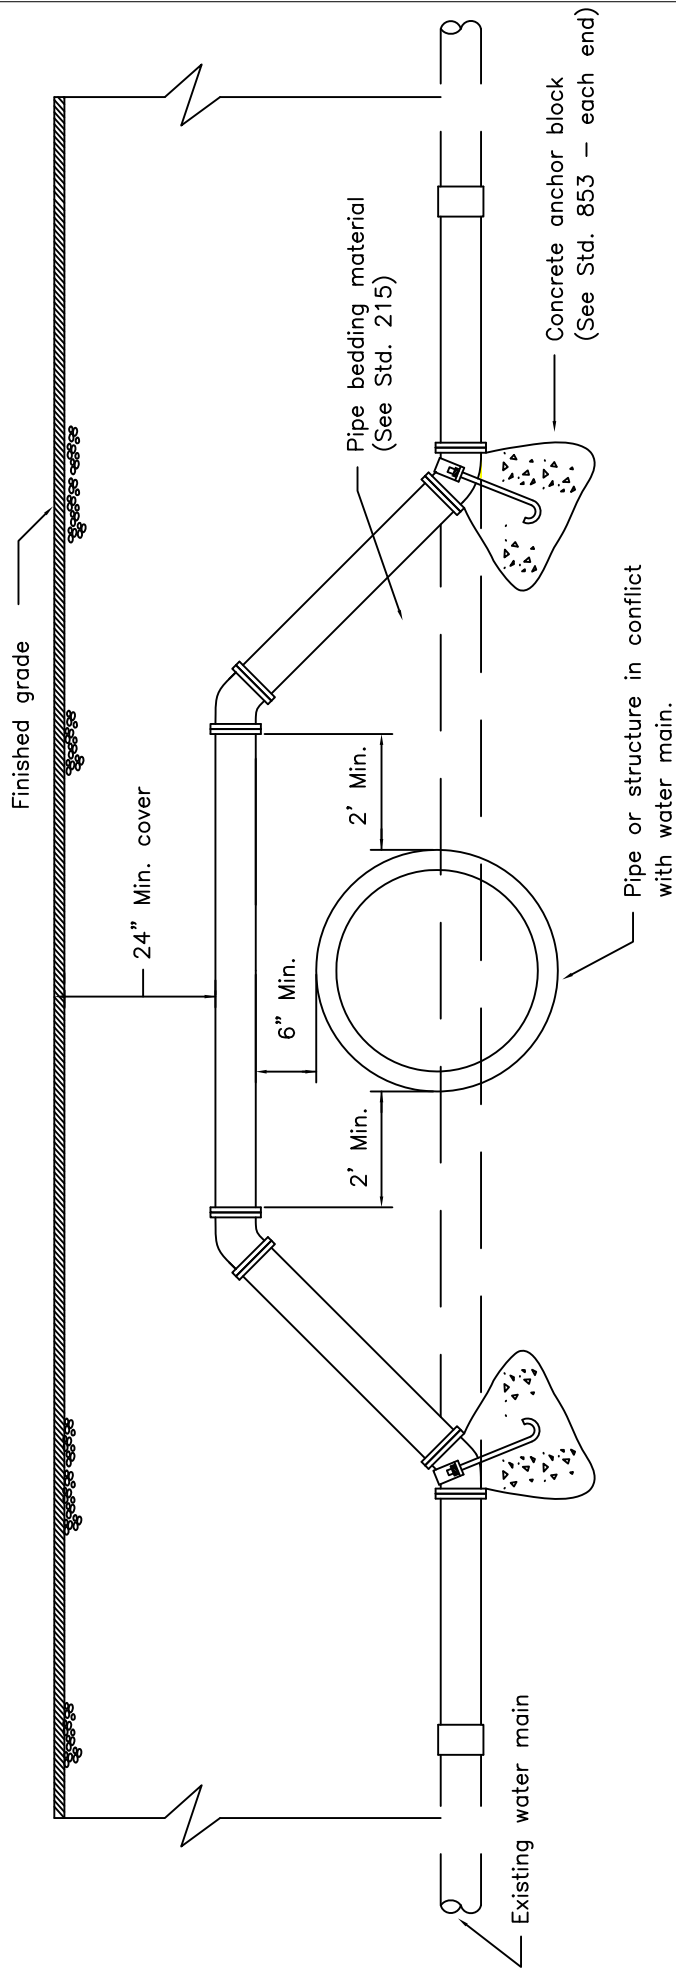

NOTES:

1. All pipe and fittings shall be ductile iron & shall be wrapped in polyethylene per City of Santa Rosa Std. Construction Specifications.
2. Only mechanical joint fittings with restrained joints may be used.
3. All bends shall be 45° or 22-1/2° fittings. - No 90° bends allowed.
4. If all new mains are being constructed, couplings are not required.
5. If installing a drop into an existing main, connections to cast iron, ductile iron or PVC pipe shall be made with mechanical joint solid sleeves. Flexible couplings shall be used when connecting to asbestos cement pipe.
6. To be used only at the direct approval of the Director of Utilities.


CITY OF SANTA ROSA		
WATER MAIN OVER STRUCTURE		
SCALE: NONE	DATE: June 2009	
DWN:GC RR CHK: AA	APPROVED	FILE NO. STD.- 856

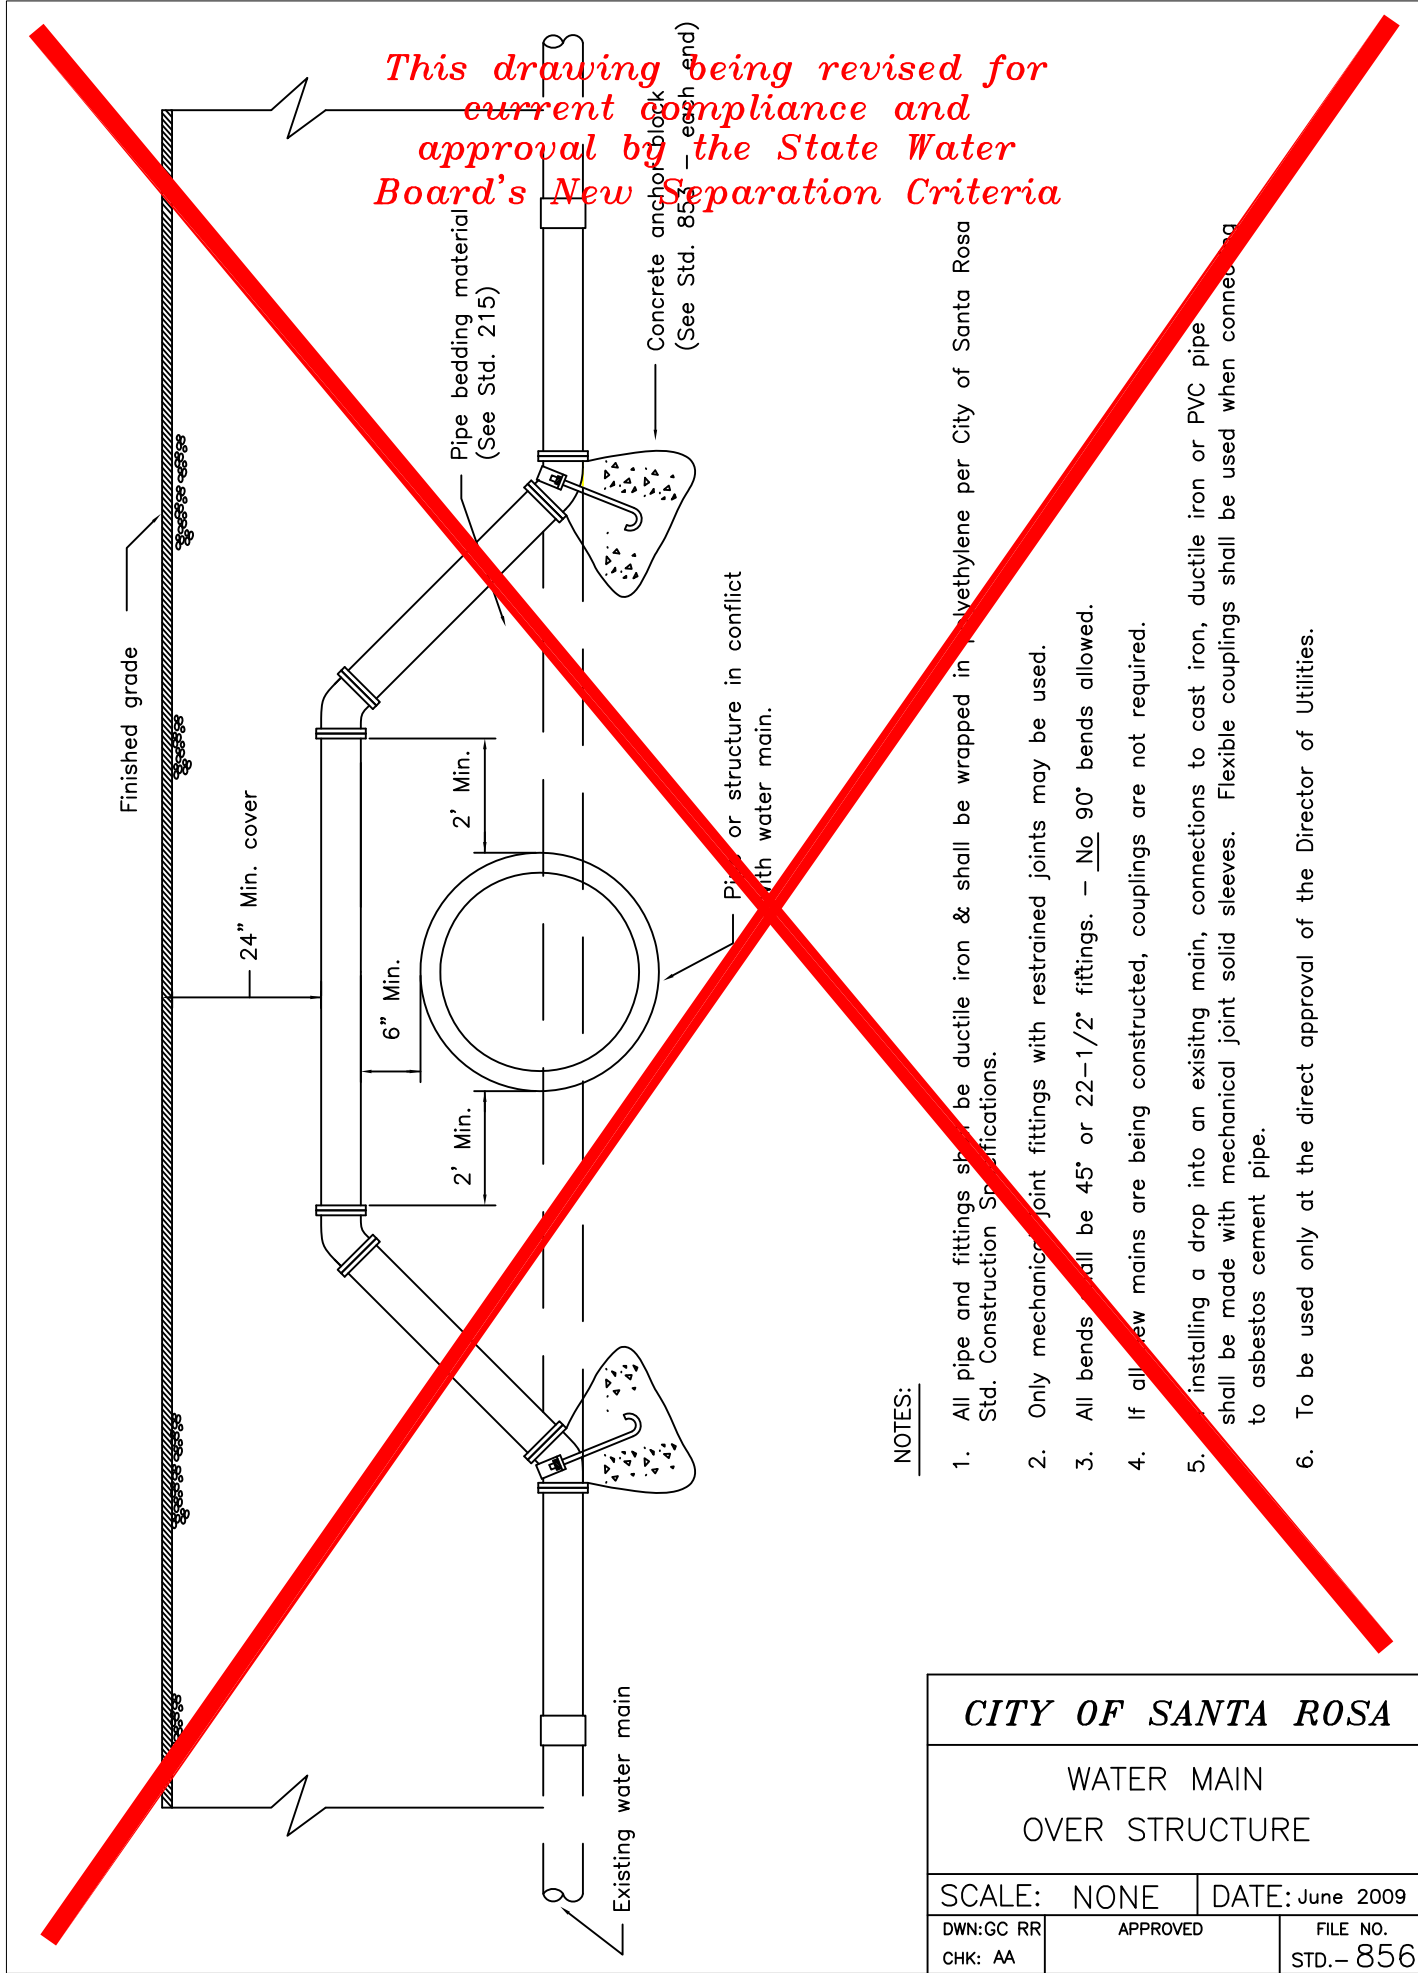

NOTES:

1. All pipe and fittings shall be ductile iron & shall be wrapped in polyethylene per City of Santa Rosa Std. Construction Specifications.
2. Only mechanical joint fittings with restrained joints may be used.
3. All bends shall be 45° or 22-1/2° fittings. - No 90° bends allowed.
4. If all new mains are being constructed, couplings are not required.
5. If installing a drop into an existing main, connections to cast iron, ductile iron or PVC pipe shall be made with mechanical joint solid sleeves. Flexible couplings shall be used when connecting to asbestos cement pipe.
6. To be used only at the direct approval of the Director of Utilities.

CITY OF SANTA ROSA		
WATER MAIN OVER STRUCTURE		
SCALE: NONE	DATE: June 2009	
DWN:GC RR CHK: AA	APPROVED	FILE NO. STD.- 856

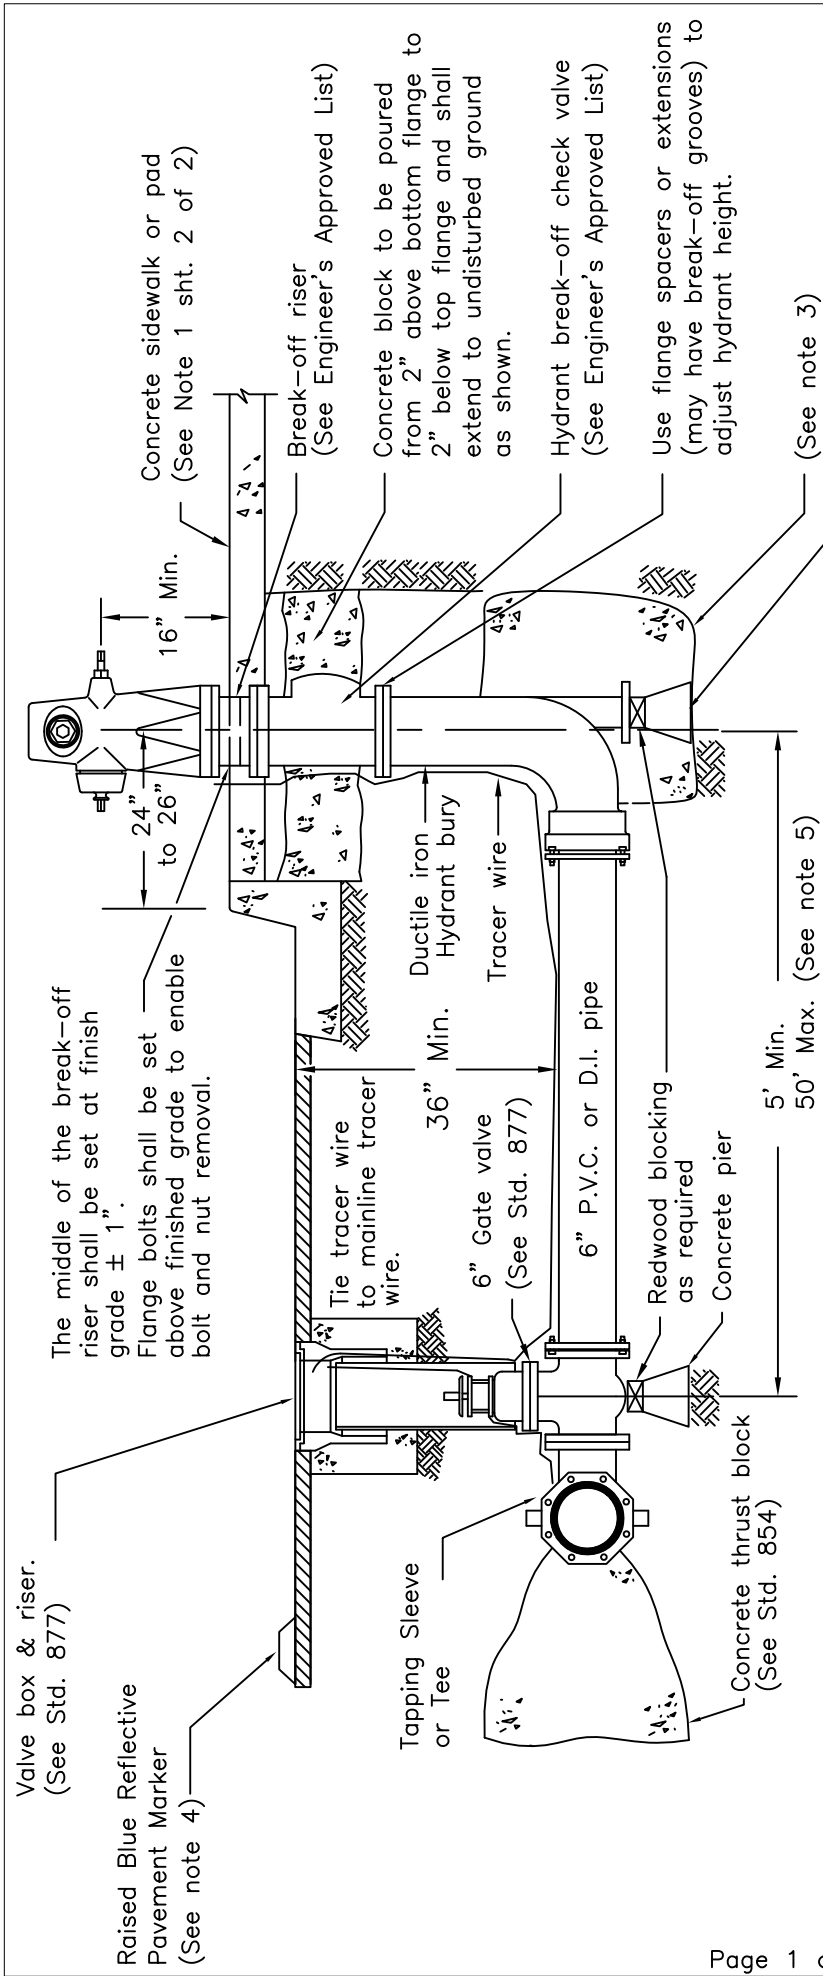

NOTES:


1. Residential fire hydrants have one 2-1/2" & one 4-1/2" outlets. Commercial fire hydrants have one 2-1/2" & two 4-1/2" outlets.
2. Paint fire hydrant in accordance with AWWA Standard Specification C503. (See Engineer's Approved List) The finished paint color shall be white. All damaged paint surfaces shall be corrected by touch up prior to acceptance.
3. Restrained joints are required for all new construction from gate valve to hydrant bury. Thrust blocks are only required where existing services are being modified and restrained joints are not used.
4. Blue reflective pavement markers should be placed 6 inches from the centerline stripe, or approximate center of the pavement where there is no centerline stripe, on the side nearest the fire hydrant.
5. If hydrant lateral length exceeds 50 feet, contact Utilities Engineering.

CITY OF SANTA ROSA			
FIRE HYDRANT and LATERAL			
SCALE: NONE		DATE: June 2009	
DWN: WH RR CHK: AA	APPROVED	FILE NO. STD.- 857	

APPROVED HYDRANTS

(See Engineer's Approved List)



Trim tracer wire 2" above finished grade.

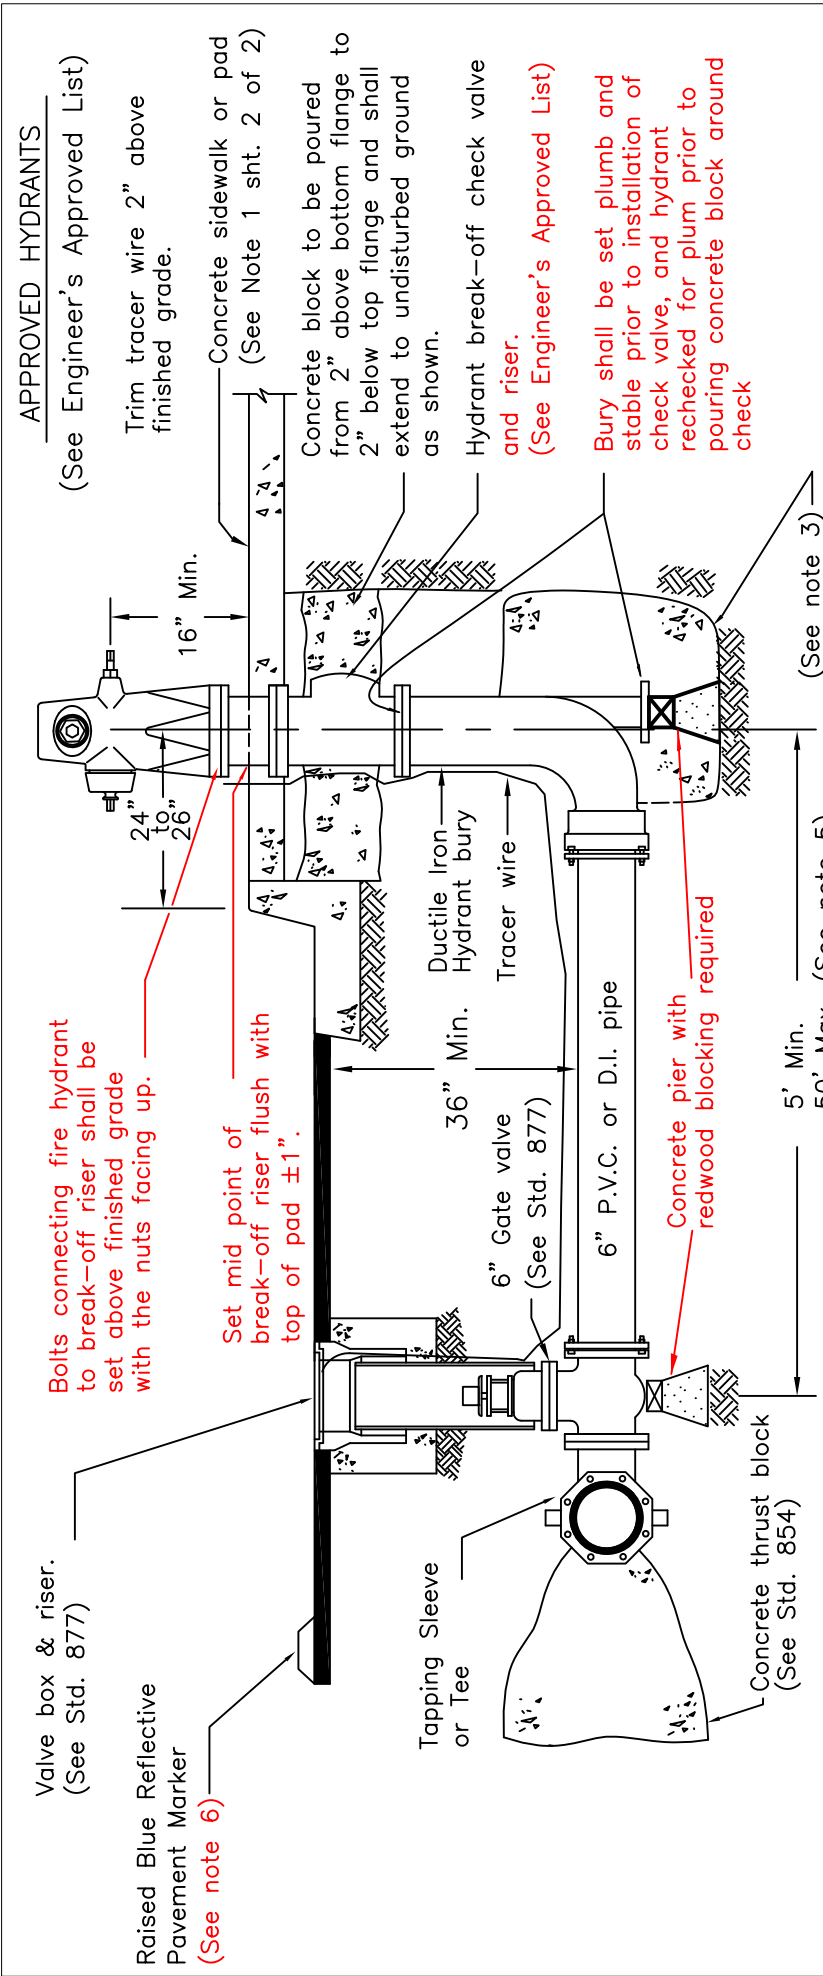

NOTES:

1. Residential fire hydrants shall have one 2-1/2" & one 4-1/2" outlet, and Commercial fire hydrants have one 2-1/2" & two 4-1/2" outlets.
2. Apply two coats of white paint to fire hydrant per Engineer's Approved List, and in accordance with AWWA C503. Any damaged paint surfaces shall be corrected by touch up prior to acceptance.
3. Restrained joints are required for all new construction, from tee or saddle to hydrant bury. Thrust blocks are only required where existing services are being modified and restrained joints alone are not adequate.
4. Flanged riser spools may be installed below check valve to obtain proper grade. Spools used for this purposes shall not have break-off grooves.
5. If proposed hydrant lateral length is greater than 50 feet, contact Water Engineering.
6. Blue reflective raised pavement markers shall be placed 6 inches from the street centerline stripe, or at the approximate centerline of the street where there is no centerline stripe, on the side nearest the fire hydrant. When located near the corner of an intersection, this applies to both streets.
7. Private fire hydrants shall be constructed per NFPA Standards and as approved by Santa Rosa Fire.

CITY OF SANTA ROSA			
PUBLIC FIRE HYDRANT AND LATERAL			
PAGE 1 of 2			
SCALE: NONE		DATE: Apr 2016	
DWN: WH RR CHK: AA	APPROVED	FILE NO. STD.- 857	

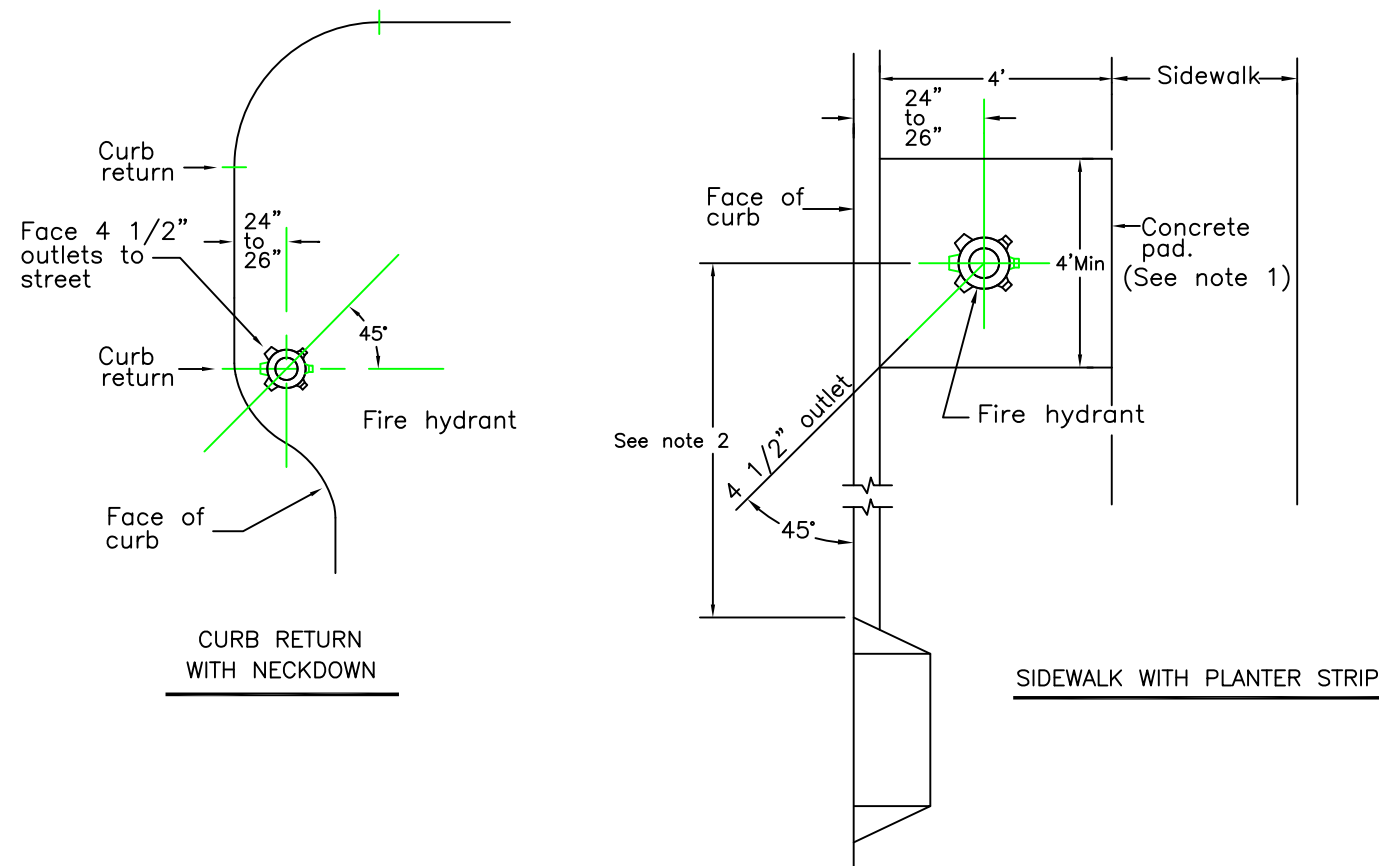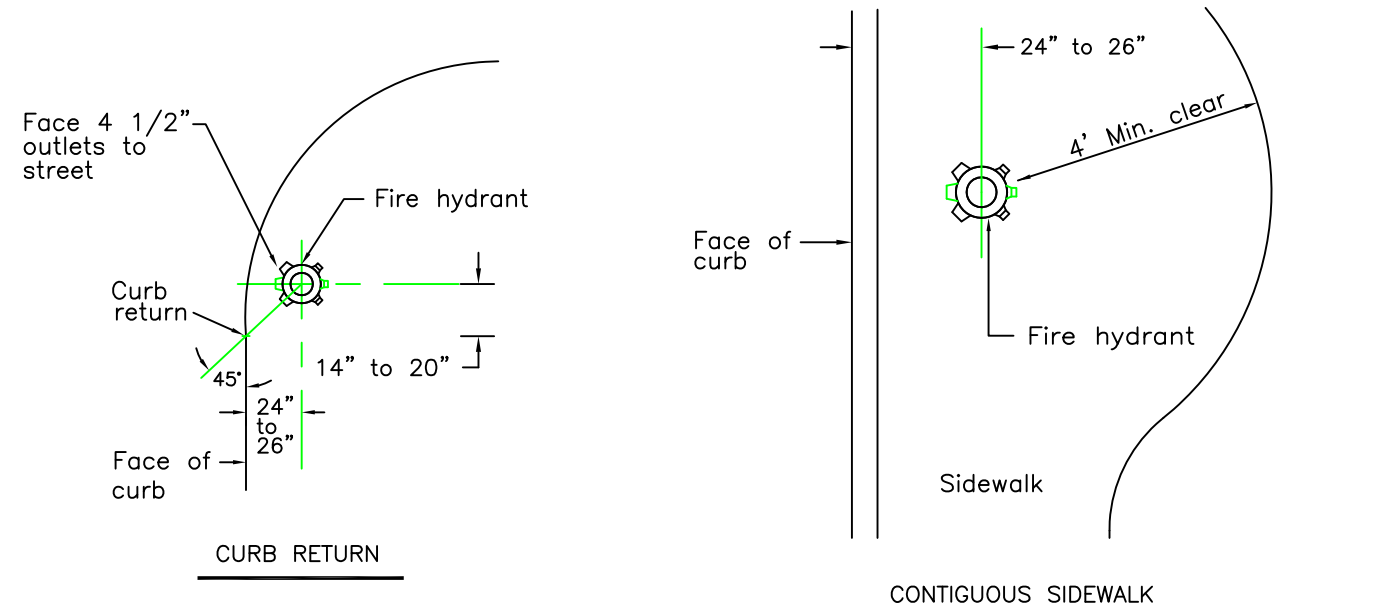



NOTES:

- Where no sidewalk exists, or where hydrant is installed in planter strip, a 4" thick 4' x 4' concrete pad shall be installed.
- Hydrants to be a minimum of 10 feet from driveway approach in commercial or multi-family developments and a minimum of 5 feet from driveway approach in one or two family developments.

CITY OF SANTA ROSA

FIRE HYDRANT and LATERAL LOCATION
PAGE 2 of 2

SCALE: NONE	DATE: June 2009
DWN: WH RR CHK: AA	APPROVED FILE NO. STD.- 857

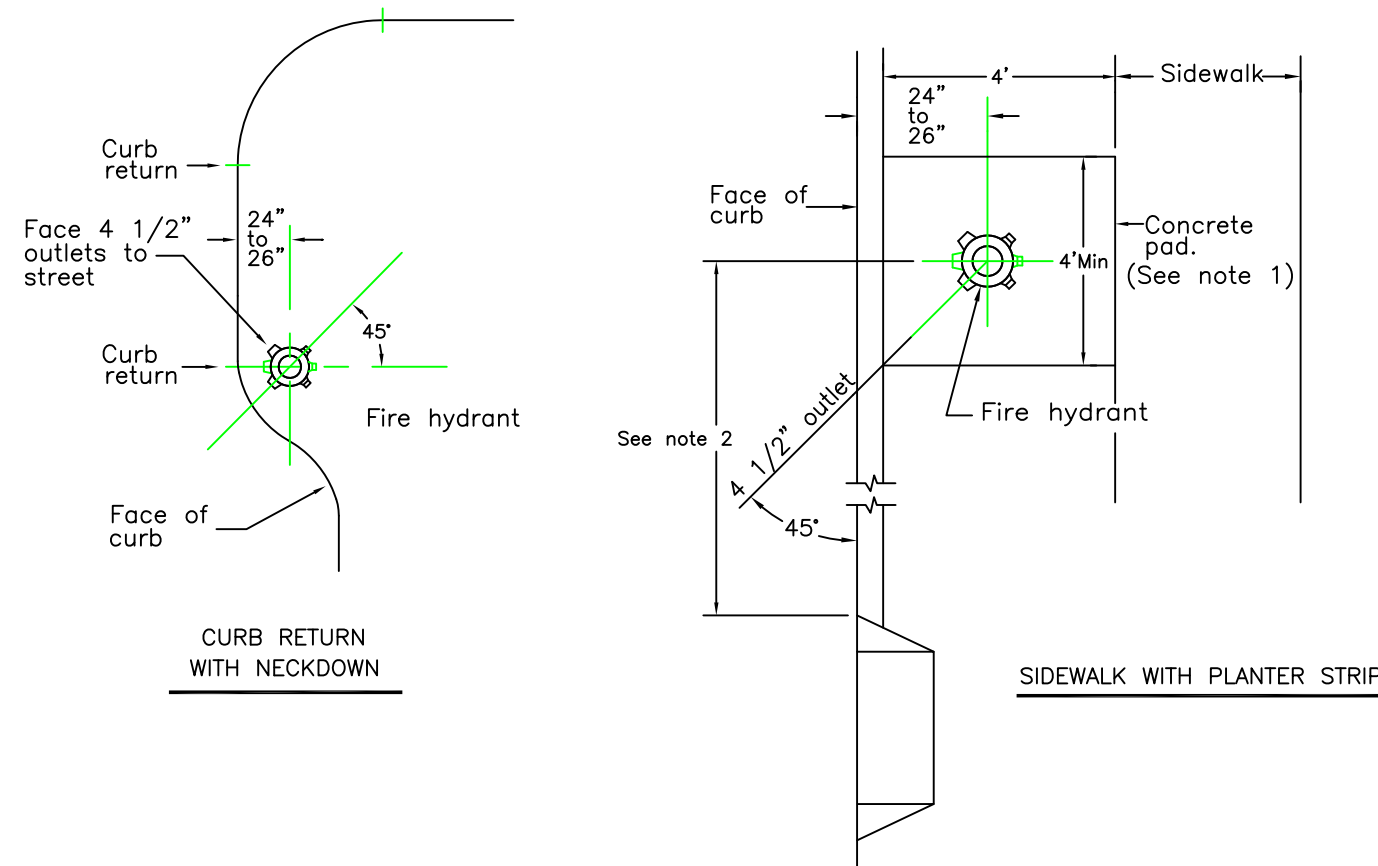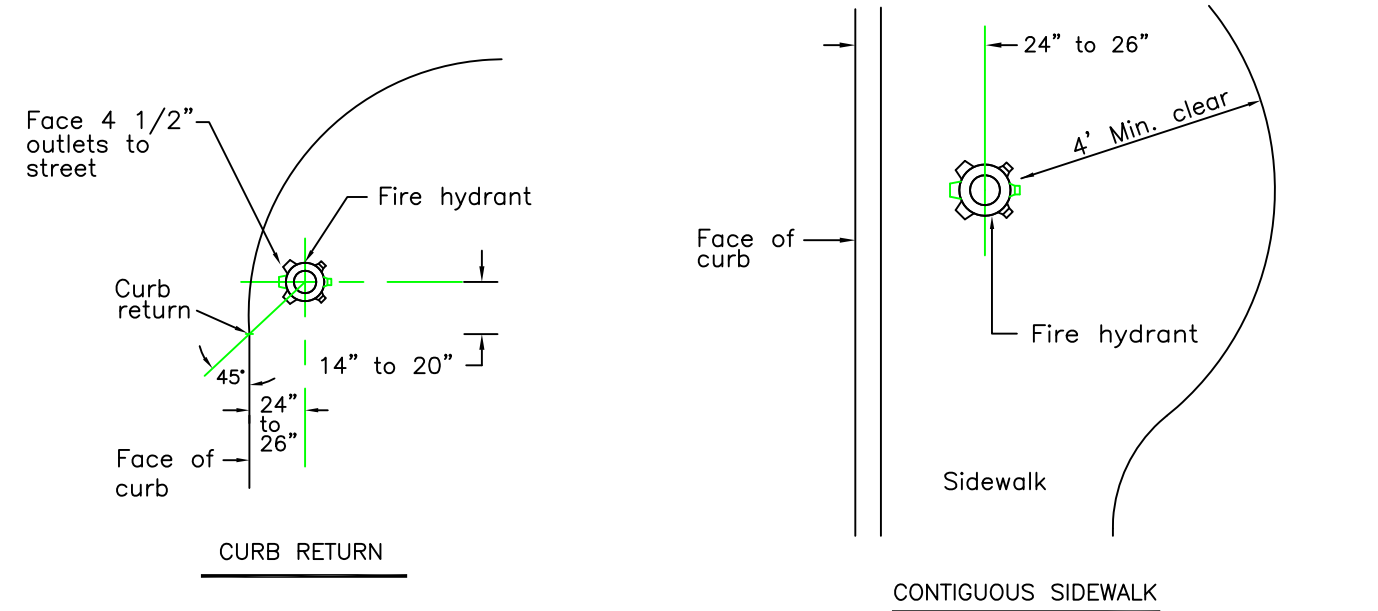

NOTES:


- Where no sidewalk exists, or where hydrant is installed in planter strip, a 4" thick 4' x 4' concrete pad shall be installed.
- Hydrants to be a minimum of 10 feet from driveway approach in commercial or multi-family developments and a minimum of 5 feet from driveway approach in one or two family developments.

CITY OF SANTA ROSA


PUBLIC FIRE HYDRANT AND LATERAL
PAGE 2 of 2

SCALE: NONE	DATE: June 2009
DWN: WH RR CHK: AA	APPROVED FILE NO. STD.- 857

APPROVED HYDRANTS (See Engineer's Approved List)

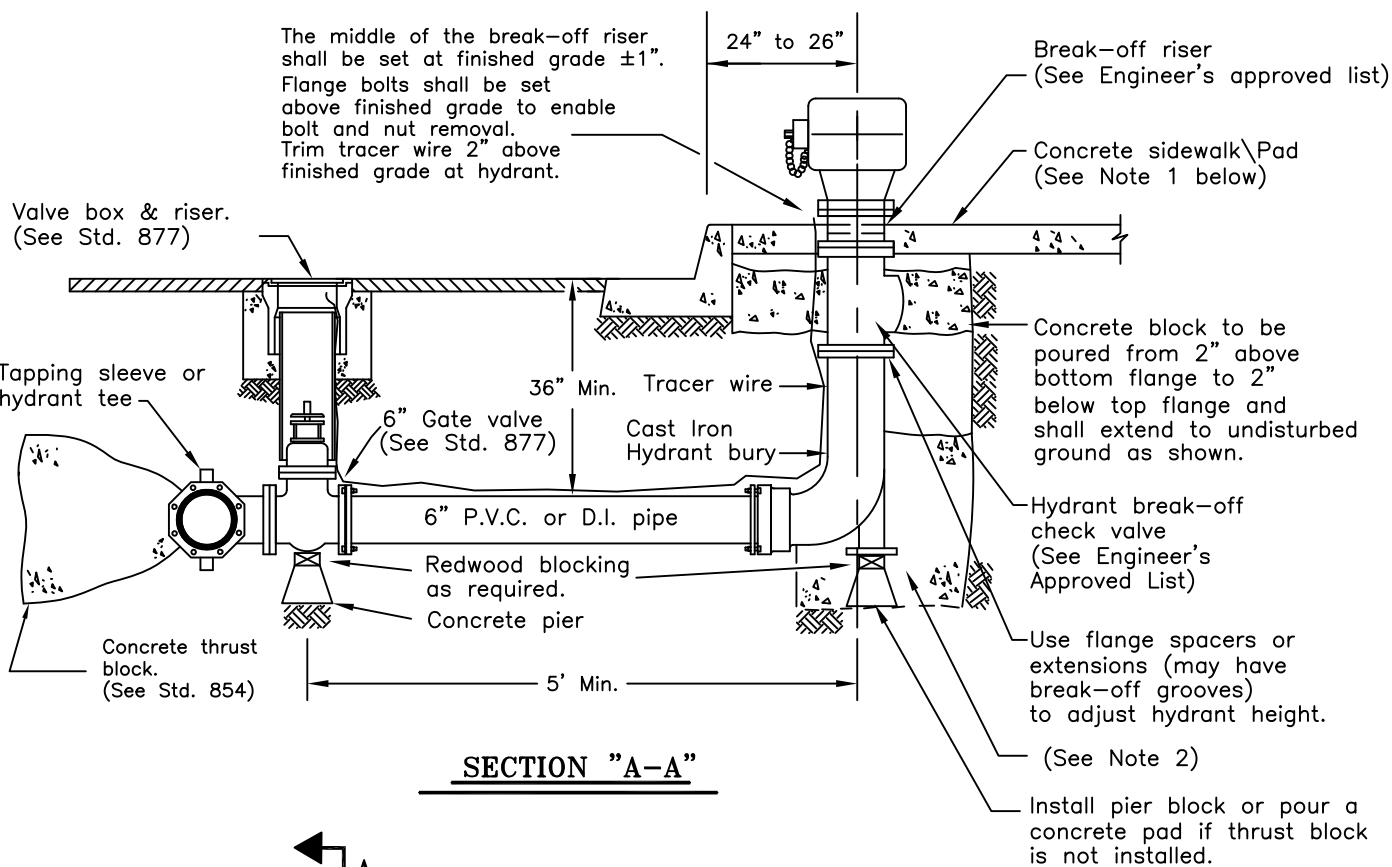

SECTION "A-A"

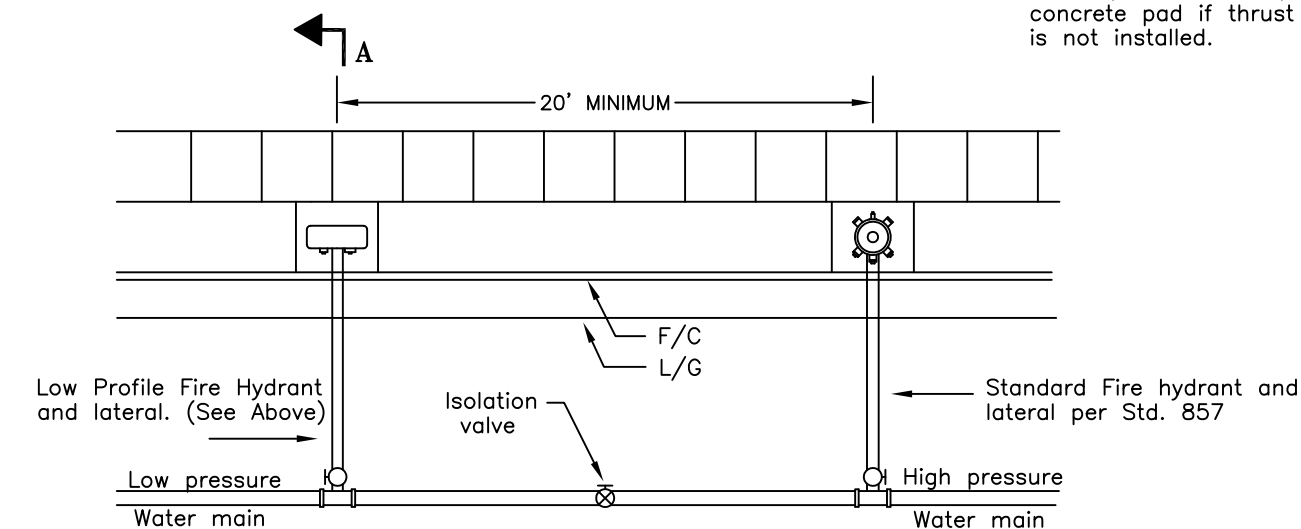

PLAN VIEW


NOTES

- Where no sidewalk exists, or where hydrant is installed in planter strip, a 4" thick 4' x 4' concrete pad shall be installed around the base of the hydrant.
- Restrained joints are required for all new construction from gate valve to hydrant bury. Thrust blocks are only required where existing services are being modified and restrained joints are not used.
- Install min. of 10' from commercial or multi-family driveways and 5' from one or two family driveways.
- Paint fire hydrant in accordance with AWWA Standard Specification C503. (See Engineer's Approved List) The finished paint color shall be white. All damaged paint surfaces shall be corrected by touch up prior to acceptance.


CITY OF SANTA ROSA

PUMPER CONNECTION

SCALE: NONE DATE: June 2009
DWN: TBM RR APPROVED FILE NO.
CHK: AA STD.- 858

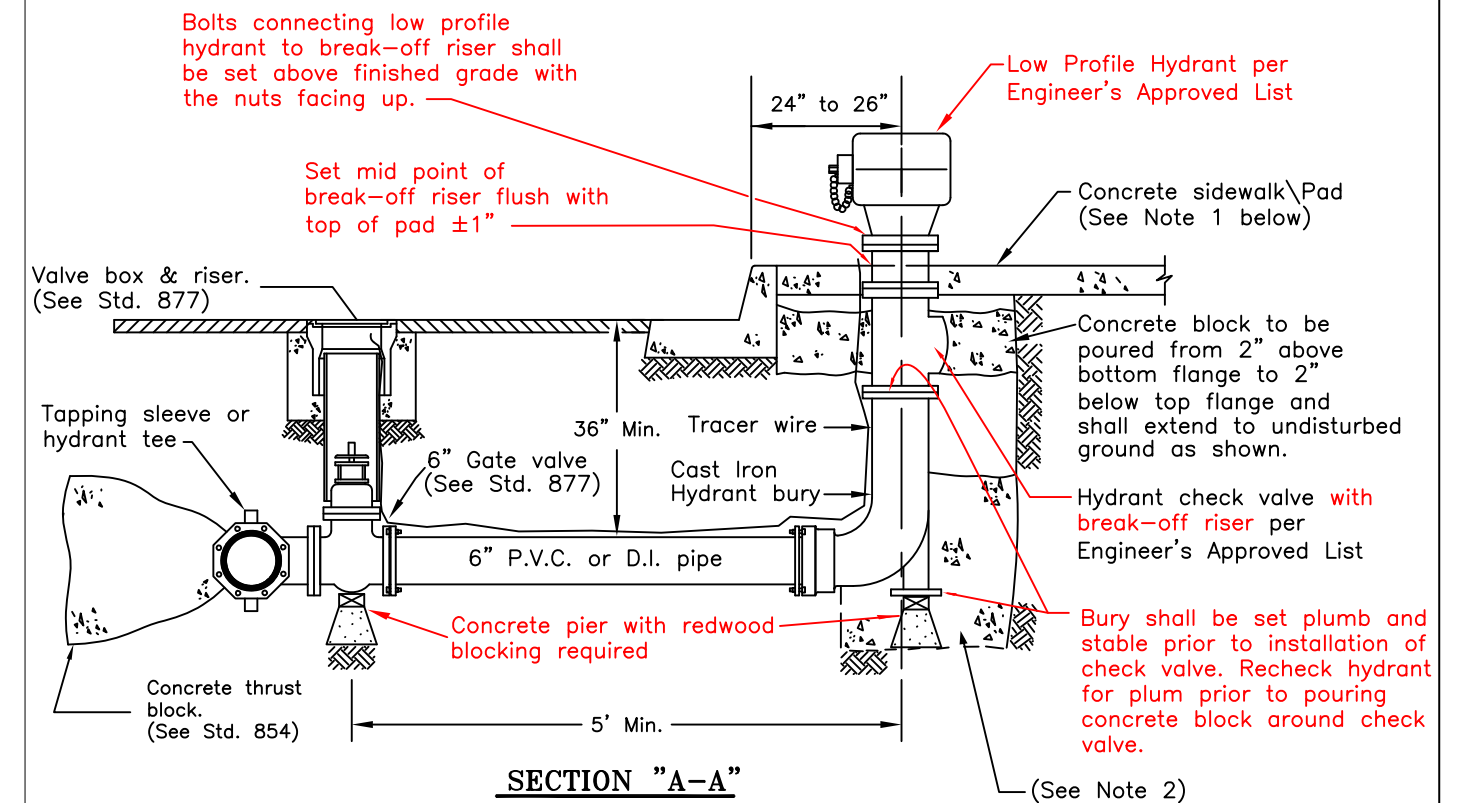

SECTION "A-A"

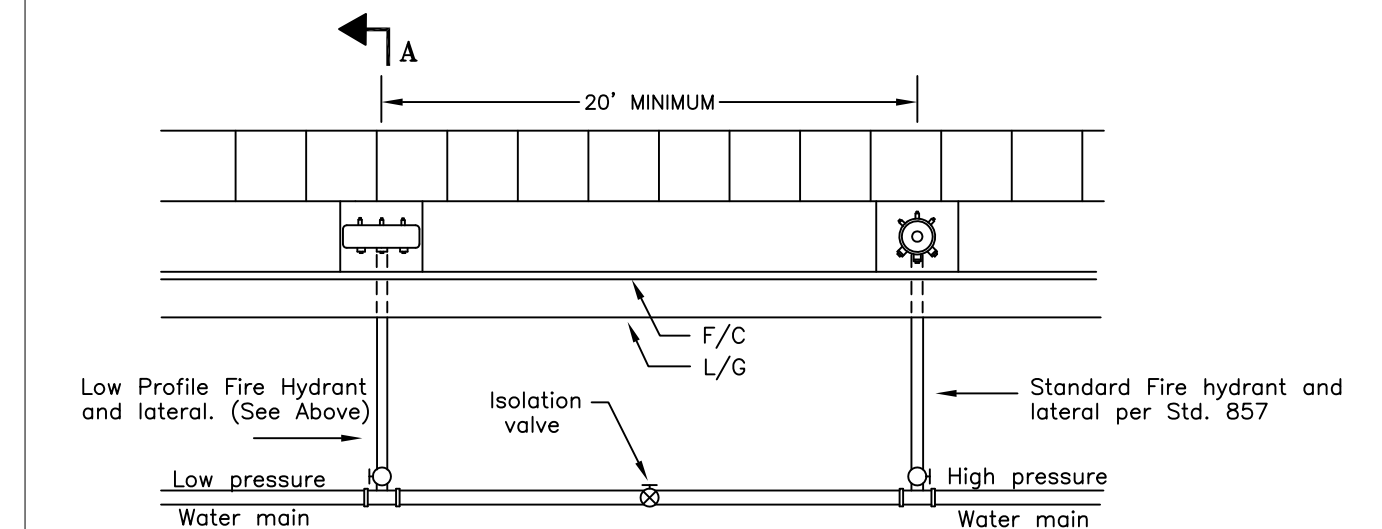

PLAN VIEW


NOTES


- Where no sidewalk exists, or where hydrant is installed in planter strip, a 4" thick 4' x 4' concrete pad shall be installed around the base of the hydrant.
- Restrained joints are required for all new construction, from tee or saddle to hydrant bury. Thrust blocks are only required where existing services are being modified and restrained joints alone are not adequate.
- Flanged riser spools may be installed below check valve to obtain proper grade. Spools used for this purposes shall not have break-off grooves.
- Apply two coats of white paint to fire hydrant per Engineer's Approved List, and in accordance with AWWA C503. Any damaged paint surfaces shall be corrected by touch up prior to acceptance.
- Install min. of 10' from commercial or multi-family driveways and 5' from one or two family driveways.

CITY OF SANTA ROSA

PUMPER CONNECTION

SCALE: NONE DATE: Mar. 2016
DWN: TBM RR APPROVED FILE NO.
CHK: AA STD.- 858

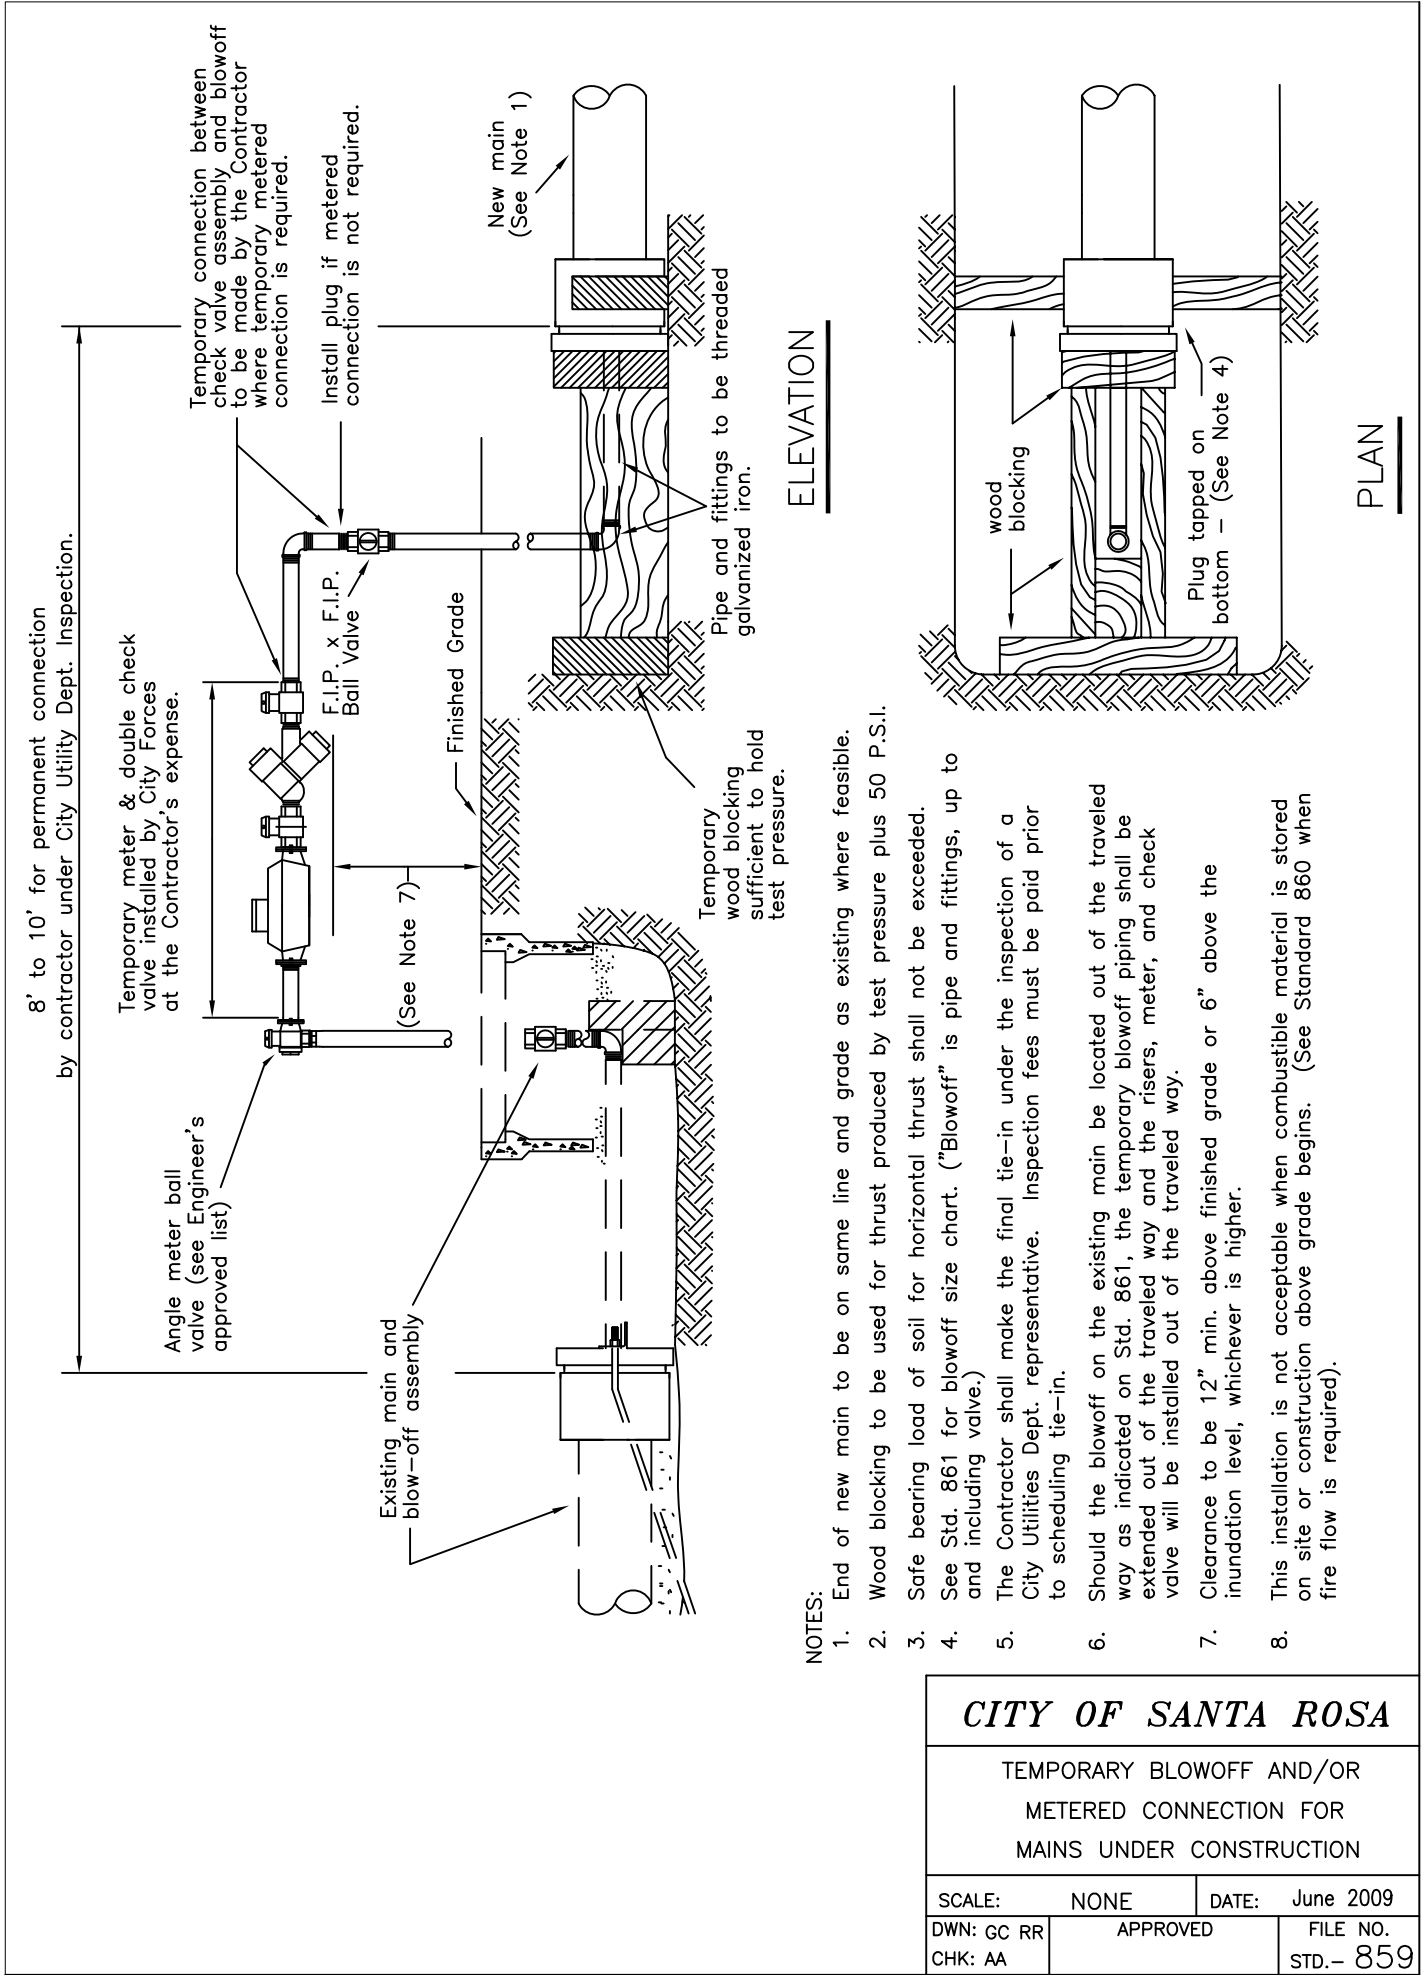


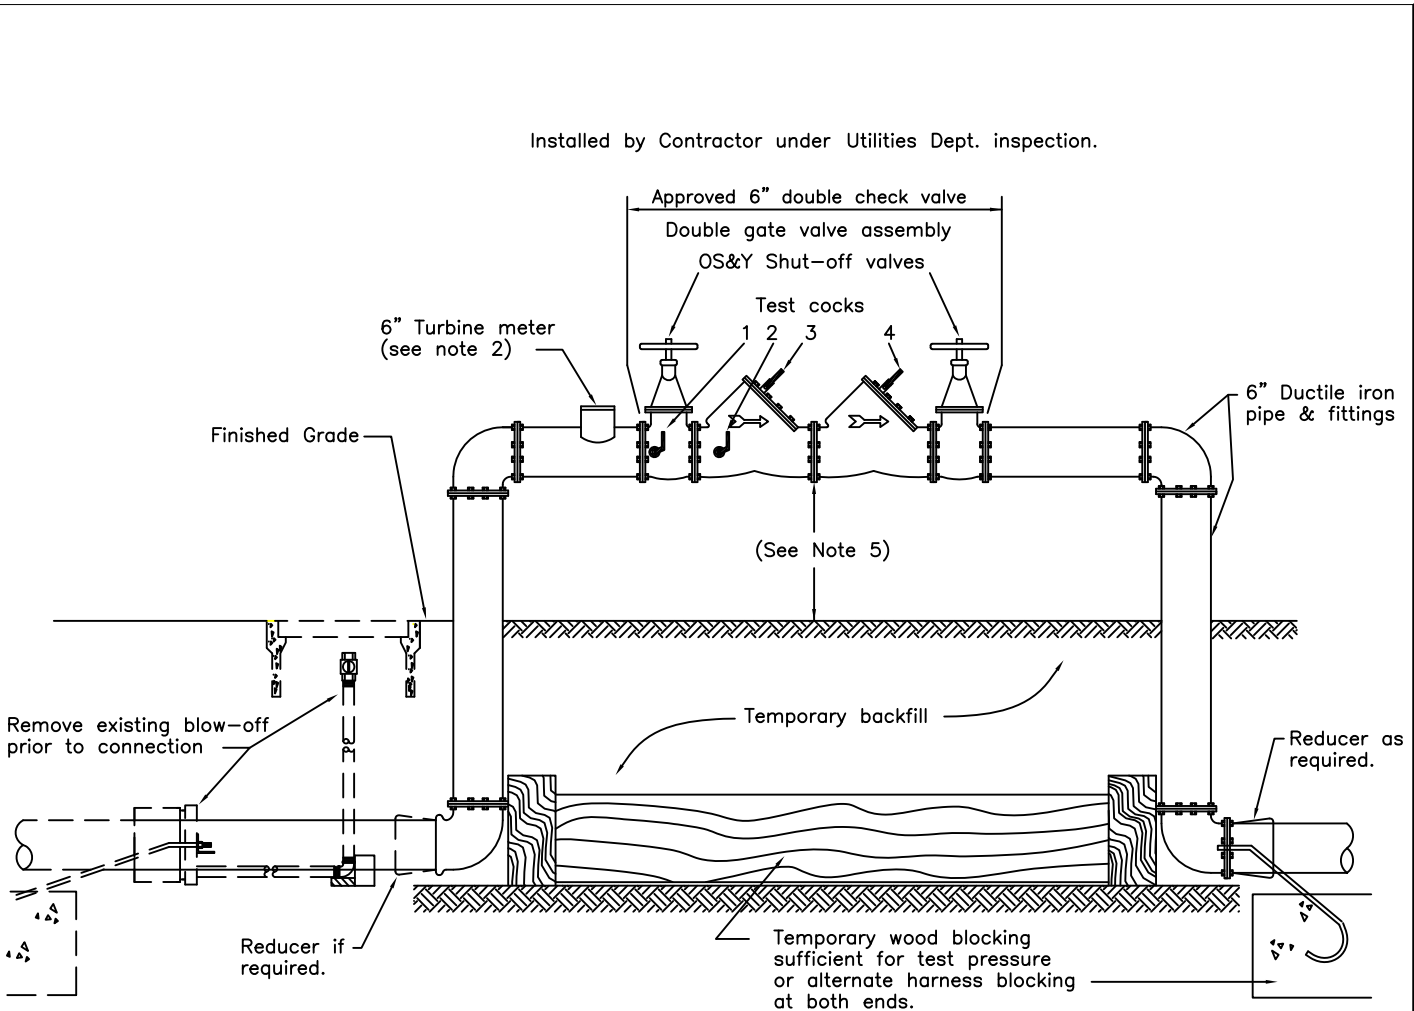

NOTES:

1. This assembly shall be installed when combustible materials will be stored or constructed on-site prior to acceptance of the on-site water main by the City. Fire flow & access must be satisfactory to the City Fire Department.
2. The Contractor shall furnish the 6" meter currently certified by an approved testing facility. The double check valve will be tested and certified on-site by the Utilities Department prior to activating the system. The contractor is responsible for any fees and charges incurred.
3. The Contractor shall make final tie-in under the inspection of a City Utilities Department representative. Inspection fees must be paid prior to scheduling tie-in.
4. Meters to be gallon reading type only.
5. Clearance to be 12" min. above finished grade or 6" above the inundation level, whichever is higher.
6. Fire lines shall be flushed per City Standard Specifications and adequate fire flow provided prior to combustible materials being stored or construction beginning on site.


CITY OF SANTA ROSA		
TEMPORARY METERED CONNECTION WHEN FIRE FLOW IS REQUIRED		
SCALE: NONE	DATE: June 2009	
DWN: GC RR	APPROVED	FILE NO.
CHK: AA		STD.- 860

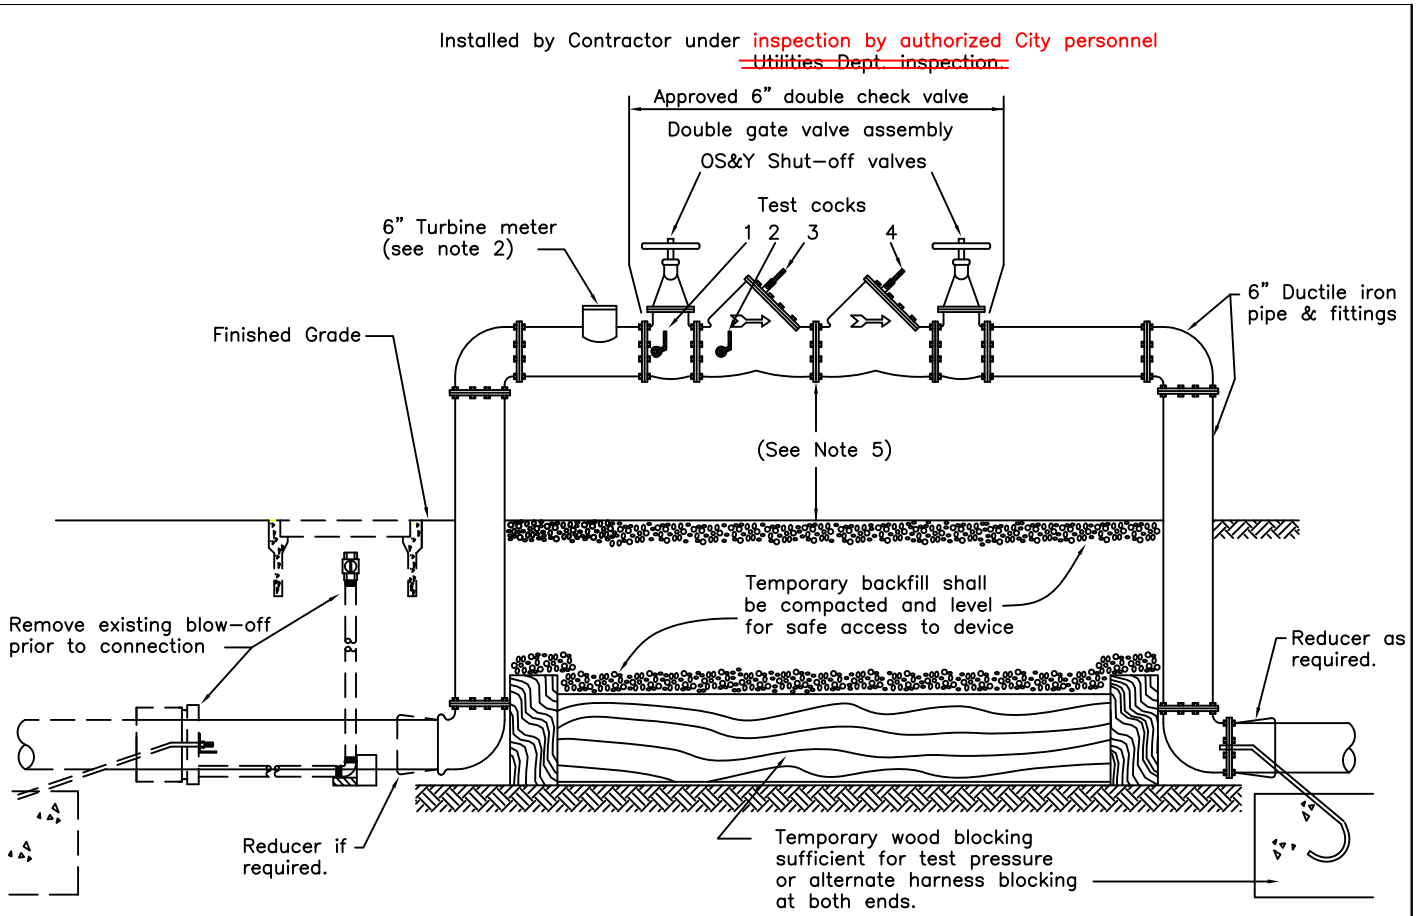

NOTES:

1. This assembly shall be installed when combustible materials will be stored or constructed on-site prior to acceptance of the on-site water main by the City. Fire flow & access must be satisfactory to the City Fire Department.
2. The Contractor shall furnish the 6" meter and double check valve. The meter shall have a current certification by an approved testing facility upon arrival, and the double check valve shall be tested and certified on-site by a Certified Tester off the City's Approved List of Testers. Written proof of a passing certification shall be provided to the City prior to activating the system. The Contractor is responsible for any fees and charges incurred.
3. Tie-in shall be made by the Contractor under inspection by authorized City personnel. Inspection fees must be paid prior to scheduling tie-in.
4. Meters to be gallon units only.
5. Clearance to be 12" min. above finished grade or 6" above the inundation level, whichever is higher.
6. Fire lines shall be flushed per City Standard Specifications and adequate fire flow provided prior to combustible materials being delivered to the site or construction beginning.



CITY OF SANTA ROSA		
TEMPORARY METERED CONNECTION WHEN FIRE FLOW IS REQUIRED		
SCALE: NONE	DATE: Mar. 2016	
DWN: GC RR	APPROVED	FILE NO.
CHK: AA		STD.- 860

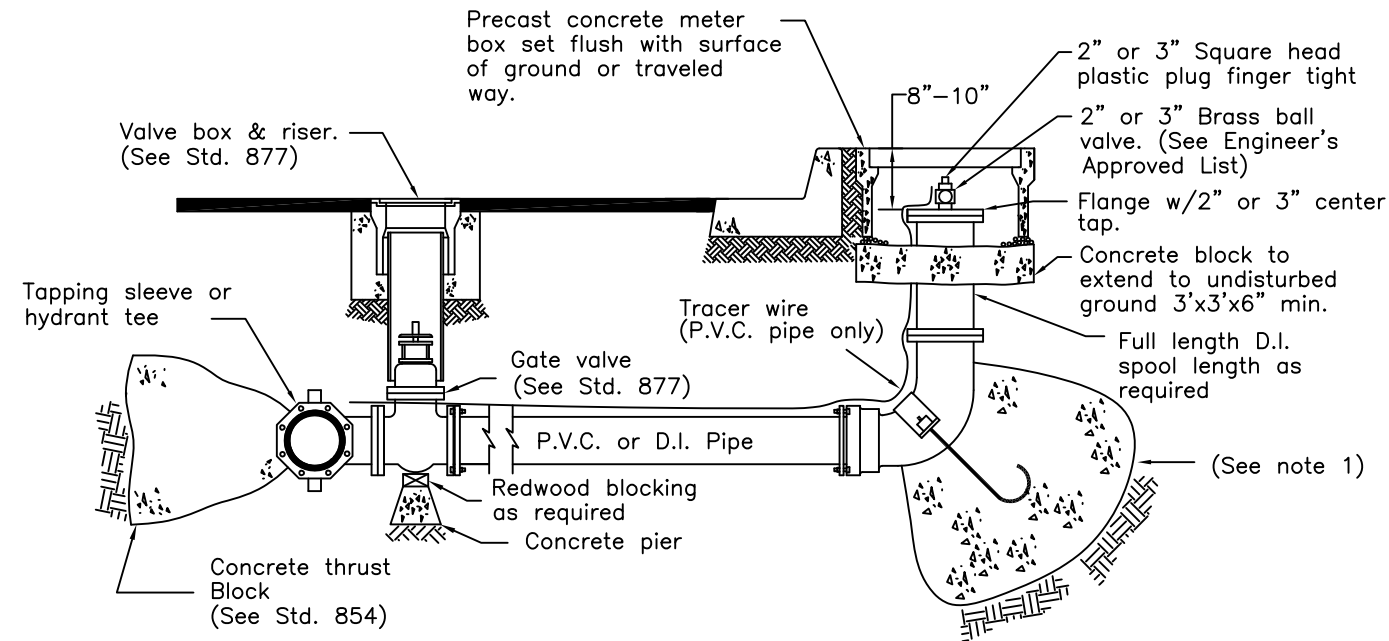

NOTES

Approved Box & Cover
(See Engineer's Approved List)

1. Restrained joints are required for all new construction from gate valve to 90° bend. Thrust blocks are only required where existing services are being modified and restrained joints are not used.
2. Blowoff piping to be the same size as the main.

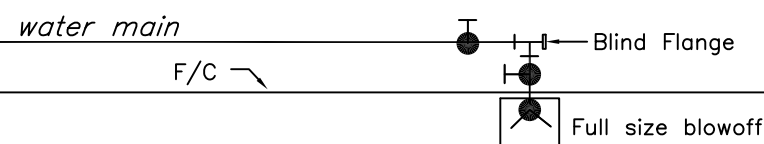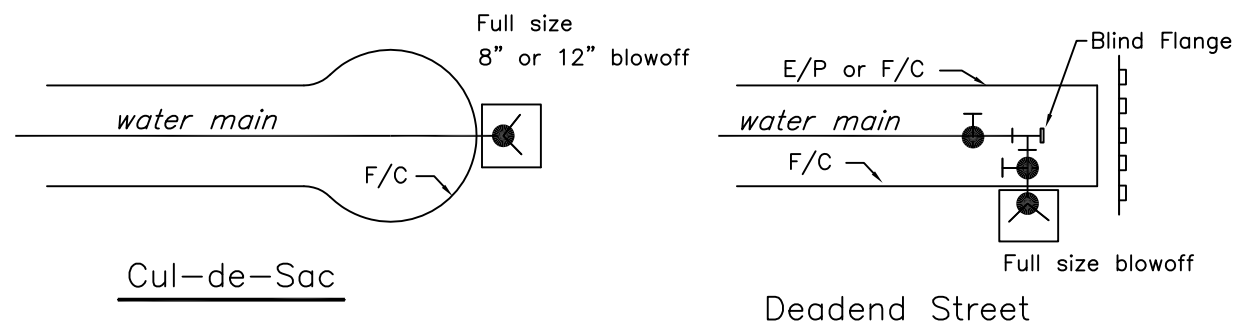


Thru-Street

CITY OF SANTA ROSA

FULL SIZE BLOW-OFF



SCALE: NONE	DATE: Sept. 2002
DWN: GC CHK: WH	APPROVED FILE NO. STD.- 862

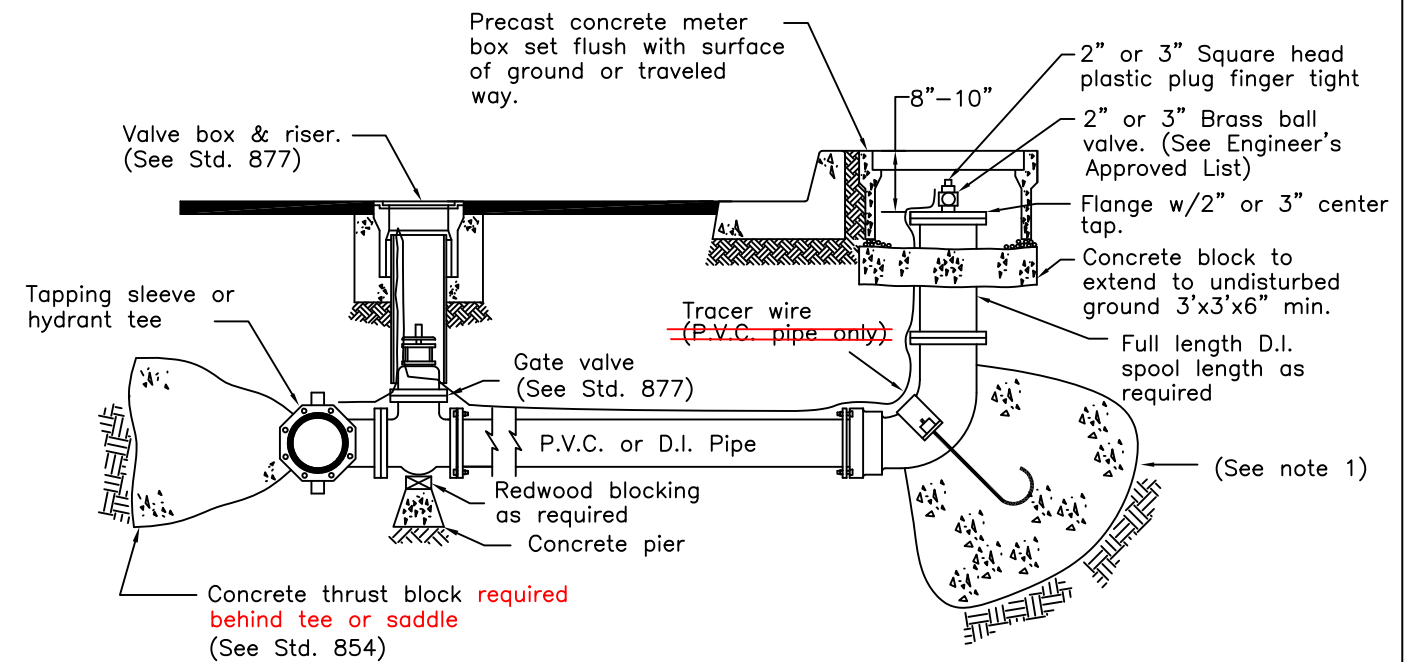

NOTES

Approved Box & Cover
(See Engineer's Approved List)

1. Restrained joints are required for all new construction from ~~tee or saddle~~ to 90° bend. Thrust blocks are only required where existing services are being modified and restrained joints are not used.
2. ~~Elbow and riser pipe~~ to be the same size as the main.
~~Blowoff piping~~

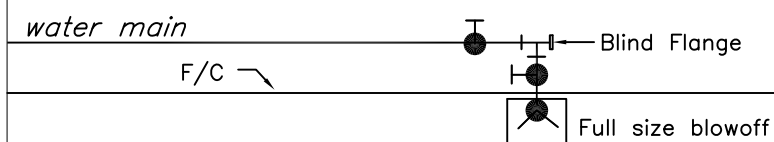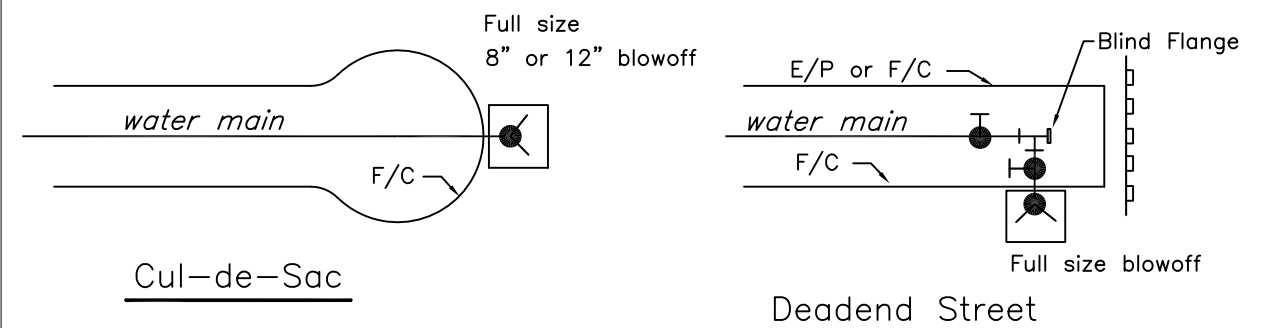


Thru-Street

CITY OF SANTA ROSA

FULL SIZE BLOW-OFF

SCALE: NONE	DATE: Mar. 2016
DWN: GC CHK: WH	APPROVED FILE NO. STD.- 862

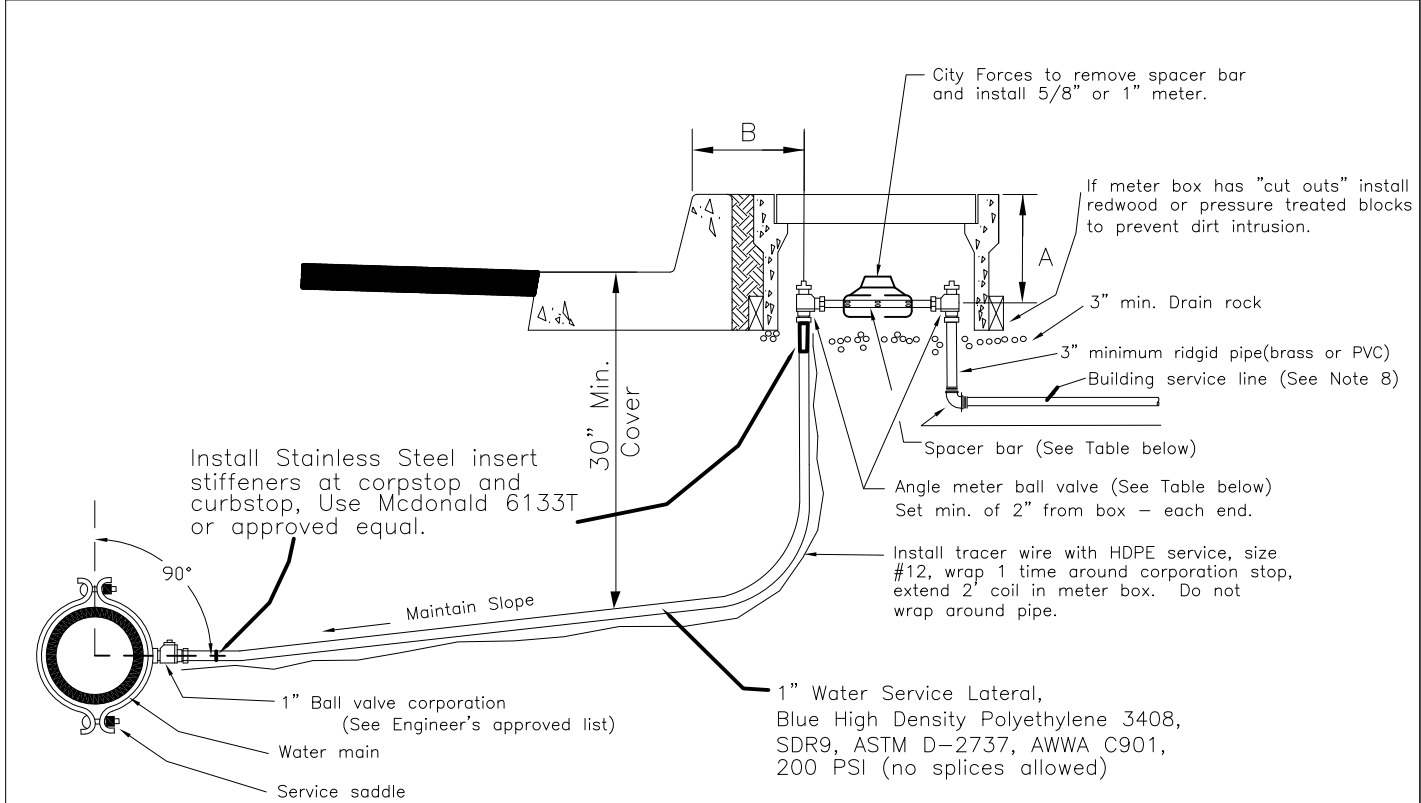

NOTES

1. Unless otherwise specified on the plans, provide for 5/8" x 3/4" meter installation for residential uses and 1" meter installation for commercial uses.
2. Unless otherwise specified on the plans, install 1" service tubing for residential and commercial uses. For unknown commercial uses, install 2" service per standard 865.
3. Contractor to install schl. 80 PVC spacer with threads on both ends. Drill 1/2" Ø holes @ 2" O.C. through pipe after testing service lateral.
4. Meter box must be set flush with top of curb or sidewalk, if applicable.
5. Prior to meter set, address to be clearly marked on topside lip of meter box with permanent felt marker.
6. Traffic loading box & lid to be installed in all driveways or locations where vehicular traffic may occur, and where specified on plans.
7. At a minimum, extend building service line to 12" beyond back of meter box and cap. Where sidewalk is being installed by the public improvements contractor, extend building service line to 12" beyond back of sidewalk and cap. If permanent meter set is requested prior to completion of property side plumbing, a minimum of 10' of the building service line must be installed with a hose bib on a riser above finished grade. Domestic supply line to building shall meet building department requirements.
8. If connecting to a backflow device use Type "K" hard temper copper or threaded brass between the meter and backflow device. If existing line to be connected is galvanized use dielectric protection.

METER SETTING ASSEMBLY PARTS LIST

METER SIZE	VALVES	SPACER BAR (SEE NOTE 3)
5/8" x 3/4"	1"x3/4" Angle meter ball valve (See Engineer's approved list)	1"Ø x 7-3/4" Schl. 80 PVC Pipe
1"	1"x1" Angle meter ball valve (See Engineer's approved list)	1-1/4"Ø x 11" Schl. 80 PVC Pipe

METER BOXES AND COVERS

(See Engineer's approved list)

APPROVED TAPPING
SERVICE SADDLES


(See Engineer's approved list)

SIZE OF METER	DIMENSION	
	A	B
5/8" x 3/4"	10"	12"-14"
1"	10"	12"-14"

CITY OF SANTA ROSA		
1 " HIGH DENSITY POLYETHYLENE WATER SERVICE LATERAL FOR 1" METERS		
SCALE:	NONE	DATE: June 2009
DWN: GC RR	APPROVED	FILE NO.
CHK: AA		STD.863-A

METER BOXES AND COVERS

(See Engineer's approved list)

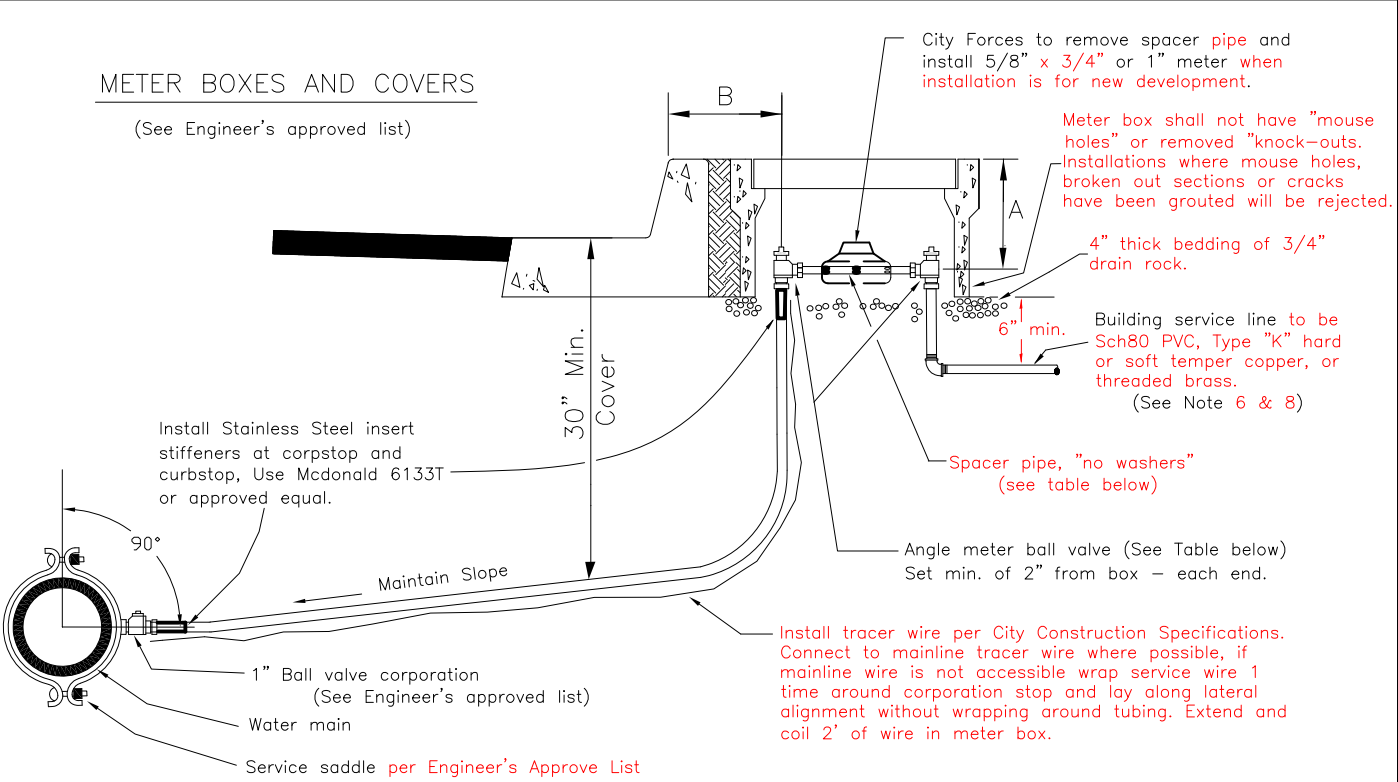

NOTES


1. Unless otherwise specified plumb 1" service lateral for a 5/8" x 3/4" meter when use is for residential, or a 1" meter when use is for commercial. Where plans show a service lateral to be installed without specifying a City Standard, the Contractor shall request direction from the Engineer.
2. Bedding material shall be compacted to a minimum 90% relative compaction prior to tubing installation.
3. For new development, after testing the service lateral the Contractor shall install a Sch.80 PVC spacer with N.I.P. threads on both ends. The spacer shall have 1/2" Ø holes drilled through the pipe @ 2" O.C.
4. Meter box shall be set flush with surrounding surfaces.
5. Prior to setting water meter for new development projects the Water Department requires the service address to be clearly marked on the topside lip of meter box with a permanent felt marker.
6. If connecting to a backflow device see specific backflow standard for piping requirements between meter and device. If existing line to be connected to is galvanized, use a dielectric fitting.
7. Water services and meter boxes shall be located away from driveways where possible. Installations in driveways, or anywhere vehicular traffic may occur, must be approved by the Director of Santa Rosa Water. If so approved, the box & lid shall have at a minimum an AASHTO H20 rating. All meter box and lid installations shall be per manufacturer's recommendations, and shall comply with all applicable City Standards.
8. When not extending to a building, or connecting to a backflow device or an existing lateral, the Contractor shall extend the service lateral to a minimum of 12" behind future sidewalk or to back of P.U.E. and cap watertight. There shall be no bends or fittings under sidewalk and/or concrete planter strip. If the permanent service meter is requested prior to completion of the property side plumbing, at least 10 linear feet of service lateral shall be installed at a location safe from traffic and construction activities, and extended vertically to a minimum 24" above grade with a 3/4" hose bib on the end.
9. If 1" installation setup calls for 5/8" x 3/4" meter, Contractor to supply approved 1" x 3/4" meter adapters.
10. Where multiple boxes are set side-by-side see spacing requirements on Standard 887.

METER SETTING ASSEMBLY PARTS LIST

METER SIZE	VALVES	SPACER BAR (SEE NOTE 3)
5/8" x 3/4"	1" service x 3/4" meter angle ball valve per Engineer's approved list	1"Ø x 7-3/4" Schl. 80 PVC Pipe
1"	1" service x 1" meter angle ball valve per Engineer's approved list	1-1/4"Ø x 11" Schl. 80 PVC Pipe

SIZE OF METER	DIMENSION	
	A	B
5/8" x 3/4"	9"-11"	14"-15"
1"	9"-11"	14"-15"

CITY OF SANTA ROSA		
1 " HIGH DENSITY POLYETHYLENE WATER SERVICE LATERAL FOR 5/8" x 3/4" or 1" METERS		
SCALE:	NONE	DATE: JUNE 2016
DWN: GC DK	APPROVED	FILE NO.
CHK: RS		STD.863-A

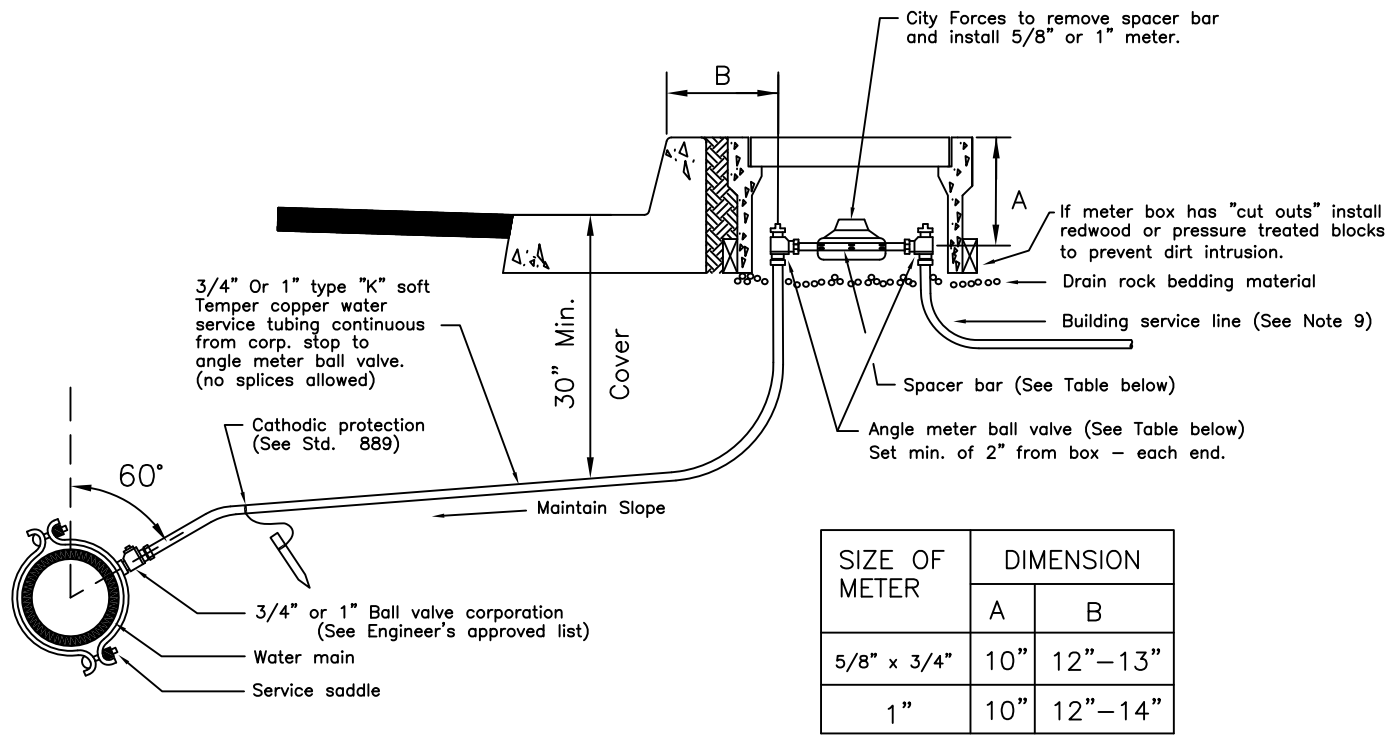

NOTES

- Service lateral bedding material to be compacted to minimum 90% relative compaction prior to installation of copper service tubing.
- Unless otherwise specified on the plans, provide for 5/8" x 3/4" meter installation for residential uses and 1" meter installation for commercial uses.
- Unless otherwise specified on the plans, install 3/4" service tubing for residential uses and 1" service tubing for commercial uses. For unknown commercial uses, install 2" service per standard 865.
- Contractor to install schl. 80 PVC spacer with threads on both ends. Drill 1/2" Ø holes @ 2" O.C. through pipe after testing service lateral.
- Meter box must be set flush with top of curb or sidewalk, if applicable.
- Prior to meter set, address to be clearly marked on topside lip of meter box with permanent felt marker.
- For 5/8" x 3/4" meter installation on a 1" water service lateral, use a reducing adapter.
- Traffic loading box & lid to be installed in all driveways or locations where vehicular traffic may occur, and where specified on plans.
- At a minimum, extend building service line to 12" beyond back of meter box and cap. Where sidewalk is being installed by the public improvements contractor, extend building service line to 12" beyond back of sidewalk and cap. If permanent meter set is requested prior to completion of property side plumbing, a minimum of 10' of the building service line must be installed with a hose bib on a riser above finished grade.

METER SETTING ASSEMBLY PARTS LIST

METER SIZE	VALVES	SPACER BAR (SEE NOTE 4)
5/8" x 3/4"	(See Engineer's approved list)	1"Ø x 7-3/4" Schl. 80 PVC Pipe
1"	(See Engineer's approved list)	1-1/4"Ø x 11" Schl. 80 PVC Pipe

METER BOXES AND COVERS


(See Engineer's approved list)

APPROVED TAPPING SERVICE SADDLES

(See Engineer's approved list)

METER BOXES AND COVERS

(See Engineer's approved list)

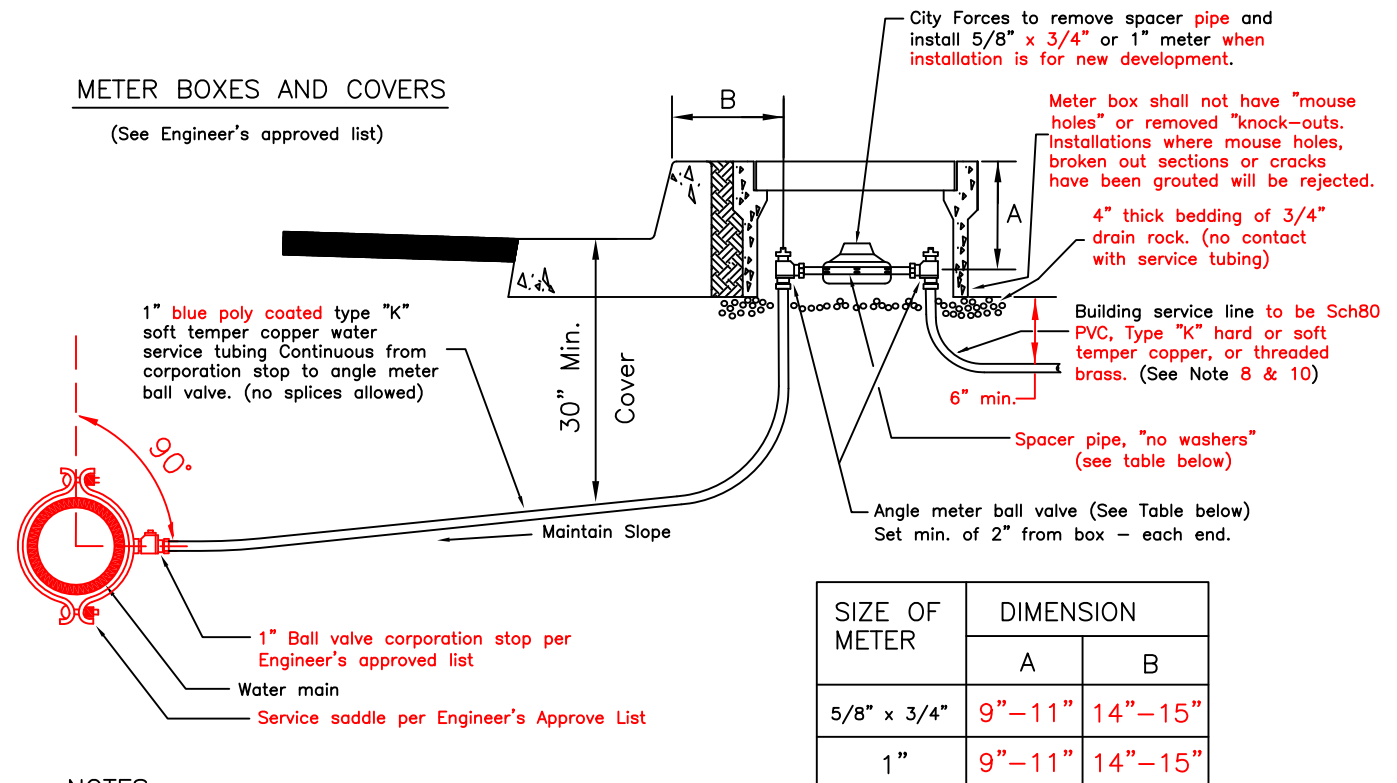

NOTES

- This standard shall only be used where copper tubing is already specified for use, or when specifically called for on the plans or other contract documents. Where no specific standard is called out, install 1" service laterals per City Standard 863-A.
- Bedding material shall be compacted to a minimum 90% relative compaction prior to tubing installation.
- Unless otherwise specified plumb 1" service lateral for a 5/8" x 3/4" meter when use is for residential, or a 1" meter when use is for commercial.
- Where copper tubing and this standard is specifically called for, 1" tubing shall be installed for both residential and commercial uses. If copper tubing is called for without a specific City Standard specified, the Contractor shall request direction from the Engineer prior to ordering material.
- For new development, after testing the service lateral the Contractor shall install a Sch.80 PVC spacer with N.I.P. threads on both ends. The spacer shall have 1/2" Ø holes drilled through the pipe @ 2" O.C.
- Meter box shall be set flush with surrounding surfaces.
- Prior to setting water meter on new development projects the Water Department requires the service address to be clearly marked on the topside lip of meter box with a permanent felt marker.
- If connecting to a backflow device see specific backflow standard for piping requirements between meter and device. If existing line to be connected to is galvanized, use a dielectric fitting.
- Water services and meter boxes shall be located away from driveways where possible. Installations in driveways, or anywhere vehicular traffic may occur, must be approved by the Director of Santa Rosa Water. If so approved, the box & lid shall have a AASHTO H20 rating. All meter box and lid installations shall be per manufacturer's recommendations, and shall comply with all applicable City Standards.
- When not extending to a building or connecting to a backflow or an existing lateral, the Contractor shall extend the service lateral to a minimum of 12" behind future sidewalk or to back of P.U.E. and cap watertight. There shall be no bends or fittings under sidewalk and/or concrete planter strip. If the permanent service meter is requested prior to completion of the property side plumbing, at least 10 linear feet of service lateral shall be installed at a location safe from traffic and construction activities, and extended vertically to a minimum 24" above grade with a 3/4" hose bib on the end.
- If 1" installation setup calls for 5/8" x 3/4" meter, Contractor to supply approved 1" x 3/4" meter adapters.
- Where multiple boxes are set side-by-side see spacing requirements on Standard 887.


METER SETTING ASSEMBLY PARTS LIST

METER SIZE	VALVES	SPACER PIPE (SEE NOTE 5)
5/8" x 3/4"	1" service x 3/4" meter angle ball per Eng's approved list	1"Ø x 7-3/4" Schl. 80 PVC Pipe
1"	1" service x 1" meter angle ball per Eng's approved list	1-1/4"Ø x 11" Schl. 80 PVC Pipe

CITY OF SANTA ROSA

1" COPPER
WATER SERVICE LATERAL
FOR 5/8" x 3/4" & 1" METERS

SCALE: NONE		DATE: JULY 2016	
DWN: GC	APPROVED		FILE NO.
CHK:			STD. 863-B

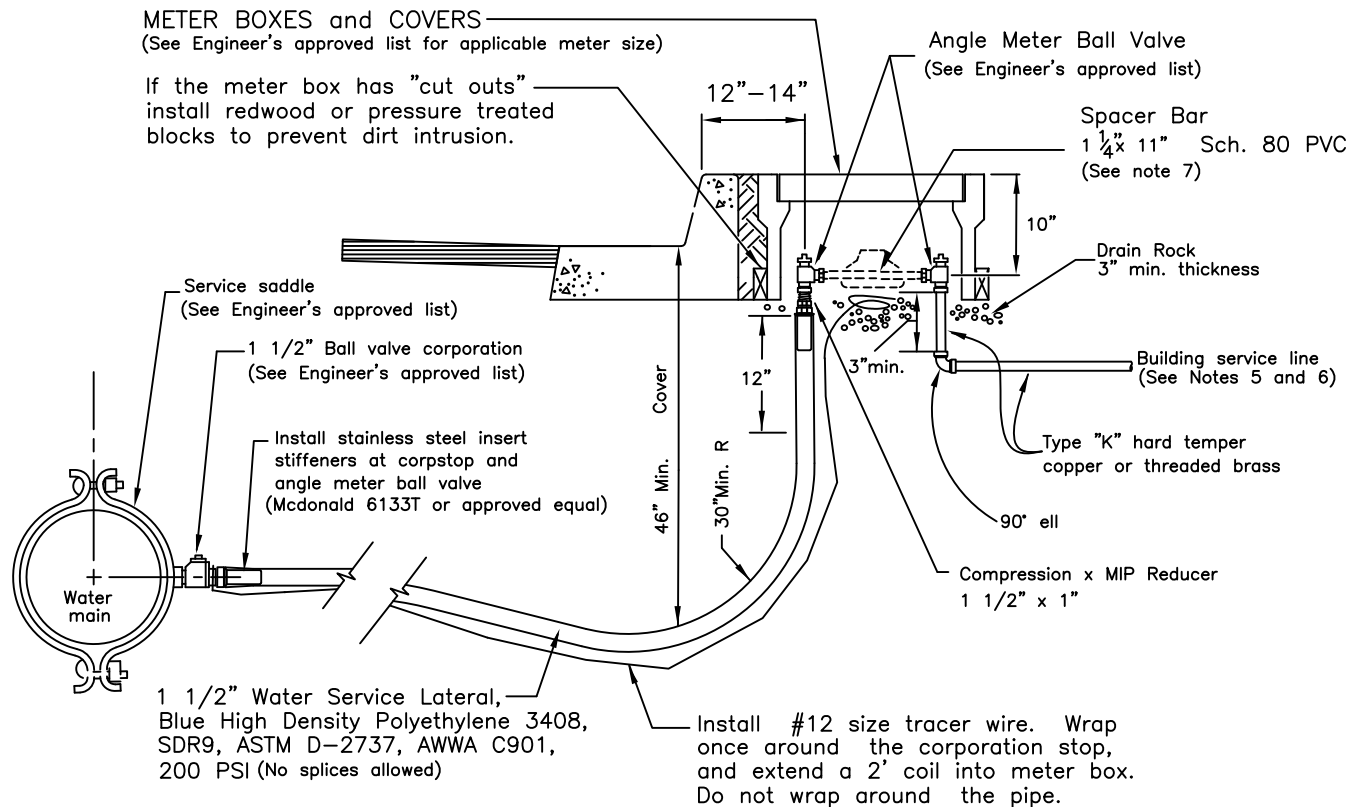

NOTES

1. Service lateral bedding material to be compacted to minimum 90% relative compaction prior to installation of Polyethylene service tubing.
2. Unless otherwise specified on the plans, provide for 1" meter installation.
3. Meter box must be set flush with top of curb or sidewalk, if applicable. The address shall be clearly marked on top of meter box with a permanent felt marker prior to requesting meter set.
4. Traffic loading box & lid to be installed in all driveways or locations where vehicular traffic may occur, and where specified on plans.
5. At a minimum, extend building service line to 12" beyond back of meter box and cap. Where sidewalk is being installed by the public improvements contractor, extend building service line to 12" beyond back of sidewalk and cap. If permanent meter set is requested prior to completion of property side plumbing, a minimum of 10' of the building service line must be installed with a hose bib on a riser above finished grade. Domestic supply line to building shall meet building department requirements.
6. If connecting to a backflow device use Type "K" hard temper copper or threaded brass pipe between the meter and the backflow device. If existing line to be connected to is galvanized, provide dielectric protection.
7. Contractor must install a Sch. 80 PVC spacer bar, without washers and threaded at each end. Drill 1/2" dia. holes through the spacer bar at 2" O.C. City forces will remove spacer bar and install meter.

CITY OF SANTA ROSA


1 1/2" HIGH DENSITY POLYETHYLENE
WATER SERVICE LATERAL
for 1" METERS

SCALE: NONE DATE: June 2009

DWN: RR APPROVED FILE NO.
CHK: AA STD. 863-C

METER BOXES and COVERS
(See Engineer's approved list)

1" F.I.P. x Meter angle ball valve per
Engineer's approved list. (typ. of 2)

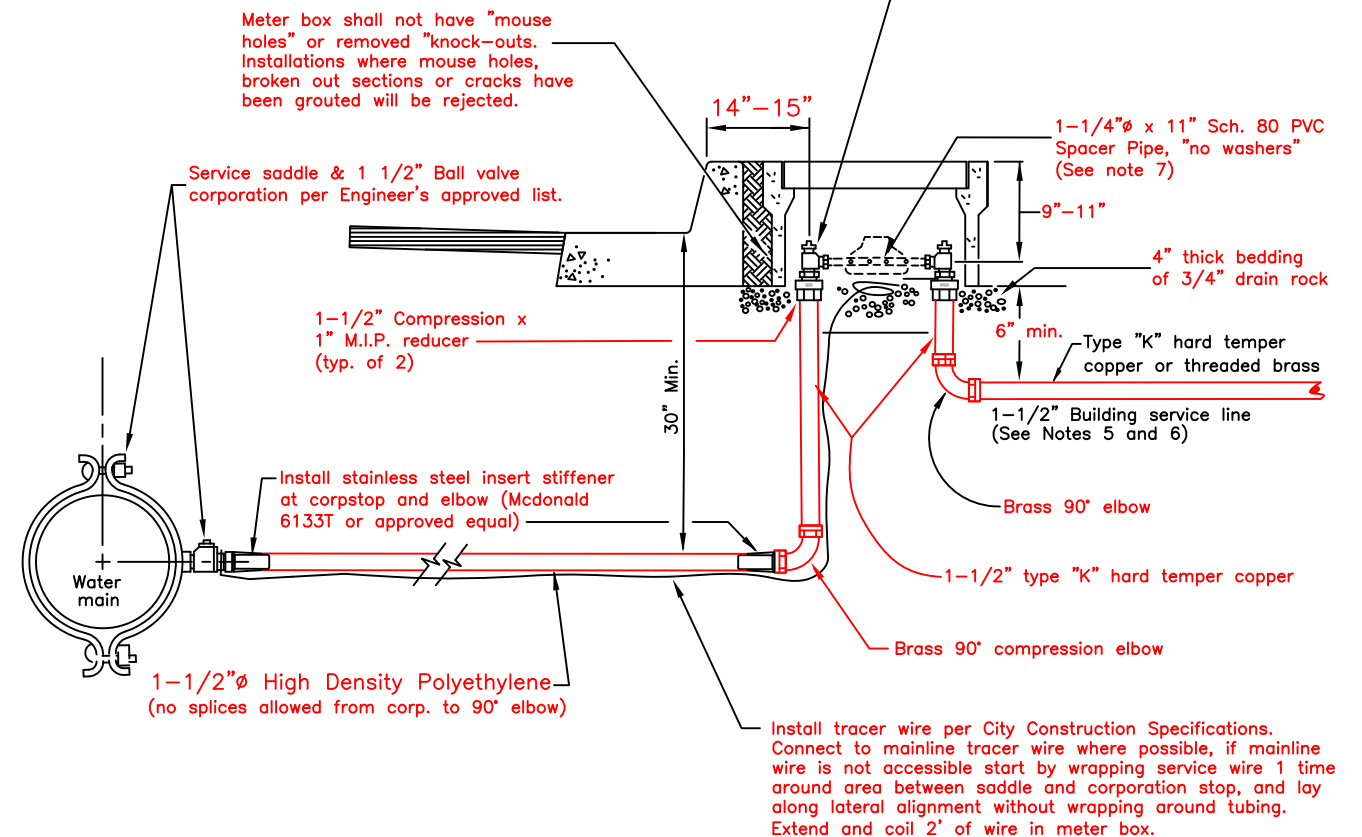

NOTES


1. Service lateral bedding material to be compacted to minimum 90% relative compaction prior to installation of Polyethylene service tubing.
2. Unless otherwise specified on the plans, plumb 1-1/2" service for a 1" meter installation.
3. Meter box must be set flush with surrounding serfaces. Service address shall be clearly marked on top of meter box lip with a permanent felt marker prior to requesting meter set.
4. Water services and meter boxes shall be located away from driveways where possible. Installations in driveways, or anywhere vehicular traffic may occur, must be approved by the Director of Santa Rosa Water. If so approved, the box & lid shall have a AASHTO H20 rating. All meter box and lid installations shall be per manufacturer's recommendations, and shall comply with all applicable City Standards.
5. Building Service line material shall be type "K" hard temper copper or threaded brass for at least the first 10 linear feet, 12" behind proposed sidewalk or to the back of P.U.E., whichever is farther. When not extending the service line to a building or connecting to a backflow device or an existing lateral, the Contractor shall cap the end watertight. There shall be no bends or fittings under curb, gutter, concrete planter strip or sidewalk unless first approved by the Director of Santa Rosa Water. If the permanent service meter is requested prior to completion of the property side plumbing, the service line shall be at least 10 linear feet in length and installed at a location safe from traffic and construction activities, and extended vertically to a minimum 24" above grade with a 3/4" hose bib on the end.
6. If connecting to a backflow device see specific backflow standard for piping requirements between meter and device. If existing line to be connected to is galvanized, use a dielectric fitting.
7. For new development, after testing the service lateral, the Contractor shall install a Sch.80 PVC spacer with N.I.P. threads on both ends. The spacer shall have 1/2" ϕ holes drilled through the pipe @ 2" O.C.
8. If installation calls for 5/8" x 3/4" meter, Contractor to supply approved 1" x 3/4" meter adapters.
9. Where multiple boxes are set side-by-side see spacing requirements on Standard 887.

CITY OF SANTA ROSA


1-1/2" HIGH DENSITY POLYETHYLENE
WATER SERVICE LATERAL
for 1" METERS

SCALE: NONE DATE: JUNE 2016

DWN: RR APPROVED FILE NO.
CHK: AA STD. 863-C

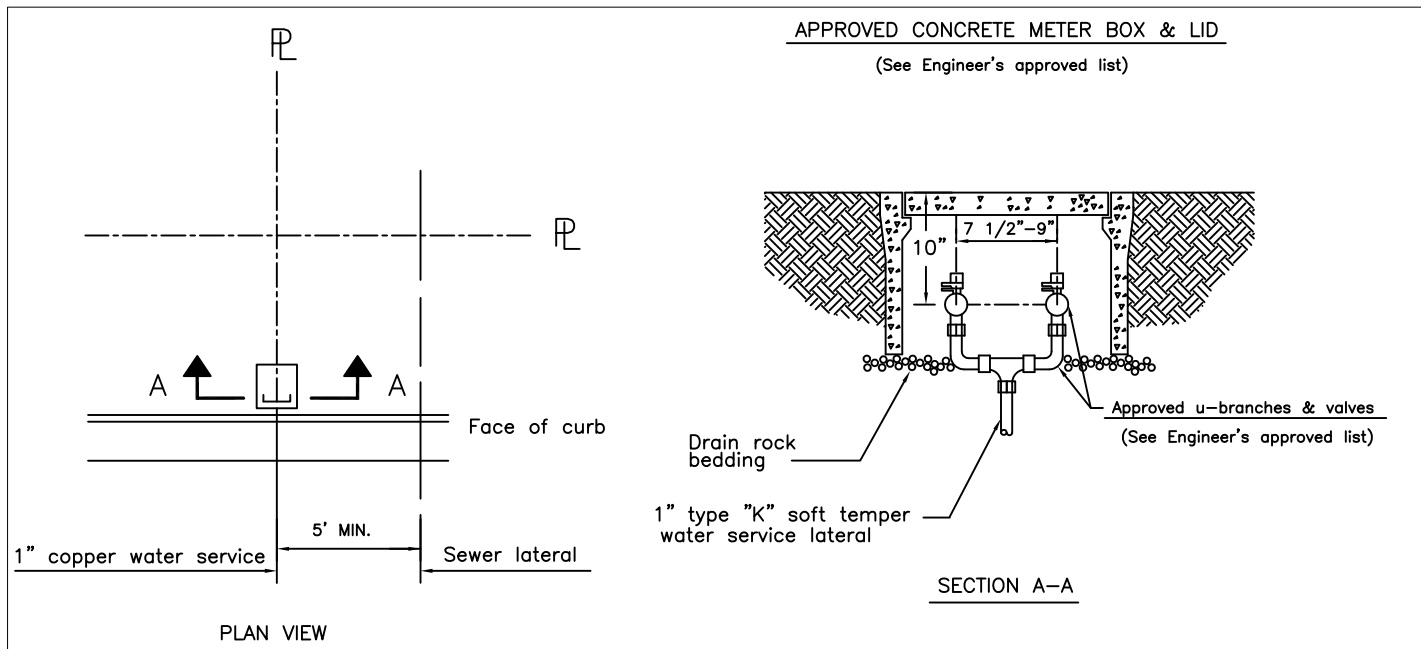

SINGLE METER BOX INSTALLATION FOR DUAL 3/4" MANIFOLD

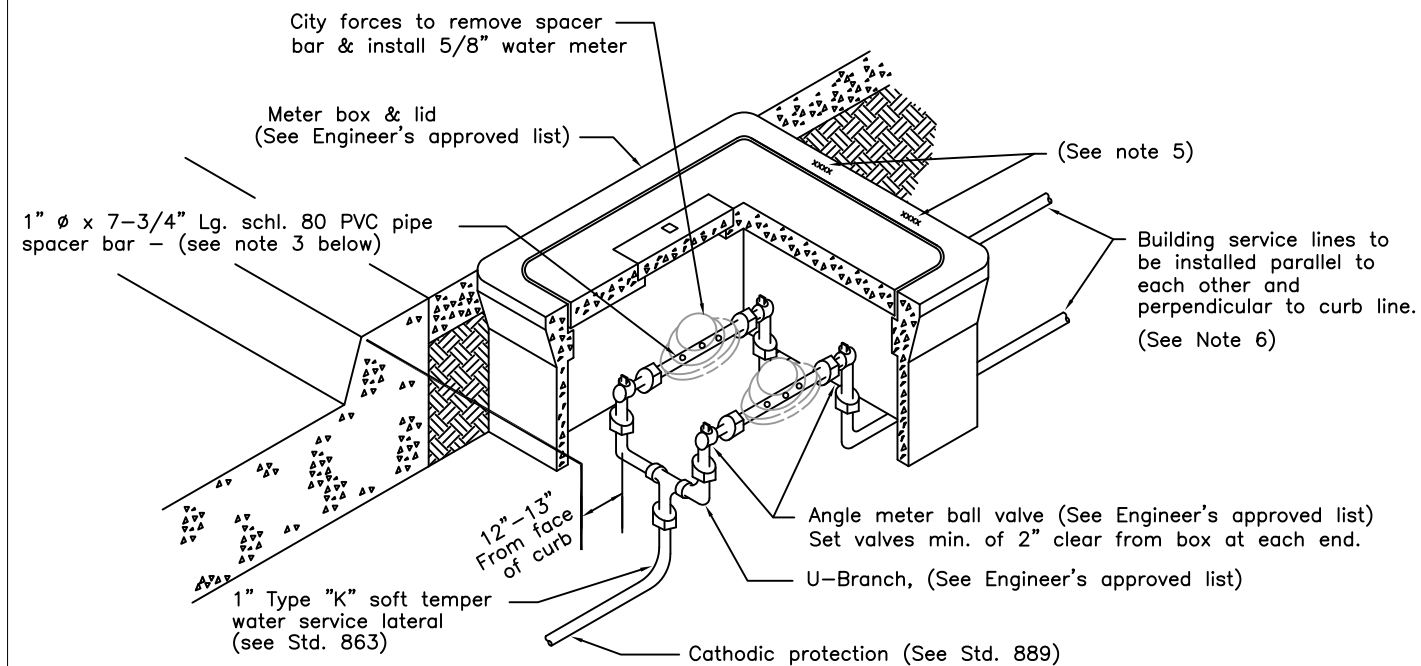


NOTES:

1. Meter box to be installed so that reading lid is centered over the meter registers.
2. In traffic loading areas, install two individual meter boxes and replace U-branch with field-made manifold.
3. Contractor to install schl. 80 pvc spacer with threads on both ends. Drill 1/2" ϕ holes @ 2" O.C. through pipe after testing service lateral.
4. Meter box knockouts will not be allowed.
5. Prior to meter set, address to be clearly marked on topside lip of meter box over each service with permanent felt marker.
6. At a minimum, extend building service lines to 12" beyond back of meter box and cap. Where sidewalk is being installed by the public improvements contractor, extend building service line to 12" beyond back of sidewalk and cap. If permanent meter set is requested prior to completion of property side plumbing, a minimum of 10' of the building service line must be installed with a hose bib on a riser above finished grade.


CITY OF SANTA ROSA

1" DUAL WATER
SERVICE LATERAL

SCALE: NONE	DATE: Sept.2002
DWN: GC CHK:	APPROVED FILE NO. STD.- 864

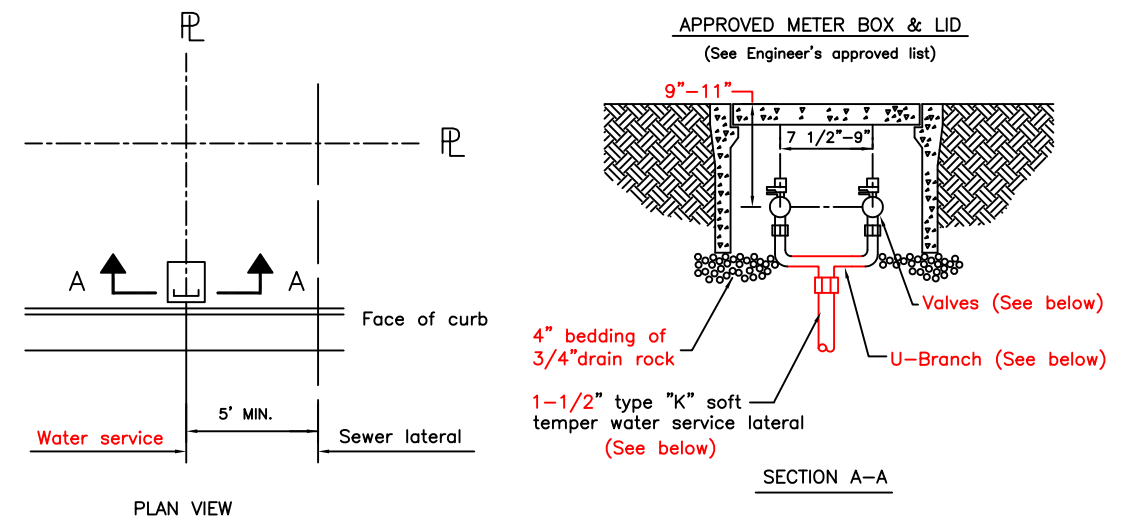

SINGLE METER BOX INSTALLATION FOR DUAL 3/4" MANIFOLD

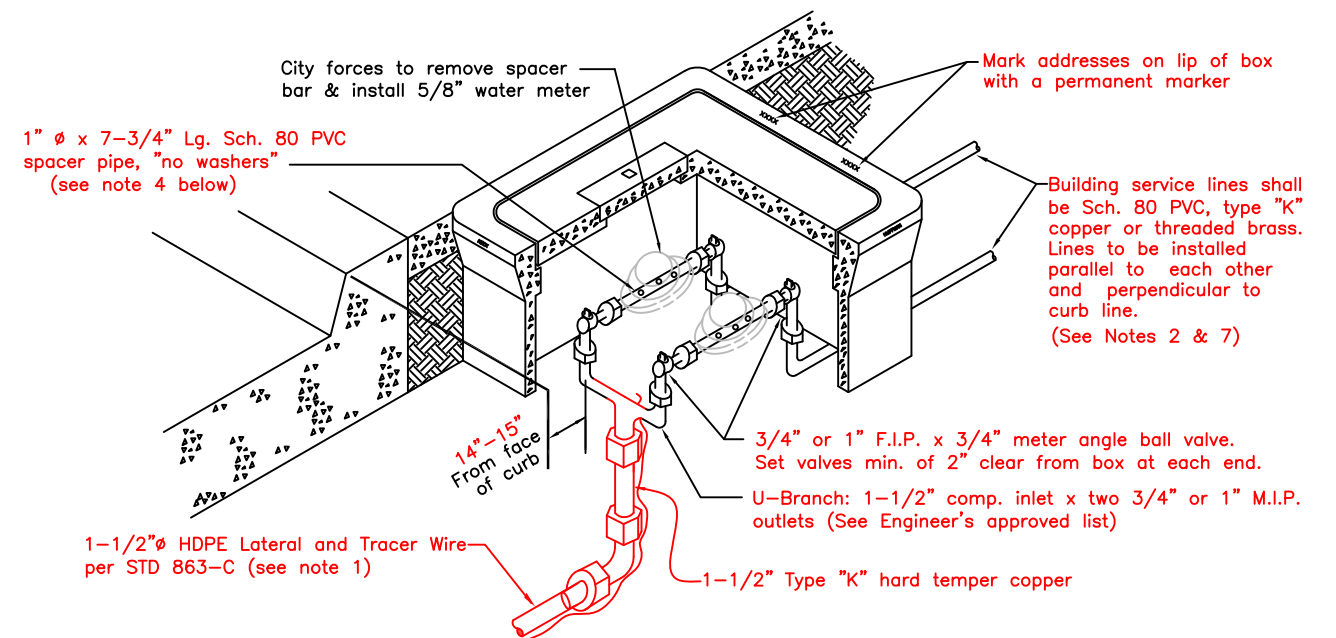


NOTES:

1. If plans or site conditions call for copper installation, install lateral per Standar863-B unless otherwise directed by the Engineer.
2. When not extending to a building or connecting to a backflow device or an existing lateral, the Contractor shall extend the service laterals to a minimum of 12" behind future sidewalk or to back of P.U.E. and cap watertight. There shall be no bends or fittings under sidewalk and/or concrete planter strip. If the permanent service meter is requested prior to completion of the property side plumbing, at least 10 linear feet of service lateral shall be installed at a location safe from traffic and construction activities, and extended vertically to a minimum 24" above grade with a 3/4" hose bib on the end.
3. Bedding material shall be compacted to a minimum 90% relative compaction prior to tubing installation.
4. For new development, after testing the service lateral the Contractor shall install a Sch.80 PVC spacer with N.I.P. threads on both ends. The spacer shall have 1/2" ϕ holes drilled through the pipe @ 2" O.C.
5. Meter box "knock-outs" shall not be removed for installation. Grouting of removed knock-outs, broken out sections or cracks will be rejected. Box shall be set at grade with surrounding surfaces.
6. Install solid lid with probe holes per City Standards and Specifications. If directed to install lid with inset read lid, box and read lid shall be centered over meters so both registers are easily visible.
7. If connecting to a backflow device see specific backflow standard for piping requirements between meter and device. If existing line to be connected to is galvanized, use a dielectric fitting.
8. Water services and meter boxes shall be located away from driveways where possible. Installations in driveways, or anywhere vehicular traffic may occur, must be approved by the Director of Santa Rosa Water. If so approved, the box & lid shall have a AASHTO H20 rating. All meter box and lid installations shall be per manufacturer's recommendations, and shall comply with all applicable City Standards.

CITY OF SANTA ROSA


1-1/2" HIGH DENSITY POLYETHYLENE
DUAL WATER SERVICE LATERAL

SCALE: NONE	DATE: SEPT 2016
DWN:GC CHK:	APPROVED FILE NO. STD.- 864


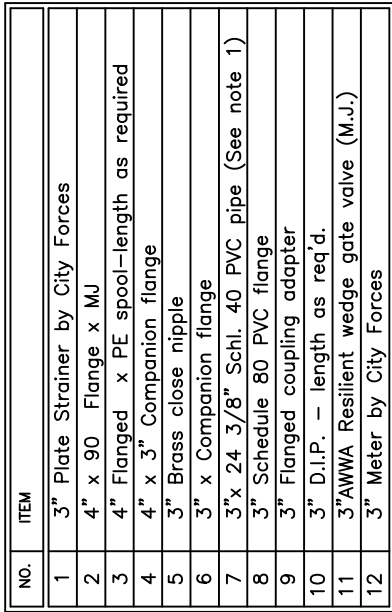



5. Restrained joints are required for all new construction from gate valve to 90° ell. Thrust blocks are only required where existing services are being modified and restrained joints are not used.

(See Engineer's approved list)

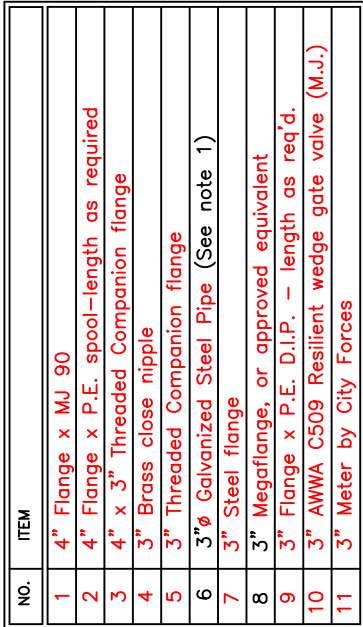

5. Restrained joints are required on all new piping from gate valve to 90° ell. Thrust blocks are only required where existing services are being modified and restrained joints are not practical.

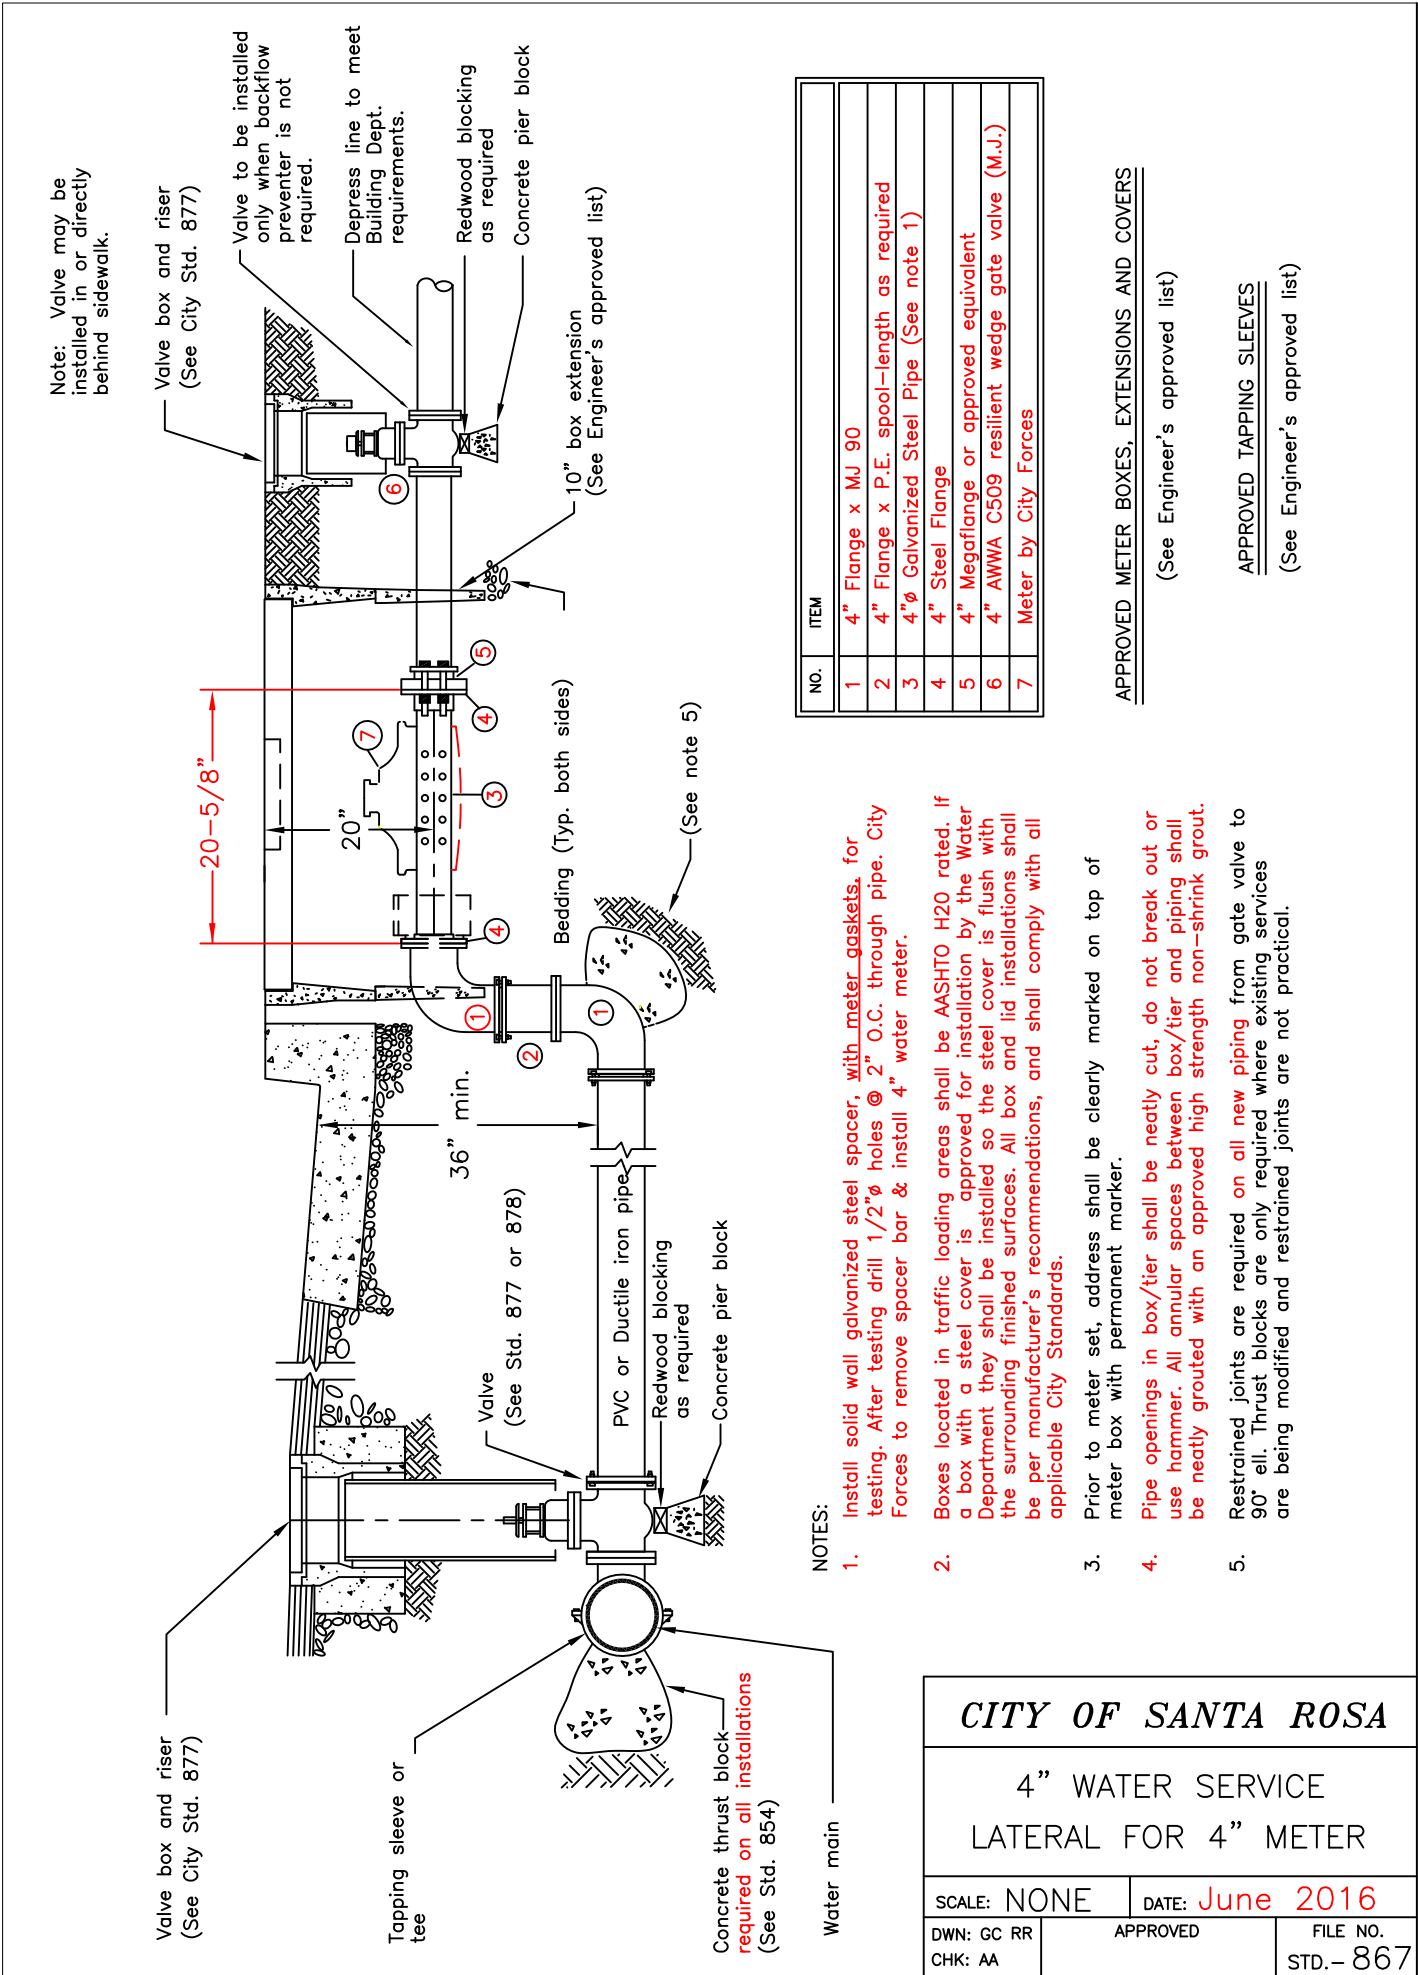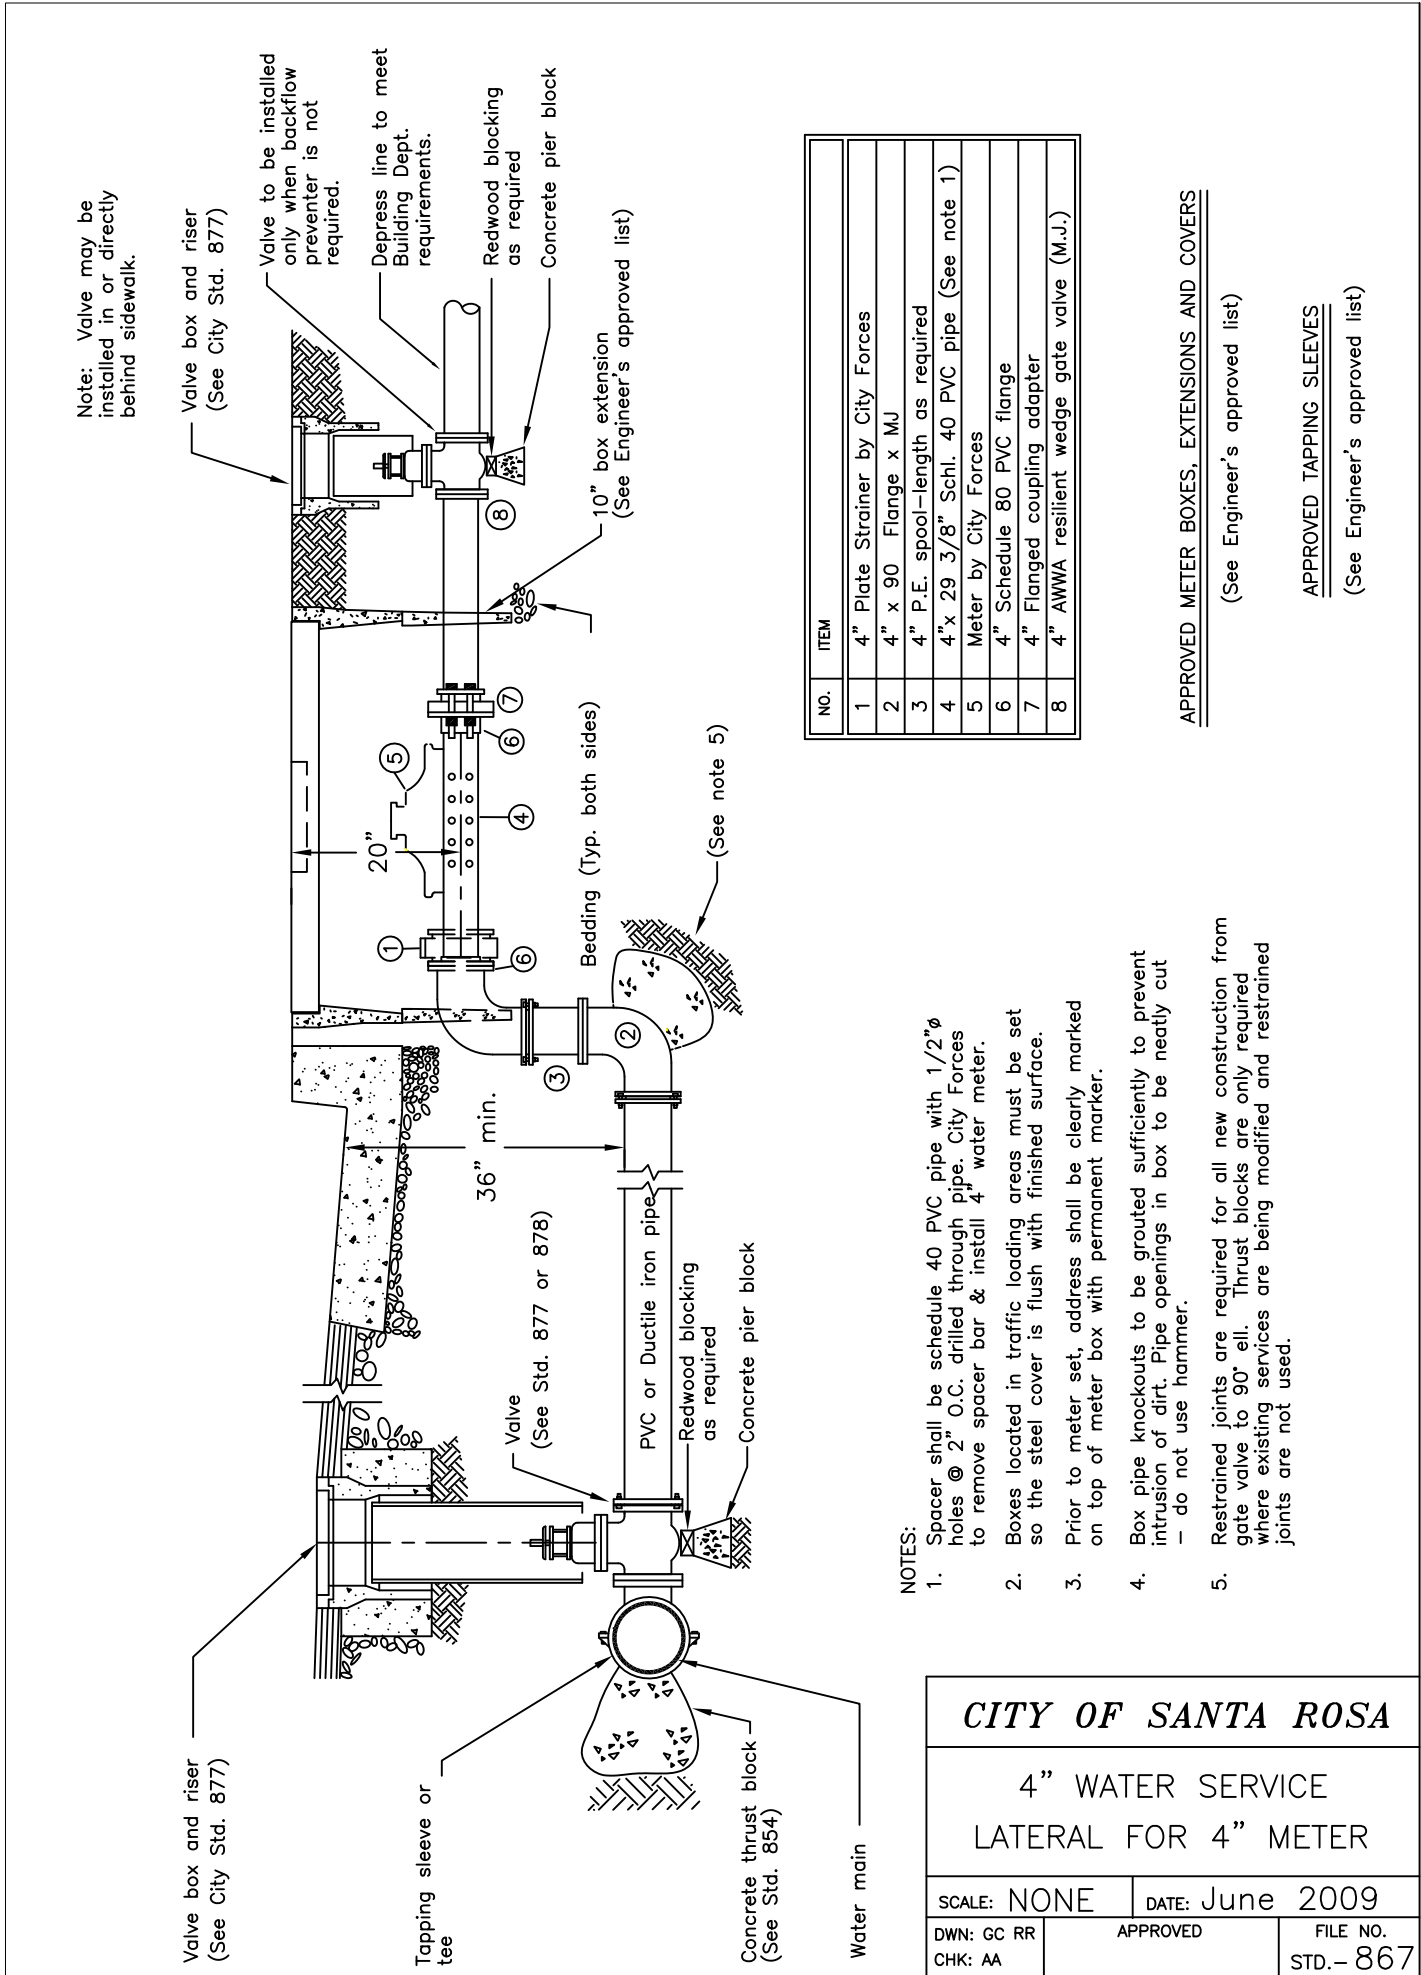

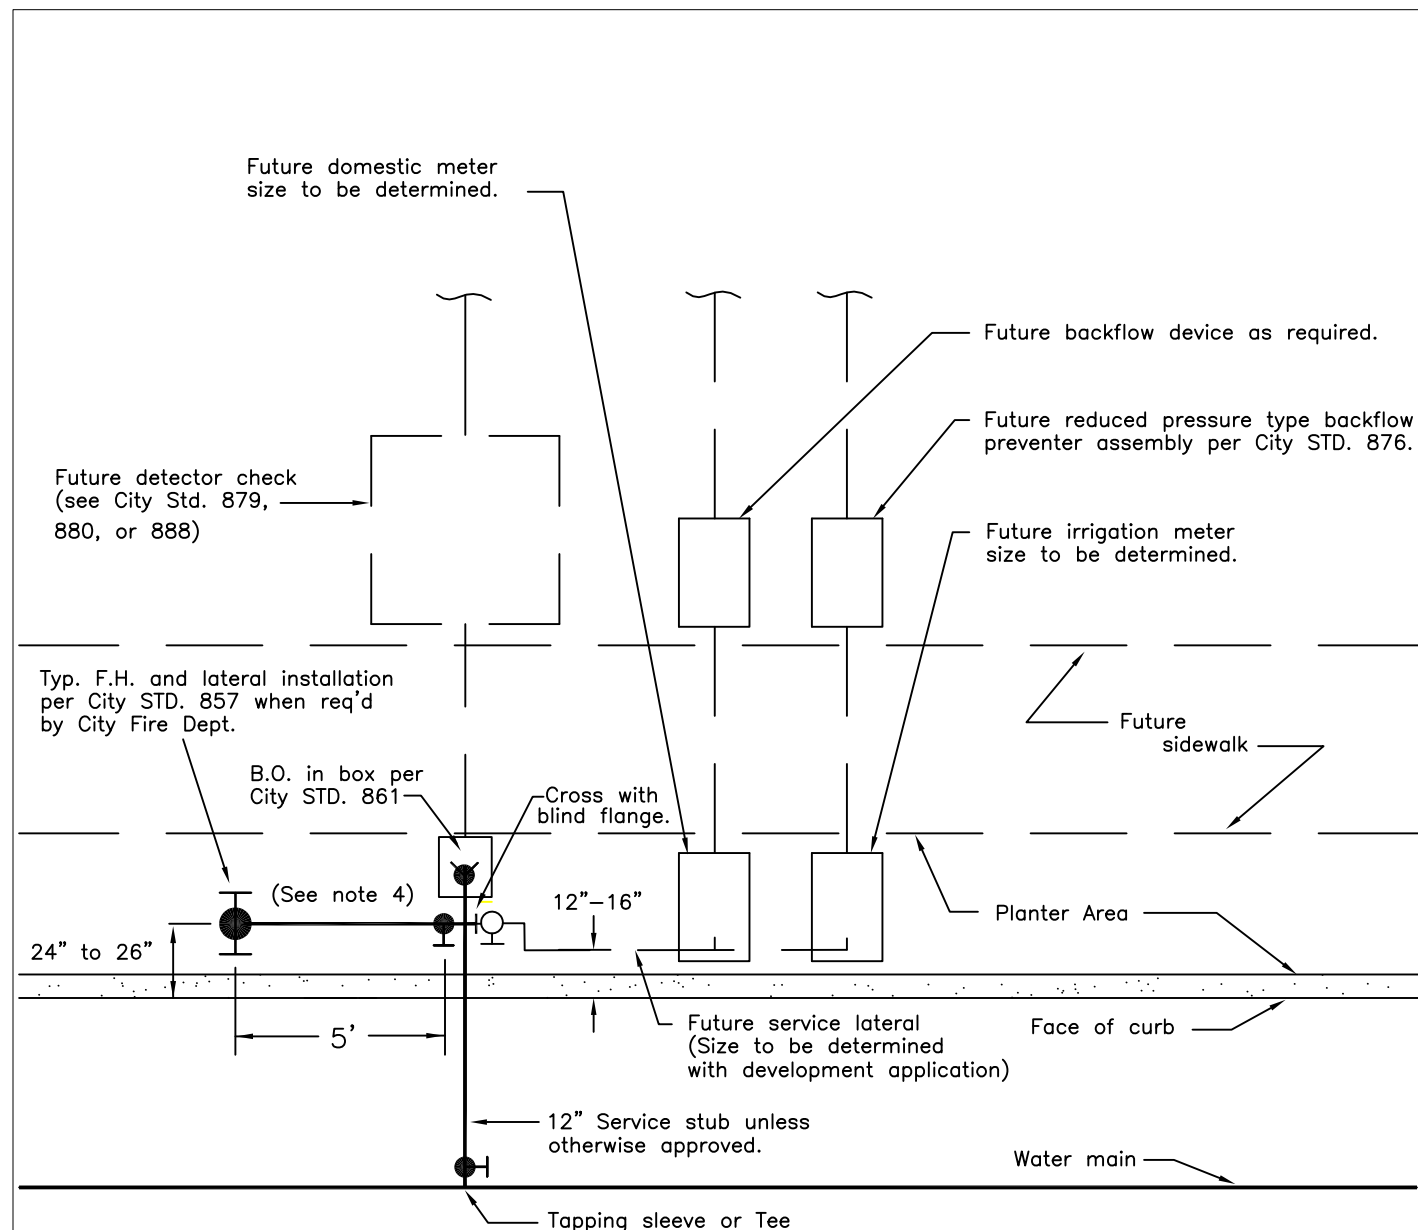


NOTES:

1. This standard applies to commercial and multi-residential developments where domestic, irrigation, or fire protection requirements are not established at the time of application.
2. Utilities Dept. approval must be obtained prior to installation.
3. Where a hydrant is required, install an 8" x 6" cross or 12" x 6" cross as appropriate. Where a hydrant is not required, install manifold connection per the appropriate service lateral Standard.
4. Use a slotted break-off riser as necessary to enable proper orientation of the fire hydrant outlets.
5. Restrained joints are required from gate valve to blowoff for all new construction.

CITY OF SANTA ROSA

COMBINATION
WATER SERVICE STUB

SCALE: NONE	DATE: June 2009
DWN: GC RR	APPROVED
CHK: AA	FILE NO. STD.- 869

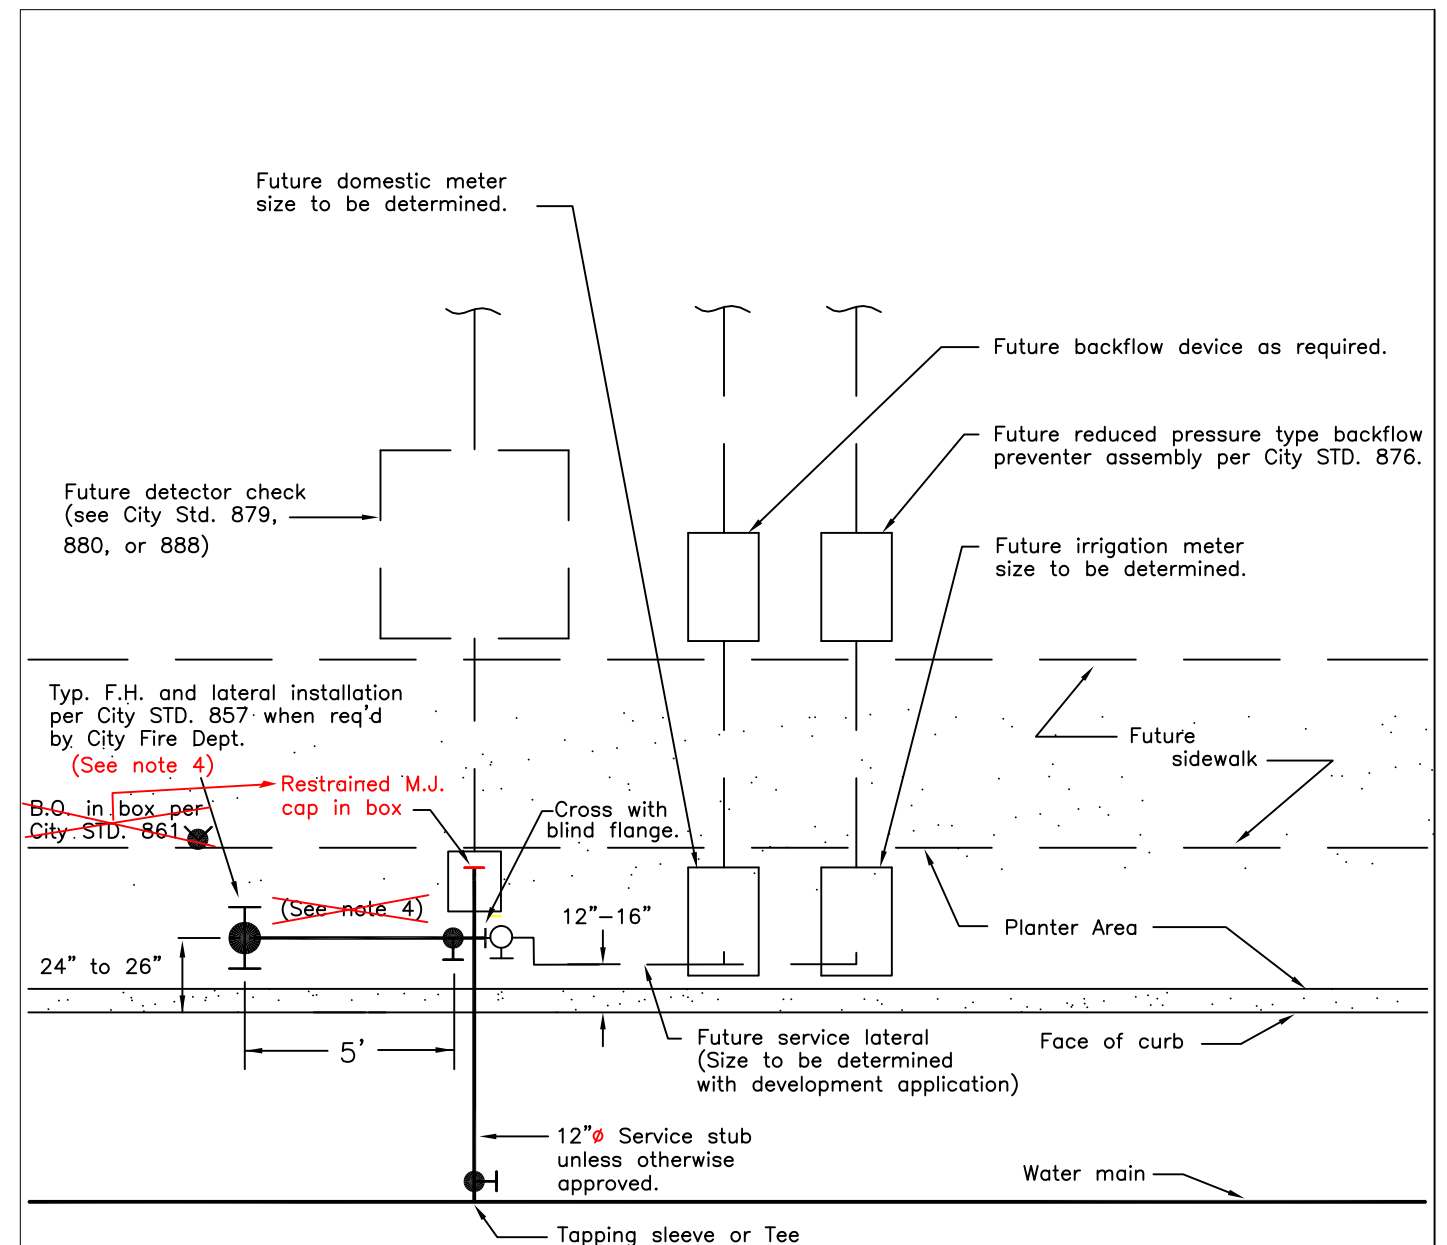


NOTES:

1. This standard applies to commercial and multi-residential developments where domestic, irrigation, or fire protection requirements are not established at the time of application.
2. ~~Utilities~~ Water Department approval must be obtained prior to installation.
3. Where a hydrant is required, install an 8" x 6" cross or 12" x 6" cross as appropriate. Where a hydrant is not required, install manifold connection per the appropriate service lateral Standard.
4. Orientation of fire hydrant outlets will be determined in the field by the Water Department.
5. Restrained joints are required on all new construction.
4. ~~Use a slotted break-off riser as necessary to enable proper orientation of the fire hydrant outlets.~~
5. ~~Restrained joints are required from gate valve to blowoff for all new construction.~~

CITY OF SANTA ROSA

COMBINATION
WATER SERVICE STUB

SCALE: NONE	DATE: Apr. 2016
DWN: GC RR	APPROVED
CHK: AA	FILE NO. STD.- 869

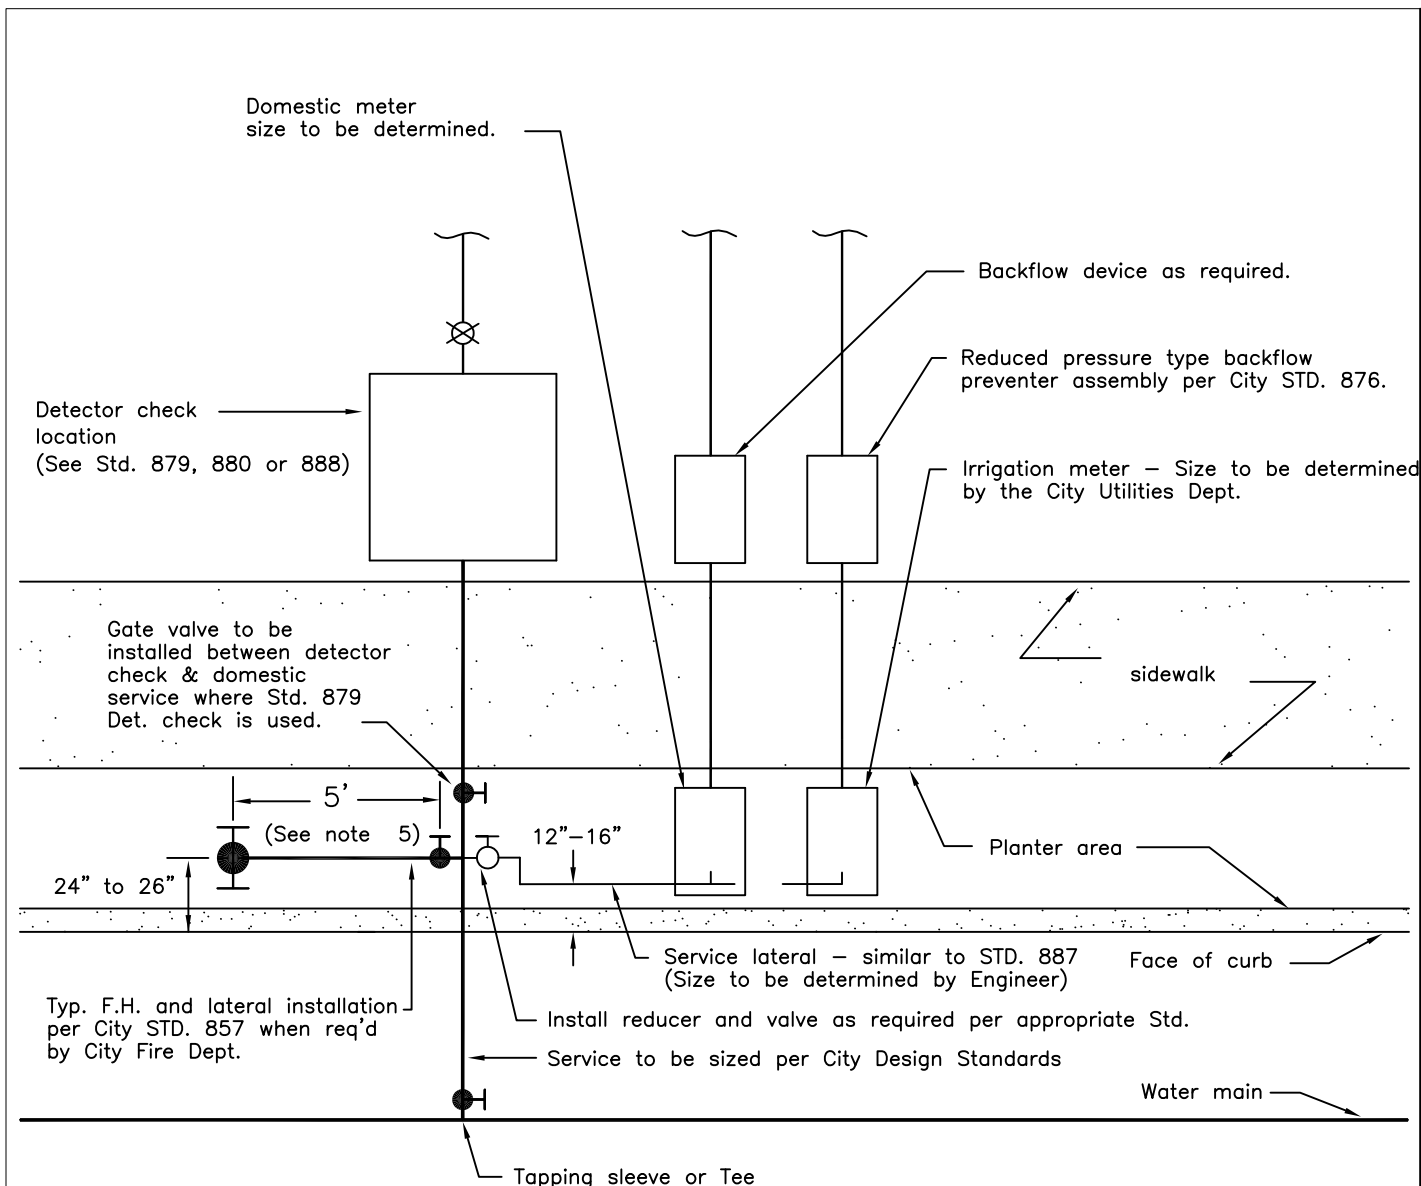


NOTES:

1. This standard applies to commercial and multi-residential developments where domestic, irrigation, or fire protection requirements are established at the time of application.
2. When referring to this standard, specify meter and detector check sizes and appropriate standard plans.
3. When field conditions preclude the installation of meters at or near the curb line, submit detailed plans of the proposed installation for Utilities Dept. approval. All meter installations must be within public right-of-way.
4. Where a hydrant is required, install an 8" x 6" cross or 12" x 6" cross as appropriate. Where a hydrant is not required, install manifold connection per the appropriate service lateral Standard.
5. Use a slotted break-off riser as necessary to enable proper orientation of the fire hydrant outlets.
6. Restrained joints are required for all new construction from the gate valve at the main to the detector check valve.

CITY OF SANTA ROSA

COMBINATION
WATER SERVICE

SCALE: NONE	DATE: June 2009
DWN: GC RR	APPROVED
CHK: AA	FILE NO. STD.- 870

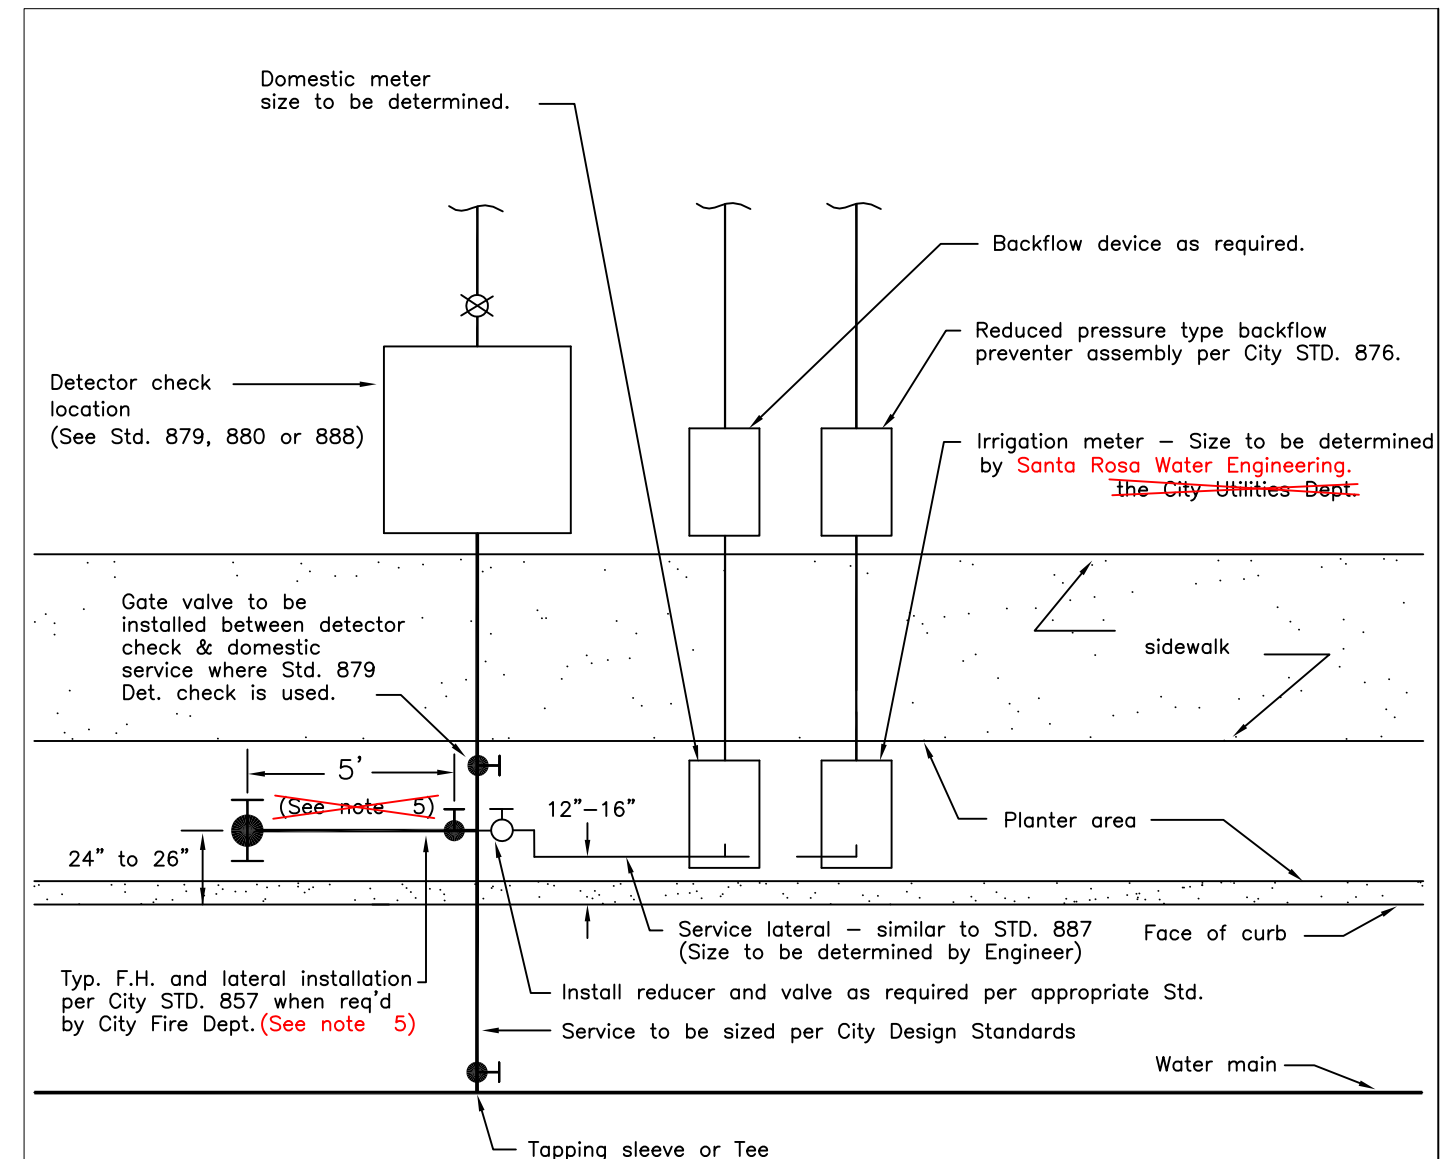

NOTES:



1. This standard applies to commercial and multi-residential developments where domestic, irrigation, or fire protection requirements are established at the time of application.
2. When referring to this standard, specify meter and detector check sizes and appropriate standard plans.
3. When field conditions preclude the installation of meters at or near the curb line, submit detailed plans of the proposed installation for ~~Utilities~~ Water Department approval. All meter installations must be within public right-of-way.
4. Where a hydrant is required, install 8" x 6" or 12" x 6" cross as appropriate. Where a hydrant is not required, install manifold connection per the appropriate service lateral standard.
5. Orientation of fire hydrant outlets will be determined in the field by the Water Department.
6. Restrained joints are required on all new construction.
- ~~5. Use a slotted break-off riser as necessary to enable proper orientation of the fire hydrant outlets.~~
- ~~6. Restrained joints are required for all new construction from the gate valve at the main to the detector check valve.~~


CITY OF SANTA ROSA

COMBINATION
WATER SERVICE

Page 1 of 2

SCALE: NONE	DATE: Apr. 2016
DWN: GC RR	APPROVED
CHK: AA	FILE NO. STD.- 870

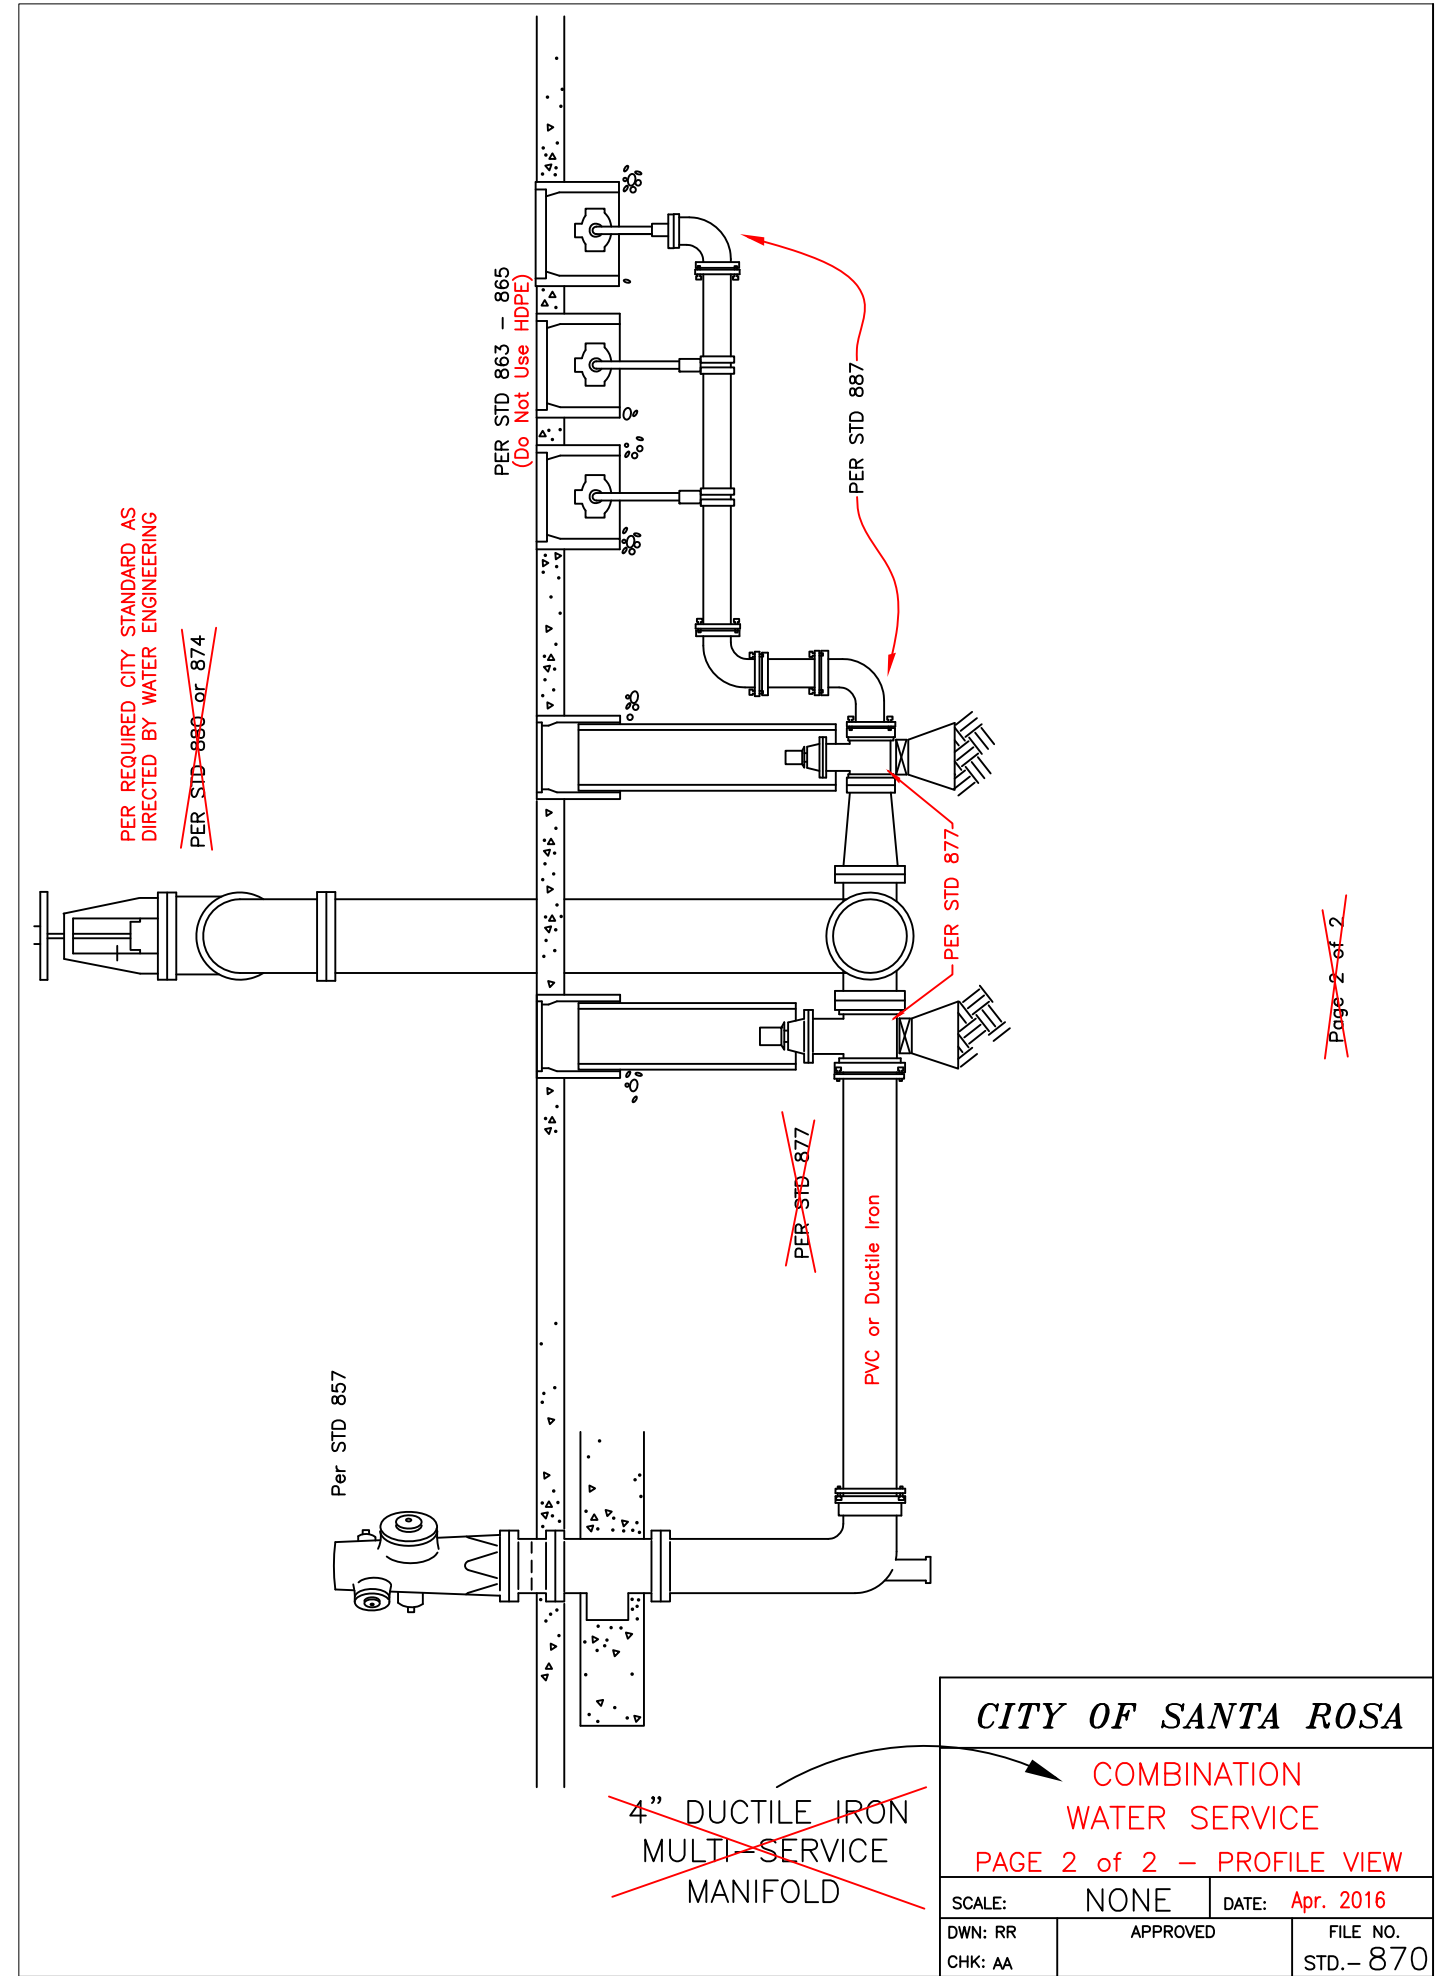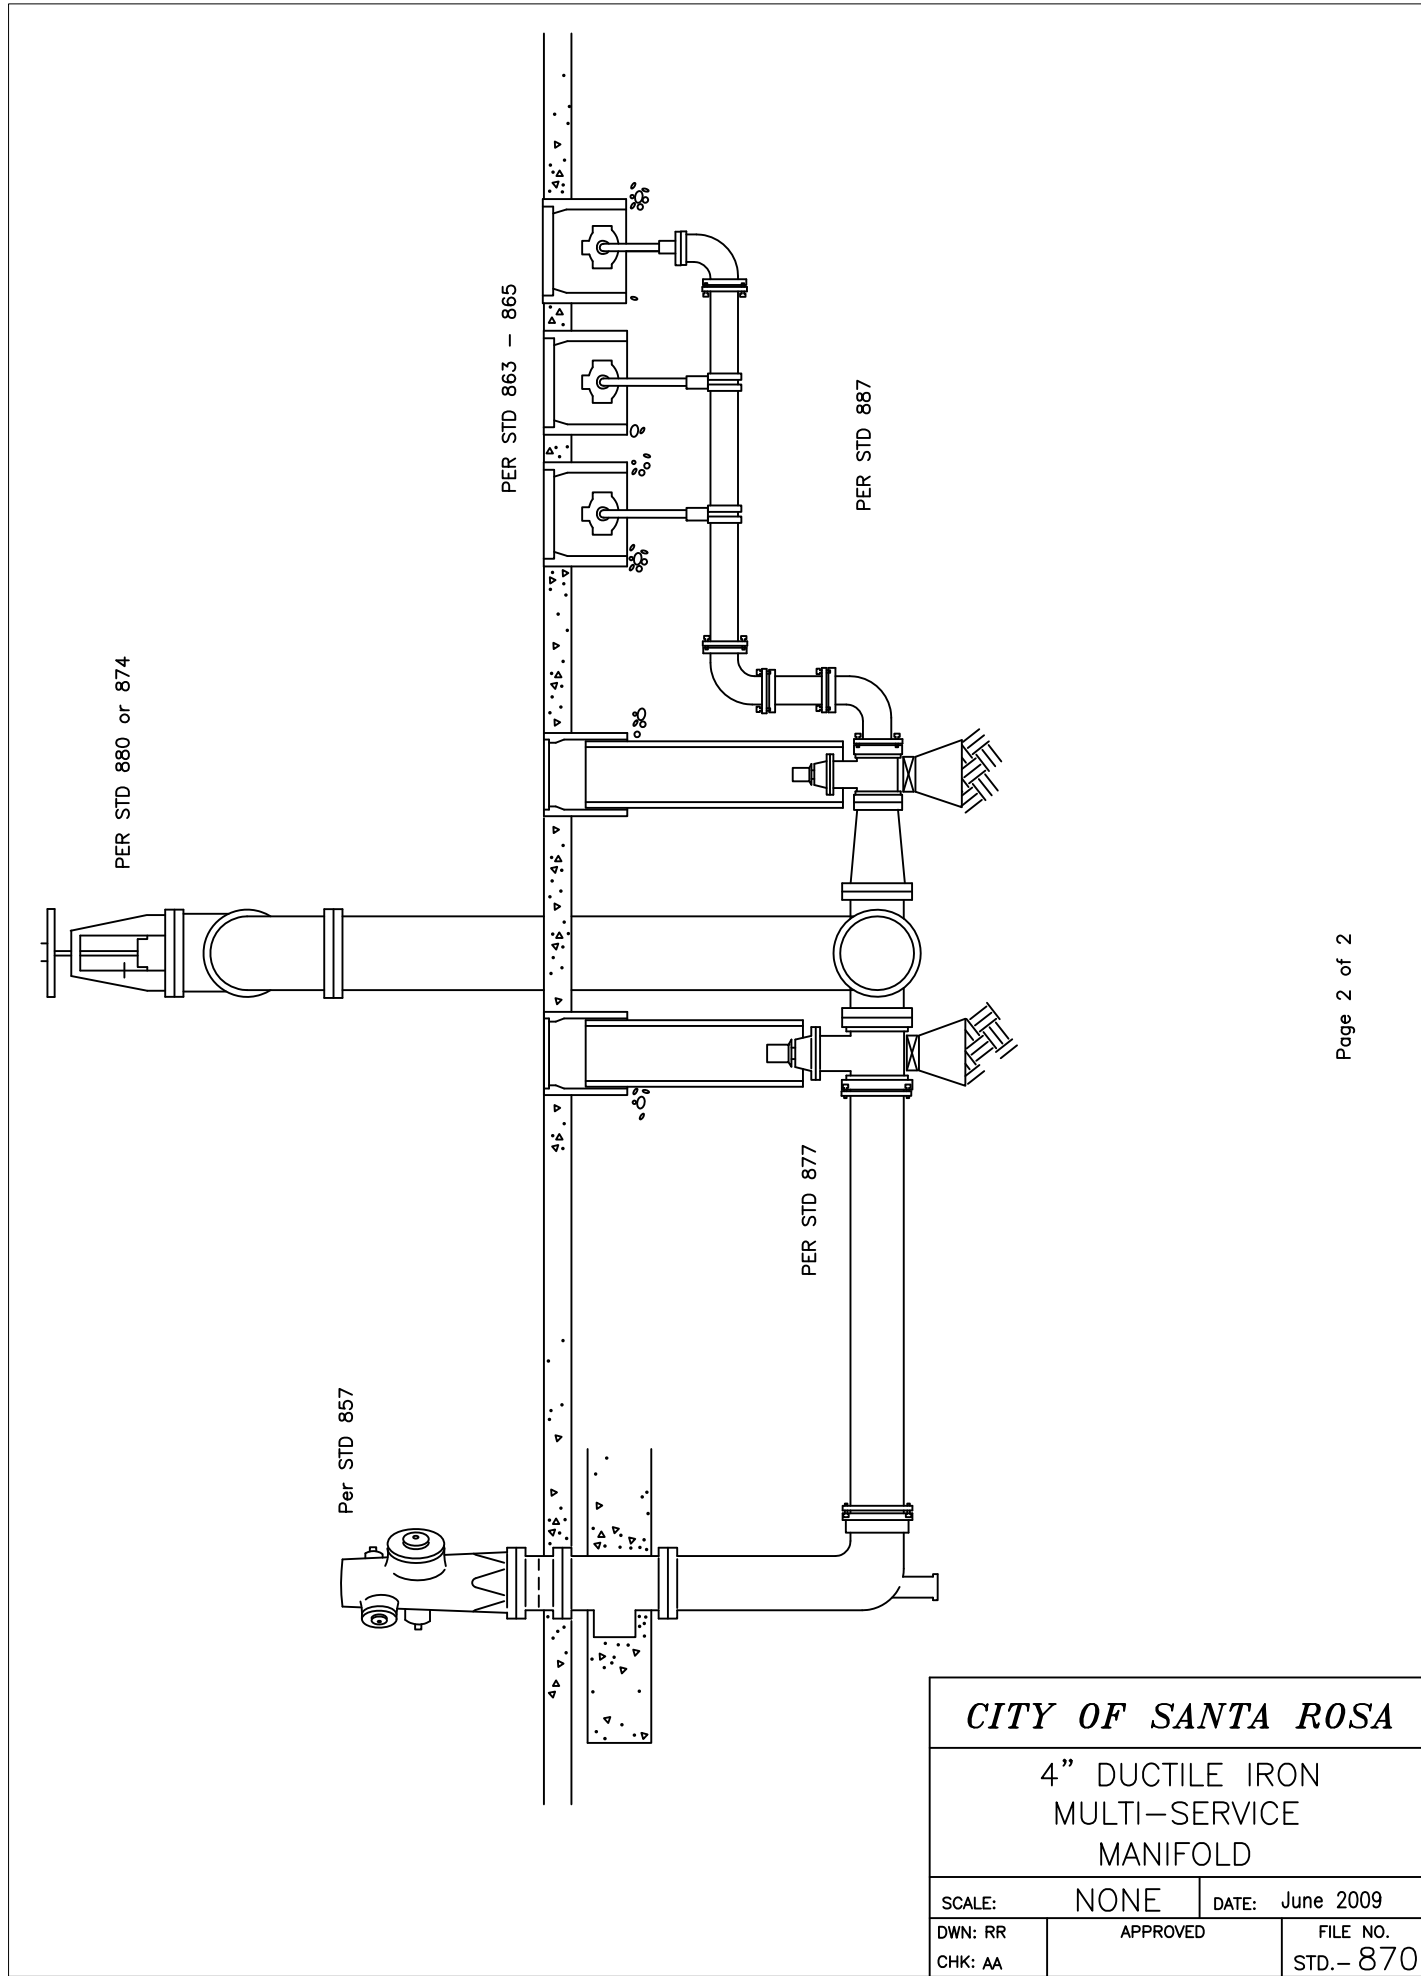

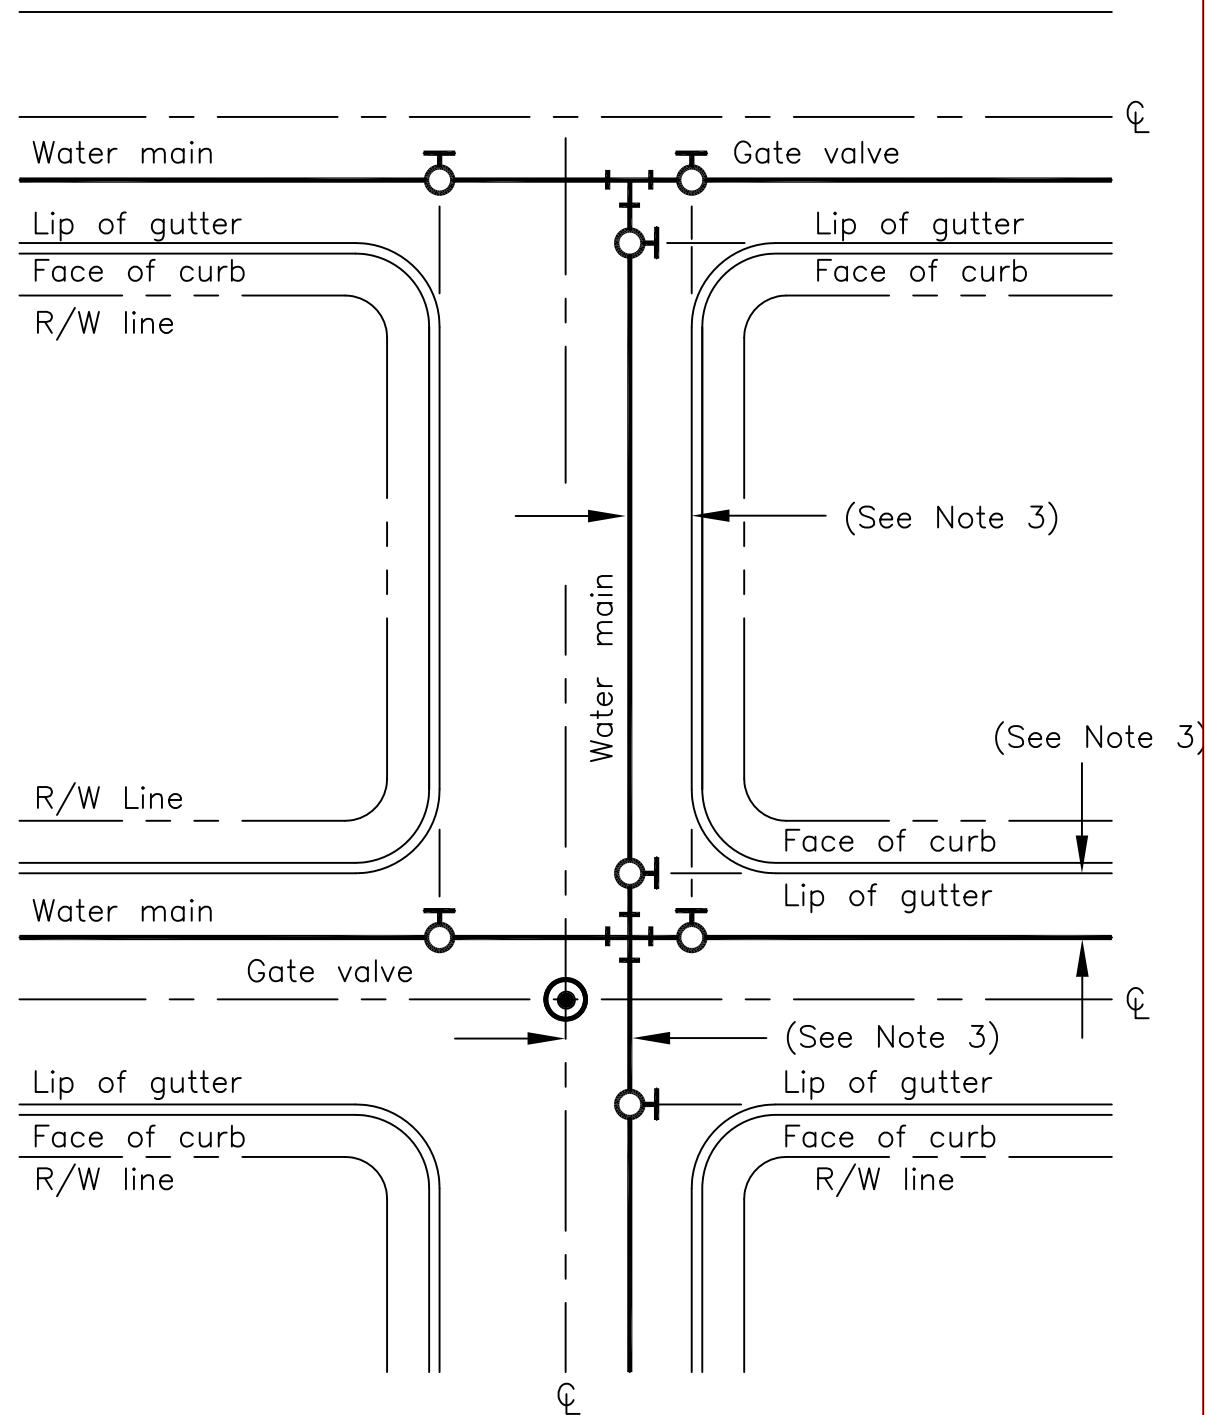


NOTES

1. Water mains shall be located parallel to street centerlines unless conflicts with other underground facilities cannot be avoided.
2. Non-standard alignments shall be approved by the Utilities Dept. prior to installation. Mainline valves, except hydrant valves and tapping valves, shall be on face of curb extended where feasible.
3. Install mains with constant alignment whenever possible, minimum 3' from the lip of gutter and minimum 4' from centerline monuments.

CITY OF SANTA ROSA

ALIGNMENT OF WATER MAINS AND PLACEMENT OF MAIN VALVES

SCALE: NONE	DATE: Sept.2002
DWN: GC	APPROVED
CHK:	FILE NO. STD.- 871

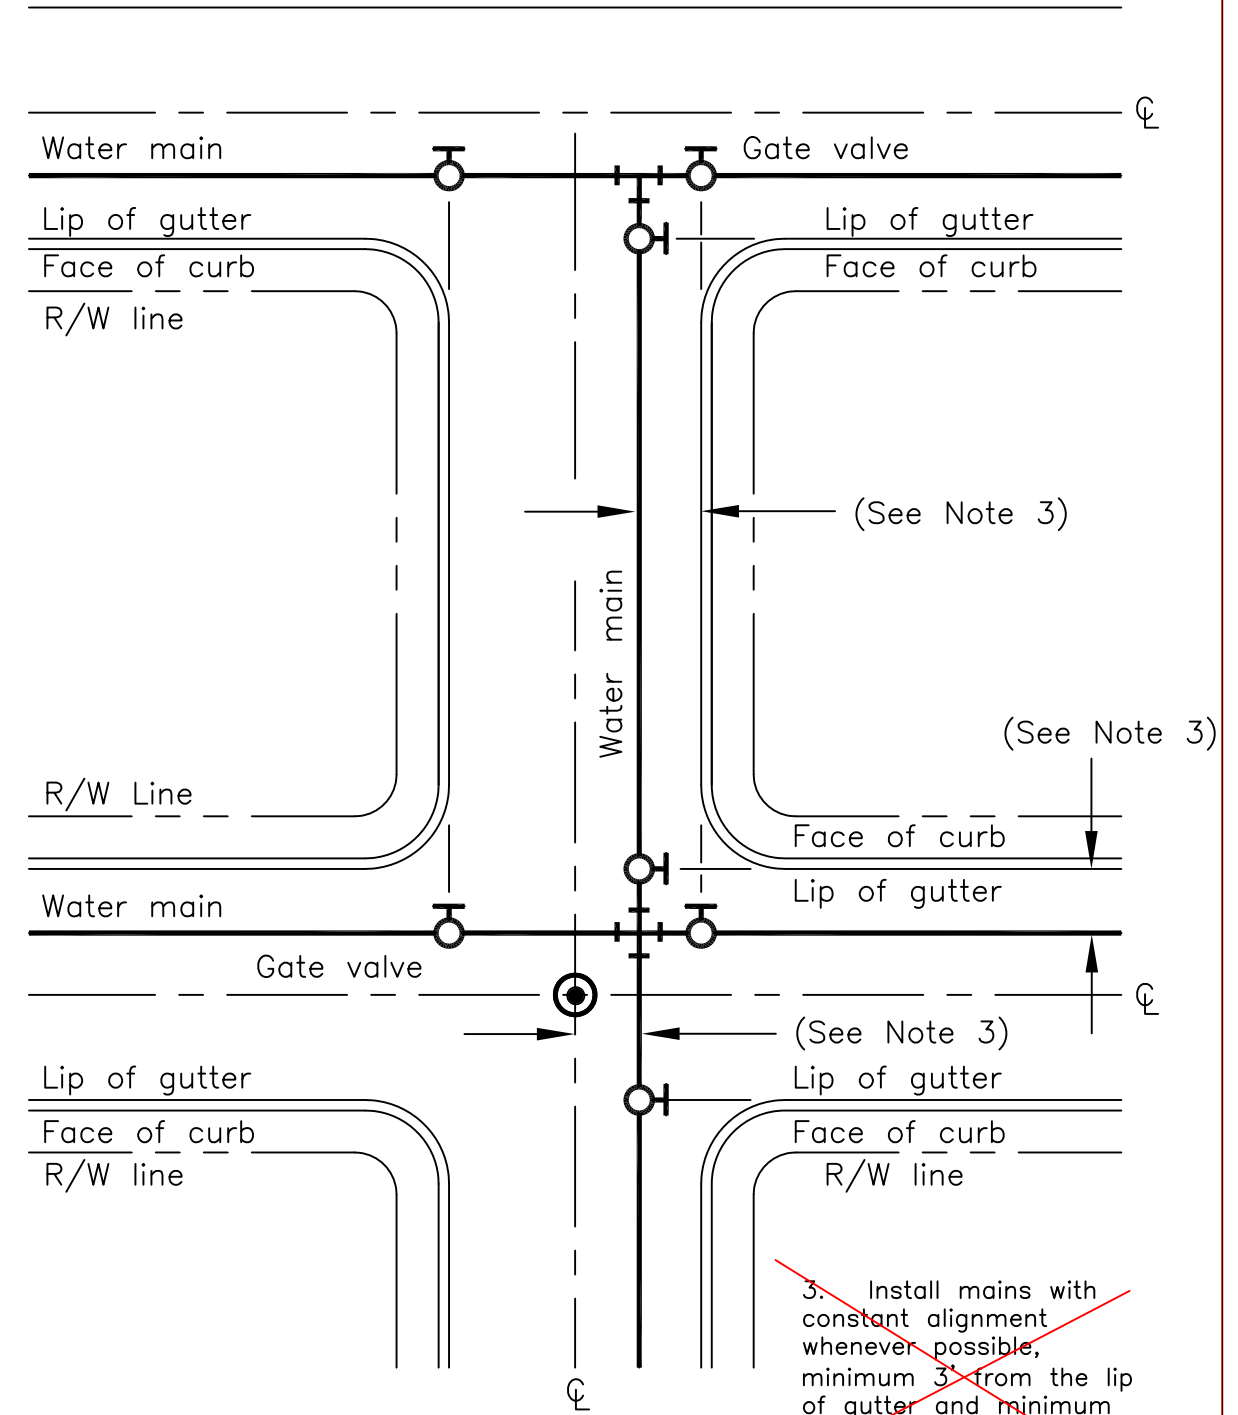


NOTES

1. Water mains shall be located parallel to street centerlines unless conflicts with other underground facilities cannot be avoided.
2. Non-standard alignments ~~shall~~ must be approved by the ~~Utilities Dept.~~ Director of Santa Rosa Water prior to installation. Mainline valves, except hydrant valves and tapping valves, shall be on face of curb extended where feasible.
3. Install mains with constant alignment whenever possible, minimums from nearest outside edge of pipe are; 3' to lip of gutter; 4' to centerline of monuments; and 5' to outside edge of structures such as manholes.

CITY OF SANTA ROSA

ALIGNMENT OF WATER MAINS AND PLACEMENT OF MAIN VALVES


SCALE: NONE	DATE: Apr. 2016
DWN: GC	APPROVED
CHK:	FILE NO. STD.- 871

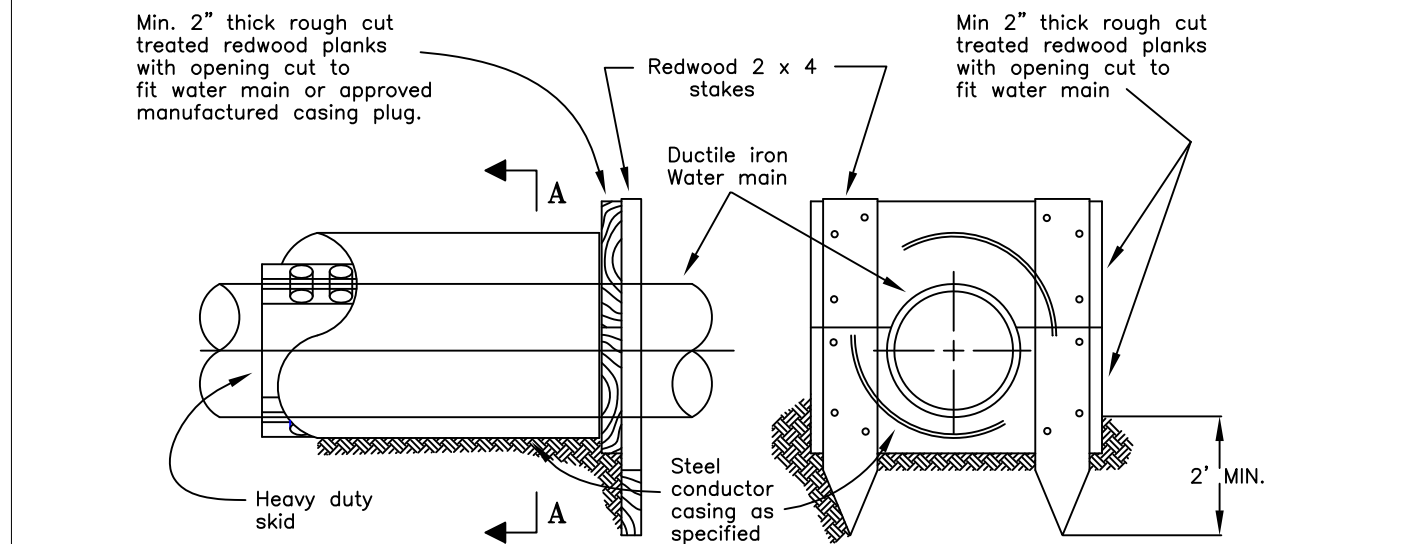


TYPICAL DIRT STOP DETAIL
NO SCALE

Alternately, install casing and seal.

- NOTES**
1. Install skids per manufacturers specifications.
 2. See Engineer's approved list for approved skids.
 3. Where conductor casing is existing R.C.P., banded redwood skids may be installed in lieu of polyethylene skids with Utilities Dept. approval.

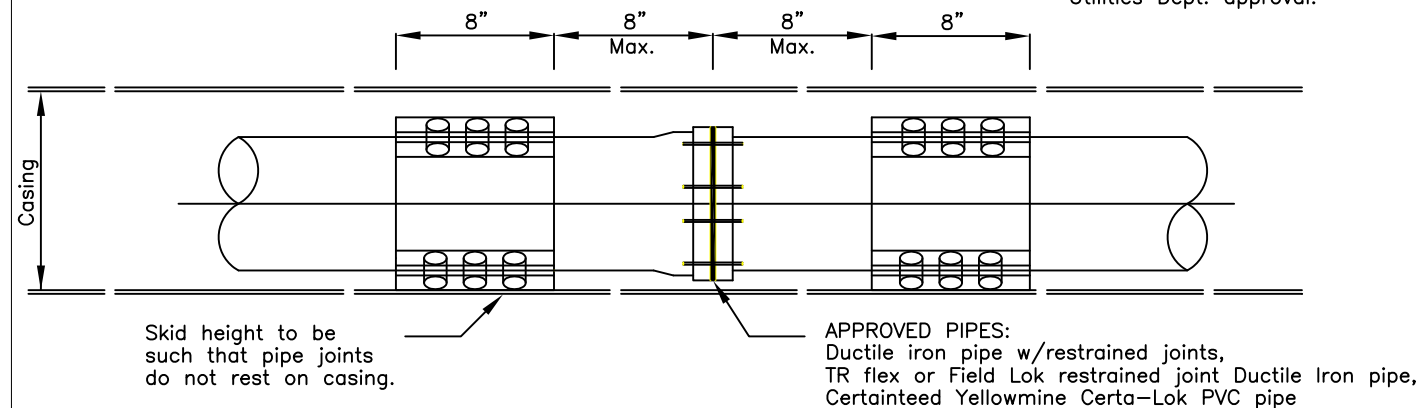

TYPICAL PIPE JOINT AND INSULATOR
NO SCALE

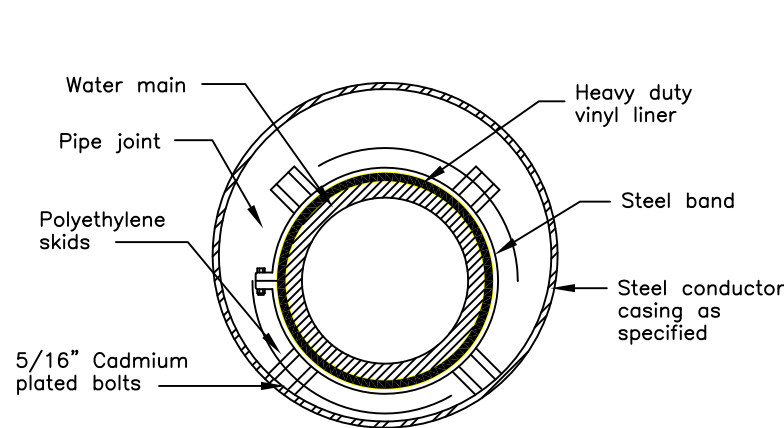


SECTION "A-A"
NO SCALE

Minimum size casing required
For all approved pipe types


Pipe Size	6"	8"	12"	14"	16"
Casing Size (Inside ϕ)	16"	18"	24"	24"	30"
Casing Wall Thickness	.375"	.375"	.375"	.375"	.500"

CITY OF SANTA ROSA		
DIRT STOP AND WATER MAIN ENCASEMENT		
SCALE: NONE	DATE: June 2009	
DWN: TBM RR	APPROVED	FILE NO.
CHK: AA		STD.- 872

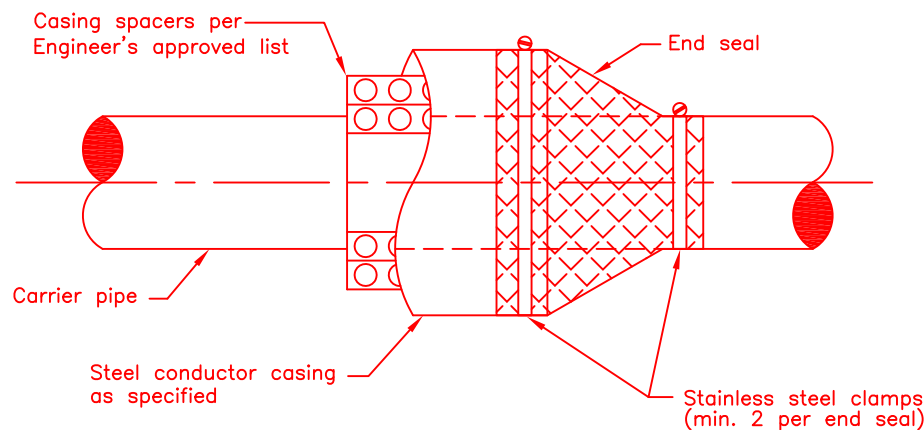

TYPICAL END SEAL DETAIL
NO SCALE


- NOTES**
1. Installations shall be per applicable manufacturer's recommendations and installation instructions.

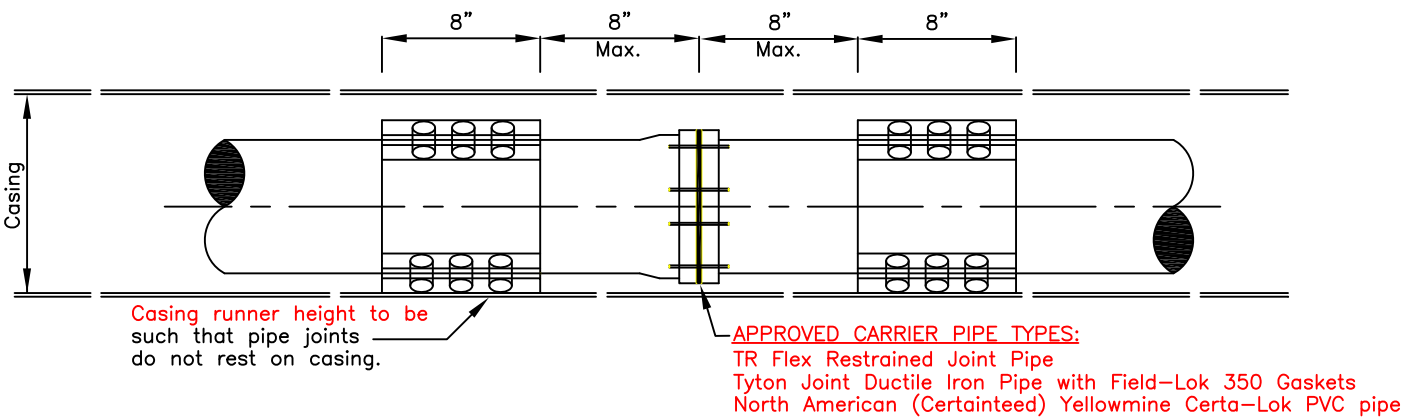

TYPICAL PIPE AND SPACER INSTALLATION
NO SCALE

- NOTES**
1. Install minimum three spacers per length of pipe.
 2. Where conductor casing is existing R.C.P., stainless steel banded unfinished 2x4 redwood skids, made from con-heart grade lumber, may be installed, with the approval from the Water Department, in lieu of casing spacers. Redwood skids shall be a minimum of 4' long, notched to accommodate bands, with the leading edges beveled. There shall be a minimum of two bottom skids, side by side, and one top skid. Ends of skids shall be no more than 30" from pipe joints.

Specific Installations may require filling of the annular space with dry blown sand

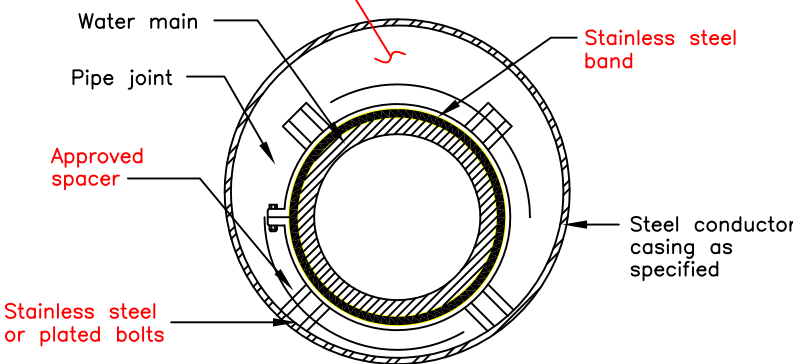


SECTION "A-A"
NO SCALE

Minimum size conductor casing
for all approved pipe types

Pipe Size	6"	8"	12"	14"	16"
Casing Size (Inside ϕ)	16"	18"	24"	24"	30"
Casing Wall Thickness	.375"	.375"	.375"	.375"	.500"

CITY OF SANTA ROSA		
WATER MAIN ENCASEMENT AND END SEAL		
SCALE: NONE	DATE: Apr. 2016	
DWN: DLK	APPROVED	FILE NO.
CHK: AA		STD.- 872

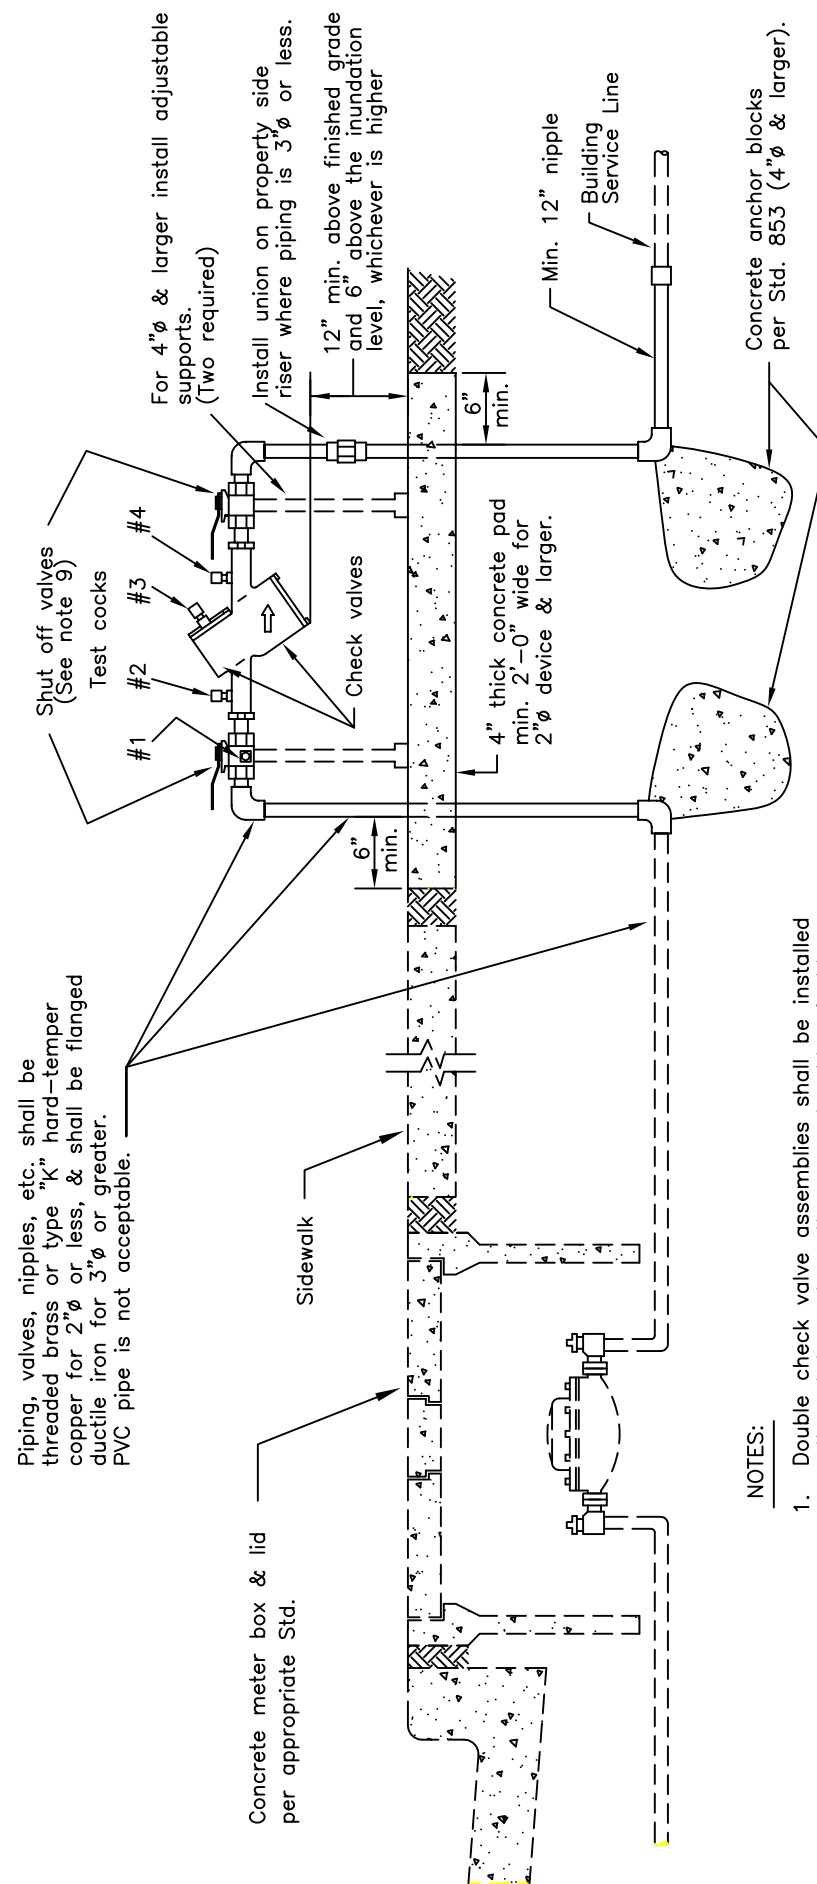

- NOTES:

1. Double check valve assemblies shall be installed adjacent to and on the property side of sidewalk where applicable. Where no sidewalk exists, the double check valve assemblies shall be installed as close as possible to the water meter location. Any conflicts shall be resolved by the City Utilities Dept.

2. Approved double check valves shall be as shown on "List Of Approved Backflow Prevention Devices" (Latest Revision) by the University of Southern California Foundation For Cross – Connection Control & Hydraulic Research.

3. All double check valve assemblies shall be provided with a minimum of four (4) test cocks.

4. Double check valve assemblies shall be required for any use where an intermediate hazard exists. To be installed on all services to properties with wells, and other domestic services as determined by the City Utilities Dept.


- The piping from the meter to the double check valve assembly and the double check valve assembly itself must be the same size as the meter unless otherwise approved by the Utilities Dept.

6. This Std. will be used for all commercial installations requiring a double check valve type backflow preventer.


7. If above ground installation is not feasible install per Std. 875 after approval by the City

8. Any cover or screening for the backflow prevention assembly must be approved by the Utilities Dept. prior to installation.

9. Valves 2"Ø & less shall be ball valves, 3"Ø and greater shall be resilient seat gate valves.

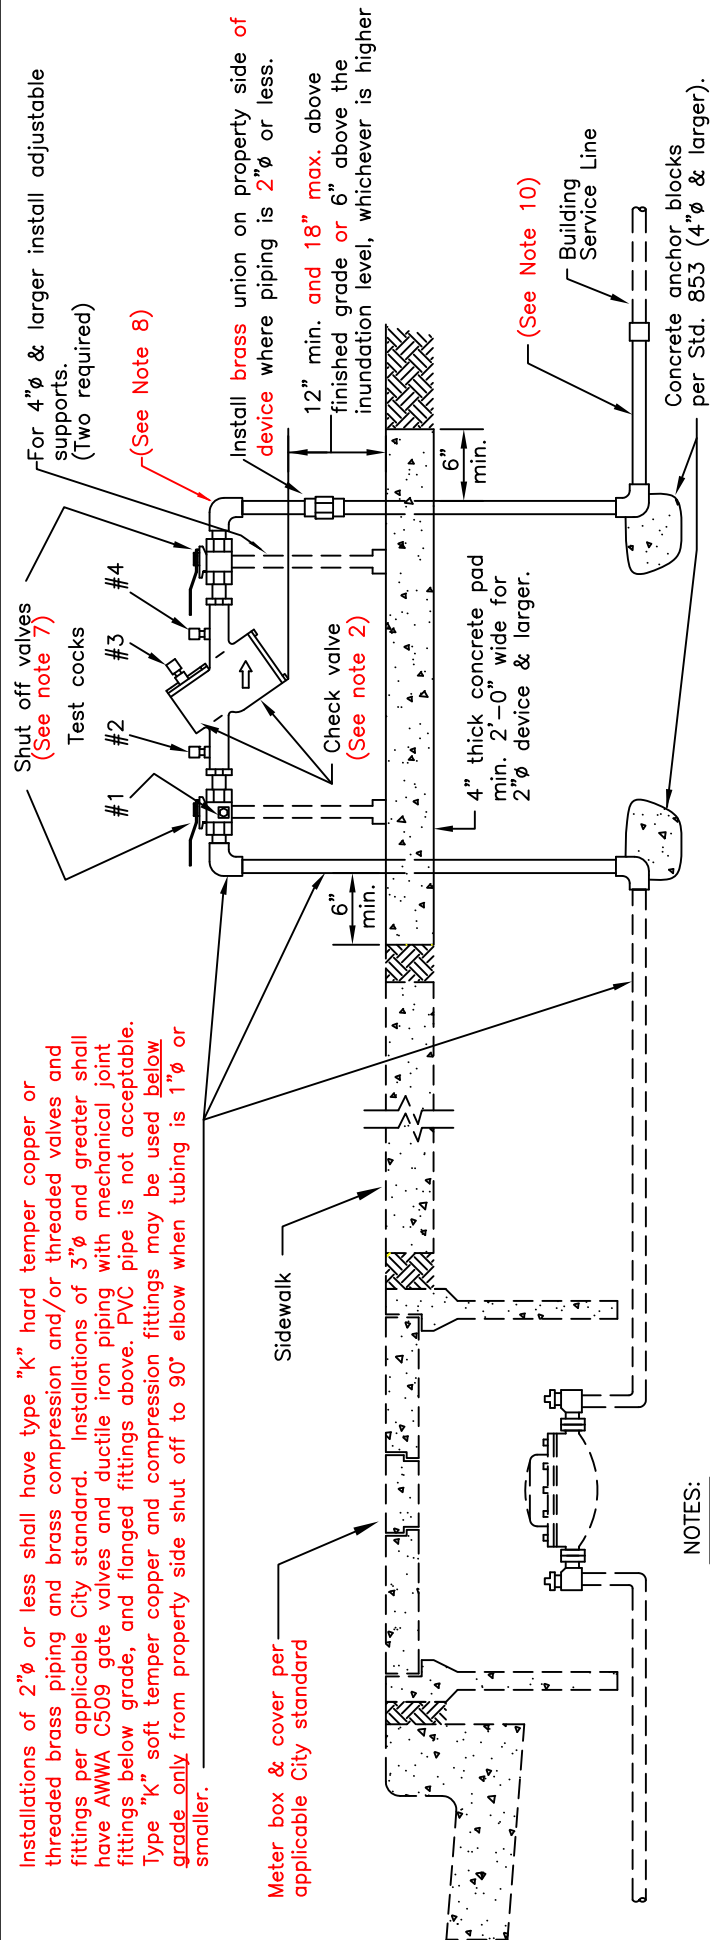


1. This standard shall be used for all commercial installations requiring a double check valve type backflow preventer.
2. Approved double check valve assemblies shall be from the "List Of Approved Backflow Prevention Devices" (Latest Revision) by the University of Southern California Foundation For Cross-Connection Control & Hydraulic Research.
3. Double check valve assemblies are required on all services where, in the opinion of the Water Department, a potential intermediate hazard exists. Device to be installed on all services to properties with wells.
4. If above ground installation is not feasible a request may be made to the Water Department for an installation per City Standard 875.
5. Double check valve assemblies shall typically be installed inline with the water meter and just behind the sidewalk. Where no sidewalk exists or installation at this location is not practical, double check valve assemblies shall be installed as close as possible to the water meter in a location that is safe from traveled ways. Any conflicts shall be brought to the attention of the Engineer and final location shall be determined by the Water Department.
6. The piping from the meter to the double check valve assembly and the double check valve assembly itself must be the same size as the meter unless otherwise approved by the Water Department.
7. Double check valve shall be equipped with shut off valves installed and tested as part of approved device assembly.
8. M.I.P. x F.I.P. 90° elbows (street ells) are not allowed for use on this installation.
9. Provide brass caps or plugs for all test cocks.
10. Minimum 12" long threaded brass nipple for 2"Ø and smaller, and 24" long ductile iron pipe for 3"Ø and greater.
11. Any enclosure, cover or screening for the backflow assembly must first be approved by the Water Department prior to installation.
12. For Residential Fire Line Requirements, if applicable, see details on City Standard 875.
13. Where multiple devices are installed side by side there shall be a minimum of 12" between devices. Where enclosures are installed over devices, devices shall be centered within, and there shall be a minimum of 4" between enclosures.

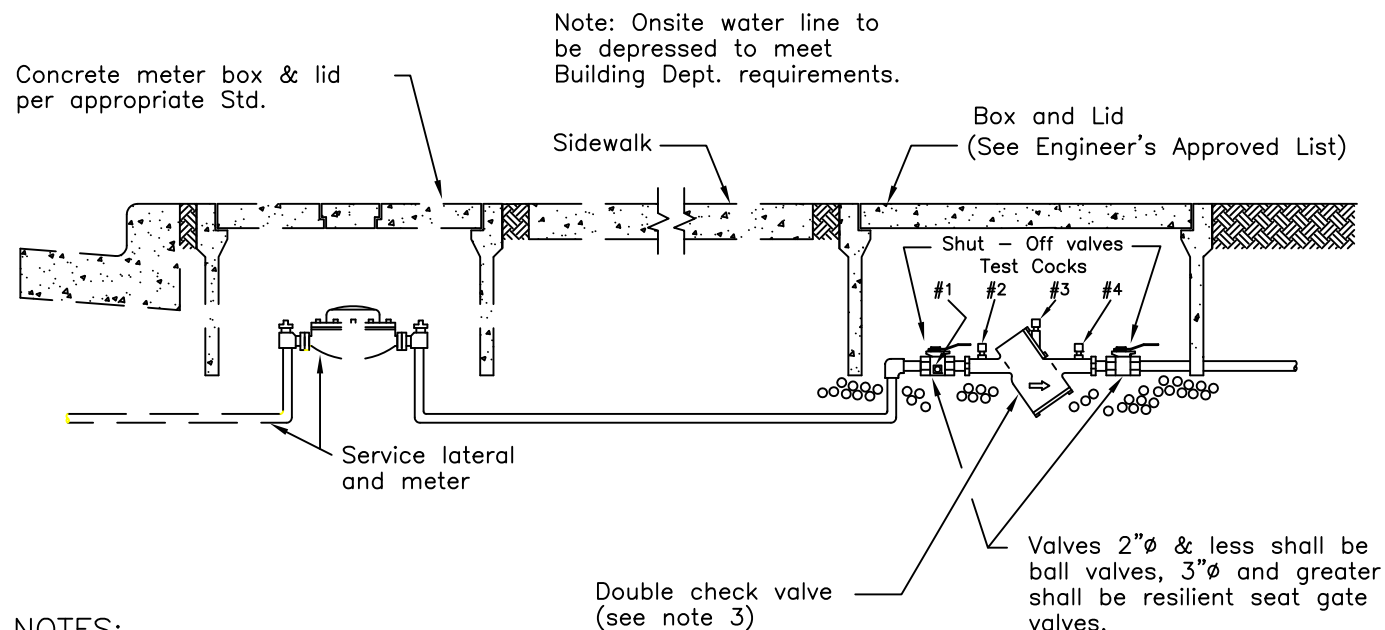

NOTES:


1. This Standard applies to residential connections with auxiliary water supplies onsite or where residential fire sprinkler systems are installed. Where residential fire sprinkler systems are designed to circulate water with the domestic systems, no backflow device is required.
2. Double check valve assemblies shall be installed adjacent to and on the property side of sidewalk where applicable. Where no sidewalk exists, the double check valve assemblies shall be installed as close as possible to the water meter location. Any conflicts shall be resolved by the City Utilities Dept.
3. Approved double check valves shall be as shown on "List Of Approved Back-flow Prevention Devices" (latest revision) by the University of Southern California Foundation For Cross-Connection Control & Hydraulic Research.
4. Piping, valves, nipples, etc. shall be threaded brass or type "K" hard-temper copper for 2"Ø or less, & shall be flanged ductile iron for 3"Ø or greater. PVC pipe is not acceptable.
5. All double check valve assemblies shall be provided with a minimum of four (4) test cocks.
6. See Engineer's Approved List for approved vaults and covers. The vault must be min. 6" longer than the backflow assembly.
7. The piping from the meter to the double check valve assembly and the double check valve assembly itself must be the same size as the meter unless otherwise approved by the Utilities Dept.
8. To be used only upon the specific approval of the Director Of Utilities.

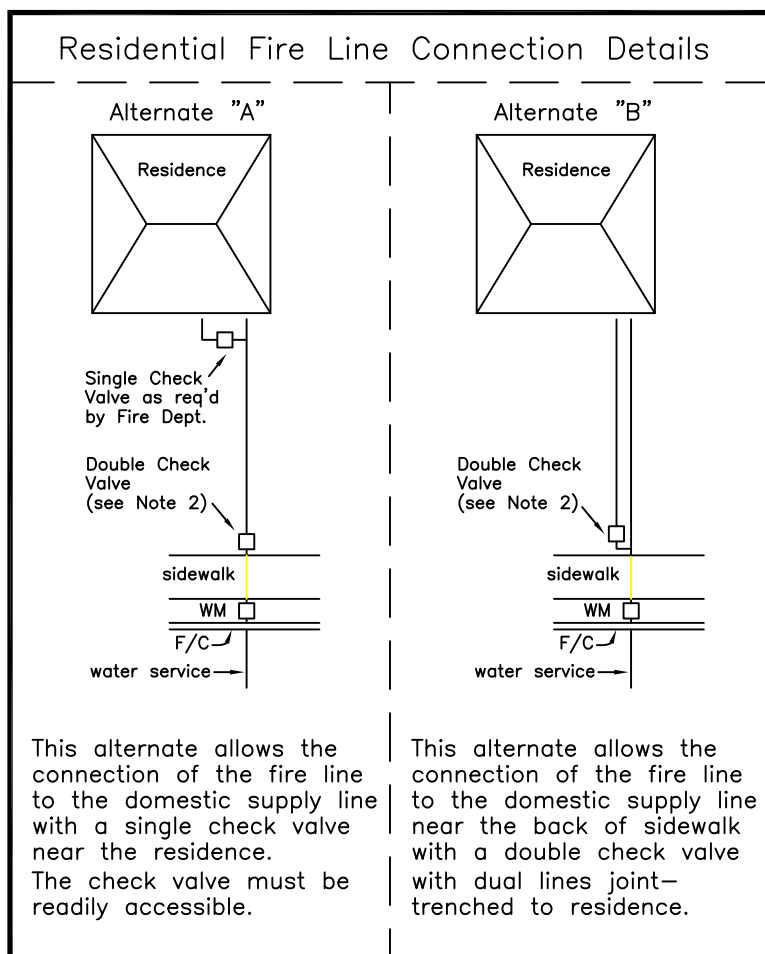

CITY OF SANTA ROSA

BELOW GROUND
DOUBLE CHECK VALVE
BACKFLOW DEVICE


SCALE: NONE DATE: June 2009
DWN: GC RR APPROVED FILE NO.
CHK: AA STD.- 875

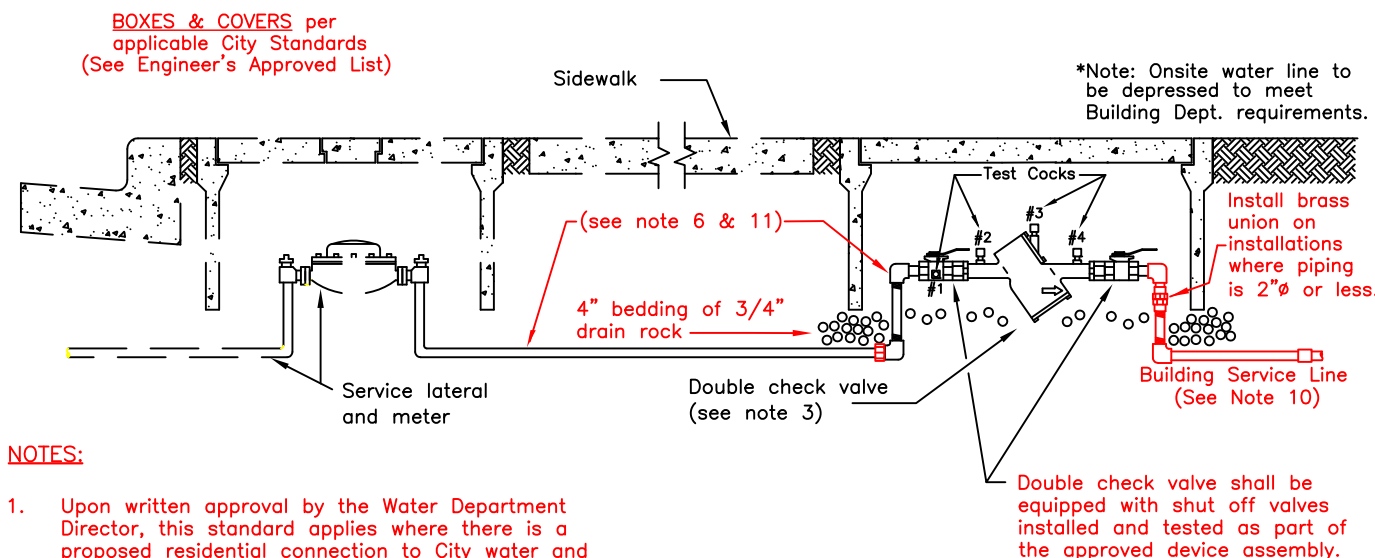

NOTES:

1. Upon written approval by the Water Department Director, this standard applies where there is a proposed residential connection to City water and there also may be an auxiliary water supply onsite, or where, in the opinion of the Water Department, a potential intermediate hazard may exist.
2. Upon written approval by the Fire Department, this standard applies where a residential fire sprinkler system is proposed. When approved, fire line to be installed in accordance with NFPA 13D.
3. Approved double check valve assemblies shall be from the "List Of Approved Backflow Prevention Devices" (Latest Revision) by the University of Southern California Foundation For Cross-Connection Control & Hydraulic Research.
4. Double check valve assemblies shall typically be installed inline with the water meter and just behind existing or proposed sidewalk. Where no sidewalk exists or installation at this location is not practical, assemblies shall be installed as close as possible to the water meter. Any conflicts shall be brought to the attention of the Engineer and final location shall be determined by the Water Department.
5. For 2"Ø and smaller use brass compression and/or threaded fittings and threaded nipples. For 3"Ø and larger use ductile iron fittings with mechanical joint connections below ground and flanged in the box.
6. Piping between property side shut off and backflow device shall be type "K" soft or hard temper copper for 1"Ø and smaller, type "K" hard temper copper for 1-1/2" and 2"Ø, and ductile iron for 3"Ø and larger. PVC will not be allowed. For all installations this piping shall be the same size as the meter unless otherwise approved by Water Department Engineering.
7. The device shall be centered in the box with a minimum of 2" clear between upper 90° elbows and box. The top of the highest point of the device shall be between 6" and 4" below the lid. Box shall not have "mouse holes" or removed "knock-outs". Installations where mouse holes, broken out sections or cracks have been grouted will be rejected.
8. M.I.P. x F.I.P. 90° elbows (street ells) are not allowed for use on this installation.
9. Provide brass caps or plugs for all test cocks.
10. Minimum 12" long threaded brass nipple for 2"Ø and smaller, and 24" long ductile iron pipe for 3"Ø and greater.
11. Compression fittings are not allowed on piping inside box

Typical Residential Fire Line Connection Details

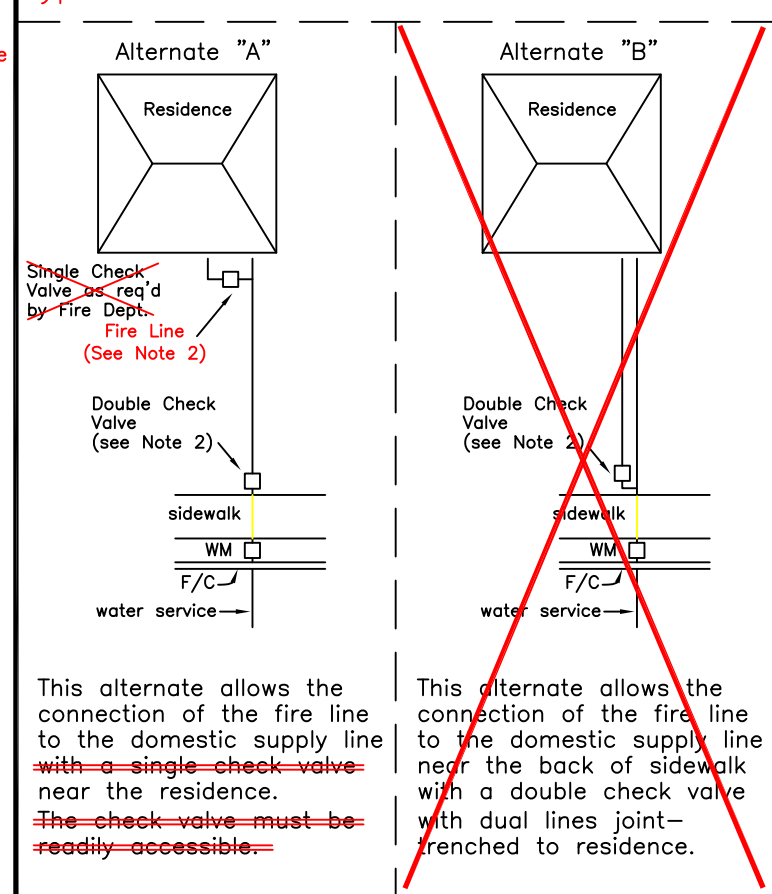


CITY OF SANTA ROSA

BELOW GROUND
DOUBLE CHECK VALVE
BACKFLOW DEVICE

SCALE: NONE DATE: June 2016
DWN: GC DK APPROVED FILE NO.
CHK: AA STD.- 875

Between meter and backflow device, all piping, valves, nipples, etc. shall be threaded brass or type "K" hard-temper copper for 2" or less, & shall be flanged ductile iron for 3" and greater. PVC pipe is not acceptable.

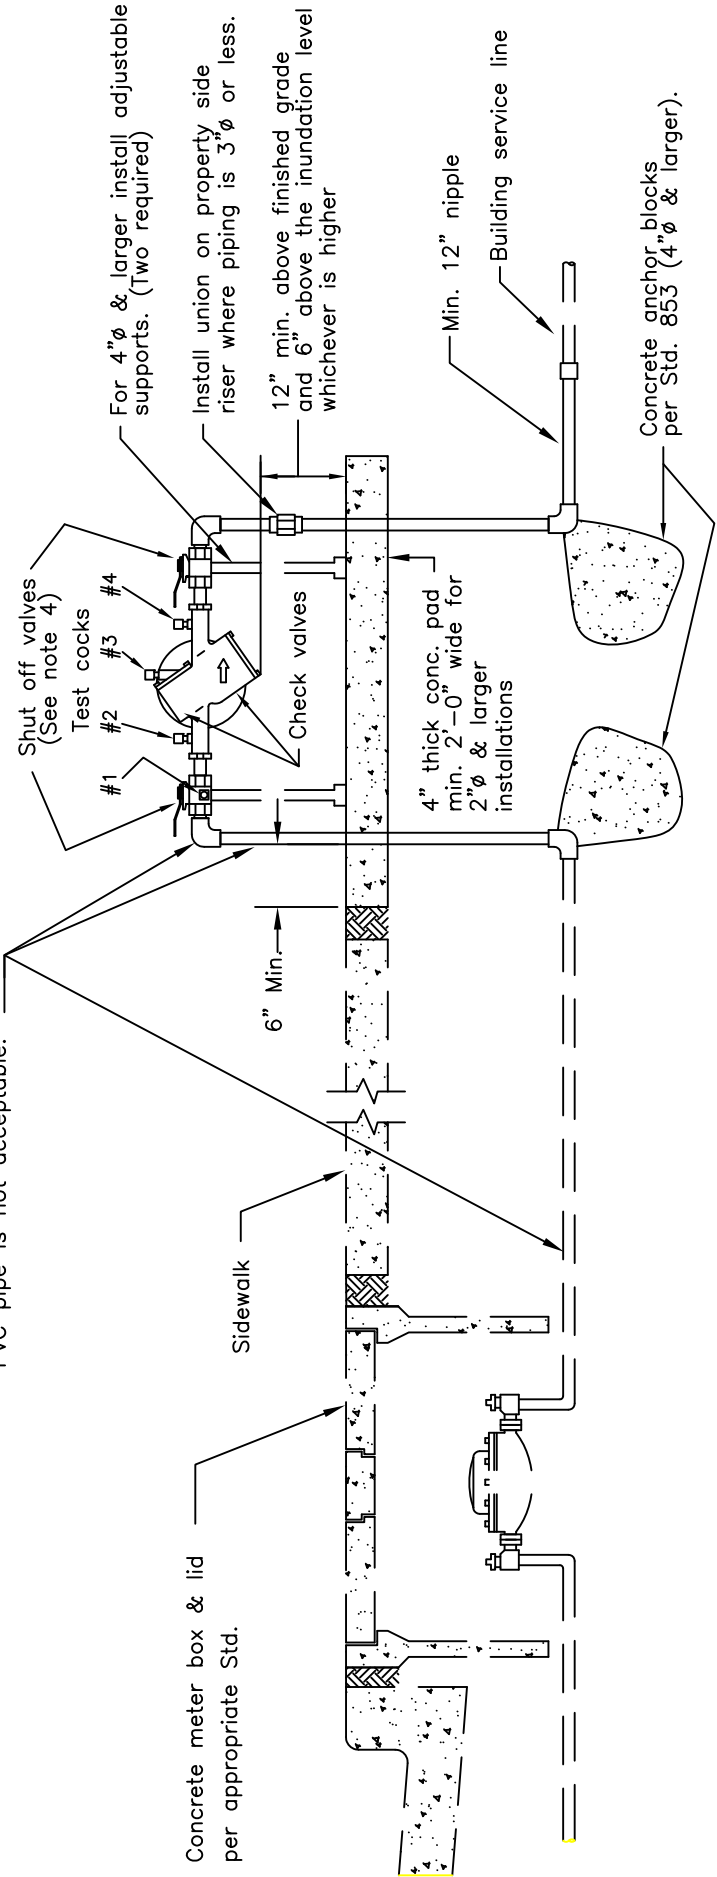


1. Reduced pressure type backflow devices shall be required as determined by the City Utilities Dept.
2. Approved reduced pressure backflow device shall be as shown on "List of approved backflow prevention devices" (of latest revision) by the University of Southern California Foundation For Cross-Connection Control & Hydraulic Research.
3. Backflow prevention devices shall be installed adjacent to and on property side of sidewalk where applicable. Where no sidewalk exists, the assembly shall be installed as close as possible to the water meter location.
4. A valve of the same size as the backflow device shall be installed on each side of the backflow prevention assembly. Valves 2" & less shall be ball valves, 3" & greater shall be resilient seat gate valves.

CITY OF SANTA ROSA		
REDUCED PRESSURE BACKFLOW DEVICE		
SCALE: NONE	DATE: June 2009	
DWN: GC BB CHK: AA	APPROVED	FILE NO. STD.- 876

5. Any cover or screening for the backflow prevention assembly must be approved by the Utilities Dept. prior to installation.
6. In limited space applications valves may be installed on risers min. 4" above grade.
7. The addition of spools must be approved by the City Inspector prior to installation.
8. The piping from the meter to the reduced pressure backflow device & the reduced pressure backflow device assembly itself must be the same size as the meter unless otherwise approved by the Director of Utilities.

Installations of 2" or less shall have type "K" hard temper copper or threaded brass piping and brass compression and/or threaded valves and fittings per applicable City standard. Installations of 3" and greater shall have AWWA C509 gate valves and ductile iron piping with mechanical joint fittings below grade, and flanged fittings above. PVC pipe is not acceptable. Type "K" soft temper copper may be used below grade from property side shut off to 90° elbow when tubing is 1" or smaller. No compression fittings on above ground piping.

Meter box & cover per applicable City standard

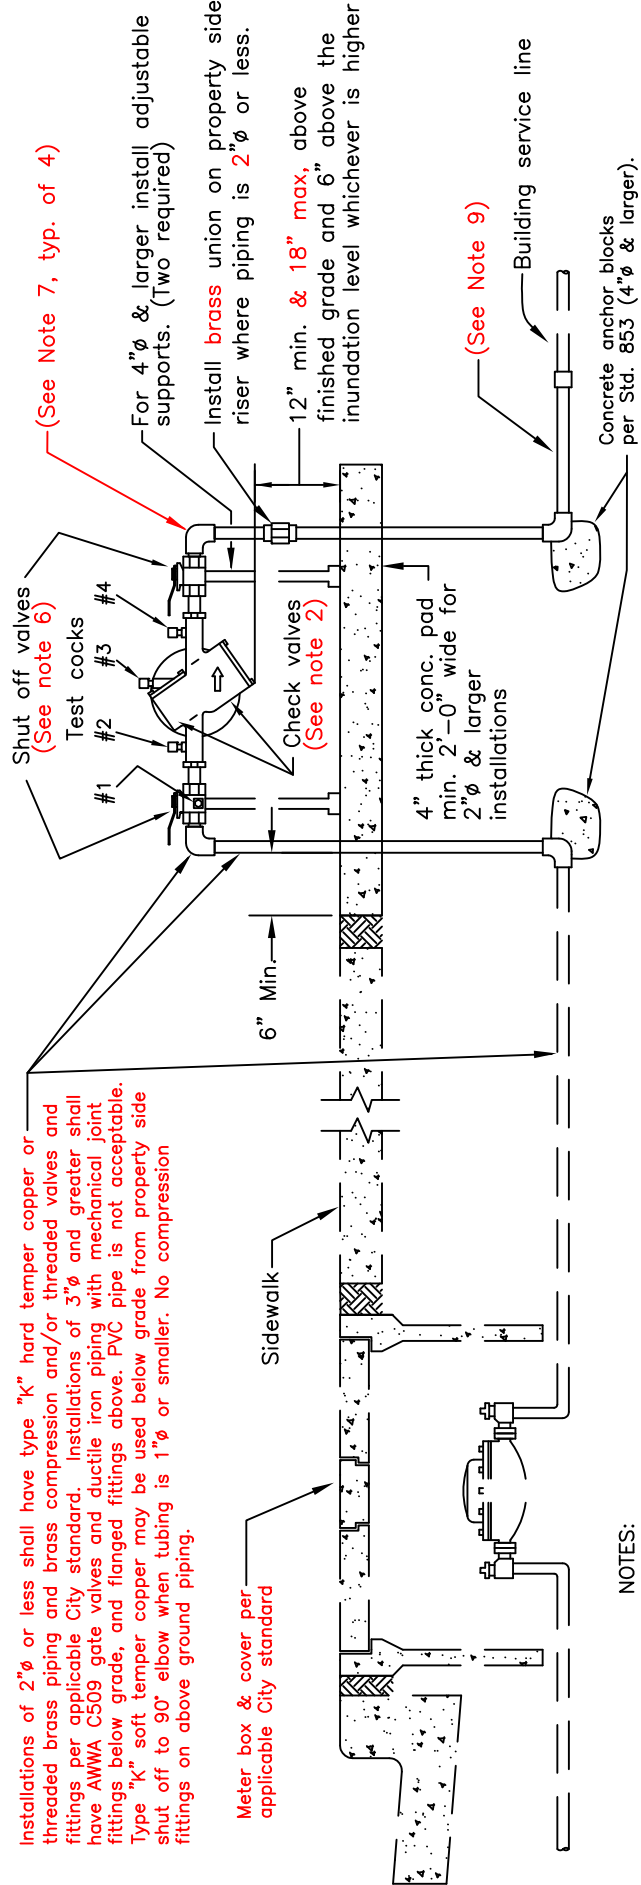

NOTES:

1. Reduced pressure type backflow assembly shall be required as determined by Santa Rosa Water.
2. Approved backflow assemblies shall be from the "List Of Approved Backflow Prevention Devices" (Latest Revision) by the University of Southern California Foundation For Cross-Connection Control & Hydraulic Research.
3. Reduced pressure type backflow assemblies are required on all services where, in the opinion of the Water Department, a potential intermediate hazard exists. Device to be installed on all services to properties with wells.
4. Reduced pressure backflow assemblies shall typically be installed inline with the water meter and just behind the sidewalk. Where no sidewalk exists or installation at this location is not practical, double check valve assemblies shall be installed as close as possible to the water meter in a location that is safe from traveled ways. Any conflicts shall be brought to the attention of the Engineer and final location shall be determined by the Water Department.
5. The piping from the meter to the device, and the device itself shall be the same size as the meter unless otherwise approved by the Water Department.
6. Valves 2" & less shall be brass ball valves, and valves 3" and greater shall be resilient seat gate valves. When shut off valves on approved backflow assemblies are installed on their vertical risers, the bottom of the valves shall be a minimum of 4" above finished grade.
7. M.I.P. x F.I.P. 90° elbows (street ells) are not allowed for use on this installation.
8. Provide brass caps or plugs for all test cocks.
9. Minimum 12" long threaded brass nipple for 2" and smaller, and 24" long ductile iron pipe for 3" and greater.
10. Any enclosure, cover or screening for the backflow assembly must first be approved by the Water Department prior to installation.
11. Where multiple devices are installed side by side they shall have a minimum separation of 12".
13. Where multiple devices are installed side by side there shall be a minimum of 12" between devices. Where enclosures are installed over devices, devices shall be centered within, and there shall be a minimum of 4" between enclosures.


CITY OF SANTA ROSA		
REDUCED PRESSURE BACKFLOW DEVICE		
SCALE: NONE	DATE: June 2016	
DWN: GC DK CHK: AA	APPROVED	FILE NO. STD.- 876

VALVE BOXES:
(See Engineer's approved list)

STEM EXTENSION FABRICATION NOTES

1. All welds to riser shaft shall be fillet weld all around as specified below.
2. All steel required for riser fabrication shall be structural steel per ASTM A36.

Precast valve box set flush with street surface with cast iron ring and cover marked "WATER".

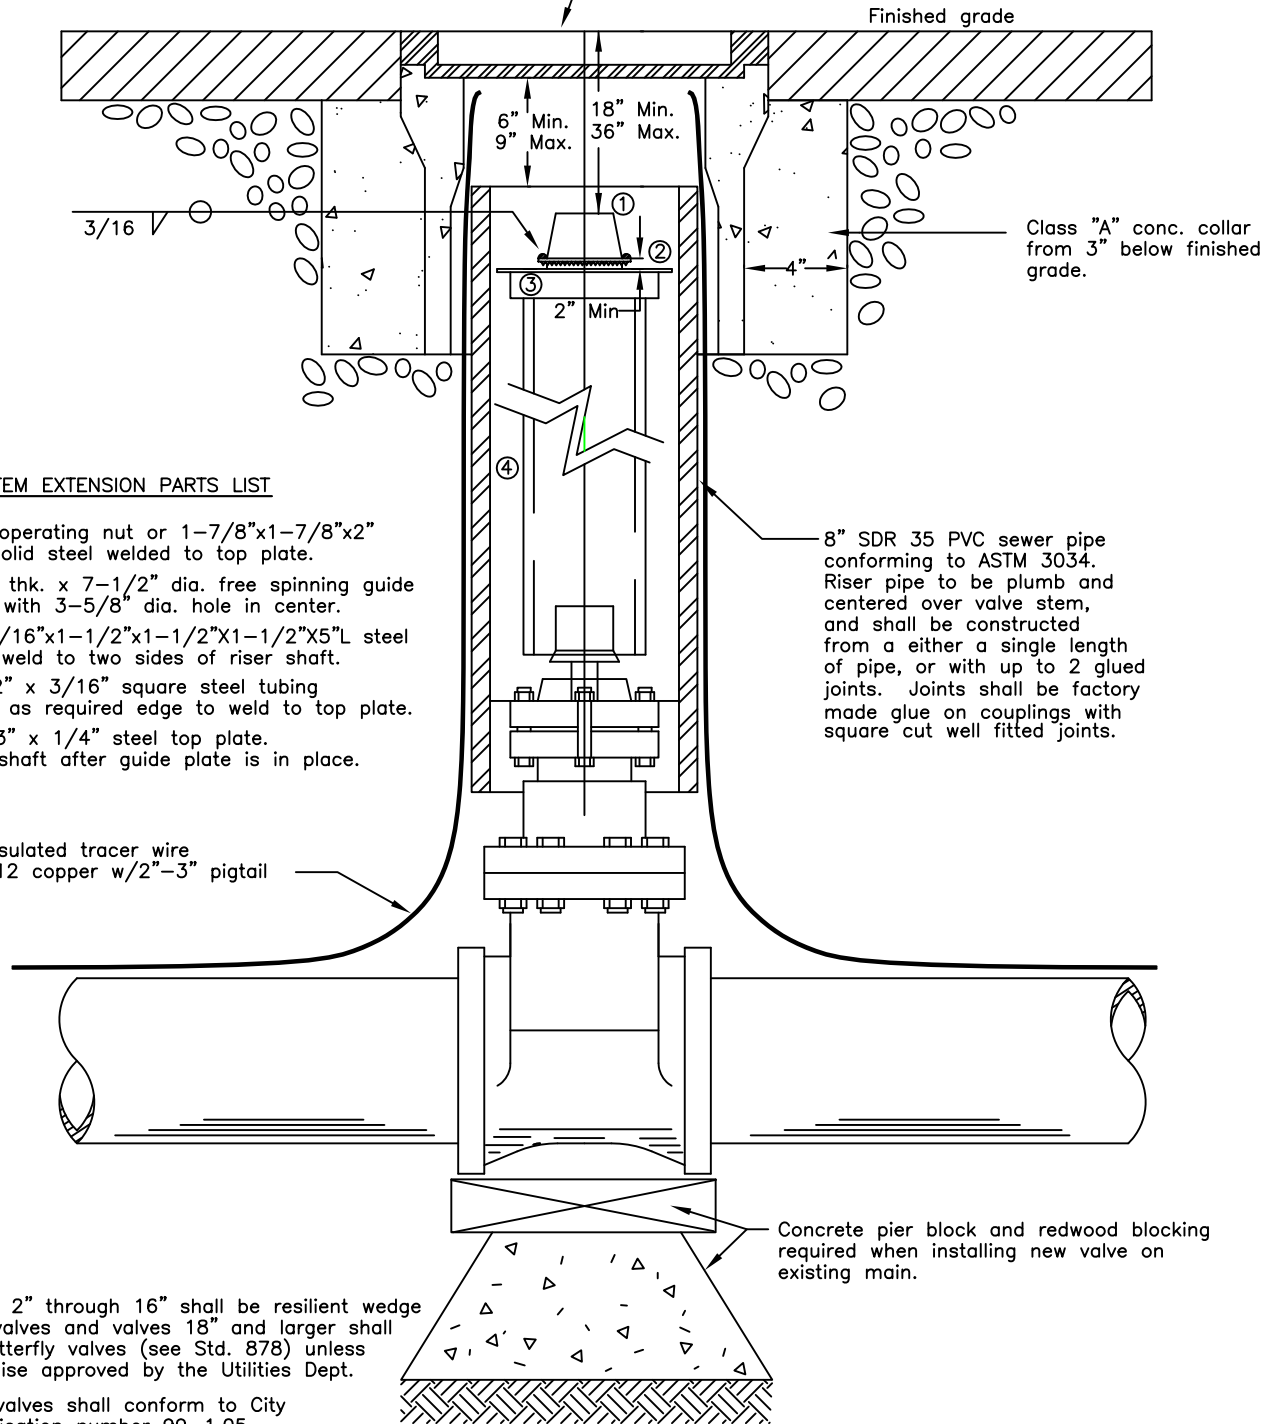

VALVE STEM EXTENSION PARTS LIST

- ① Valve operating nut or 1-7/8"x1-7/8"x2" high solid steel welded to top plate.
- ② 3/16" thk. x 7-1/2" dia. free spinning guide plate, with 3-5/8" dia. hole in center.
- ③ Two 3/16"x1-1/2"x1-1/2"x1-1/2"x5"L steel angle weld to two sides of riser shaft.
- ④ 2-1/2" x 3/16" square steel tubing length as required edge to weld to top plate.
- ⑤ 3" x 3" x 1/4" steel top plate.
Riser shaft after guide plate is in place.

8" SDR 35 PVC sewer pipe conforming to ASTM 3034. Riser pipe to be plumb and centered over valve stem, and shall be constructed from a either a single length of pipe, or with up to 2 glued joints. Joints shall be factory made glue on couplings with square cut well fitted joints.

Insulated tracer wire
#12 copper w/2"-3" pigtail

NOTES

1. Valves 2" through 16" shall be resilient wedge gate valves and valves 18" and larger shall be butterfly valves (see Std. 878) unless otherwise approved by the Utilities Dept.
2. Gate valves shall conform to City Specification number 99-1.05.
3. All external bolts and nuts on valves shall be 304 stainless steel or the entire valve shall be wrapped tightly with polyethylene film held securely with adhesive tape.
4. If valve is installed so that the top of the operating nut is less than 30" below finished grade, the valve stem riser is not required.
5. For installation of butterfly valve and tapping valve, see Std. 878.

CITY OF SANTA ROSA

GATE VALVE

SCALE: NONE	DATE: June 2009
-------------	-----------------


DWN: TBM BB	APPROVED	FILE NO
CHK: AA		STD - 8

VALVE BOXES:
(See Engineer's approved list)

VALVE STEM RISER FABRICATION NOTES

1. All welds to riser shaft shall be fillet welds all around as specified below.
2. All steel required for riser fabrication shall be structural steel per ASTM A36.

Precast valve box set flush with street surface with cast iron ring and cover marked "WATER".

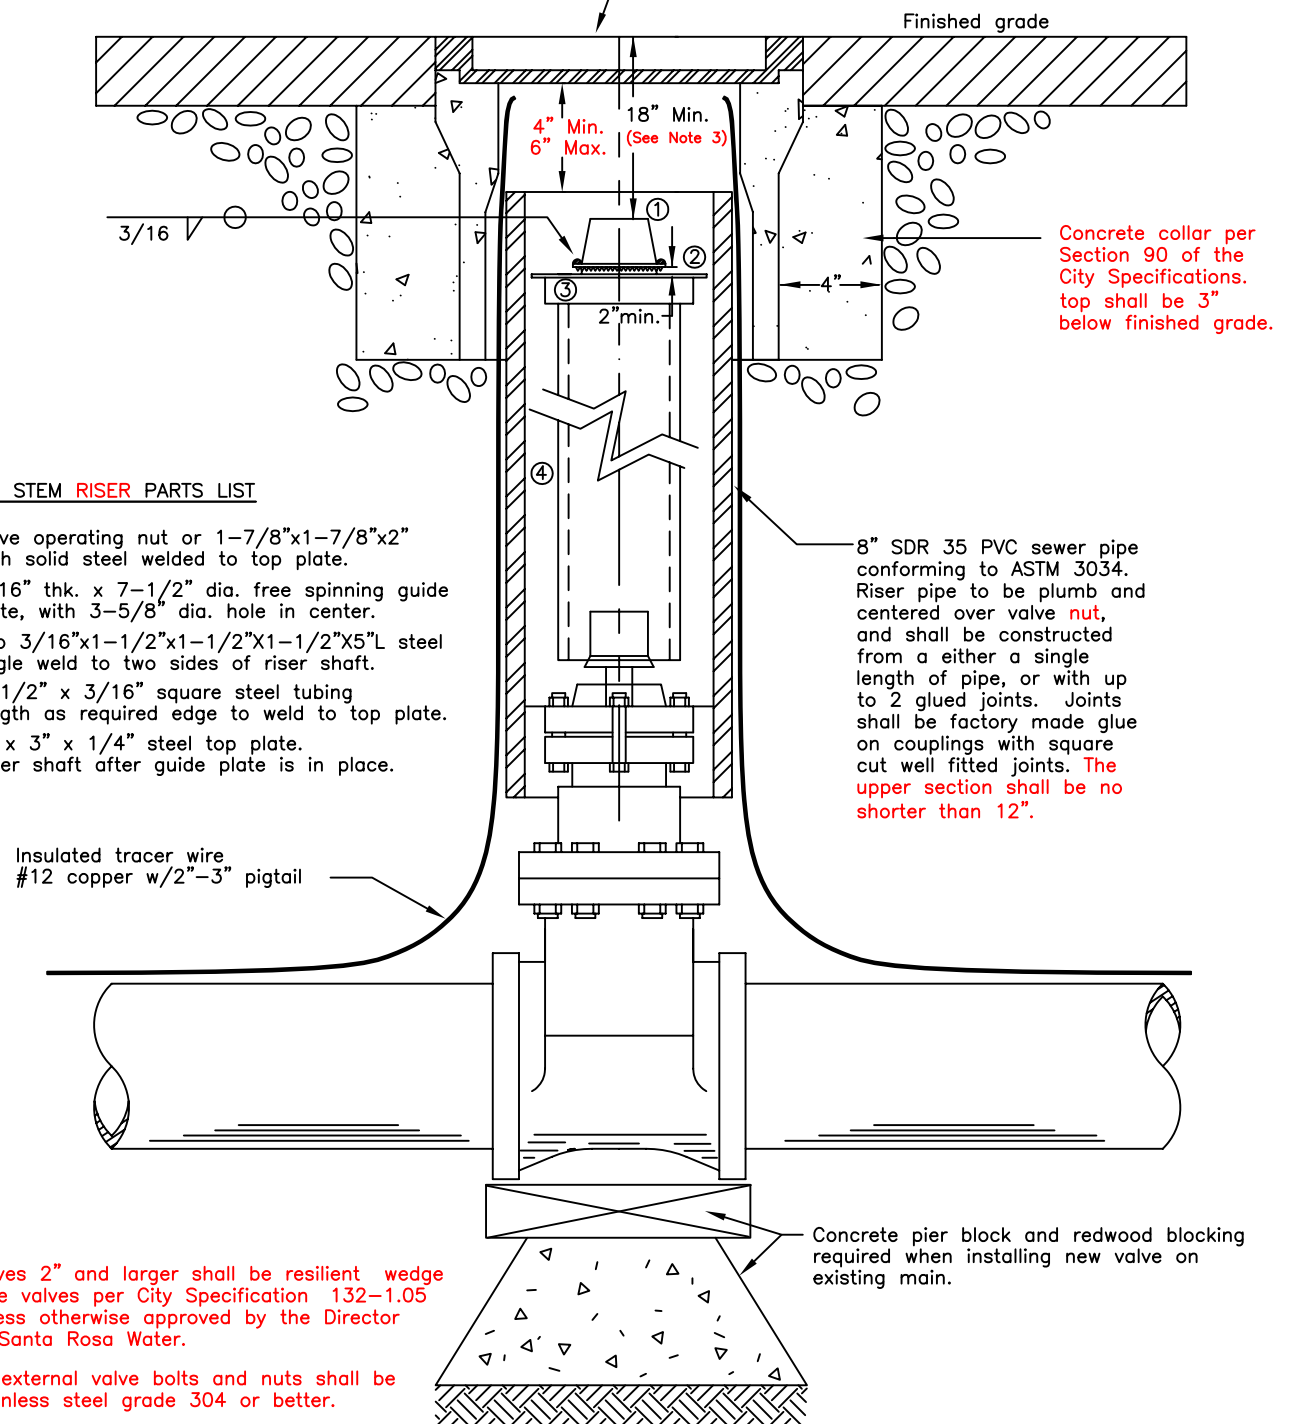


VALVE STEM RISER PARTS LIST

- ① Valve operating nut or 1-7/8"x1-7/8"x2" high solid steel welded to top plate.
- ② 3/16" thk. x 7-1/2" dia. free spinning guide plate, with 3-5/8" dia. hole in center.
- ③ Two 3/16"x1-1/2"x1-1/2"x1-1/2"x5"L steel angle weld to two sides of riser shaft.
- ④ 2-1/2" x 3/16" square steel tubing length as required edge to weld to top plate.
- ⑤ 3" x 3" x 1/4" steel top plate.
Riser shaft after guide plate is in place.

8" SDR 35 PVC sewer pipe conforming to ASTM 3034. Riser pipe to be plumb and centered over valve **nut**, and shall be constructed from a either a single length of pipe, or with up to 2 glued joints. Joints shall be factory made glue on couplings with square cut well fitted joints. **The upper section shall be no shorter than 12".**

Insulated tracer wire
#12 copper w/2"-3" pigtail

NOTES

1. Valves 2" and larger shall be resilient wedge gate valves per City Specification 132-1.05 unless otherwise approved by the Director of Santa Rosa Water.
 2. All external valve bolts and nuts shall be stainless steel grade 304 or better.
 3. Where valve is installed so that the top of the operating nut is 36" or less below finished grade, the valve stem riser is not required. Where valve stem riser is required the operating nut of the riser shall be 18" to 24" below grade. Risers of 12" in length or shorter shall not be used.
 4. Where top of operating nut of valve will be 6" or less below finished grade, horizontal gate valve shall be installed unless otherwise approved.
 5. For installation of tapping valve, or butterfly valve as approved by the Director of Santa Rosa Water, installation shall be per City Standard 878.
- 

- Concrete pier block and redwood blocking required when installing new valve on existing main.


CITY OF SANTA ROSA

GATE VALVE

SCALE: NONE	DATE: Apr. 2016
-------------	-----------------

DWN: TBM BB	APPROVED	FILE NO.
CHK: AA		STD - 877

Install Flanged Butterfly valve with two flanged by mechanical adapters on Class 200 PVC.

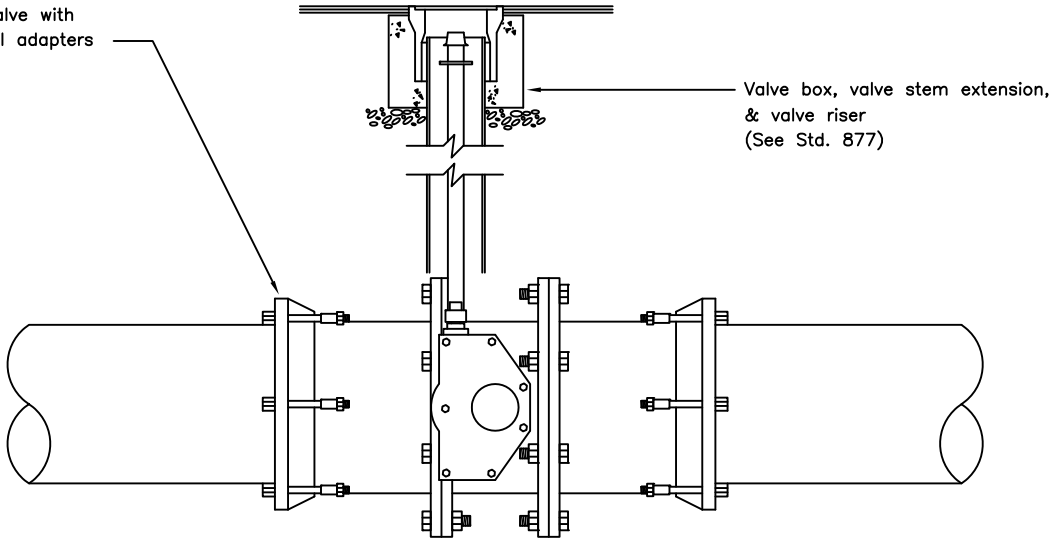


All Butterfly valves shall conform to City Specification Number 99-1.06

Valve box, valve stem extension, & valve riser (See Std. 877)

BUTTERFLY VALVE

To be used on pipe 18" and larger

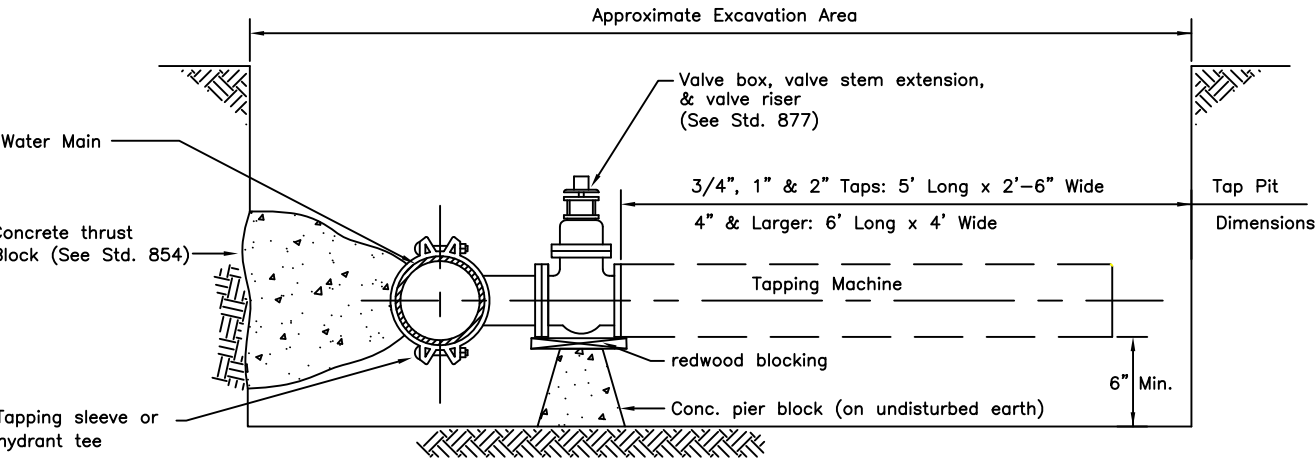

TAPPING SLEEVE & VALVE

TAPPING SLEEVES

(See Engineer's Approved List for Std. 866/867)

NOTES:

1. All external bolts and nuts on valves shall be 304 stainless steel or the entire valve shall be wrapped tightly with polyethylene film held securely with adhesive tape.
2. Taps shall be made by City forces. Schedule through the Utilities Engineering Dept.


CITY OF SANTA ROSA

BUTTERFLY VALVE AND
TAPPING VALVE

SCALE:	NONE	DATE:	June 2009
DWN: GC BB	APPROVED	FILE NO.	
CHK: AA		STD.-	878

~~Install Flanged Butterfly valve with two flanged by mechanical adapters on Class 200 PVC.~~

Install mechanical joint or flanged butterfly valve conforming to City Specification 132-1.06, and per approval.

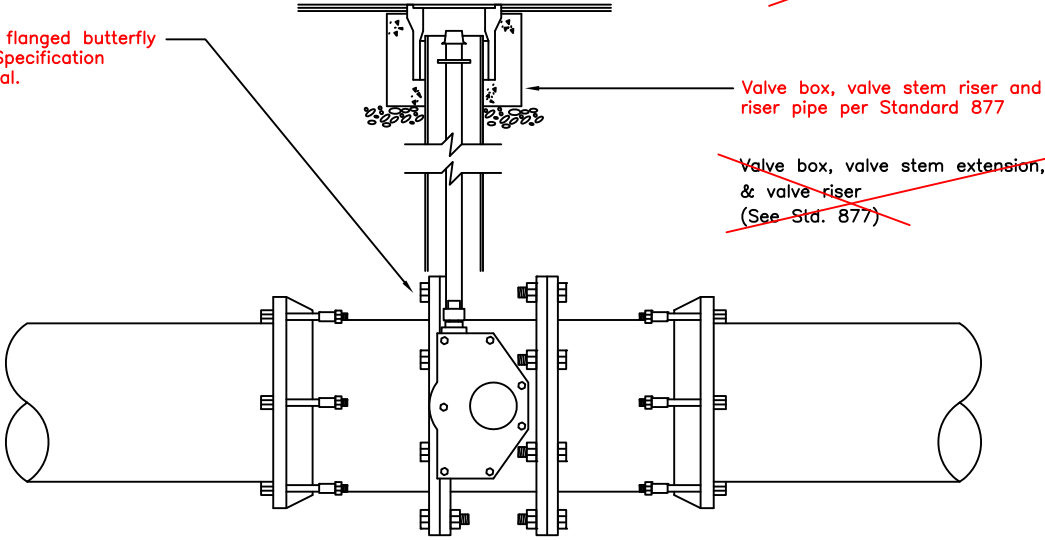

~~All Butterfly valves shall conform to City Specification Number 99-1.06~~


Valve box, valve stem riser and riser pipe per Standard 877

~~Valve box, valve stem extension, & valve riser (See Std. 877)~~

BUTTERFLY VALVE

To be used only upon approval from the Director of Santa Rosa Water

~~To be used on pipe 18" and larger~~

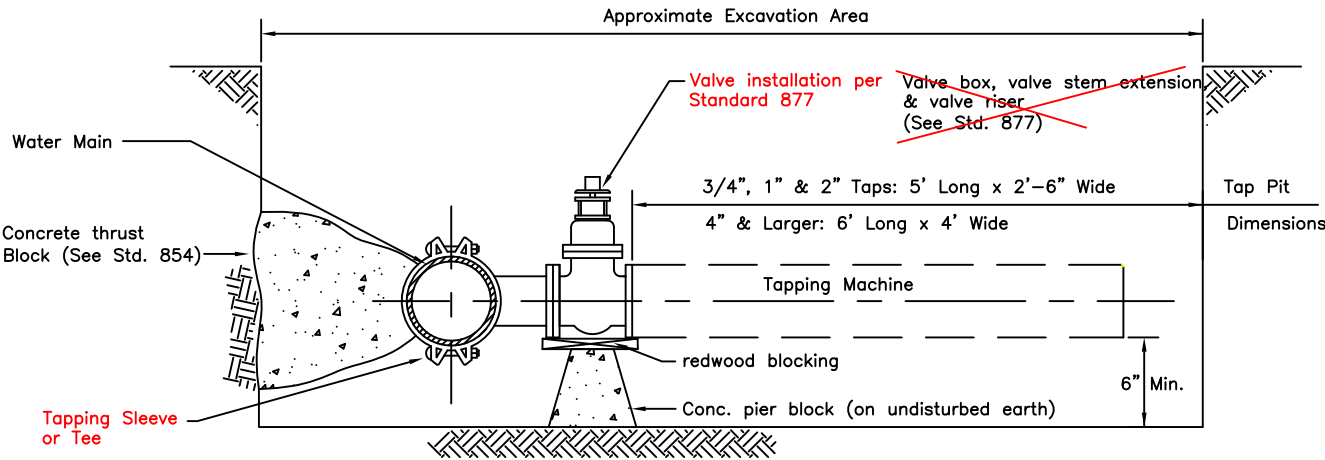

~~Tapping sleeve or hydrant tee~~

TAPPING SLEEVE & VALVE

TAPPING SLEEVES

(See Engineer's Approved List for Std. 866/867)


NOTES:

1. All external bolts and nuts on valve shall be stainless steel grade 304 or better.
2. Taps shall be scheduled through, and made by Santa Rosa Water personnel only.
- ~~1. All external bolts and nuts on valves shall be 304 stainless steel or the entire valve shall be wrapped tightly with polyethylene film held securely with adhesive tape.~~
- ~~2. Taps shall be made by City forces. Schedule through the Utilities Engineering Dept.~~

CITY OF SANTA ROSA


BUTTERFLY VALVE AND
TAPPING VALVE

SCALE:	NONE	DATE:	Apr. 2016
DWN: GC BB	APPROVED	FILE NO.	
CHK: AA		STD.-	878

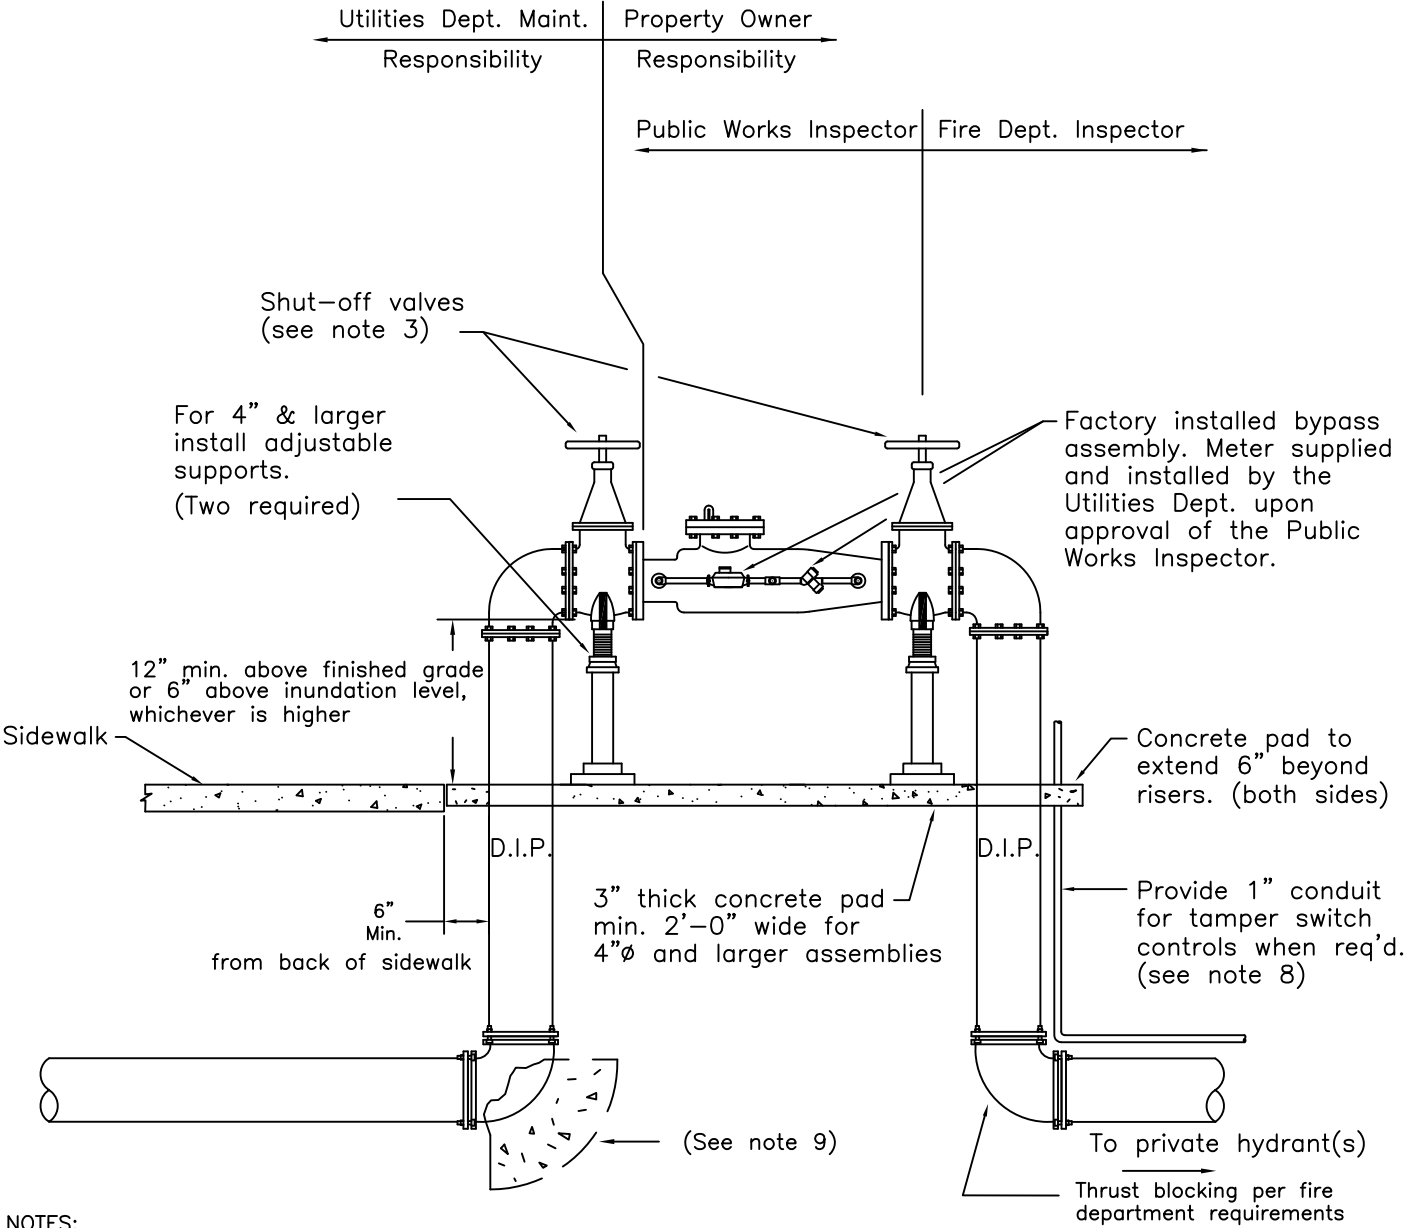


- NOTES:
1. Above ground single check detector valve assemblies may only be used on fire lines serving private fire hydrants. Where sprinklers are served, use double check detector per Std. 880. When above ground installation is not possible due to site constraints, use single check detector in vault per Std. 879.
 2. See Engineer's Approved list for Std. 879 for approved Detector checks.
 3. Shut-off valves to be resilient wedge type O.S. & Y. and will be chained and padlocked in the open position.
 4. All test valves shall be fitted with 1/4" female test cocks.
 5. Detector check assembly shall be located as close as possible to the sidewalk or public right-of-way.
 6. Any cover or screening for this assembly must have both Fire Department & Utility Department approval prior to installation.
 7. Detector check shall be the same size as the fire line except a 10" detector check assembly is permitted when a 12" fire line is required.
 8. The installation shall be provided with electronic supervision monitoring when required by the Fire Department.
 9. Restrained joints are required for all new construction from gate valve to 90° ell. Thrust blocks are only required where existing services are being modified and restrained joints are not used.

CITY OF SANTA ROSA		
ABOVE GROUND SINGLE CHECK DETECTOR ASSEMBLY		
SCALE: NONE	DATE: June 2009	
DWN: GC BB	APPROVED	FILE NO.
CHK: AA		STD.- 888

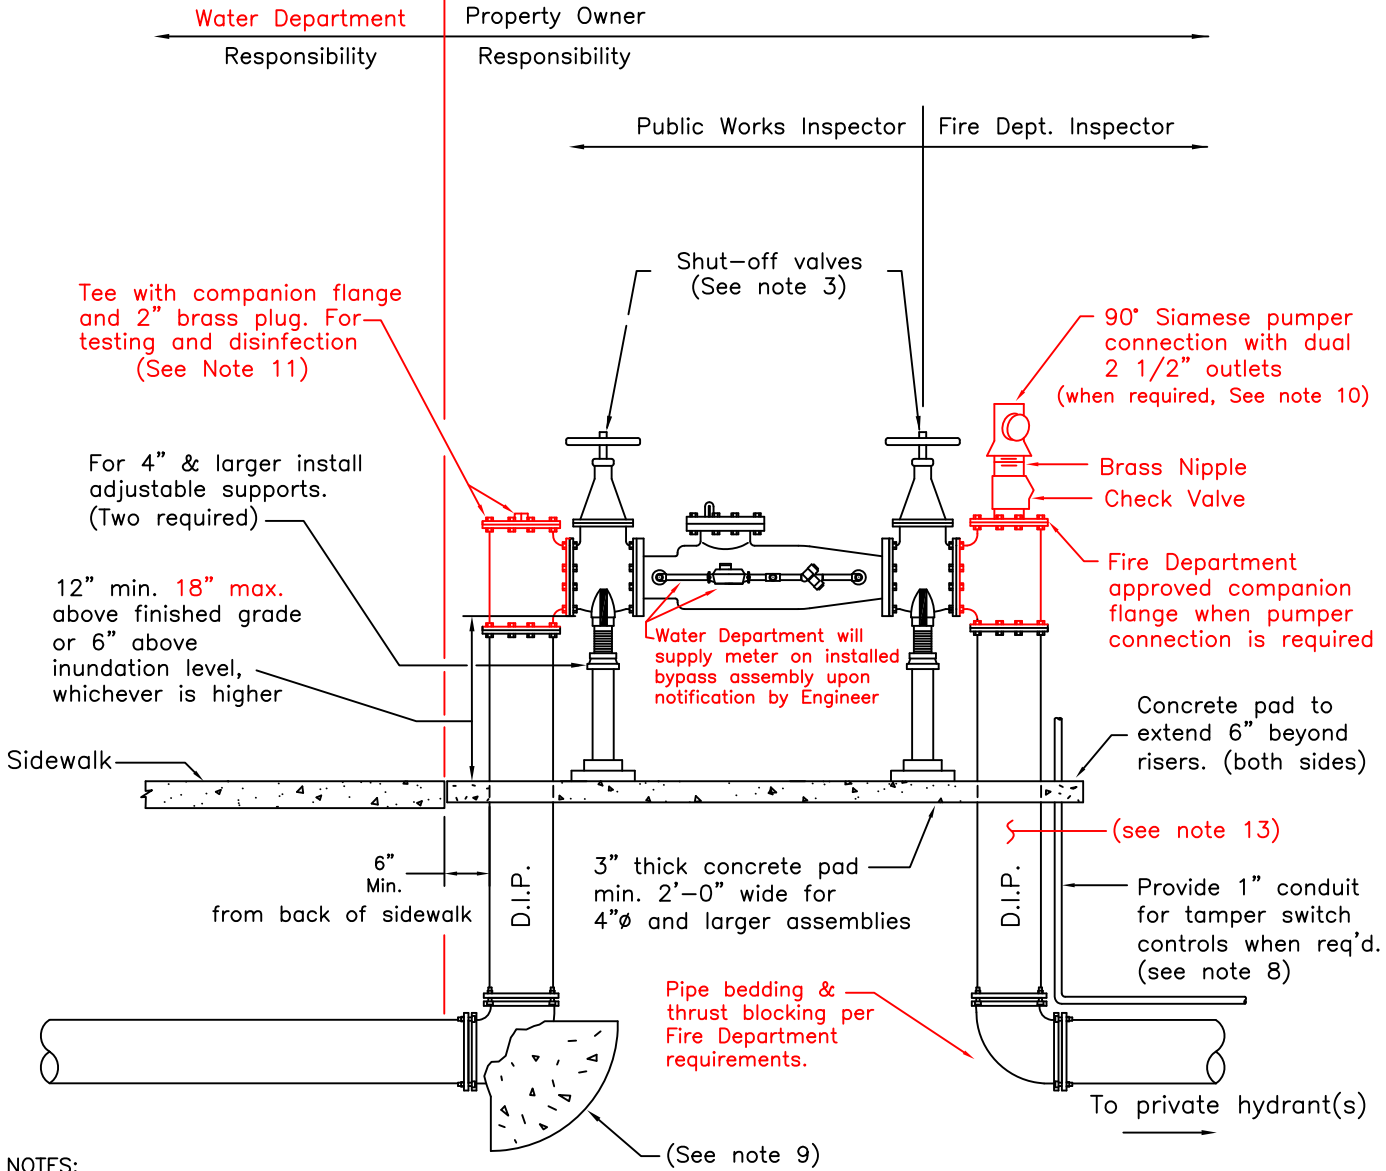

- NOTES:
1. Above ground single check detector valve assemblies may only be used on fire lines serving private fire hydrants. Where sprinklers are served, use double check detector per STD. 880. Where above ground installation is not possible due to site constraints, in the opinion of the Engineer, a below ground single check detector per STD. 888 may be allowed.
 2. See Engineer's Approved list for approved detector check devices.
 3. Shut off valves shall be resilient wedge type O.S. & Y. valves, and shall be chained and padlocked in the open position by owner.
 4. All test valves shall be fitted with 1/4" female test cocks.
 5. Detector check assembly shall be located as close as possible to back of sidewalk or public right-of-way.
 6. Any cover or screening for this device must have both the Fire and Water Department's approval prior to installation.
 7. Detector check shall be the same size as the fire line except a 10" detector check assembly is permitted when a 12" fire line is required.
 8. The installation shall be provided with electronic supervision monitoring when required by the Fire Department.
 9. Restrained joints are required for all new construction from gate valve to 90° elbow. Thrust blocks are only required where existing service is being modified and restrained joints are not used. Thrust block behind tee or tapping sleeve is required on all installations.
 10. Must have specific approval of the Fire Dept. prior to installation.
 11. For filling and disinfection when service has been tapped or cut-in on existing main, add 2" piping as needed so "fill line" is a minimum of 6" above all other piping. Install brass plug after disinfection and testing.
 12. Regardless of detector device orientation, bypass meter shall be installed to set horizontally at a location easily accessed and read. See City Standard 885.
 13. Contractor shall provide protection from corrosion in accordance with Fire Department requirements.

CITY OF SANTA ROSA		
ABOVE GROUND SINGLE CHECK DETECTOR ASSEMBLY		
SCALE: NONE	DATE: June 2016	
DWN: GC DK	APPROVED	FILE NO.
CHK: RS		STD.- 879

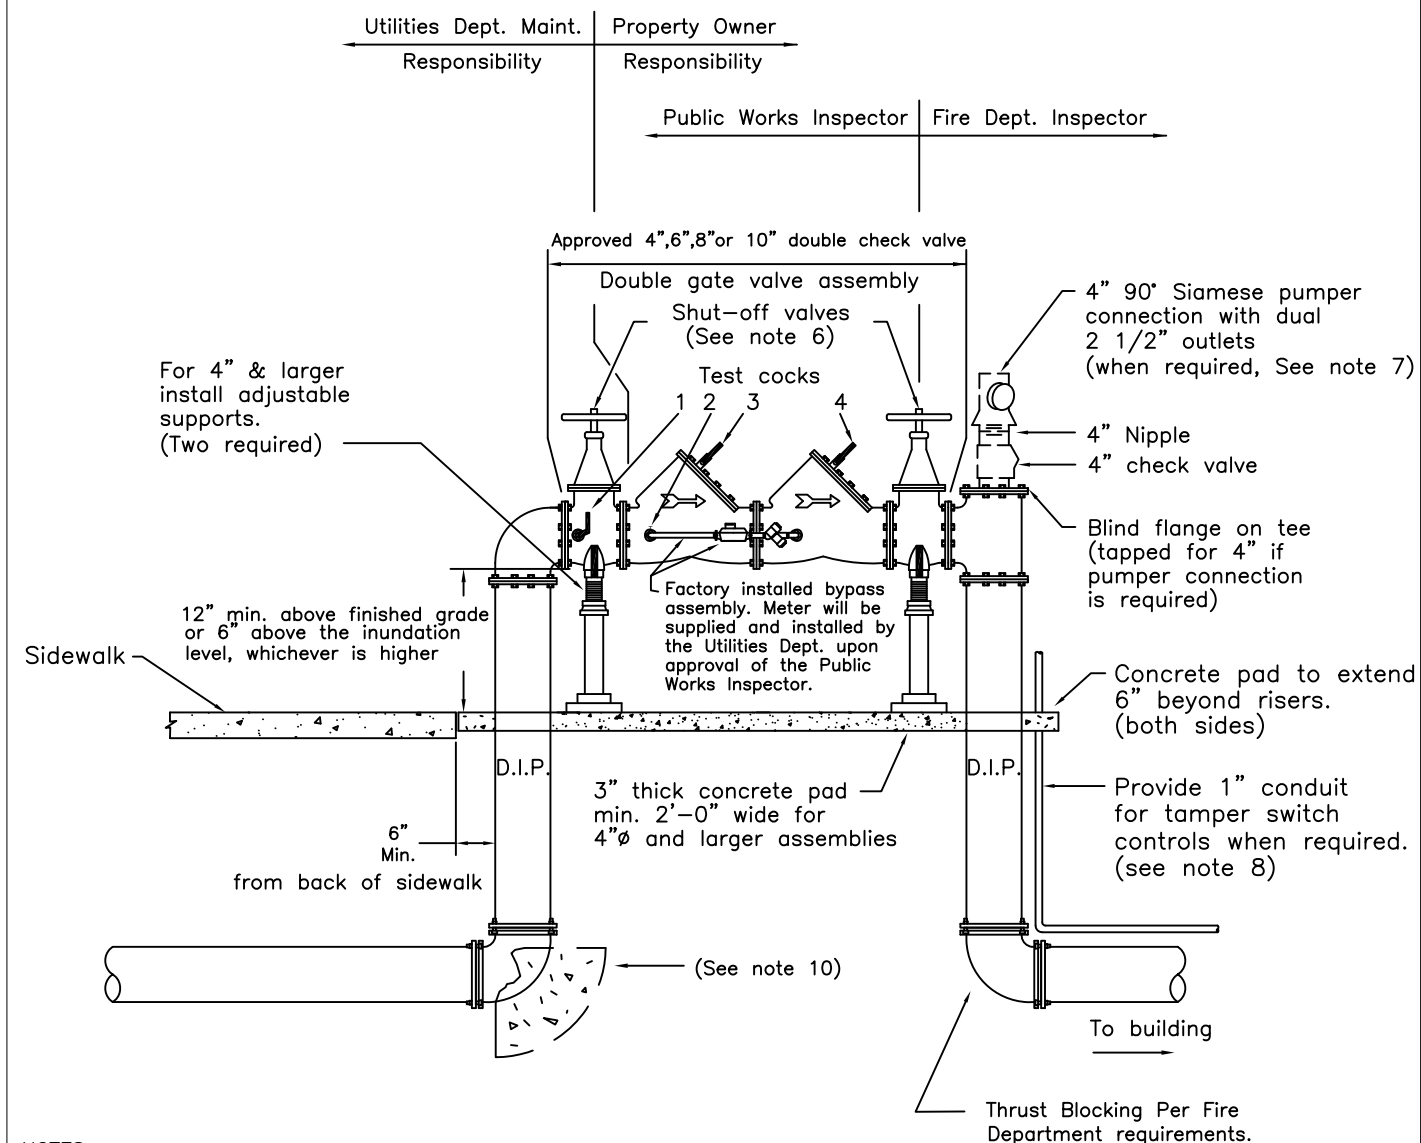


- NOTES:
- This Standard is required for:
 - all connections serving commercial fire sprinkler systems.
 - any fire line connections to properties with auxiliary water supplies.
 - sites with multiple fire line connections to the City water system.
 - Approved double check detector backflow assemblies shall be shown on "List of approved backflow devices" of latest revision, by the University of Southern California Foundation for Cross Connection Control & Hydraulic Research.
 - All test valves shall be fitted with 1/4" female test cocks.
 - Double check detector assembly shall be located as close as possible to the sidewalk or public right-of-way.
 - Any cover or screening for this assembly must have both Fire Department & Utility Department approval prior to installation.
 - Shut-off valves to be resilient wedge type O.S. & Y and will be chained and padlocked in the open position.
 - Must have specific approval of the Fire Dept. prior to installation.
 - The installation shall be provided with electronic supervision monitoring when required by the Fire Department.
 - Double check detector shall be the same size as the fire line except when a 12" fire line is required, then a 10" double detector check backflow assembly is required.
 - Restrained joints are required for all new construction from gate valve to 90° ell. Thrust blocks are only required where existing services are being modified and restrained joints are not used.

CITY OF SANTA ROSA

DOUBLE CHECK DETECTOR FIRE LINE BACKFLOW ASSEMBLY

SCALE:	NONE	DATE:	June 2009
DWN: GC BB	APPROVED	FILE NO.	STD.- 880
CHK: AA			


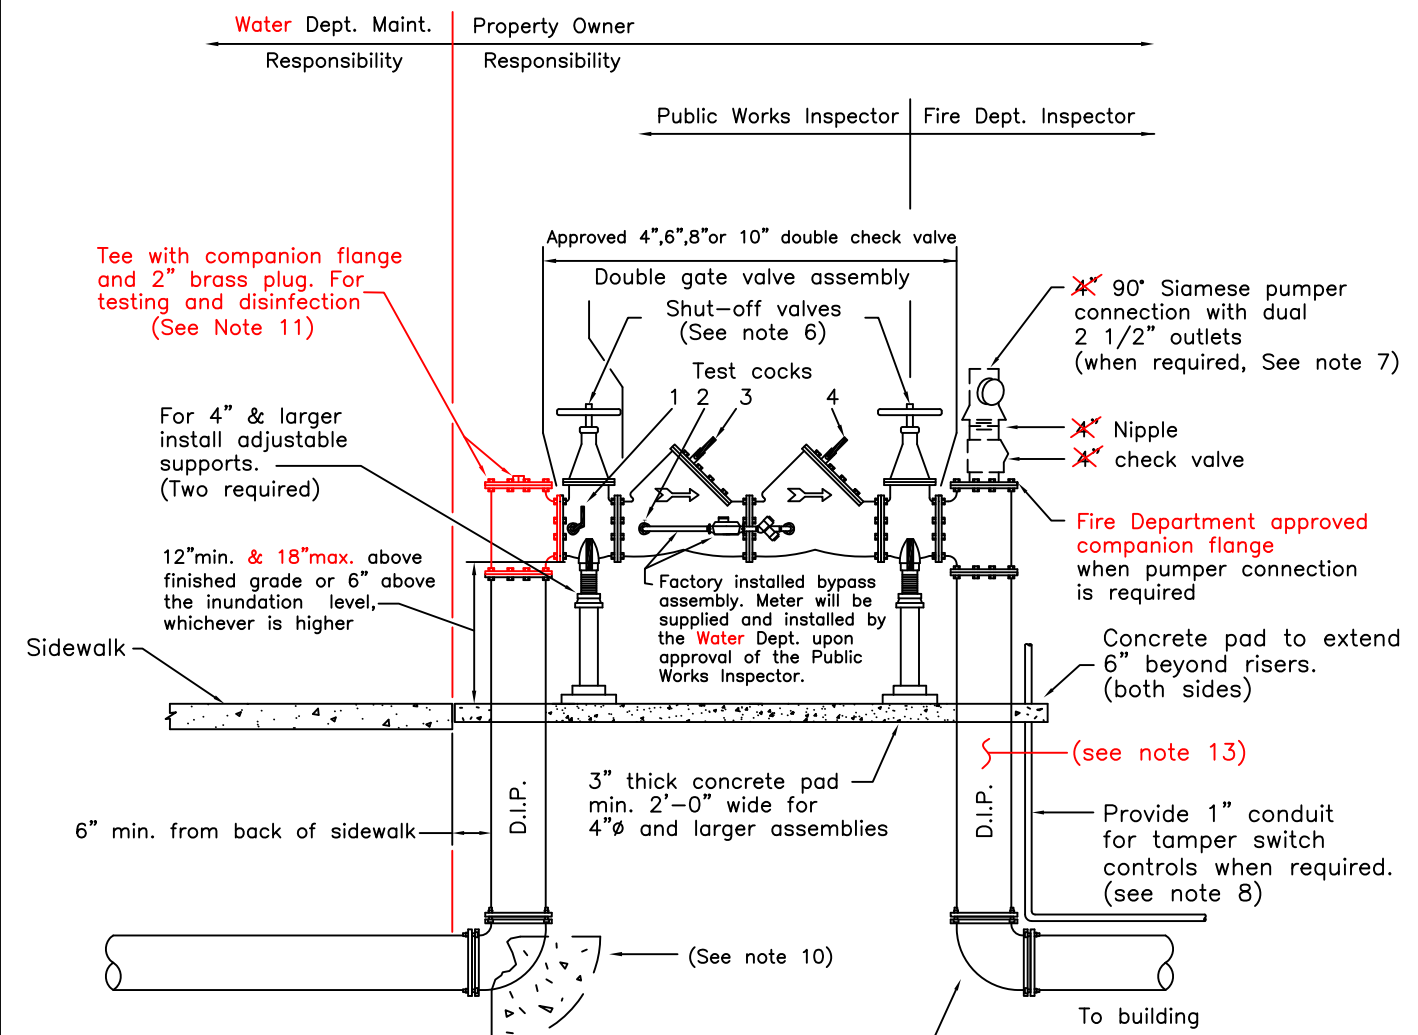


- NOTES:
- This Standard is required for:
 - all connections serving commercial fire sprinkler systems.
 - any fire line connections to properties with auxiliary water supplies.
 - sites with multiple fire line connections to the City water system.
 - Approved double check detector backflow assemblies shall be shown on "List of approved backflow devices" of latest revision, by the University of Southern California Foundation for Cross Connection Control & Hydraulic Research.
 - All test valves shall be fitted with 1/4" female test cocks.
 - Double check detector assembly shall be located as close as possible to the sidewalk or public right-of-way.
 - Any cover or screening for this assembly must have both the Fire and Water Department's approval prior to installation.
 - Shut-off valves shall be resilient wedge type O.S. & Y. valves. Valves are to be chained and padlocked by device owner in the open position.
 - Must have specific approval of the Fire Dept. prior to installation.
 - The installation shall be provided with electronic supervision monitoring when required by the Fire Department.
 - Double check detector shall be the same size as the fire line except when a 12" fire line is required, then a 10" double detector check backflow assembly is required.
 - Restrained joints are required for all new construction from gate valve to 90° elbow. Thrust blocks are only required where existing service is being modified and restrained joints are not used. Thrust block behind tee or tapping sleeve is required on all installations.
 - For filling and disinfection when service has been tapped or cut-in on existing main, add 2" piping as needed so "fill line" is a minimum of 6" above all other piping. Install brass plug after disinfection and testing.
 - Regardless of detector device orientation, bypass meter shall be installed to set horizontally at a location easily accessed and read. See City Standard 885.
 - Contractor shall provide protection from corrosion in accordance with Fire Department requirements.

CITY OF SANTA ROSA

DOUBLE CHECK DETECTOR FIRE LINE BACKFLOW ASSEMBLY

SCALE:	NONE	DATE:	FEB. 2016
DWN: DK	APPROVED	FILE NO.	STD.- 880
CHK: RS			

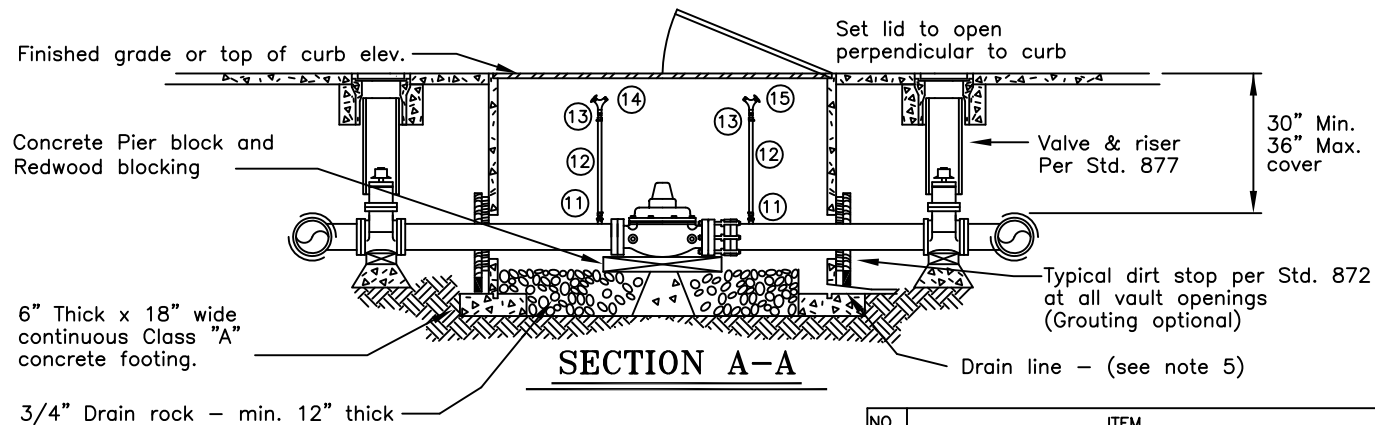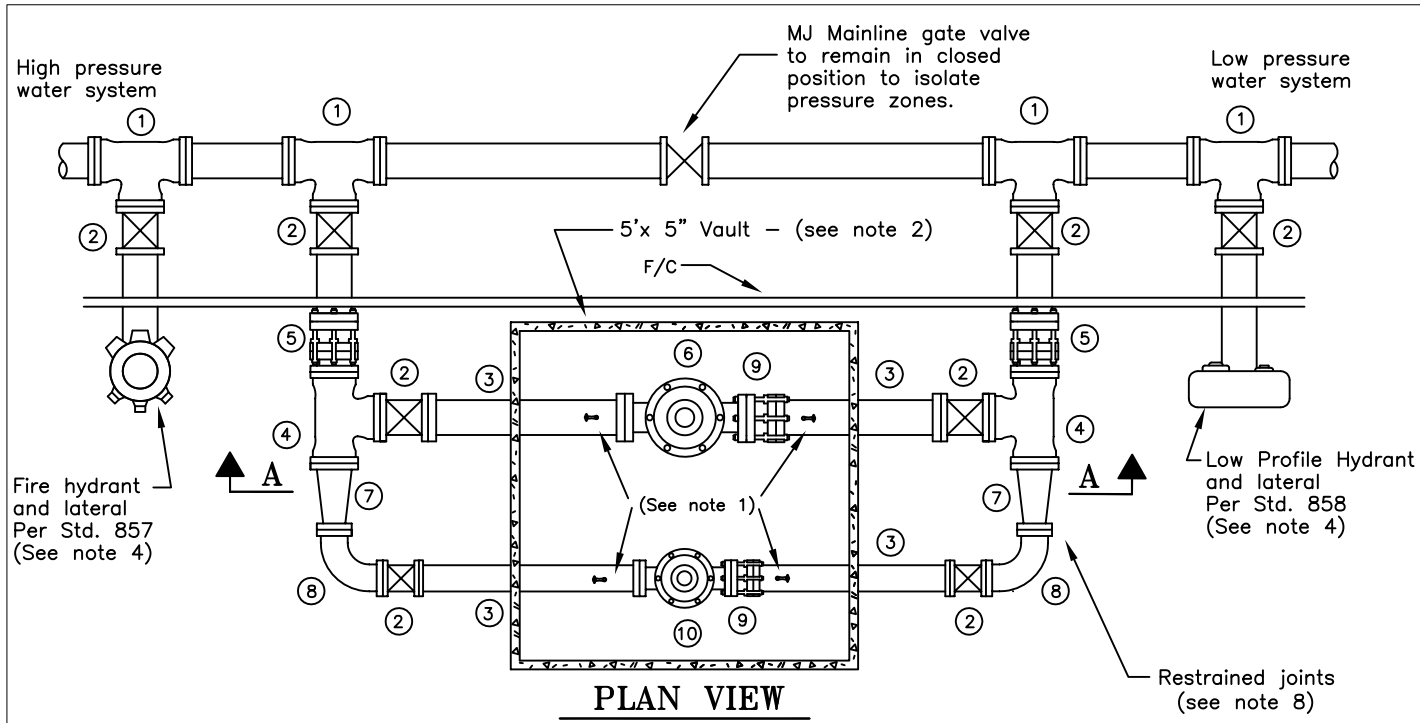

NOTES:



- Make 3/4" top tap - install risers as shown.
- See the engineer's approved list for approved vaults and covers.
- The low flow by-pass (part numbers 8-13) shall be installed unless otherwise approved by the Utilities Dept. and shall be a min. 4" in size. If a single P.R.V. is installed, center in vault and change parts Number 4 to 90° flanged ells, and delete part 5.
- Install fire hydrant and low profile hydrant only when required by the City Utilities Dept.
- 2" schedule 40 P.V.C. drain pipe shall be installed from a perforated sump canister to an existing drainage system or to daylight.
- Valves 18" and larger shall be butterfly valves. Valves 16" and smaller shall be resilient wedge gate valves.
- All pressure reducing valves to be epoxy fused, inside and outside. (See the engineer's approved list)
- Restrained joints are required for all new construction from mainline gate valve to vault. Thrust blocks are only required where existing services are being modified and restrained joints are not used.

NO.	ITEM
①	MJ x MJ x FL TEE
②	FL x MJ GATE VALVE
③	DUCTILE IRON PIPE - FL. X P.E.
④	FLANGED TEE
⑤	FL x MJ ADAPTER
⑥	FLANGED P.R.V. - HIGH FLOW
⑦	FLANGED REDUCER
⑧	FLANGED 90° ELL
⑨	FLANGED COUPLING ADAPTER
⑩	FLANGED P.R.V. - LOW FLOW
⑪	3/4" BALLCORP (FORD FB 1000)
⑫	3/4" TYPE "K" COPPER TUBING
⑬	3/4" COMP. X F.I.P. ADAPTER (FORD C14-33)
⑭	3/4" M.I.P. X HOSE BIBB - BRASS
⑮	3/4" M.I.P. TEE WITH TWO (2) 3/4" F.I.P. X H.B.

CITY OF SANTA ROSA

PRESSURE REDUCING VALVES

SCALE: NONE	DATE: June 2009
DWN: TBM RR	APPROVED
CHK: AA	FILE NO. STD.- 881

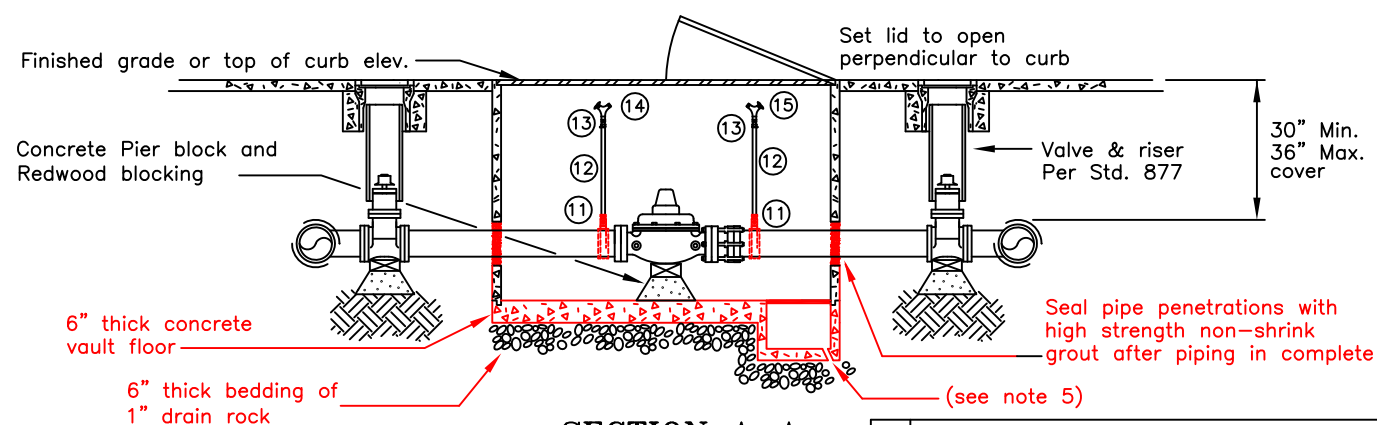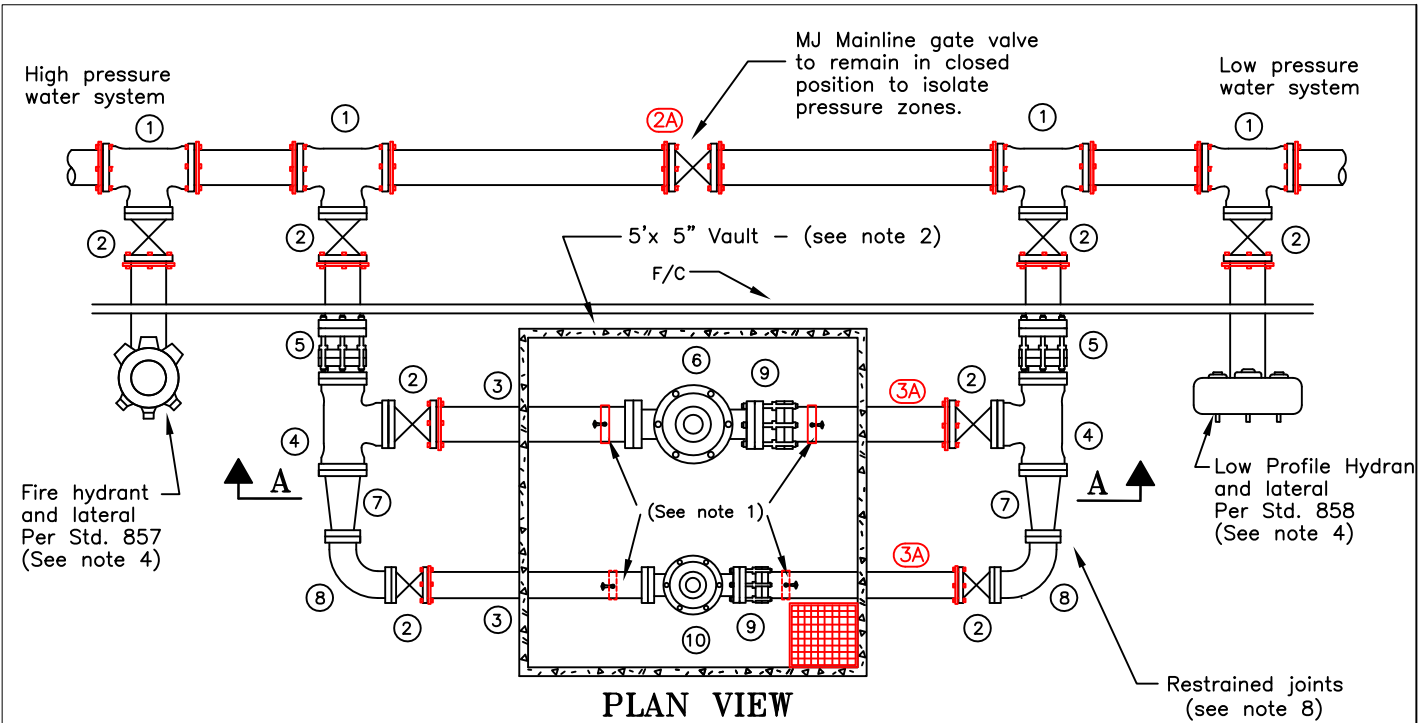

NOTES:

- Make 3/4" top tap - install risers as shown.
- Precast vault and spring assisted aluminum double leaf H20 rated cover with non-skid surface.
- Low flow by-pass (part numbers 7-13) shall be installed unless otherwise approved by the Water Department and shall be sized as required (4" min.). If low flow P.R.V. is not required, center lone P.R.V. in vault and change part number 7 to a blind flange.
- Install fire hydrant and low profile hydrant only when required by the Water Department.
- 12"x 12"x 12" sump with galvanized grate cover. Install 3/4"Ø drain in corner of sump.
- Gate valves shall be resilient wedge type. Where cover from top of operating nut to finish grade is 6" or less, install horizontal gate valve. Installation of any other valve type must be approved by the Director of Santa Rosa Water.
- Pressure reducing valve shall be fusion bonded epoxy lined and coated. (See the engineer's approved list)
- Restrained joints are required for all new construction from mainline gate valve to vault. Thrust blocks are only required where existing services are being modified and restrained joints are not used.


NO.	ITEM
①	MJ x MJ x FL TEE
②	FL x MJ GATE VALVE
2A	MJ GATE VALVE
③	DUCTILE IRON PIPE - FL. X P.E.
3A	DUCTILE IRON PIPE - P.E. X P.E.
④	FLANGED TEE
⑤	FL x MJ ADAPTER
⑥	FLANGED P.R.V. - HIGH FLOW
⑦	FLANGED REDUCER
⑧	FLANGED 90° ELL
⑨	MEGAFLANGE - OR APPROVED EQUIVALENT
⑩	FLANGED P.R.V. - LOW FLOW
⑪	SADDLE & 3/4" BRASS CORPORATION BALL VALVE
⑫	3/4" TYPE "K" HARD TEMPER COPPER TUBING
⑬	3/4" BRASS COMP. X F.I.P. COUPLER
⑭	3/4" M.I.P. X HOSE BIBB - BRASS
⑮	3/4" M.I.P. TEE WITH TWO (2) 3/4" F.I.P. X H.B.

CITY OF SANTA ROSA

PRESSURE REDUCING VALVE ASSEMBLY

SCALE: NONE	DATE: Apr. 2016
DWN: TBM RR	APPROVED
CHK: AA	FILE NO. STD.- 881

NOTE: Surge anticipator valve installation is shown. Pressure relief valve installation is similar except no sensing line is required.

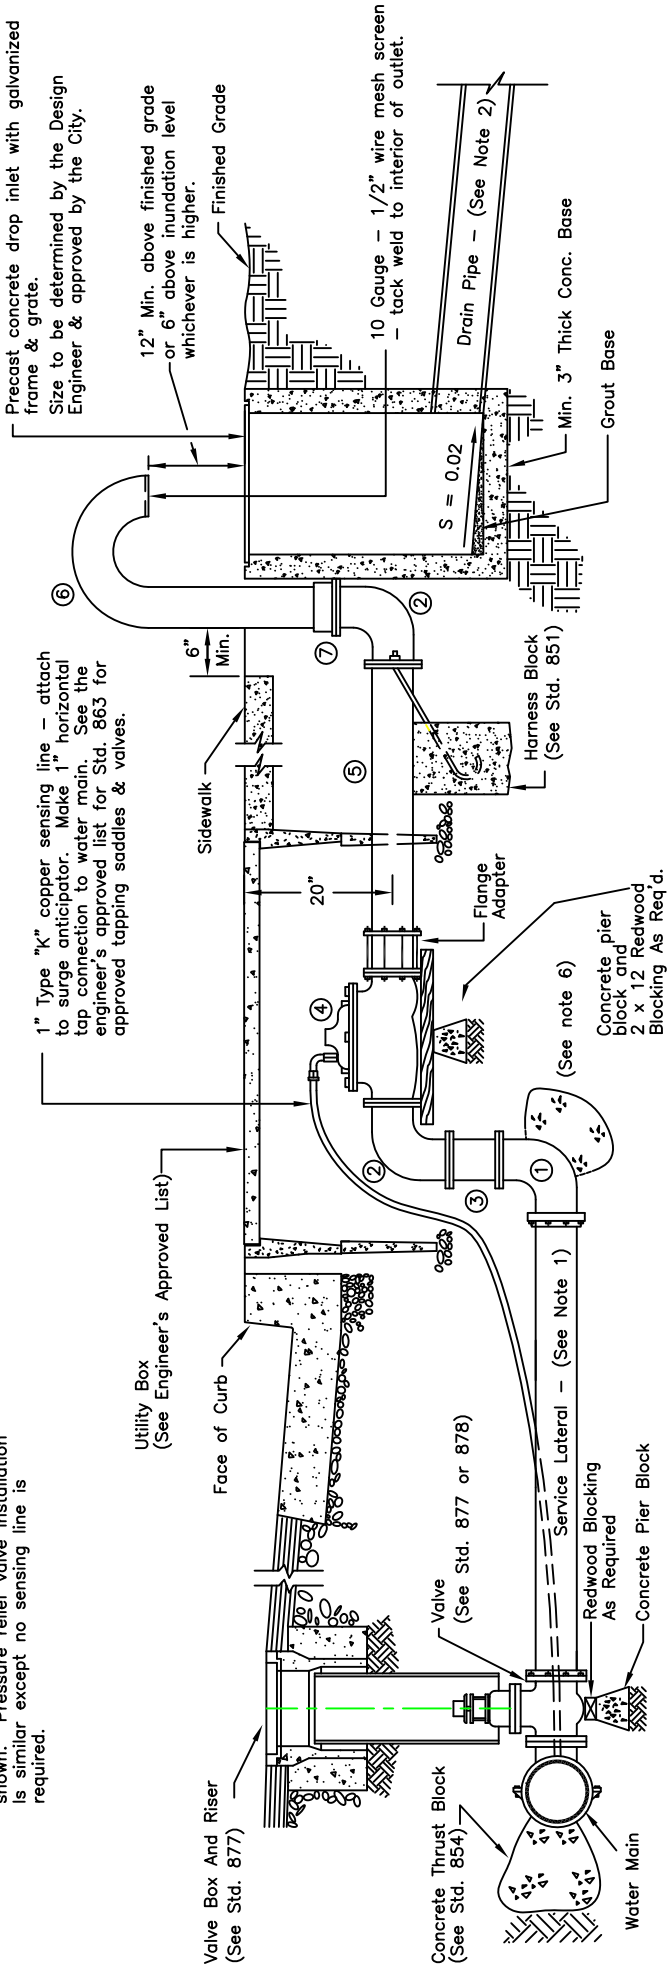

NOTES

1. Service lateral pipe shall be either 4" diameter or equal in size to the surge anticipator valve, whichever is greater. The pipe material shall be Ci. 50 or PC 350 Ductile Iron, unless otherwise shown on the plans. Should the surge anticipator valve be smaller than 4", install a flanged reducer as required on the inlet side of the valve.
2. Discharge water shall drain either to an existing drainage system or to daylight. The Project Engineer shall submit design to the appropriate agencies for approval.
3. All piping & fittings on the discharge side of the surge anticipator valve shall be equivalent in size to the valve.
4. Discharge riser shall be fabricated from standard welded steel pipe. Welding shall conform to AWWA Standard C206. The riser assembly shall be tape coated per AWWA Standard C209.
5. Contact the Utilities Dept. for specific telemetry requirements which must be met.
6. Restrained joints are required for all new construction from gate valve to lower 90° bend. Thrust blocks are only required where existing services are being modified and restrained joints are not used.


PARTS LIST	
NO.	ITEM DESCRIPTION
①	Flange x M.J. 90° - Size As Required
②	C.I. Fl. 90° Ell - Size As Required
③	D.I. Fl. Spool - Length As Required
④	Valve - See Engineer's approved list
⑤	Fl. D.I.P. - Length As Required
⑥	Fabricated Welded Steel Discharge (See Note 4)
⑦	Flange Adapter - Size As Required

CITY OF SANTA ROSA

SURGE ANTICIPATOR VALVE
or PRESSURE RELIEF VALVE

SCALE: NONE		DATE: June 2009
DWN: GC BB	APPROVED	FILE NO.
CHK: AA		STD.- 882

NOTE: Surge anticipator valve installation is shown. Pressure relief valve installation is similar except no sensing line is required.

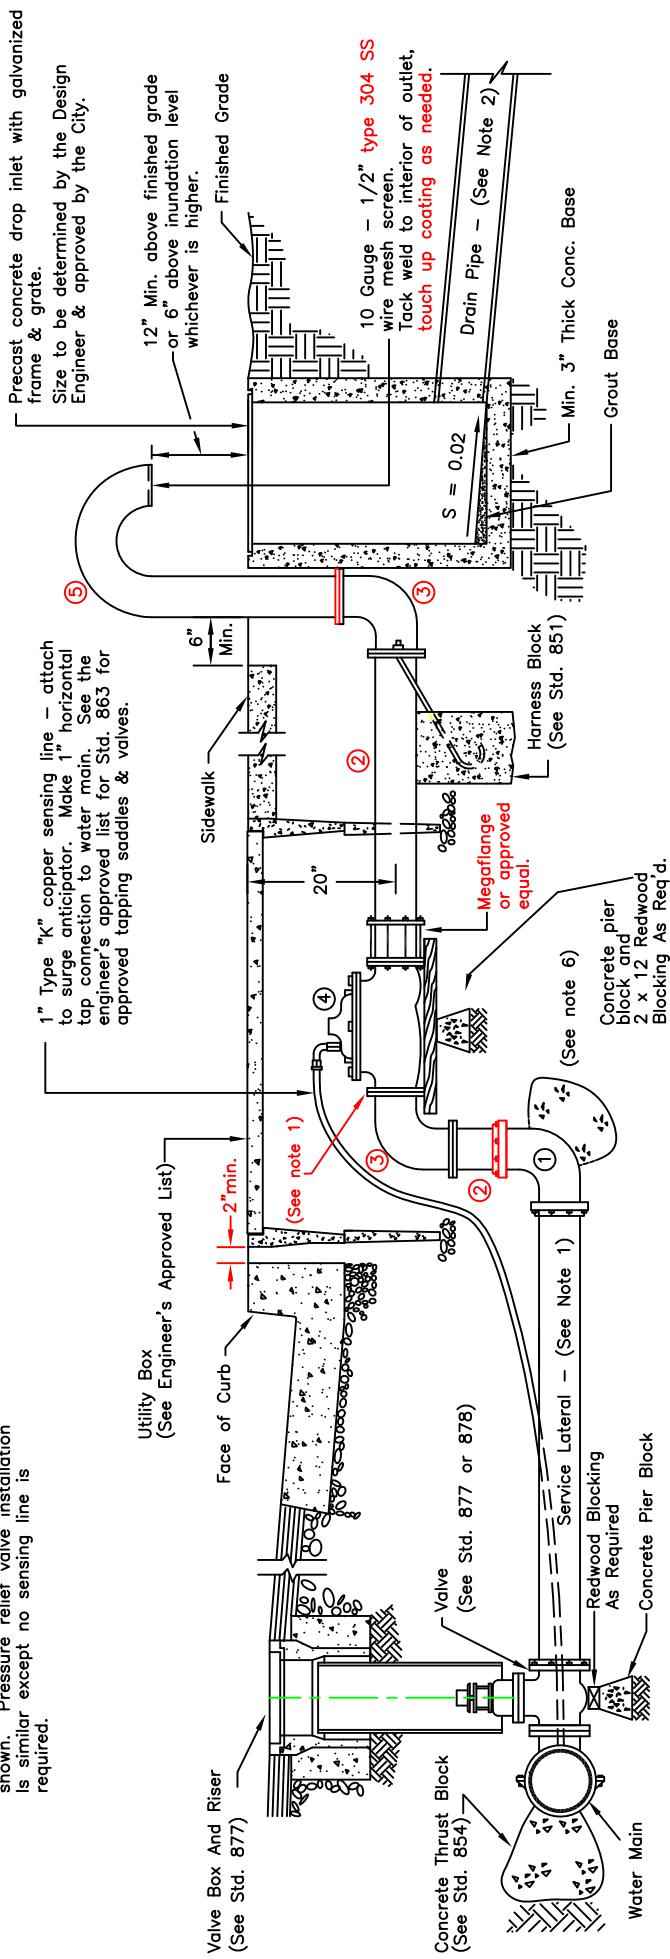

NOTES



1. Service lateral pipe and fittings on inlet side of valve shall be 4"ø or some size as surge anticipator valve, whichever is greater. 3"ø and larger pipe material shall be PC350 ductile iron unless otherwise shown on the plans. Where a smaller than 4" surge anticipator valve is approved for installation, install 4" x "as required" reducer on the inlet side of the valve.
2. The Project Engineer shall submit a proposed design to the Engineer and all other appropriate Agencies for approval of discharge water drainage.
3. Material for discharge side of valve shall be the same size as the valve, and material smaller than 3" shall be submitted on for approval.
4. Discharge riser shall be fabricated from standard welded steel pipe, with a weld on flange. Welding of pipe shall conform to AWWA Standard C206. The riser assembly shall be Fusion Bonded Epoxy lined and coated per AWWA Standard C213.
5. Contact the Water Department for specific telemetry requirements which must be met.
6. Restrained joints are required for all new construction from gate valve to upper 90° bend. Thrust blocks are only required where existing services are being modified and restrained joints are not used.


PARTS LIST	
NO.	ITEM DESCRIPTION
①	M.J. 90° - Size As Required
②	FL x P.E. D.I. Spool - Dia. & Length As Required
③	FL 90° Ell - Size As Required
④	Valve - See Engineer's approved list
⑤	Fabricated Welded Steel Discharge (See Note 4)

CITY OF SANTA ROSA

SURGE ANTICIPATOR VALVE
or PRESSURE RELIEF VALVE

SCALE: NONE		DATE: Apr. 2016
DWN: GC BB	APPROVED	FILE NO.
CHK: AA		STD.- 882

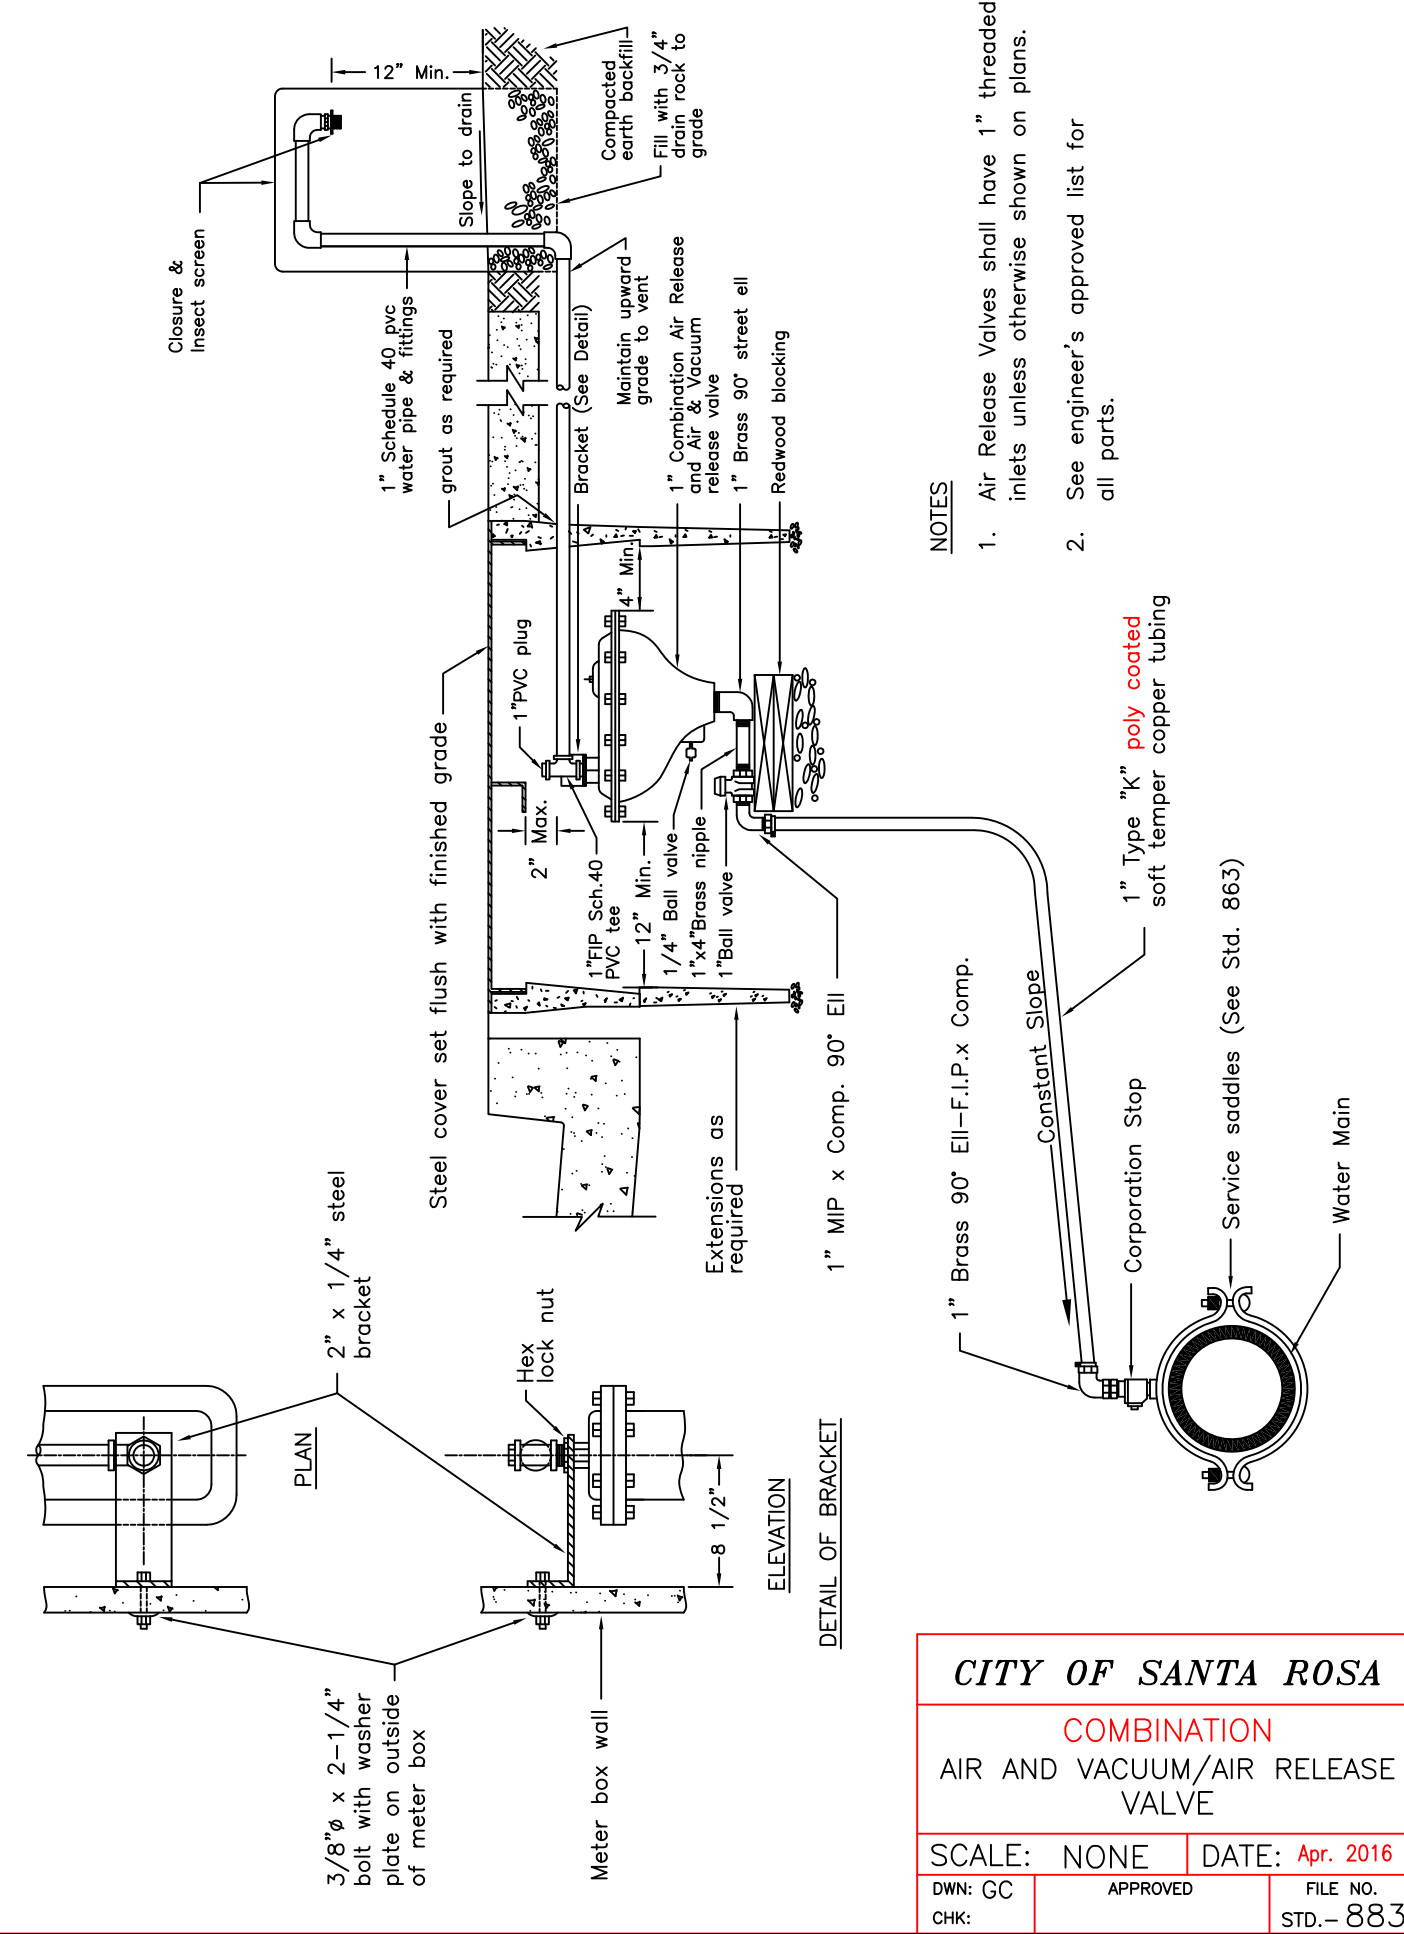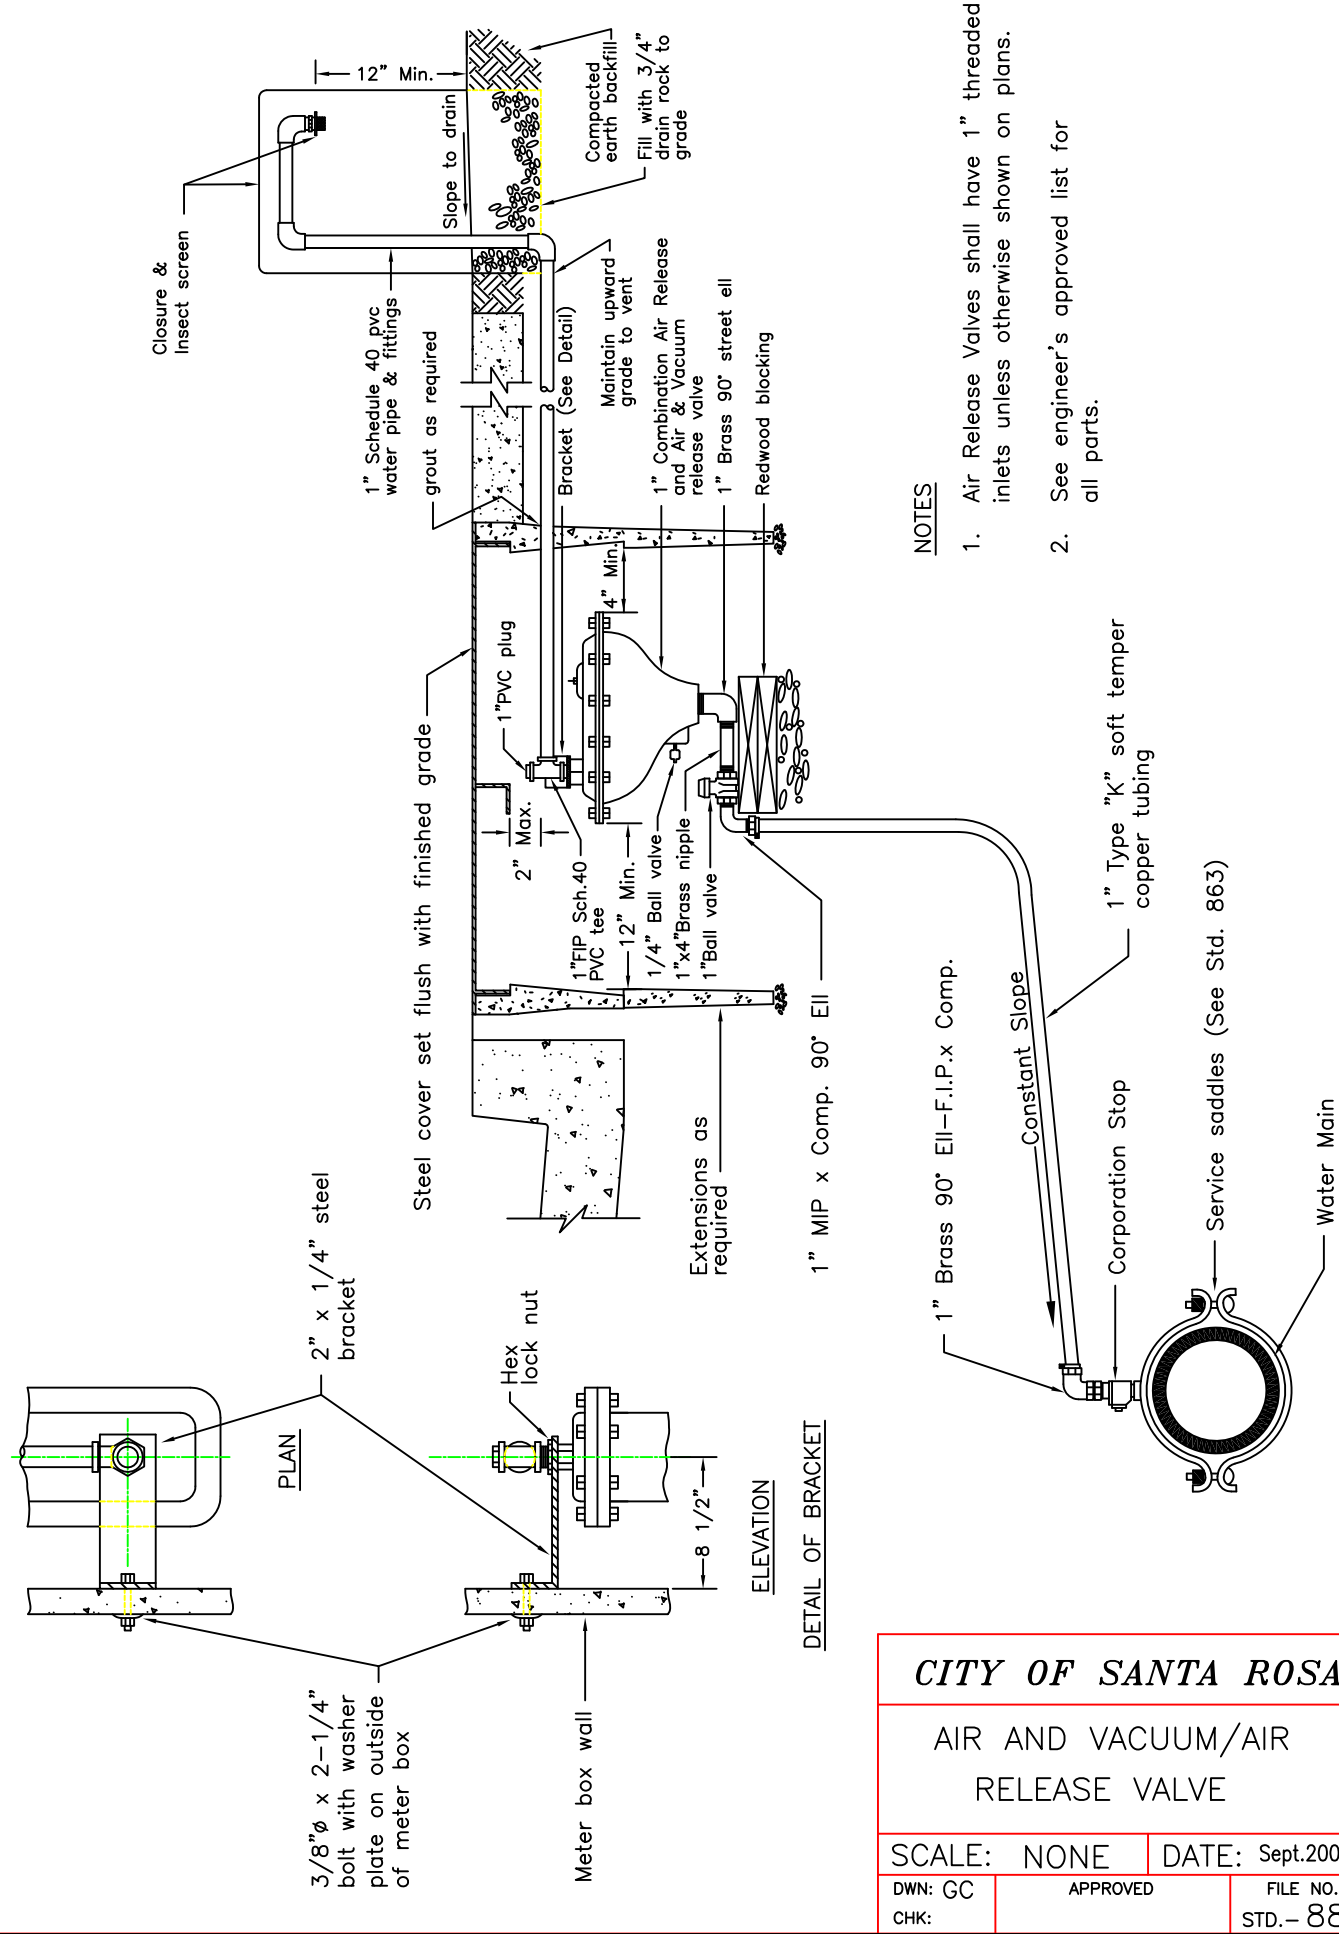

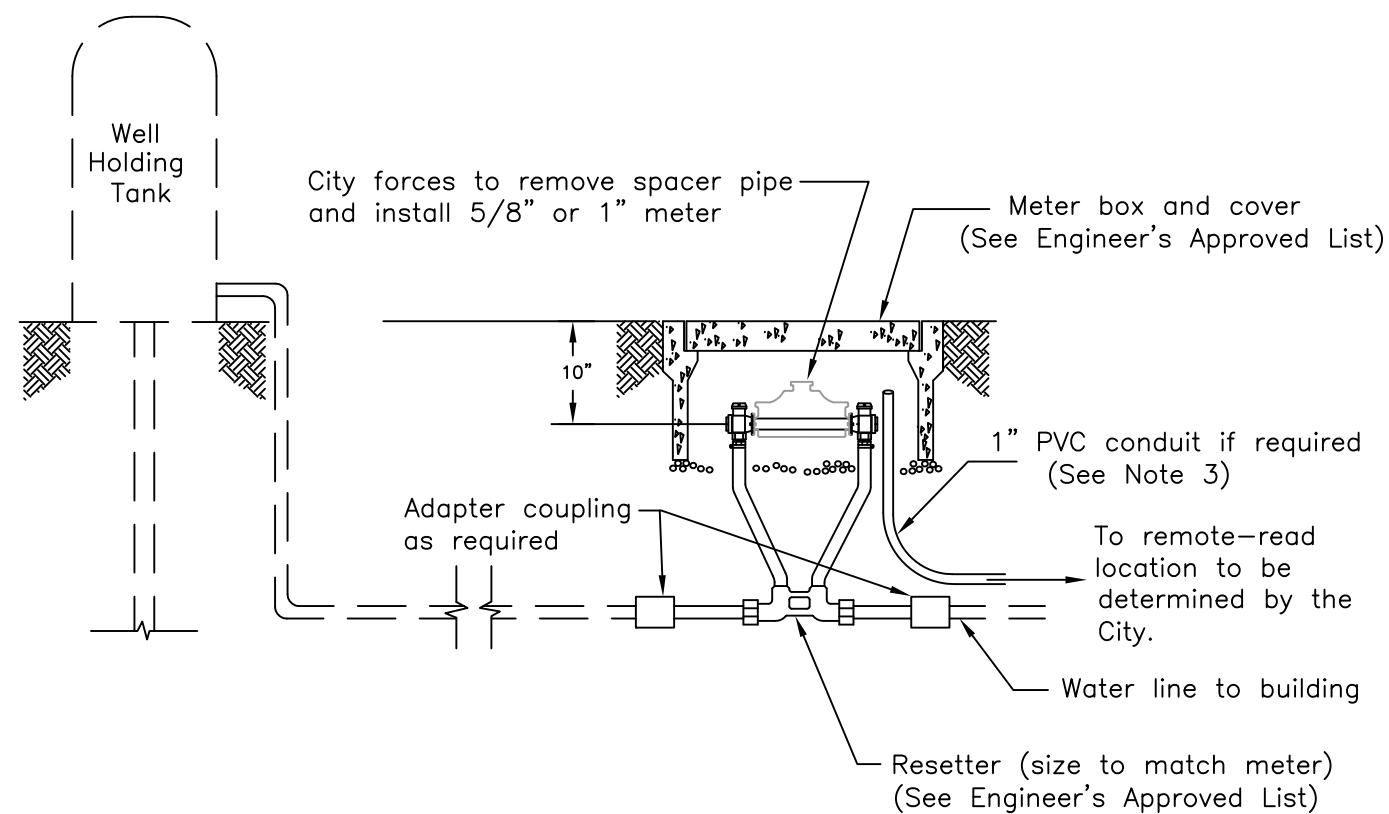

NOTES

1. Contractor to install schedule 80 PVC spacer bar—without holes.
2. All meter boxes, vaults and pits shall be bedded on 3" minimum thick, 3/4" drain rock, AB-2, or other clean material with typical sand equivalent of 20 minimum uncontaminated by native soil, against compacted or undisturbed base. The gravel bed shall extend to a 4" minimum beyond all sides of the meter box. Box shall set flush with the top of curb, sidewalk or ground, whichever is applicable.
3. 1" PVC electrical conduit with pull cable may be required where a remote-read meter is to be installed. Only long-radius ells may be used. Conduit installation to be inspected by the Utilities Department.
4. Location of meter requires prior approval by Utilities Department.
5. Meters larger than 1" requires prior approval by Utilities Department.
6. Traffic loading box and lid to be installed in all driveways or locations where vehicular traffic may occur, and where specified on plans. Box shall be installed so that the steel cover is set flush with finished surface.

CITY OF SANTA ROSA

WATER METER for PRIVATE
NON-RESIDENTIAL SYSTEMS


SCALE: NONE DATE: Sept.2002

DWN: GC
CHK: PM

APPROVED

FILE NO.

STD.- 884

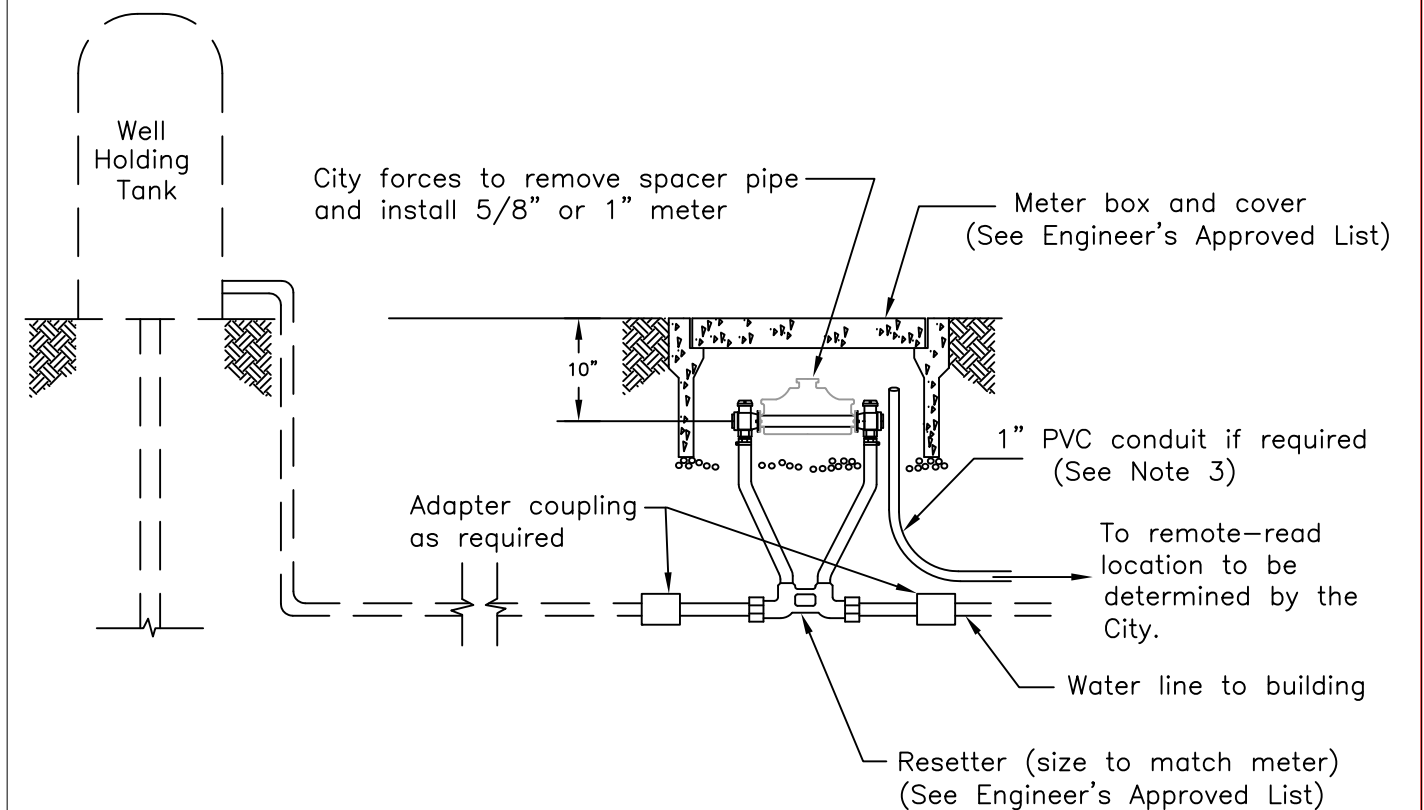

NOTES

1. Contractor to install schedule 80 PVC spacer pipe—without holes.
2. All meter boxes, vaults and pits shall be bedded on 3" minimum thick, 3/4" drain rock, AB-2, or other clean material with typical sand equivalent of 20 minimum uncontaminated by native soil, against compacted or undisturbed base. The gravel bed shall extend to a 4" minimum beyond all sides of the meter box. Box shall set flush with the top of curb, sidewalk or ground, whichever is applicable.
3. 1" PVC electrical conduit with pull cable may be required where a remote-read meter is to be installed. Only long-radius ells may be used. Conduit installation to be inspected by the Water Department.
4. Location of meter requires prior approval by Water Department.
5. Meters larger than 1" requires prior approval by Water Department.
6. Traffic loading box and lid to be installed in all driveways or locations where vehicular traffic may occur, and where specified on plans. Box shall be installed so that the steel cover is set flush with finished surface.

CITY OF SANTA ROSA

WATER METER for PRIVATE
NON-RESIDENTIAL SYSTEMS

SCALE: NONE DATE: Apr. 2016

DWN: GC
CHK: PM


APPROVED

FILE NO.

STD.- 884

METER SETTING ASSEMBLY PARTS LIST

METER SIZE	RESETTER	SPACER BAR (See note 1)
5/8" x 3/4"	(See Engineer's approved list)	1"ø x 7-3/4" LG. SCHL. 80 PVC PIPE
1"	(See Engineer's approved list)	1-1/4"ø x 11" LG. SCHL. 80 PVC PIPE

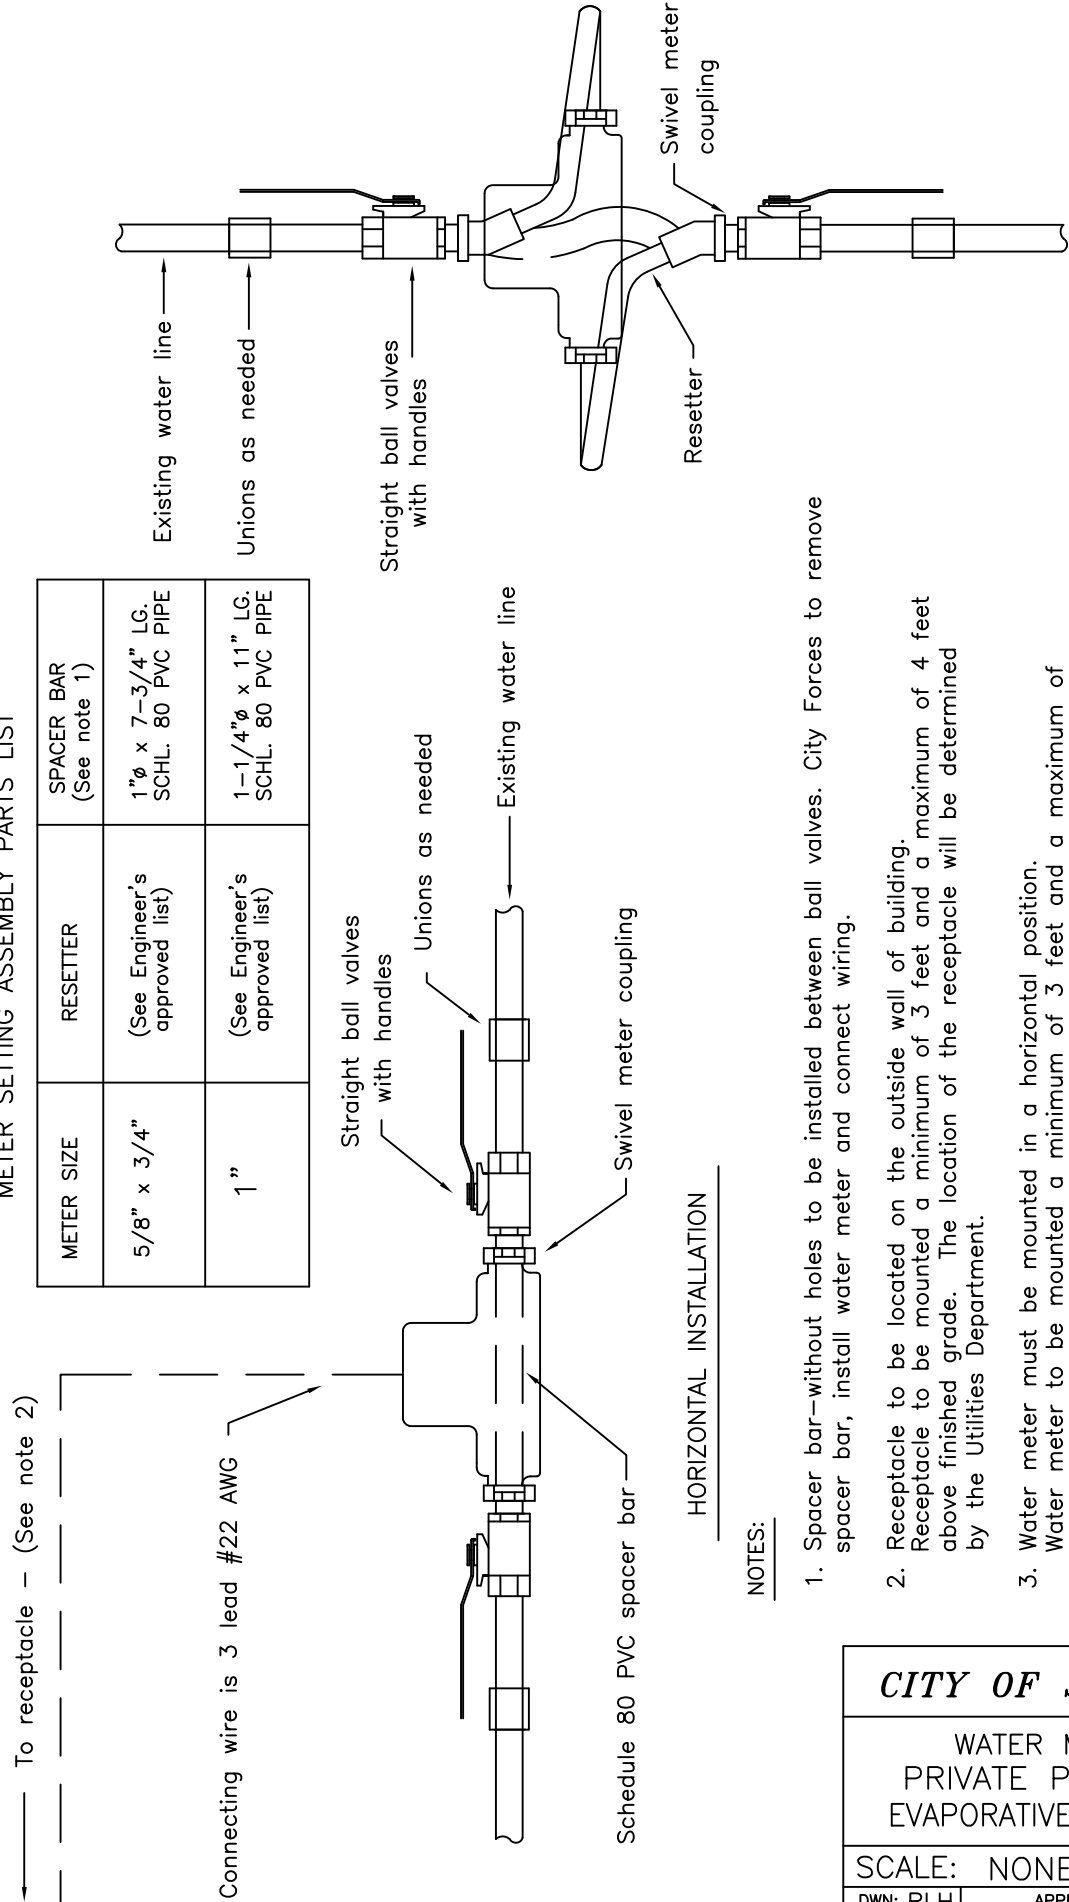

HORIZONTAL INSTALLATION

NOTES:

- Spacer bar—without holes to be installed between ball valves. City Forces to remove spacer bar, install water meter and connect wiring.
- Receptacle to be located on the outside wall of building. Receptacle to be mounted a minimum of 3 feet and a maximum of 4 feet above finished grade. The location of the receptacle will be determined by the Utilities Department.
- Water meter must be mounted in a horizontal position. Water meter to be mounted a minimum of 3 feet and a maximum of 5 feet above finished floor. The location of the water meter will be determined by the Utilities Department.
- Connecting wire to be installed in 1/2" diameter PVC conduit. Meter, conduit and wire may not be installed in areas with explosive atmospheres.
- The Utilities Department will maintain the water meter only. All plumbing and wiring is the responsibility of the property owner.

VERTICAL INSTALLATION

RESETTER REQUIRED

CITY OF SANTA ROSA

WATER METER for
PRIVATE PROCESS and
EVAPORATIVE WATER LINES

SCALE: NONE DATE: Sept 2002


DWN: RLH
CHK: G.C.

APPROVED

FILE NO.
STD.- 885

METER SETTING ASSEMBLY PARTS LIST

METER SIZE	RESETTER	SPACER PIPE (See note 1)
5/8" x 3/4"	(See Engineer's approved list)	1"ø x 7-3/4" LG. SCHL. 80 PVC PIPE
1"	(See Engineer's approved list)	1-1/4"ø x 11" LG. SCHL. 80 PVC PIPE

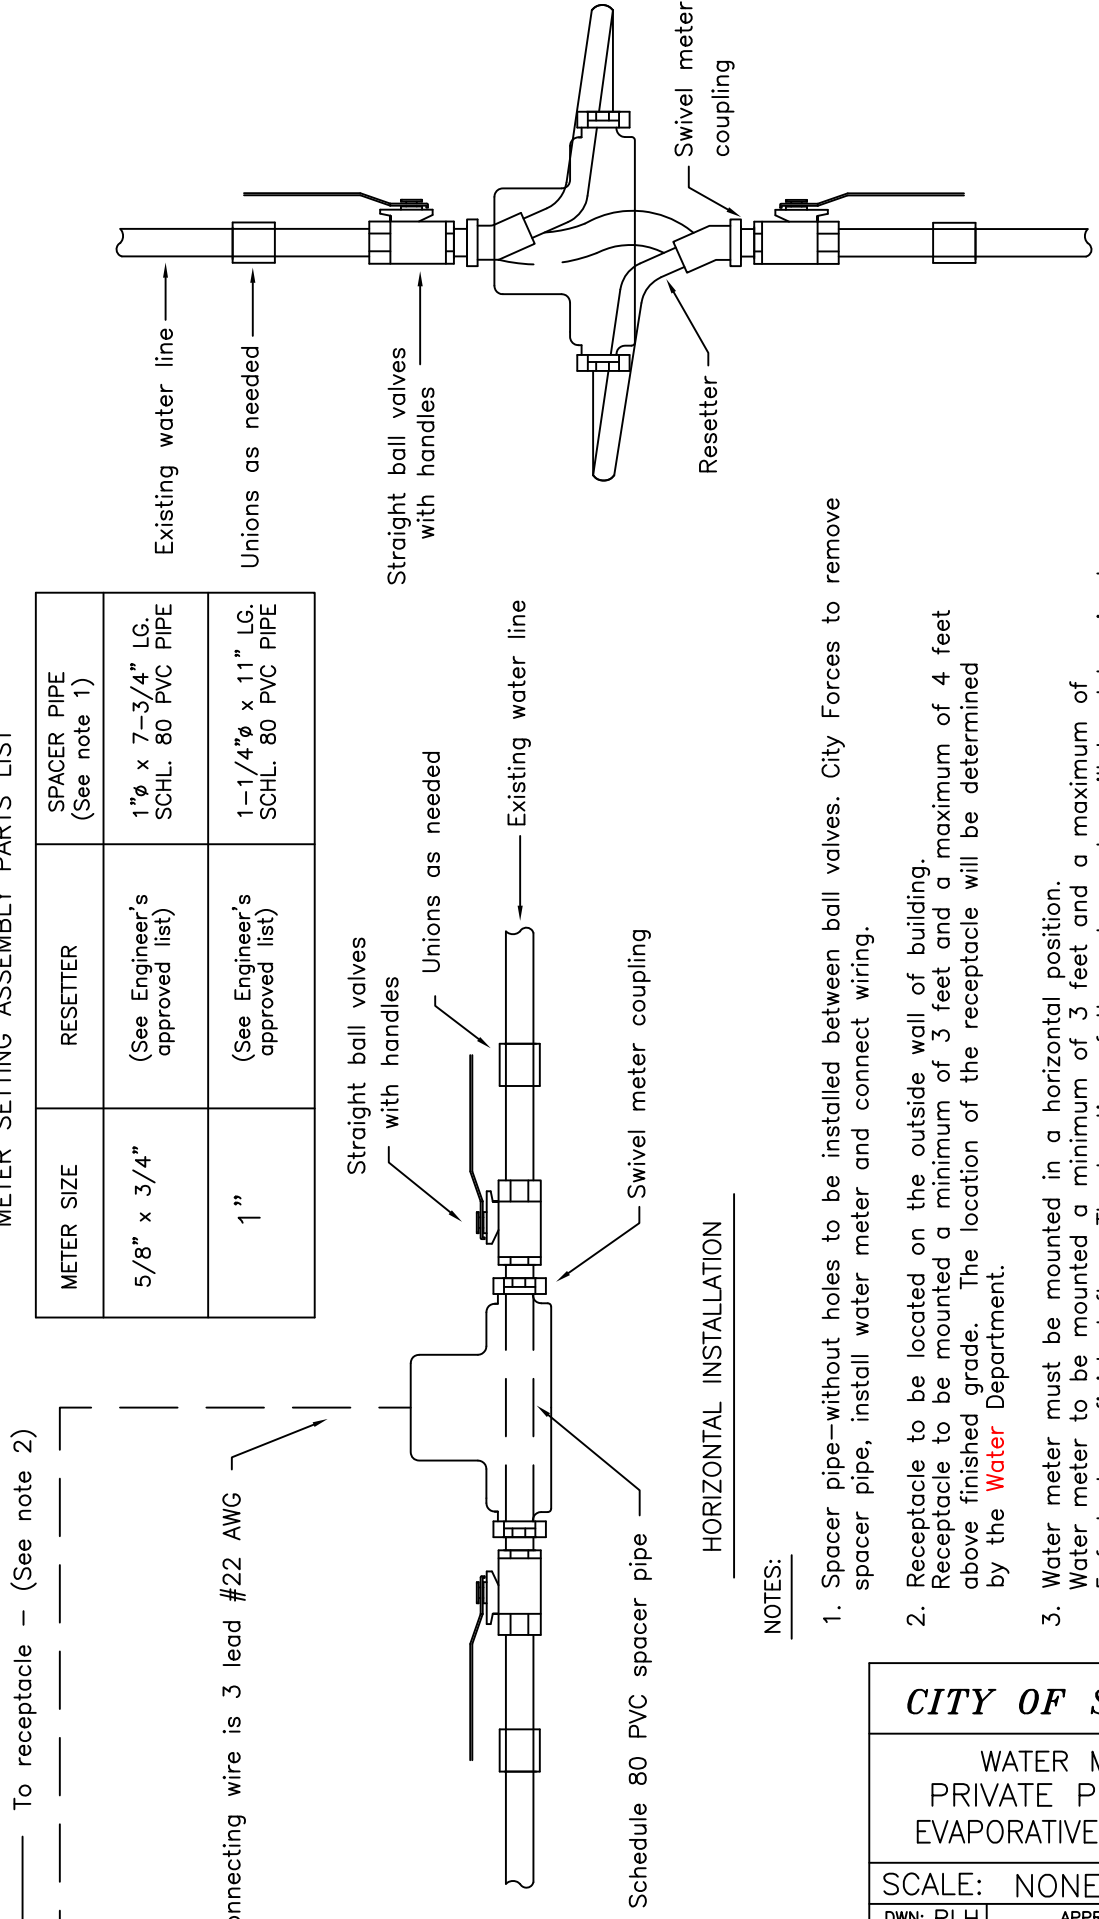

HORIZONTAL INSTALLATION

NOTES:

- Spacer pipe—without holes to be installed between ball valves. City Forces to remove spacer pipe, install water meter and connect wiring.
- Receptacle to be located on the outside wall of building. Receptacle to be mounted a minimum of 3 feet and a maximum of 4 feet above finished grade. The location of the receptacle will be determined by the Water Department.
- Water meter must be mounted in a horizontal position. Water meter to be mounted a minimum of 3 feet and a maximum of 5 feet above finished floor. The location of the water meter will be determined by the Water Department.
- Connecting wire to be installed in 1/2" diameter PVC conduit. Meter, conduit and wire may not be installed in areas with explosive atmospheres.
- The Water Department will maintain the water meter only. All plumbing and wiring is the responsibility of the property owner.

VERTICAL INSTALLATION

FOR STANDARDS 879 & 880

RESETTER REQUIRED

CITY OF SANTA ROSA


WATER METER for
PRIVATE PROCESS and
EVAPORATIVE WATER LINES

SCALE: NONE DATE: June 2016

DWN: RLH
CHK: G.C.

APPROVED

FILE NO.
STD.- 885

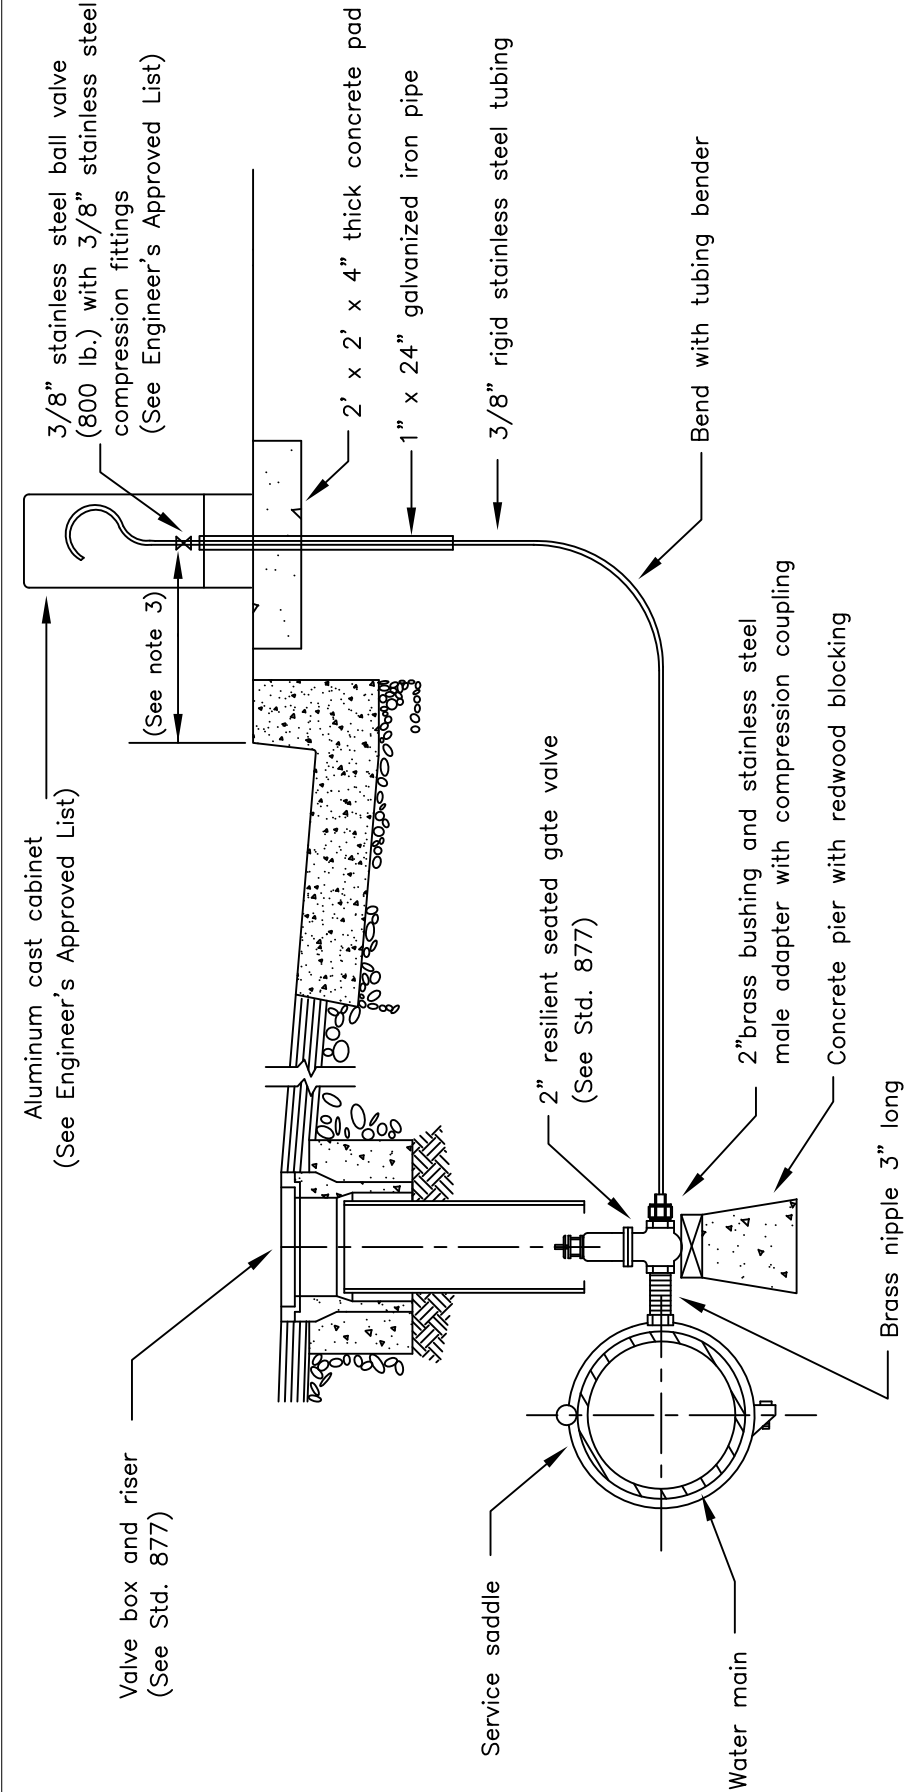


NOTES:

1. If more than one length of 3/8" stainless steel tubing is required stainless steel compression couplings shall be used.
2. All 3/8" tubing shall be wrapped in 10 mil tape.
3. Where planter strip exists, install min. 18" behind F/C – Where sidewalk is contiguous, install 12" behind sidewalk.

APPROVED TAPPING SERVICE SADDLES:

(See Engineer's Approved List for Standard 863)

CITY OF SANTA ROSA			
WATER SAMPLING STATION			
SCALE: NONE	DATE: Sept.2002		
DWN: BLH	APPROVED	FILE NO.	
CHK: RLH		STD.- 886	

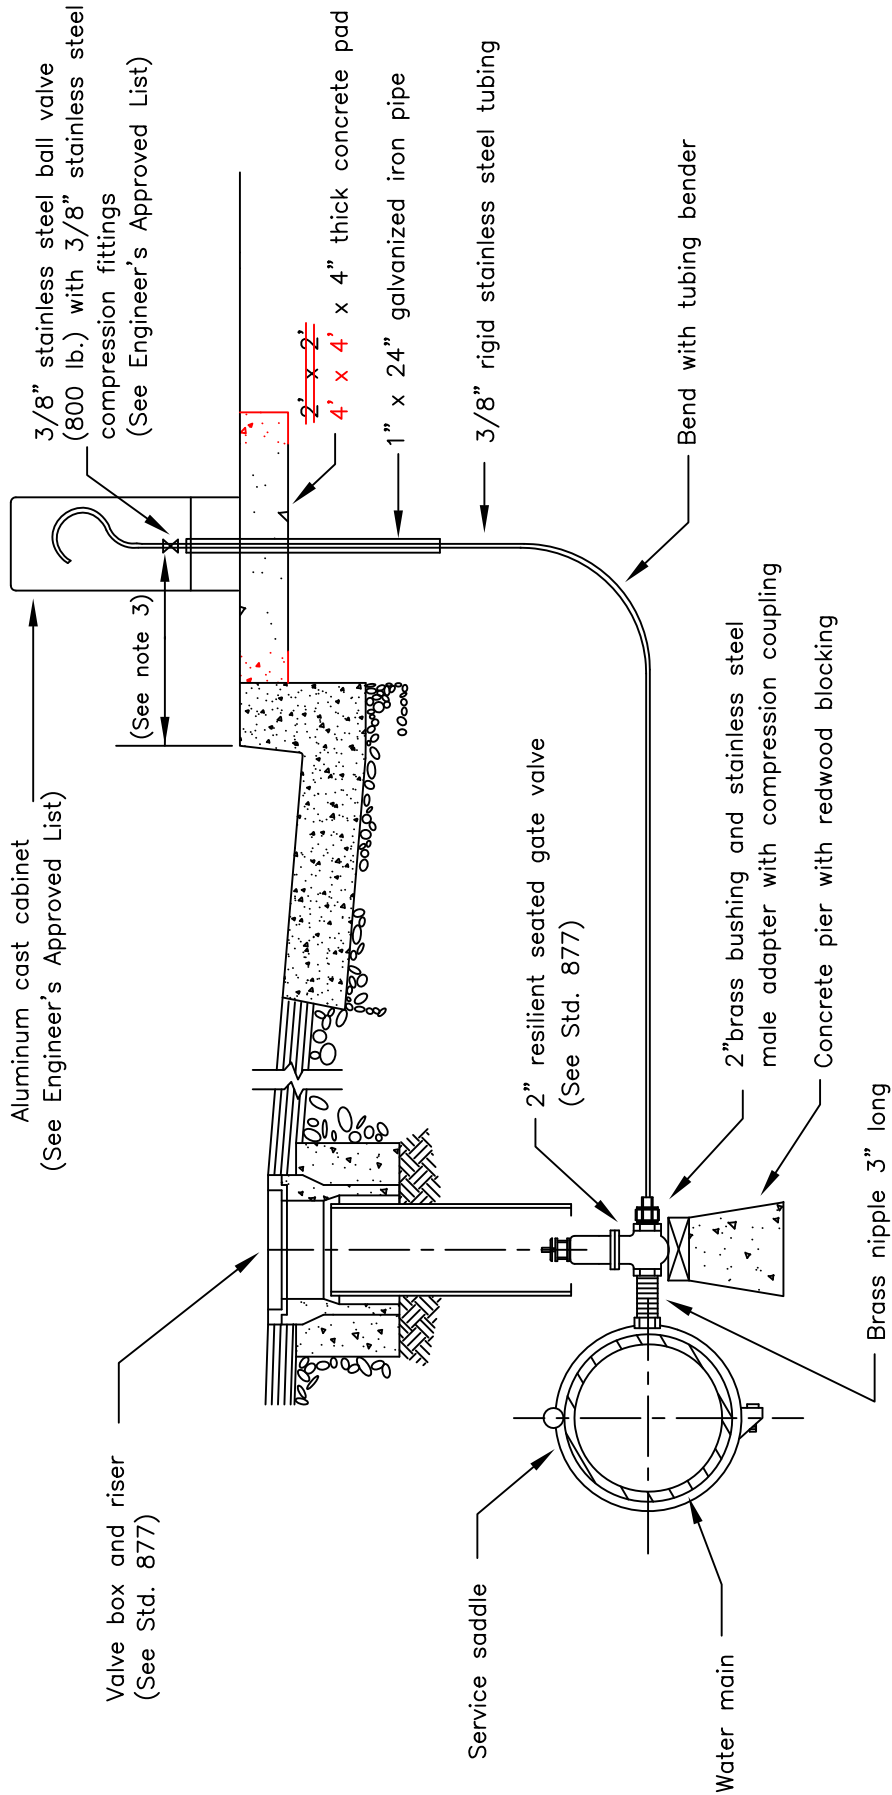



NOTES:

1. If more than one length of 3/8" stainless steel tubing is required stainless steel compression couplings shall be used.
2. All 3/8" tubing shall be wrapped in 10 mil tape.
3. Where planter strip exists, install min. ~~18"~~ 24" behind F/C – Where sidewalk is contiguous, install 12" behind sidewalk.

APPROVED ~~TAPPING~~ SERVICE SADDLES:

(See Engineer's Approved List; **STD-863A**)

CITY OF SANTA ROSA			
WATER SAMPLING STATION			
SCALE: NONE	DATE: Apr. 2016		
DWN: BLH	APPROVED	FILE NO.	
CHK: RLH		STD.- 886	

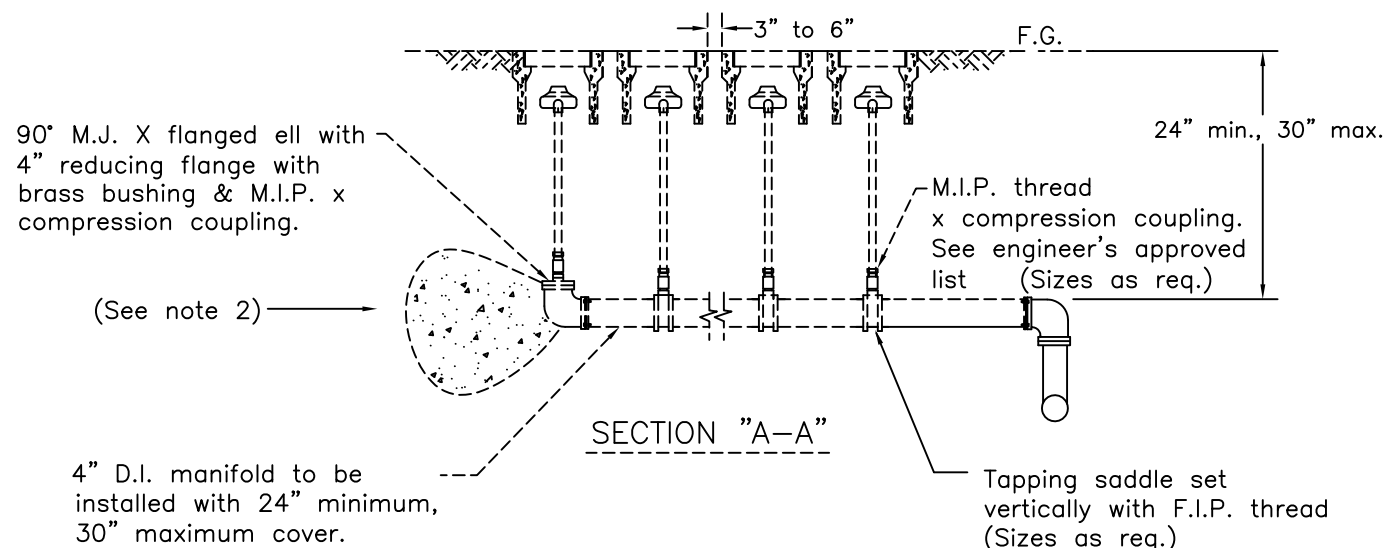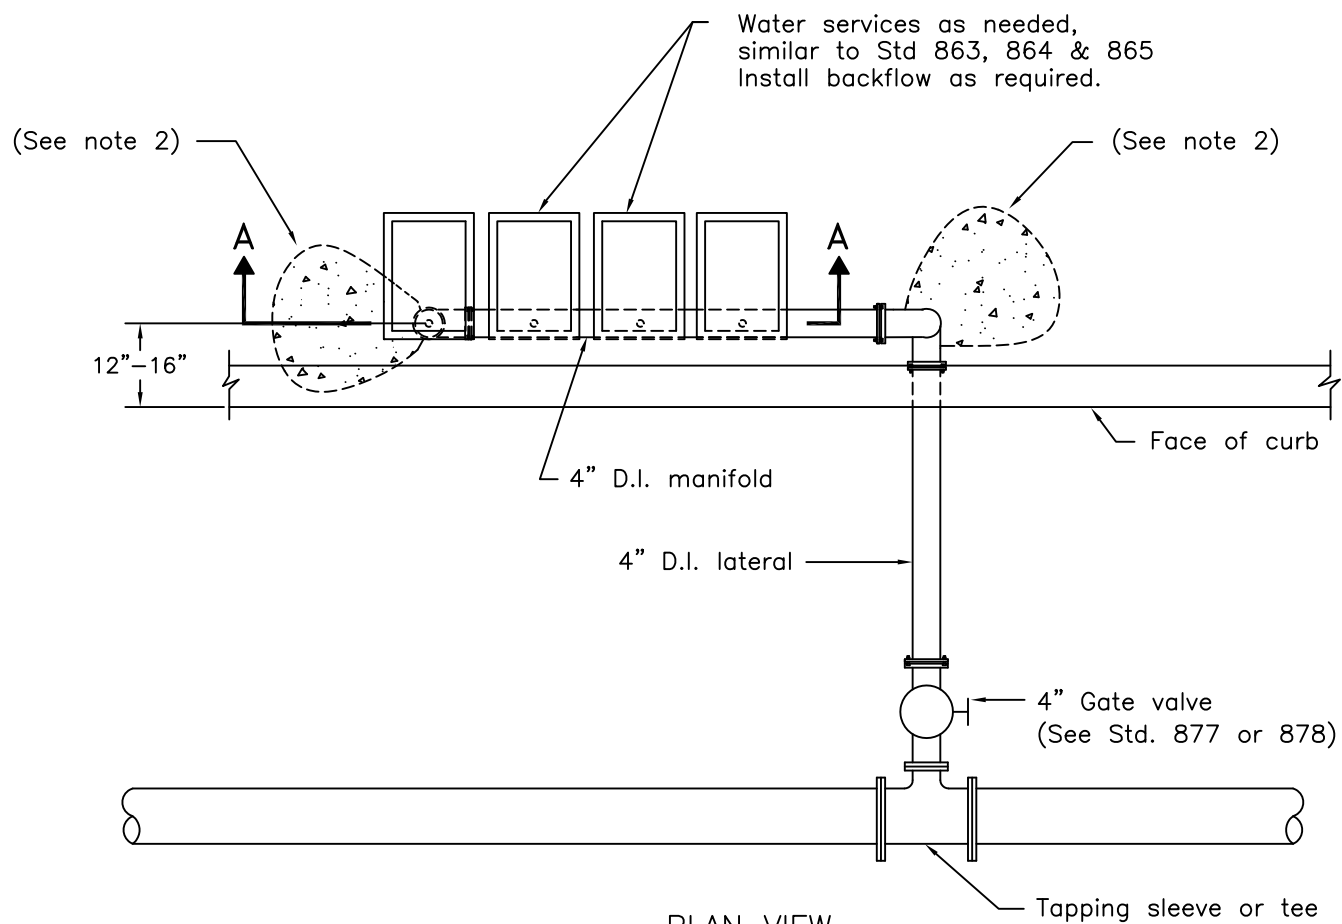

NOTES:

1. This Standard may be adapted for connection to a combination water service per Std. 870.
2. Restrained joints are required for all new construction from gate valve to end of 4" manifold. Thrust blocks are only required where existing services are being modified and restrained joints are not used.



CITY OF SANTA ROSA

4" DUCTILE IRON MULTI-SERVICE MANIFOLD

SCALE: NONE	DATE: June 2009
DWN: GC BB	APPROVED
CHK: AA	FILE NO. STD.-887

BOXES & COVERS

per applicable City Standards

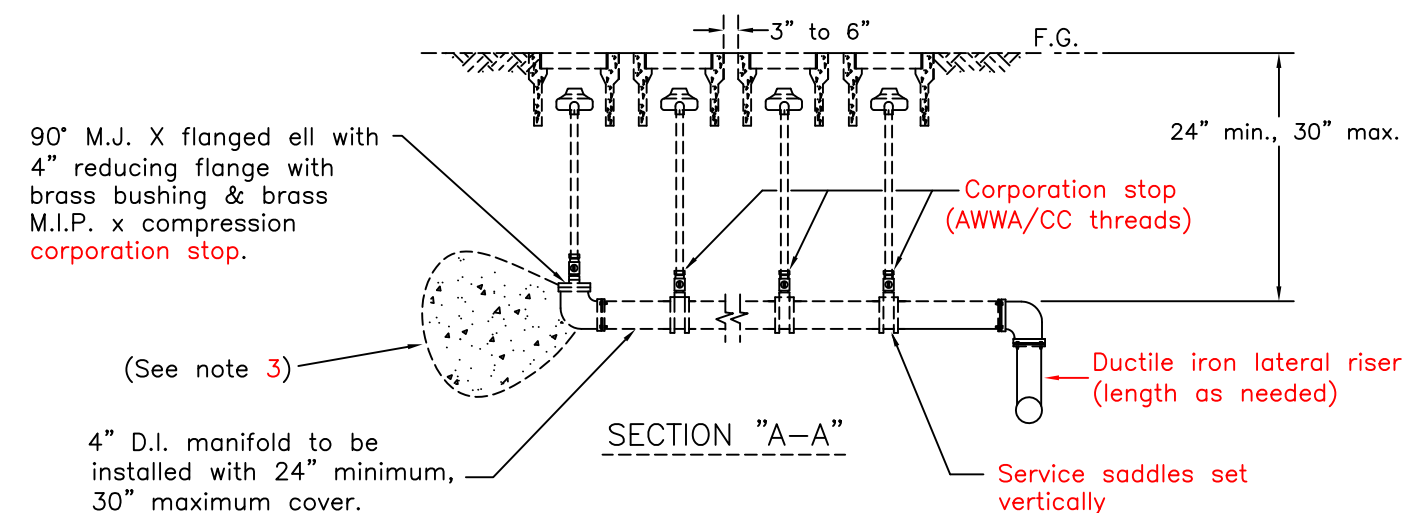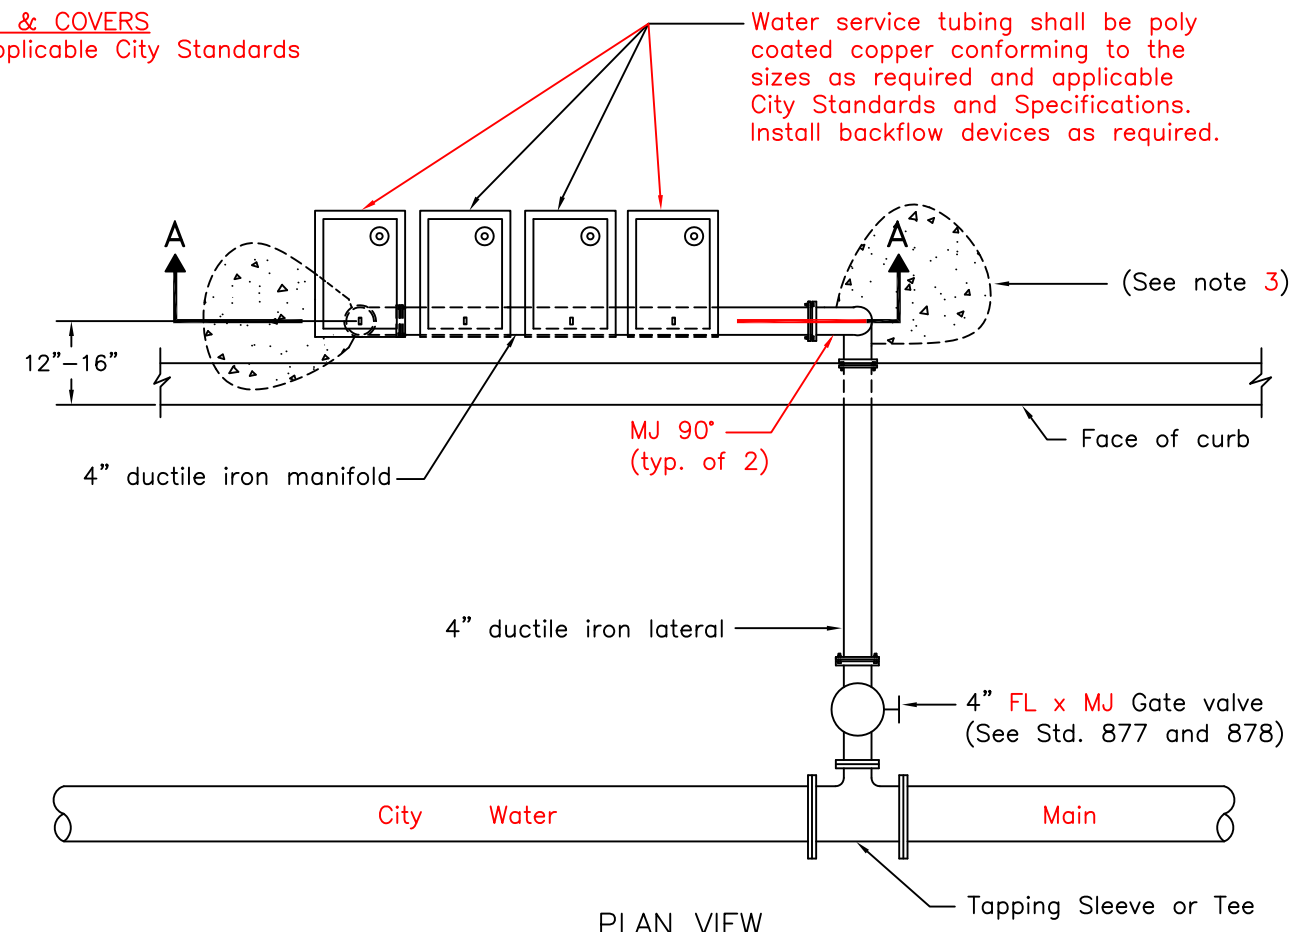

NOTES:

1. This Standard may be adapted, as approved by the Water Department, for connection to a combination water service per Std. 870.
2. Service saddle and corporation stop per applicable City Standard for individual service sizes.
3. Restrained joints are required for all new construction from gate valve to end of 4" manifold. Thrust blocks are only required where existing services are being modified and restrained joints are not used.

CITY OF SANTA ROSA

4" DUCTILE IRON MULTI-SERVICE MANIFOLD

SCALE: NONE	DATE: Apr. 2016
DWN: GC BB	APPROVED
CHK: AA	FILE NO. STD.-887

BY-PASS PARTS LIST

NO.	DESCRIPTION	QUANT.	PART SIZE OR MODEL NO.*
1.	HOSE BIB – MIP	3	3/4"
2.	TEE – FIP x FIP x FIP	3	3/4"
3.	SHORT MTR SPUD – 2" L	2	C38 – 23 – 2
4.	STRAIGHT CHK. VALVE – MIP x FIP	1	HS81 – 333
5.	ADAPTER – COMP x MIP	1	C84 – 33
6.	COPPER TUBING – TYPE "K" (SOFT)	VARIES	3/4"
7.	90° ADAPTER – COMP x MIP	4	L84 – 33
8.	STRAIGHT BALL VALVE – FIP x FIP	2	B11 – 33
9.	CLOSE NIPPLE	4	3/4"
10.	90° ADAPTER – COMP x FIP	1	L14 – 33
11.	ADAPTER – COMP x FIP	2	C14 – 33
12.	BUSHING	2	3/4" x VARIES

* FORD MODEL NO’s ARE GIVEN. SUBMIT SUBSTITUTIONS FOR APPROVAL.

NOTES

1. This Standard applies when above ground installation per Std. 888 is not possible due to site constraints.
2. The post indicator valve shall be installed as close as possible to the detector check vault. If a post indicator cannot be installed, an O.S. & Y. valve with locking chain must be installed inside the vault on the property side of the detector check with approval from the City Utilities Department. The installation shall be provided with electronic supervision monitoring when required by the Fire Department.
3. Refer to vault size chart for proper size. Should an O.S. & Y. valve be installed in the vault, the vault size may need to be verified by the Contractor. See the engineer’s approved list for approved vaults and covers.
4. All fire line services to the post indicator valve shall be tested by the Public Works Dept. Construction inspection section per City of Santa Rosa Construction Specifications. All on-site fire lines, hydrants, and the P.I.V. shall be tested & inspected by the Fire Dept. per City Fire Code.
5. Double check detector check valve assembly with bypass double check shall be installed where the Utilities Dept. determines an extreme hazard exists. Installation details shall be approved by the Utilities Dept. prior to installation. (See Std. 880).
6. The fire department connection shall be installed and located as required by the Fire Department.
7. Post indicator valves shall be locked with a break-away lock. The top of the P.I.V. shall not be less than thirty-six inches (36") above finished grade.

VAULT SIZES		
D.C. SIZE	WIDTH	LENGTH
4"	4'	4'
6"	4'	4'
8"	5'	5'
10"	5'	5'

CITY OF SANTA ROSA

SINGLE CHECK
DETECTOR IN VAULT

SCALE: NONE | DATE: Sept.2002

DWN: GC
CHK: GC

APPROVED

FILE NO.
STD.– 879


BY-PASS PARTS LIST

NO.	DESCRIPTION	QUANTITY
1.	3/4" BRASS MALE HOSE BIB	3
2.	3/4" BRASS TEE – FIP x FIP x FIP	3
3.	3/4" BRASS MTR SPUD – LENGTH AS NEEDED	2
4.	3/4" BRASS MIP INLET X FIP OUTLET STRAIGHT CHK. VALVE	1
5.	3/4" BRASS MIP X COMP. COUPLING	1
6.	3/4" TYPE "K" SOFT TEMPER COPPER	AS NEEDED
7.	3/4" BRASS COMP. X MIP 90° ELL	4
8.	3/4" BRASS FIP X FIP STRAIGHT BALL VALVE	2
9.	3/4" BRASS HEX HEAD CLOSE NIPPLE	4
10.	3/4" BRASS COMP. X FIP 90° ELL	1
11.	3/4" BRASS COMP x FIP COUPLING	2
12.	DEVICE PENETRATION Ø X 3/4" BRASS BUSHING	2

* All material shall comply with California Health and Safety Code Section 116875

NOTES

1. Single check detector installation per Standard 888 requires prior authorization by the Director of Santa Rosa Water. Authorization shall only be provided when, in the opinion of the Engineer, above ground installation, per Standard 879 is not possible due to site constraints.
2. The post indicator and valve shall be installed as approved by the Fire Department. The installation shall be provided with electronic supervision monitoring when required by the Fire Department. Any adjustments to this standard must be first approved, in writing, by both the Fire and Water Departments.
3. Refer to vault size chart for proper size. Should a property side O.S. & Y. valve be required inside the vault the vault length shall increase by an additional 12" for 4" & 6" installations, and 18" for 8" and 12" installations. The Contractor shall notify the Engineer if additional clearances appear to be warranted. See the engineer’s approved list for approved vaults and covers. Pipe penetrations in vault shall be offset to allow 12" clearance from edge of device to edge of vault wall on side opposite of bypass.
4. All fire line services, to the post indicator valve, shall be tested by the Public Works Inspector per City of Santa Rosa Water Distribution Specifications. All onsite fire line appurtenances, including, the post indicator valve and hydrants, shall be inspected and tested by the City of Santa Rosa Fire Department per City Fire Code.
5. Where, in the opinion of the Water Department, there’s potential for a higher level of hazard to exist on any fire service, the service shall be installed per City Standard 880.
6. The fire department connection (FDC) shall be installed and located as required by the Fire Department.
7. Post indicator valves shall be locked with a break-away lock. The post indicator valve status indicator shall not be less than 36" above finished grade.
8. Valve shall be tied down with Fire Department approved rods and concrete blocking. See table on STD-851 for rod and block sizes. 4" valves shall sized the same as a 6".

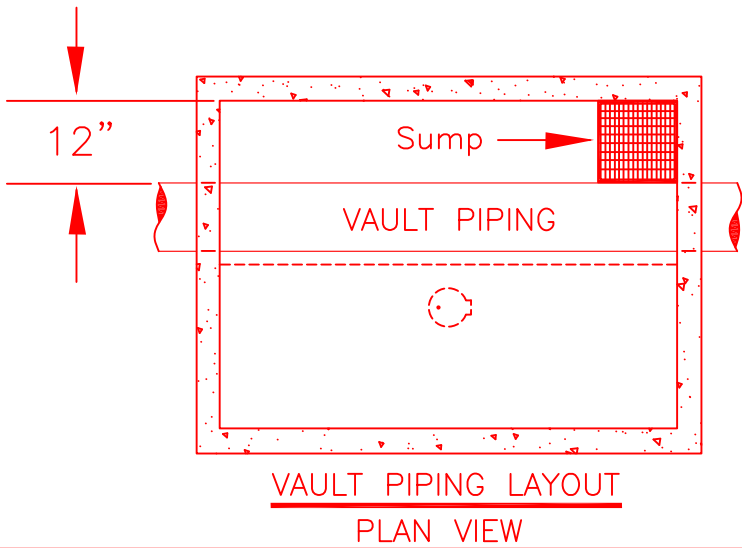

VAULT (inside) DIMENSIONS		
S.D.C. SIZE	WIDTH	LENGTH
4"	4'	6'
6"	4'	6'
8"	5'	7'
10"	5'	7'

CITY OF SANTA ROSA

SINGLE CHECK DETECTOR
ASSEMBLY IN VAULT


Page 2 of 3

SCALE: NONE | DATE: Apr. 2016


DWN: GC
CHK: GC

APPROVED

FILE NO.
STD.– 888

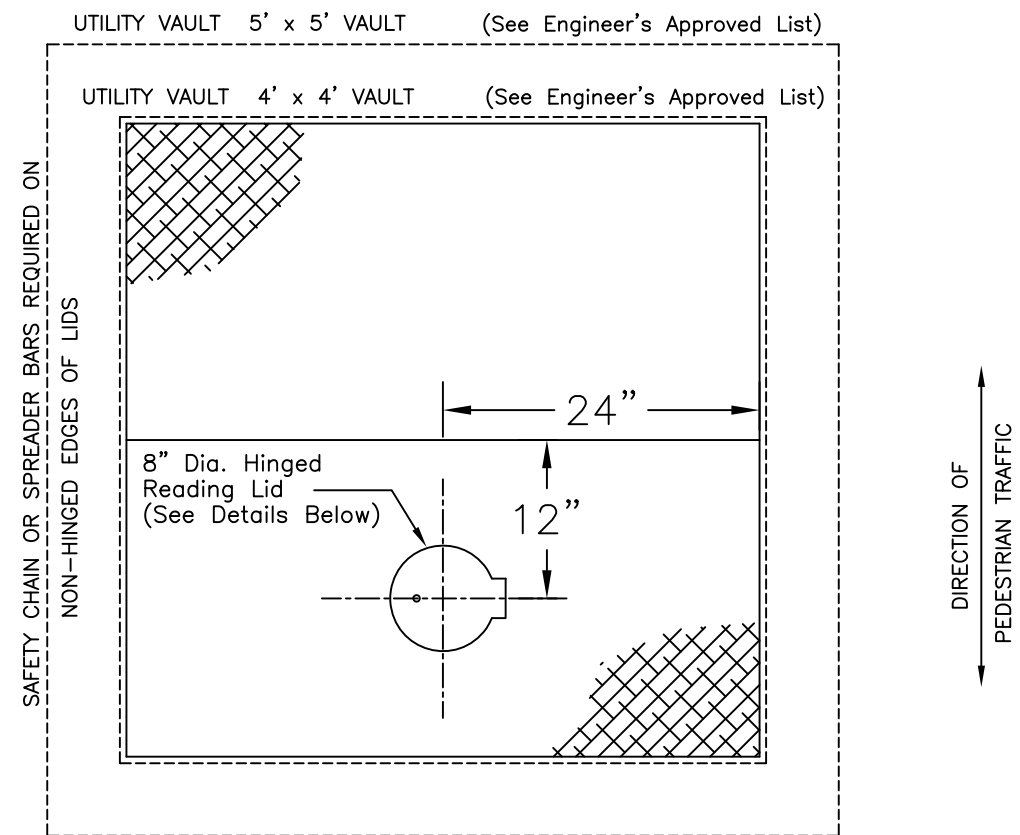

VAULT PLAN

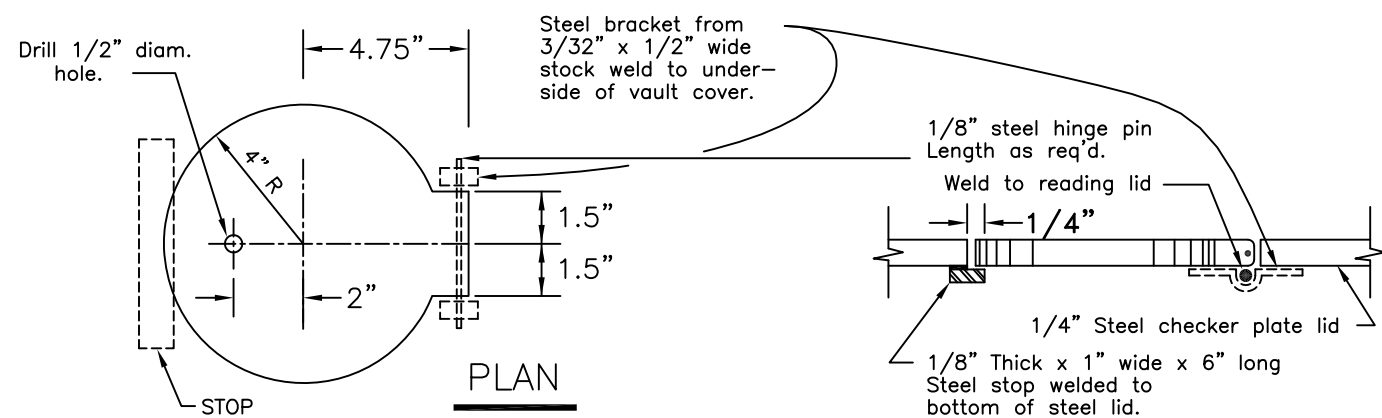

READING LID DETAILS

N.T.S.

NOTES

1. Reading lid shall be centered over the by-pass meter.
2. Galvanize coat all parts after welding. Vaults that are to be placed in pedestrian way must have lids with "all-grip" surface in lieu of galvanizing.


PAGE 3 OF 3

CITY OF SANTA ROSA


SINGLE CHECK
DETECTOR IN VAULT

SCALE: NONE DATE: Sept.2002

DWN: GC CHK: GC APPROVED FILE NO. STD.- 879

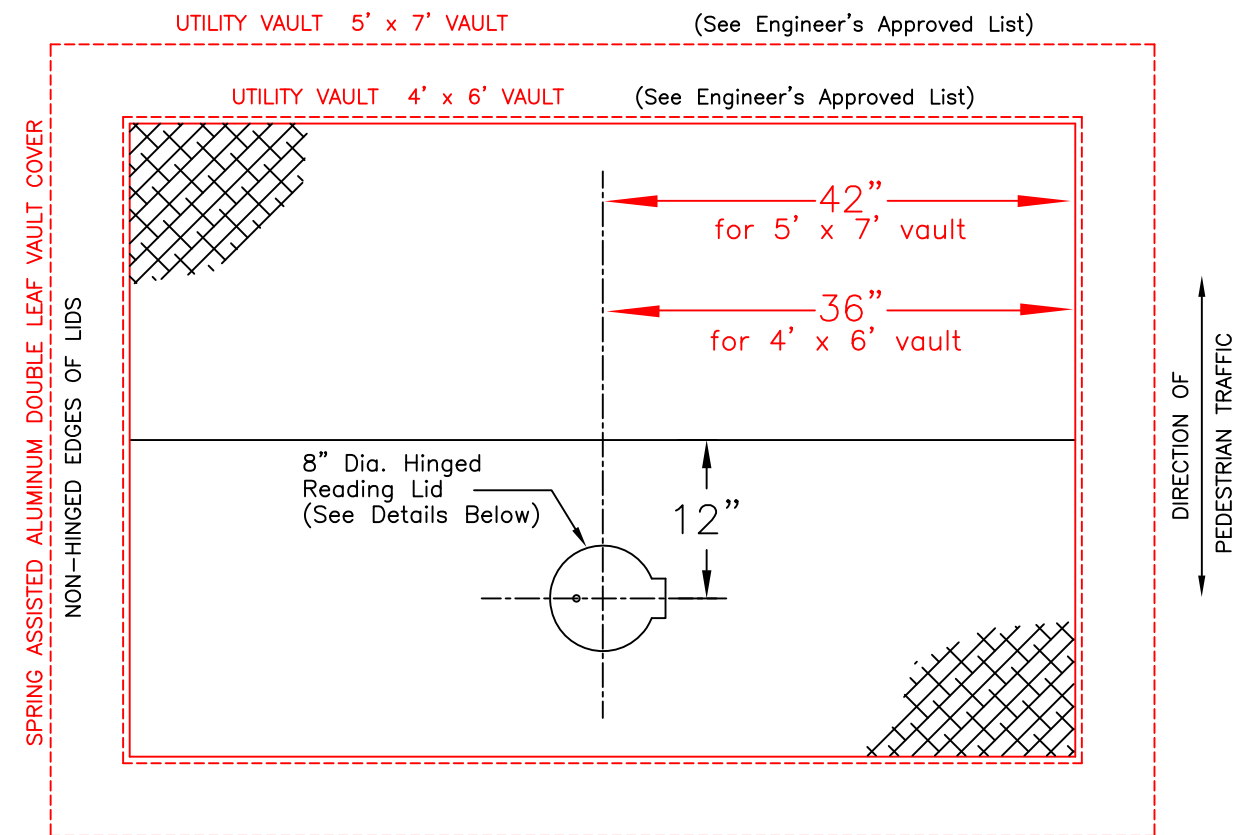

VAULT PLAN

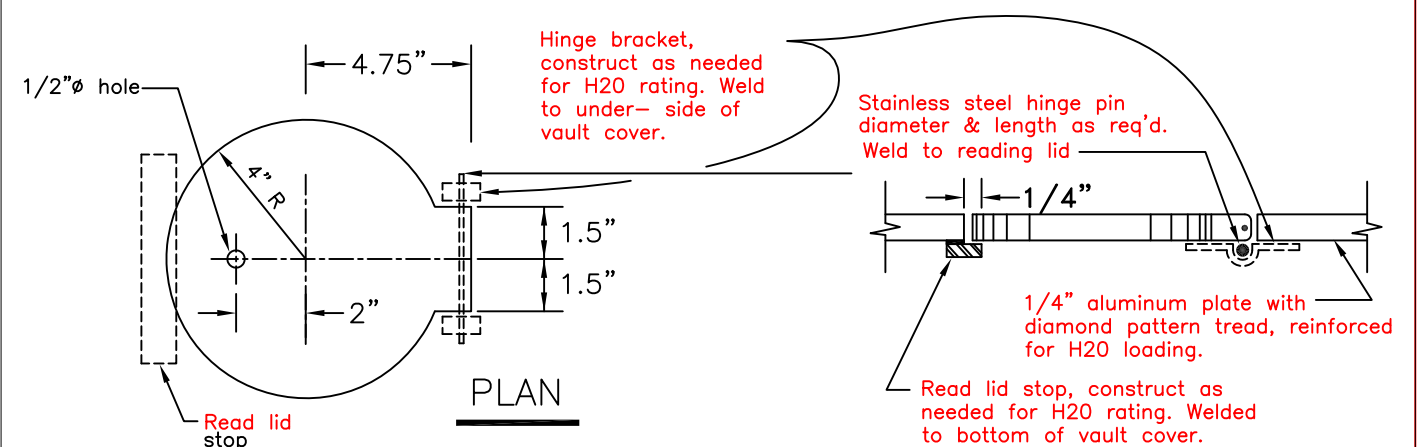

READING LID DETAILS

N.T.S.

NOTES

1. By-pass meter shall be plumbed to center under reading lid. Read lid may be replaced with Automatic Meter Reading probe mount at the direction of the Water Department.
2. Vault cover shall have extruded aluminum channel frame with bend down anchor tabs around perimeter. Hinges shall be heavy forged type 316 stainless steel. Cover shall have a type 316 stainless steel "slam-lock" type latch with fixed interior handle and a removable exterior handle and mechanism to automatically lock doors in the open position. Latch release shall be protected by a flush removable screw plug.
3. Vault cover shall be AASHTO H20 compliant, and have a "non-skid" surface.


CITY OF SANTA ROSA

SINGLE CHECK DETECTOR
ASSEMBLY IN VAULT

Page 3 of 3

SCALE: NONE DATE: Apr. 2016

DWN: GC CHK: GC APPROVED FILE NO. STD.- 888

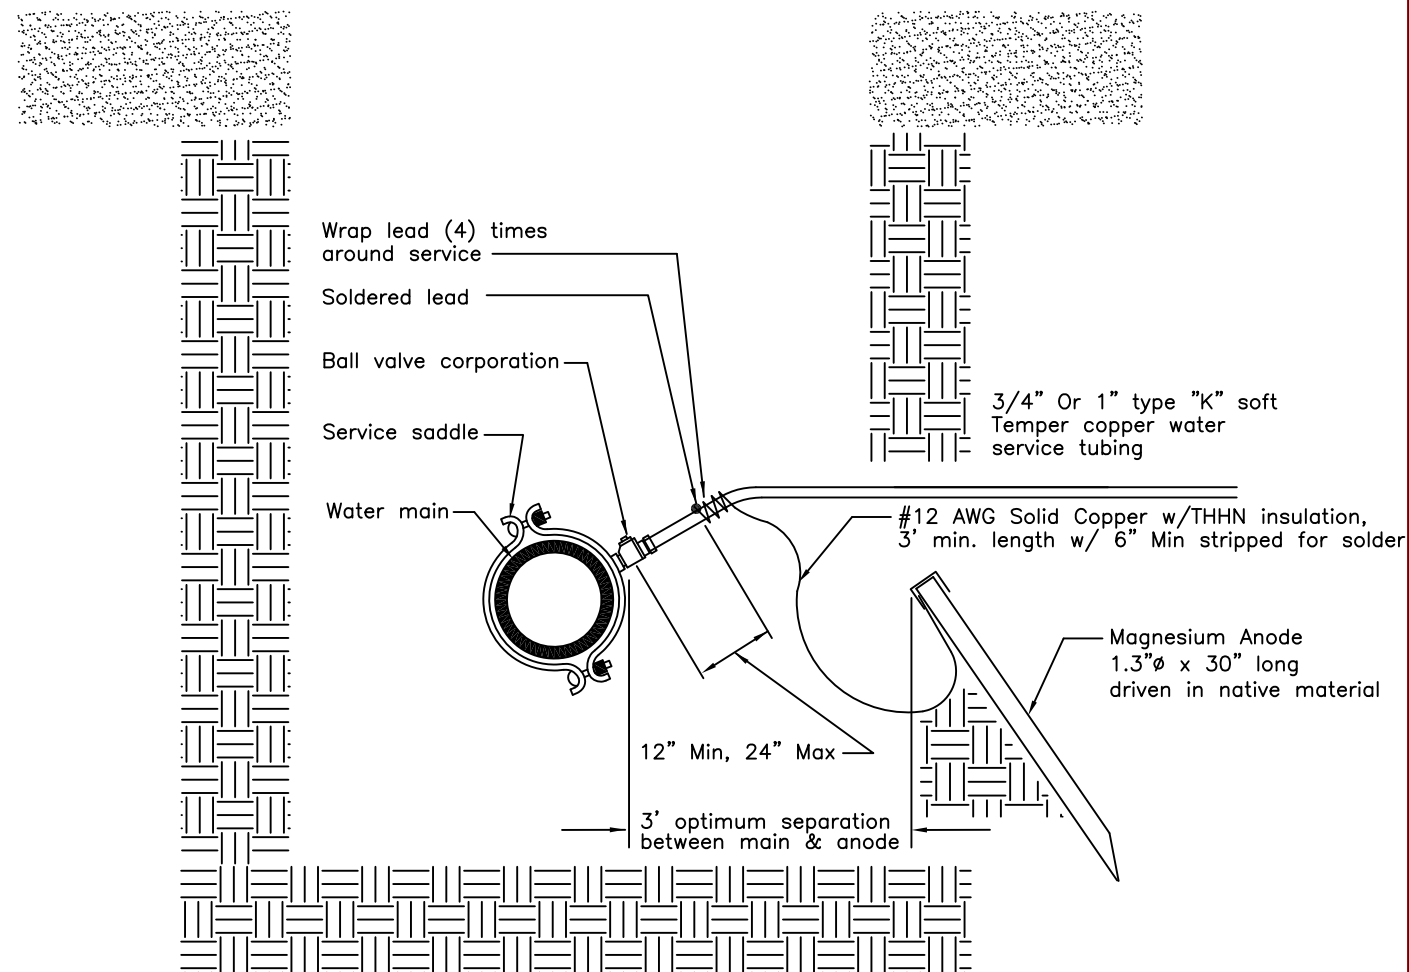

Structural Section




Native material

NOTES

1. Magnesium anode shall be driven completely into native soil at 45°. Maximize distance between copper service and anode.
2. Contractor shall confirm clearance between proposed anode location and other utilities in close proximity prior to driving anode.

CITY OF SANTA ROSA		
WATER SERVICE ANODE		
SCALE: NONE	DATE: Sept.2002	
DWN: TB CHK: RH	APPROVED	FILE NO. STD.- 889

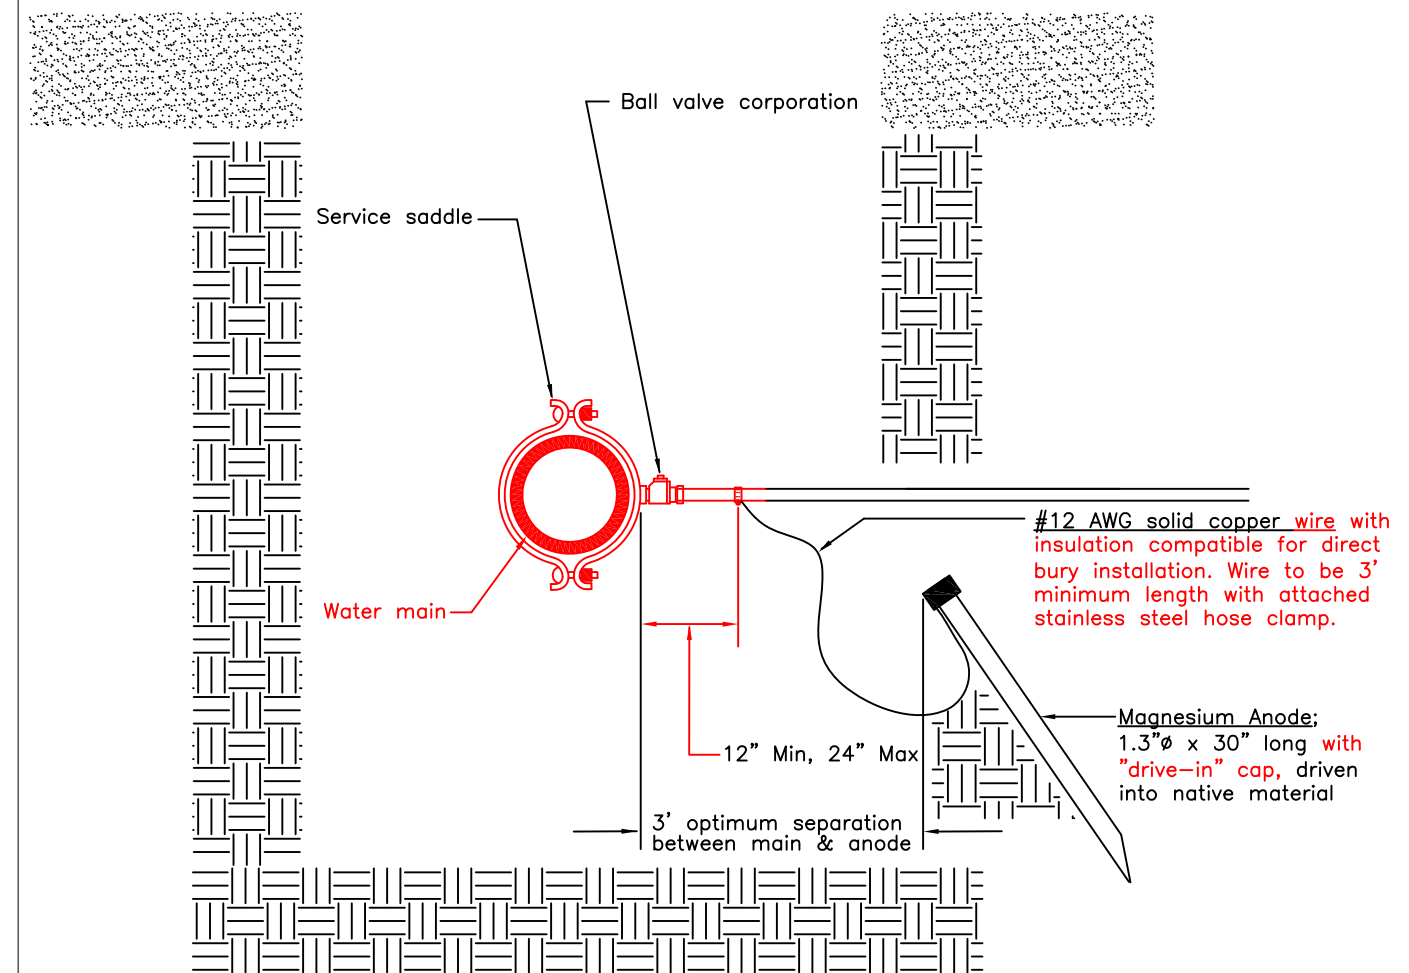

Structural Section



Native material

NOTES;

1. Do not install anode on poly coated copper unless otherwise specified elsewhere in contract documents, or directed by the Water Department.
2. If anode does not have supplied hose clamp connector, wrap bare wire end four times around pipe and solder to service as shown.
3. Magnesium anode shall be driven completely into native soil at 45° angle. Maximize distance between copper service and anode.
4. Contractor shall confirm clearance between proposed anode location and other utilities in close proximity prior to driving anode.

CITY OF SANTA ROSA		
WATER SERVICE ANODE		
SCALE: NONE	DATE: July 2016	
DWN: TB DK CHK: RS	APPROVED	FILE NO. STD.- 889

WATER DISTRIBUTION SYSTEM CONSTRUCTION STANDARD SPECIFICATIONS

SECTION 99132 WATER DISTRIBUTION SYSTEM~~MAIN~~ CONSTRUCTION

99132-1.01 Description

All water distribution system components and related items for new construction and rehabilitation projects shall be constructed in accordance with all applicable City Standards, the latest version of the Standard Specifications as they apply, and any modifications herein. Any proposed deviations must first be approved in writing by the Director of Santa Rosa Water.

~~Construct all water mains and related appurtenances in accordance with the City of Santa Rosa Standard Plans and Standard Construction Specifications for Public Improvements.~~

The Contractor shall provide a full size set of water distribution system “record plans” for their project to the City within 7 calendar days from the final connection to the City’s water distribution system. All deviations from the improvement plans shall be recorded on the plans in red ink.

Permanent paving shall not take place until all underground work is finished, except as otherwise noted, and the Engineer has given written notice of acceptance to the Contractor.
~~Permanent paving shall not take place until all underground work is finished and the City has given written notice of acceptance to the contractor, unless otherwise directed or approved by the Engineer.~~

The pipe manufacturer shall legibly mark pipe materials. Name and/or trademark of manufacturer, nominal pipe size and manufacturing standard reference number shall be printed on the pipe.

99132-1.01A Materials

The Contractor shall use a single manufacturer for each of the following types of items supplied for their project unless otherwise approved by the Engineer;

- Pipe
- Fittings
- Valves
- Meter Boxes

Connections to cast iron (CI), polyvinyl chloride (PVC), or ductile iron (DI) pipe shall be made with mechanical joint solid sleeves. When connecting to asbestos cement (AC) and/or “over-sized” cast iron pipe, “wide range” style couplings from Ford, Smith-Blair, Romac or an approved equivalent shall be used. Submittals are required for all couplings.

The City reserves the right to reject any material that may be supplied for use, whether on the “Engineer’s List of Approved Items” or not. If the City obtains information indicating that a listed item is not performing satisfactorily or is found to be defective, that item will be rejected and the Contractor shall submit a replacement for review at no additional cost to the City.

All materials used shall be lead free per California Health & Safety code, Section 116875.

Per U.S. et al., ex rel. Hendrix v. J-M Manufacturing Co., Inc., et al., Case No. ED CV-06-0055-GW (C.D. of CA), the City of Santa Rosa is not currently accepting PVC pipe manufactured by J-M Manufacturing Co. or JM Eagle for installation on City projects.

99132-1.01B Material Submittals

The Contractor shall submit to the Engineer, in writing, a list of all materials proposed to be used on their project, and any supporting documentation and/or samples required by the Water Department.

For material listed on the "Engineer's List of Approved Items" the Engineer shall be provided with the name of the manufacturer and model/part number for all material proposed for this project, unless that item has been replaced as shown on the Plans or in other contract documents.

For any material not listed on the "Engineer's List of Approved Items" the Contractor shall provide to the Engineer, the name of the manufacturer and model/part number along with supporting documentation and/or samples that will allow the Engineer to make an informed decision on acceptance or rejection of the material.

The Contractor shall submit the installation location for any proposed use of flange fittings. Use of flanged fittings other than those already specified herein must be approved by the Director of Santa Rosa Water.

99132-1.02 Pipe

Unless otherwise approved by the Director of Santa Rosa Water, water distribution pipe shall be ~~The pipe except where otherwise specified on the plans can either be~~ either Ductile ~~Cast~~ Iron Pipe (DIP) or Polyvinyl Chloride (PVC) all in accordance with the following:

- A. Ductile Iron Pipe (DIP) shall be cement lined, new pipe conforming to AWWA Standard C151, pressure class 350. The pipe shall be furnished with either Bell and spigot end, "Tyton Joints" or Mechanical Joints ~~unless otherwise approved by Santa Rosa Water. except where otherwise specified on the plans.~~

All Ductile Iron pipe buried underground shall be encased with 8 mil (minimum) polyethylene film in tube form. Polyethylene material and installation procedure for the encasement shall conform to ~~ANSI/AWWA C105/A21.5-99~~ or most recent issue.

- B. Polyvinyl Chloride (PVC) Pipe, 4" through 12", shall be new pipe, with a minimum ~~class~~ ~~150~~ pressure class (PC) rating of PC235, DR18 ~~or as shown on the plans and~~ conforming to the requirements of AWWA ~~Standard~~ C900 "Standard for Polyvinyl Chloride (PVC) Pressure Pipe and Fabricated Fittings, 4" through 12" for Water Transmission and Distribution, ~~4 inch through 12 inch for Water~~". 16" Polyvinyl Chloride (PVC) pipe, ~~for~~

~~16" diameter water mains~~ shall be new pipe, with a minimum pressure class (PC) rating of PC165, DR25 ~~conforming to~~ conforming to the requirements of AWWA ~~standard C905~~ "Polyvinyl Chloride (PVC) Pressure Pipe and Fabricated Fittings, 14" through 48". ~~C-905 DR-25, minimum pressure rating 165 or as shown on the plans.~~

An affidavit shall be provided that all delivered materials comply with the requirements of AWWA ~~Standard C900/C905~~ and these specifications.

Water distribution pipes of different sizes and/or materials than those specified above shall only be used when first approved by the Director of Santa Rosa Water.

Any pipe that is delivered to the job site that, in the opinion of the Engineer, shows signs of contamination, damage and/or defect, may result in the rejection of any pipe that was delivered to the supplier on the same shipment.

Tracer wire shall be laid on the top of and along the entire length of all water pipe and HDPE tubing and shall be extended to the surface at all valve locations, blow-offs and meter boxes sufficiently for locator equipment to be attached. Tracer wire shall be 12 AWG solid copper wire with a blue type UF 60 mil insulation that is designed for use in the detection of underground utilities. ~~No. 12 insulated solid copper wire shall be laid on top of and along entire length of all new pipes, except for copper services, and shall be extended to the surface at all valve locations, blowoffs/blow-offs and meter boxes sufficiently for locator equipment to be attached.~~ Except where otherwise noted on individual City Standards, ~~F~~fasten the wire to the top of the pipe ~~unless otherwise shown on individual City Standards,~~ so as not to be displaced ~~by~~during backfilling ~~procedure~~operations, (one method of accomplishing this is to affix the wire to the top of the pipe with duct tape at approximately 10 feet intervals). Where splicing is required only watertight connectors shall be used, and shall be either Copperhead Snakebite, 3M DBR, or an approved equivalent.

99132-1.03 Copper Water Service Tubing

All copper water service tubing shall be factory coated "blue" with a polyethylene coating that has a minimum coating thickness of 0.025". The copper tubing shall conform with the latest AWWA Standards as described in ~~ANSI~~AWWA C800 of the latest revision, and with ASTM B88. ~~and shall be~~Type K soft temper tubing shall be used for ~~3/4" and 1" tubing services,~~ and Type K hard temper tubing for ~~2" tubing service sizes of 1-1/2" and 2" services.~~ **No splices allowed**

Tubing shall be continuously marked at a minimum with; manufacturer, size, specification information and manufacturing codes.

99132-1.03A High Density Polyethylene (HDPE) Water Service Tubing

All HDPE water service tubing shall be blue copper tubing size (CTS) SDR9 tubing, and shall conform to both AWWA C901 and ASTM D2737, and shall be either PE3608 - 200psi tubing or PE4710 - 250psi tubing.

Tubing shall be continuously marked at a minimum with; manufacturer, size, specification information and manufacturing codes.

If soil contaminations is suspected during construction the Contractor shall notify the Engineer prior to the installation of HDPE material. Use of HDPE material within or adjacent to areas of known contaminated soils is strictly prohibited.

99132-1.04 Fittings

All fittings 3” through 16” shall be new ~~gray iron or~~ ductile iron fittings conforming to ~~ANSI/AWWA C110/A21.10~~, or new ductile iron compact fittings conforming to ~~ANSI/AWWA C153/A21.53~~ of the latest revision and shall be compatible with the type and pressure class of pipe used.

Unless otherwise approved herein or by the ~~Engineer~~ Director of Santa Rosa Water all fittings shall be mechanical joint type.

Flanged fittings shall only be used on above ground installations or on tees or crosses when attached to a flange (FL) x mechanical joint (MJ) valve or approved fitting, or as otherwise approved by the Director of Santa Rosa Water.

All non stainless steel bolts, ~~exposed nuts, bolts~~ and threads (~~except stainless steel~~) shall be coated ~~painted~~ with bitumastic paint or Permatex spray-on heavy duty rubberized under-coating or an approved equivalent. ~~Bitumastic paint or approved equal after nuts are tightened.~~ All nuts shall be fully tightened and surfaces to be coated dried prior to application. The use of an anti-galling agent is required on all stainless steel bolts.

99132-1.04A Restrained Joints and Fittings

In general, and unless otherwise specified or allowed by the Director of Santa Rosa Water, all new water distribution system installations of 4” and larger shall be a “Restrained Joint System” where, in lieu of, or in addition to concrete thrust blocks and/or harnesses, approved mechanical restraint devices are used to restrain the system. The Project Design Engineer shall show joint restraint, at a minimum, on all tees, crosses and on all joints required to make a bend in the alignment of the water system. This is to include all joints on either side of a bend to a calculated distance with the calculation including, at a minimum, a safety factor of 2 to 1, size of pipe(s), angle of bend(s), depth of cover, type of compaction, and test pressures as specified herein.

All water distribution system installations that are 12” or larger and are in an area where the static system pressure is 90psi or greater shall comply with the above requirements and shall include concrete thrust blocks and/or harnesses in their design and construction per applicable City Standards.

Restrained joint fittings shall be **mechanical joint type** ductile iron in accordance with the applicable requirements of ~~ANSI/AWWA C111/A21.11~~ and ~~ANSI/AWWA C153/A21.53~~ of latest

revision and shall be compatible with the type and pressure class of pipe used. Mechanical restraint devices of 4" through 16" shall have a minimum working pressure of 350 psi.

Ductile iron pipe locking gaskets such as "Field Lok 350 Gaskets manufactured by U.S. Pipe", or an approved equivalent, may be approved by Santa Rosa Water for use on specific installations. Requests and submittals for use shall be accompanied by supporting documentation. Information provided shall include, at a minimum, specifications of product, manufacturer's installation instructions, and compatibility acceptance from the pipe manufacturer.

99132-1.04B Cut-in Tee or Cross

Contractor shall install a new tee or cross on an existing main, with or without valve(s), by "cut-in" at the location(s) shown on the Plans per City Standards 854 and 877. In general, and to mitigate the necessity for prolonged shutdown times, the "cut-in assembly" shall be assembled as much as possible prior to shutting down the City's distribution system. Connection to the existing mains shall be by approved couplings as noted herein unless otherwise approved by the Director of Santa Rosa Water.

99132-1.05 Gate Valves

Gate valves shall have ductile iron bodies and bonnets and resilient seated gates, and shall conform to ~~A-W-W-A-~~ Standard C509 and/or AWWA Standard C515 of the latest revisions. All gate valves, unless otherwise specified, shall be non-rising stem (NRS) type with O-ring stem seals. Gate valves installed above grade or in vaults shall be equipped with an approved hand wheel. Outside screw and yoke (OS&Y) rising stem type gate valves shall only be installed where specified or approved by the Water Department. All gate valves shall open in the counter clockwise direction. Where elevations on buried installations will not allow a minimum of six inches of cover over the valve nut, the Contractor shall submit for approval, by the Water Department, the installation of a horizontally installed gate valve with manufacturer installed bevel gearing. Bonnet direction of horizontally installed gate valves must be approved by the City and shall be recorded on the record plans. ~~and shall be the resilient seat type with non rising stem opening counter clockwise with O-ring stem seal and suitable ends for connection to the type of pipe or fitting used.~~

The working pressure rating of gate valves shall meet or exceed the pressure rating of the pipe specified on the plans. ~~External~~ Gate valve bolts and nuts shall be ~~304~~ stainless steel, and joint connection bolts and nuts shall be 304 stainless steel or coated as specified herein. ~~or poly wrapped per standard.~~

Gate valves shall be Mechanical Joint type unless otherwise specified herein or approved by the Engineer.

New gate valves shown to be installed by "cut-in" on an existing main shall be done by removing a section of the existing main and installing the required gate valve, pipe and couplers as specified in the City Standards. Sections of pipe used shall be at least 18 inches in length ~~unless otherwise directed by the Engineer.~~

When any part of the new water system is pressurized, all affected gate valves shall be at grade and accessible to City personnel at all times. Valves that require “valve stem risers” shall not be considered accessible unless the riser is in place and operational.

99132-1.06 Butterfly Valves

Butterfly valves shall only be installed where approved by the Director of ~~Utilities~~ Santa Rosa Water.

Butterfly valves shall be flanged or mechanical joint type only and ~~shall conform~~ shall conform to AWWA ~~Standard~~ C504 of latest revision and shall be of the rubber seat type. Valve discs shall rotate 90 degrees from the full open position to the tight shut position. The valve seat shall provide a tight shutoff at a pressure differential of 150 psi upstream and 0 psi downstream in either direction. The valve operator shall be the traveling nut type. Valve shall open with a counter-clockwise rotation of the operating nut.

99132-1.07 Valve Boxes, Vaults and Pits

Each gate valve shall be covered by a precast 8" valve box set flush with street surface with cast iron ring and cover marked "WATER".

Valve box riser pipe shall be installed centered over and plumb with the valve nut prior to final paving. If riser pipe needs to be lowered for paving it shall be cut by hand perpendicular to the axis of the pipe and free of jagged edges. If sections need to be added after paving it shall be done per Standard 877. The riser pipe shall extend into the bottom of the valve box a minimum of 2 inches and the upper section shall be no shorter than 1-foot in length.

If valve stem risers are required they shall be installed and checked for operation prior to paving.

All meter boxes, vaults and pits shall be bedded on 3" minimum thick, 3/4" drain rock, or other ~~approved~~ clean material with typical sand equivalent of 20 minimum, uncontaminated by native soil, against compacted or undisturbed base. The gravel bed shall extend to a 4" minimum beyond all sides of the meter box. Box shall be set flush with top of curb, sidewalk or ground, whichever is applicable. Addresses ~~must~~ shall be clearly marked on top side lip of meter box with a permanent marking pen.

Meter boxes and vaults shall be set so that the reading lids are aligned over the meter registers as closely as possible.

99132-1.08 Locating and Adjusting Water Valve Boxes

After a street has been paved, mark the location of all water valve boxes in white paint before the close of that work day. ~~If multiple paving lifts are required, remark box locations after each lift.~~

Within 48 hours of paving, adjust all water valve boxes up to grade.

If an existing valve box riser pipe is found to be asbestos cement, the entire pipe shall be removed and new riser pipe installed per Standard 877. See Section 132-1.10 Asbestos Cement Pipe herein for additional requirements.

99132-1.09 Fire hydrants and Lateral Assembly

Unless stationing is specifically called out, fire hydrant locations, as shown on the plans, are approximate and shall be field located with the Engineer's approval.

Fire hydrant and lateral assemblies that are installed on an existing water main by "cut-in" requires that the disinfection and bacteria test sampling shall take place prior to hydrostatic testing. The Contractor shall request, and the Engineer shall provide the proper procedures for this operation.

~~At the location(s) shown on the plans, the Contractor shall provide and install a fire hydrant and lateral assembly in accordance with City Standard 857.~~

No bends are allowed in fire hydrant laterals without approval of the Director of **Santa Rosa WaterUtilities**.

Fire hydrants serving one and two family residential use have one 2-1/2 inch outlet and one 4-1/2 inch outlet. Fire hydrants serving commercial and multi-family residential uses have one 2-1/2 inch outlet and two 4-1/2 inch outlets.

Paint all hydrants in accordance with City Standard 857.

Before a public fire hydrant may be placed in service, a high velocity flushing of the hydrant lateral shall be witnessed and approved by **Santa Rosa WaterUtilities** Department personnel.

All concrete which is to be removed from sidewalk areas for fire hydrant removal or installation shall be removed to the nearest transverse score mark across the full width of sidewalk and replaced as specified per applicable City Standards and Specifications.~~in Section 73 "Concrete Curbs and Sidewalks" of the City Standards.~~

99132-1.10 Asbestos Cement Pipe

The installation of asbestos cement pipe is prohibited.

Cutting of Asbestos Cement Pipe (ACP) shall be done utilizing a Pipe Cutter (snapper), of the proper type and size for the intended use. A ratcheting hand snapper shall only be used on ACP sizes of 6 inch and smaller. The "snapper", and all appurtenances shall have been inspected by the Contractor to ensure that it is in good working order prior to use.

If field conditions require an alternative method for cutting the ACP, the alternative method shall comply with all laws and requirements as specified by OSHA, the Contractor's State Licensing Board, and any other governing body for this type of work.

In all cases, cutting, handling and disposal shall be done per the above stated governing bodies. Cut pipe shall be properly enclosed as soon as possible after removed from the trench. ~~All cutting, handling and disposal of asbestos cement pipe shall be done in compliance with the Contractor's State Licensing Law and all applicable laws and regulations.~~

99132-1.11 Excavation, Backfill, and Resurfacing

All trenching, backfill and resurfacing required for installation of water distribution system facilities shall be in accordance with all applicable City Standards, specifically Standard 215, or as modified on the plans, and approved by the City of Santa Rosa Materials Engineer.

If existing utility crossings or other potential conflicts are shown on the plans or specified in other contract documents, the Contractor shall pot hole said areas prior to the start of pipe laying. If conflicts are discovered during this investigation the Engineer shall be notified immediately.

An **air gap** shall be in use at all times when dewatering to the sanitary sewer system.

It is the Contactor's responsibility to ensure that water system components are laid and bedded on sound, stable material. All existing material that has been disturbed shall be removed from the trench prior to installation of new material. The Contractor shall promptly notify the Engineer of any field conditions that may affect alignment and/or grade.

All stumps and large roots encountered during trenching operations shall be removed to the satisfaction of the Engineer.

Where excavations occur within the drip line of any tree, the Contractor shall hand dig to protect tree roots. If necessary for installations, roots one inch in diameter or smaller may be cut neat by hand tool. Unless otherwise specified, cutting roots larger than one inch in diameter shall only be done with City approval.

The trench shall be opened sufficiently ahead of the pipe laying operations to reveal obstructions. Trench crossings shall be provided as necessary to accommodate public travel and to provide convenient access to adjacent properties. Flow shall be maintained in any sanitary sewers, storm drains, water lines, or water courses encountered in trenching.

When the public works involved will exceed an estimated \$25,000 for the excavation of any trench or trenches five feet or more in depth, the Contractor shall, except for subdivisions, submit to the City Engineer for acceptance in advance of job excavation, a detailed plan showing the design of shoring, bracing, sloping, or other provisions to be made for worker protection from the hazard of caving ground during the excavation of such trench or trenches. If such plan varies from the shoring system standards established by the construction safety orders, the plan shall be prepared by a registered civil or structural engineer. A permit to do the above described work must be obtained from the State of California, Division of Industrial Safety. Proof of such permit shall be submitted to the Engineer prior to starting the trench work.

Unless otherwise specified, ~~Excess Material~~ material from excavation shall become the property

of the Contractor and shall be disposed of to the satisfaction of the Engineer. If the work is in existing City streets the excess material shall be removed from the site daily unless it has been preapproved for reuse.

Prior to disposal of any materials or operation of any equipment on sites provided by the Contractor for disposal of excess trench excavation owned by him, the Contractor shall submit to the Engineer written authorization for such disposal of materials and entry permission signed by the owners of the disposal site and the required permits.

All excavations shall be able to accommodate any typical compaction and testing equipment and personnel used to backfill the trench. If, in the opinion of the Engineer, typical methods cannot be used, the Engineer may require the use of a pneumatic Pogo Stick/Powder Puff type compactor at no additional cost to the City.

All lateral services constructed under curb, gutter and driveway culverts shall be accomplished by use of a trenchless method approved by the Engineer, unless otherwise specified. Boring under sidewalks and/or concrete filled planter strips will not be allowed. Boreholes shall be only large enough to allow for the size of pipe to be installed. If the Contractor's operations disturbs the supporting soil, the Engineer may require the removal and replacement of any undermined sidewalk, curb, gutter or culvert; and/or the use of CDF backfill at the Contractor's expense. The limits of curb and gutter replacement and any required doweling will be at the discretion of the Engineer.

Blasting shall not be permitted unless first approved of, in writing, by the Building Department and the Director of Santa Rosa Water.

Controlled density fill (CDF) shall be placed at the locations shown on the plans and where cover is less than 3 feet unless otherwise specified herein, on the plans, or approved by the Director of Santa Rosa Water. CDF shall conform to City Standard 215, and a material submittal is required for approval. All excavations in a traveled way with CDF backfill shall be plated or otherwise safely covered to allow for safe passage during curing.

Trenching operations shall be conducted in such a manner that will not disturb existing facilities. The Contractor shall incur all costs associated with repairs needed, in the opinion of and to the satisfaction of the Engineer, by any such damage due to their operations.

Unless otherwise approved by the Engineer, all excavated material shall be removed from the job site each day.

Five days prior to cutting into any traffic detector loop the Contractor shall notify and coordinate with the Engineer.

99132-1.11A Trench Bracing and Shoring – Water

All bracing and shoring shall conform to Section 7-1.02K(6) of the Standard Specifications, the Division of Industrial Safety Construction Safety Orders which are currently in use, and any additional requirements specified by the Engineer.

Trench sheeting or boxes shall be withdrawn in such a manner as to prevent caving at the walls of excavations or damage to piping or other structures. Sheeting shall be completely removed from the trench and no backfill shall be installed against the sheeting before it is removed. ~~Except as may be hereinafter modified, no sheeting shall be left in the trench and no backfill shall be made against the sheeting before it is removed. Any sheeting extending below the bottom of the pipe or structure shall be left in place by cutting off in a manner satisfactory to the Engineer. Trenching operations shall be conducted in such a manner that will not disturb the existing curb and gutter and the existing utilities.~~

The Contractor shall take all necessary measures to protect workers, adjacent areas, and structures, and all other facilities from the hazards of the trenching operations.

99132-1.12 Laying and Handling Pipe Materials

All pipe stockpiled on the job shall be stored with the ends covered to prevent the entrance of foreign matter. The Engineer may reject stockpiled pipe with exposed ends. Whenever pipe laying is not in progress, the open ends of installed pipe shall be closed watertight by mechanical plug, cap or other means approved by the Engineer.

Proper implements, tools, and facilities satisfactory to the Engineer shall be provided and used by the Contractor for safe, convenient, and workmanlike prosecution of the work.

Prior to start of pipe laying, the Contractor shall expose the ends of the existing mains to determine individual lines and grades. New mains shall begin approximately 8 feet from and on the same line and grade as the existing main unless otherwise shown or approved. New mains shall be installed at minimum standard cover conforming to the requirements of the City Water Distributions System Design Standards, or as shown on the Plans. Where, in the opinion of the Engineer, new mains cannot start on the same lines and grades and the existing main, restrained fittings shall be used to make grade and/or alignment transitions for tie-ins to existing mains. This does not eliminate the requirement for thrust blocking unless specifically ~~stated on the on the Plans or in these Special Provisions~~ specified elsewhere. ~~Start excavation by exposing end of existing pipe to determine its line and grade. Start laying new pipe 8-10 feet from the existing and install new pipe at or below the minimum depth specified in Section VIII-B of the Water System Design Standards. Elbows and ductile iron pipe shall be used to make grade adjustments as needed during tie-in operations.~~

All pipe fittings and valves shall be carefully lowered into the trench in such a manner as to prevent damage to pipe coatings. Under no circumstances shall pipe or accessories be dropped or dumped into the trench. Before lowering and while suspended, the pipe shall be inspected for defects and the cast iron pipe rung with a light hammer to detect cracks. Any defective, damaged, or unsound pipe shall be rejected and sound material furnished. Cutting of pipe for inserting valves, fittings, or closure pieces shall be done in a neat and workmanlike manner without damage to pipe. All pipe stockpiled on the job shall be stored with the ends covered to prevent the entrance of foreign

matter.

Installation of all pipe joints shall be per manufacturer's recommendations and installation instructions, and all PVC bell and spigot joints, up to and including 8 inch, shall be assembled using the bar and block method. At any time and at no additional cost to the City the Engineer may require the use of a device to prevent "over-insertion" such as a Mega-Stop Series 5000 from EBAA Iron, or an approved equivalent. All joints that are, in the opinion of the Engineer, over-inserted, shall be pulled back to the proper insertion point or removed and replaced at the Engineer's discretion. Any adjacent joint that may have been disturbed due to the over-insertion shall be allowed to be inspected by the Engineer and if required shall be pulled back or removed and replaced.

Whenever it is necessary either in vertical or horizontal plane, to avoid obstructions or when long radius curves are permitted, the amount of deflection shall not exceed the maximum recommended by the pipe manufacturer or that required for satisfactory jointing.

Each length of pipe shall be free of any visible evidence of contamination, dirt, and foreign material before it is lowered into its position in the trench, and it shall be kept clean by approved means during and after laying. At times when pipe laying is not in progress, the open ends of any pipe which have been laid shall be closed by approved means to prevent the entrance of small animals or foreign material. Trench water shall not be permitted to enter the pipe.

Existing utilities shall be supported in place with service maintained during construction.

If proper separation between water mains and sewer lines, per the latest guidelines from the California State Water Resources Control Board cannot be maintained, the Contractor shall inform the Engineer immediately to get direction, unless direction has been already provided in the contract documents. See Appendix "A" of the City of Santa Rosa Water Distribution System Design Standards for additional information and direction.

Proposed water main elevations may need to be adjusted in the field to allow for the required separation with sanitary sewer lines and other facilities. If water system components are proposed to be installed prior to sanitary sewer or storm drain components, the Contractor shall investigate for the possibility of conflicts or inadequate separation of facilities. The Contractor shall perform this investigation prior to water system installation and provide all relevant information in writing to the Engineer immediately upon discovery of any conflict.

99132-1.13 Laying P.V.C. Pipe

Individual pieces of pipe, valves, and fittings shall be joined by placing the rubber rings on the machined ends of the pipe and pulling the couplings, valves, or fittings in accordance with the manufacturer's recommendations. The rings shall be checked to be sure they are in the proper position after the coupling is in place. Care shall be taken to insure proper seating of the rings, and adapters shall be utilized for connections as required by the manufacturer.

Where ground water occurs, pumping shall continue until back filling has progressed to a sufficient

height to prevent flotation of the pipe. Water shall be disposed of in such a manner as to cause no property damage or not be a hazard to public health

~~Fittings for P.V.C. pipe shall be either the mechanical joint type or push-on type unless otherwise approved herein or by the Engineer.~~

~~No. 12 insulated copper wire shall be laid on top of and along entire length of all new pipes and shall be extended to the surface at all valve locations, blowoffs and meter boxes sufficiently for locator equipment to be attached. Fasten the wire to the top of the pipe so as not to be displaced by backfilling procedure (one method of accomplishing this is to affix the wire to the top of the pipe with duct tape at approximately 10 feet intervals).~~

99132-1.14 Laying of Ductile Iron Pipe

Ductile iron pipe, and their appurtenances, shall be as specified in and installed per AWWA C600 of latest revision, ~~and~~ in accordance with the manufacturer's recommendations and any modifications herein.

99132-1.14A Water Main Lowering/Over-Structure

Attention is directed to Sections 99132-1.04 and 99132-1.04A of these Construction Specifications.

Where shown on the Plans or as directed by the Engineer to lower or raise the alignment of the water main or 3" or larger service lateral using fittings, the alignment change shall be done in accordance with Section VI. "B" of the City of Santa Rosa Water Distribution System Design Standards and these Construction Specifications.

If the Contractor elects to install a partial or full water main lowering to make a grade transition in place of roping the pipe if roping is shown on the plans, they shall first receive written approval from the Engineer. The lowering shall be installed per City Standards and shall include restrained joints beyond the lowering to a calculated distance as directed by the Engineer.

The flame cutting of pipe by means of oxyacetylene torch ~~is~~ shall not be allowed.

99132-1.15 Service Laterals

Service laterals other than those shown or noted on the plans shall not be installed prior to obtaining ~~City~~ approval from the Director of Santa Rosa Water. Service laterals encountered in construction that will not be used shall be abandoned.

99132-1.15A Water Services

The Contractor shall install new water service laterals per applicable City Standards at the locations shown on the Plans.

If a new water service lateral is replacing an existing lateral, the work shall include abandoning the old service lateral pipe or tubing, removal of curb stop valve(s), removal and disposal of old meter boxes, and removal, disposal and replacement of any existing sidewalk, curb and gutter as needed.

Typically replacement service laterals shall be designed and constructed per all other City requirements and as close as practical to the existing laterals they are replacing. Exact locations shall be determined in the field and approved by the Engineer. New service laterals shall be installed with a minimum horizontal clearance of 5 feet from sewer laterals.

HDPE and type "K" soft temper copper water services shall be one continuous length (no splices), from the water distribution main to the water meter. For water service laterals of other material types the Contractor shall minimize joints as much as possible.

Water service ~~tie-ins~~connections to existing building service lines of 3/4" or 1" in size shall be made with type "K" hard or soft temper copper or schedule 80 PVC tubing, and shall match the size of the existing service line. ~~When existing service is galvanized iron dielectric protection is required.~~

Water Service ~~tie-ins~~connections to existing building service lines of 1-1/2" to 3" in size shall be made with type "K" hard temper copper tubing and shall match the size of the existing service line. ~~When existing service line is galvanized iron dielectric protection is required.~~

When connecting to any service line under 4" that has a backflow prevention device, threaded brass or type "K" hard temper copper tubing shall be used unless otherwise shown on individual Standards. If the existing pipe between the meter and backflow device is found to be plastic, the Contractor shall inform the Engineer, and replace the existing pipe with threaded brass or type "K" hard temper copper.

When ~~the~~an existing service line is found to be galvanized iron, an approved dielectric ~~protection~~fitting shall be required. The use of PVC material as dielectric protection is not acceptable. ~~If the existing pipe between the meter and backflow device is found to be plastic the Contractor shall replace the existing pipe with threaded brass or type "K" hard temper copper.~~

Except as required to comply with City Standards, ~~B~~bends and/or fittings shall not be ~~permitted~~installed under~~the~~ sidewalk or concrete planter strips.

Connections to existing water service lines shall be made behind sidewalk or at the back of P.U.E., ~~and all tie-ins to the existing service lines shall be made behind the sidewalk, unless otherwise shown on the Plans and/or directed by the Engineer.~~

Submittals are required on all material used for service tie-ins.

When connecting to a 5/8" x 3/4" water meter the street side curb stop shall be a 1" x 3/4" angle meter ball valve (submittal required), and the meter box shall be per Standard 863.

~~Excavations under existing curb and gutter for installation of water services shall be accomplished by use of a mole or other boring device, or by mechanically pushing a pipe through the soil to create an opening for the lateral. The opening shall be no larger than necessary to allow for the service line.~~

~~Where an excavation for a water service disturbs the supporting soil under the existing curb and gutter, as determined by the Engineer, the Contractor shall replace the undermined curb and gutter at the Contractor's expense. The limits of curb and gutter replacement as well as any necessary doweling to adjacent curb gutter shall be as required by the Engineer.~~

~~Where an excavation for a new water service occurs within the drip line of any street tree, the Contractor shall hand dig to protect tree roots, as directed by the Engineer.~~

After the new water system is connected to the existing City water distribution system the Contractor shall purge the new service of air and sediment prior to new meter installation or the transferring of the existing water meter.

Prior to transferring an existing water meter ~~the Contractor shall notify each~~ the affected customer before shutting down their ~~existing service and transferring the meter~~. The Contractor shall coordinate this work to provide minimum customer out-of-service time and inconvenience. All existing water meter transfers and service tie-ins shall be witnessed by the field Inspector, and it is the Contractor's responsibility to coordinate this inspection.

The Contractor shall shut off any available property side valve on the existing service prior to cutting into the line and after the meter transfer, but prior to activating the new service, the Contractor shall notify the customer that the water is coming back on, then open the property side valve and flush the new service for a minimum of 5 minutes and until the water is clear and free of all air and foreign matter.

The existing building service line to be connected to may be metal or plastic and may not be the same size as the new service. The Contractor shall provide couplings, ~~connectors~~ adapters and fittings as necessary to complete the connection to the new water service line. ~~at no additional cost to the City.~~

Where a new services ~~are~~ is connected to existing backflow devices the Contractor shall provide documentation that the backflow devices ~~has~~ ~~ve~~ been certified after installation. Certifications shall be completed by a certified tester off the "*City of Santa Rosa Approved List of Backflow Testers*". All necessary paperwork shall be completed by the Tester and one copy given to the property owner and one to the City's Water Quality Section within 72 hours after connection.

Where new service laterals of 2" in diameter and smaller are connected to existing water mains, a minimum distance of 18" ~~inches~~ shall be maintained between taps, whether new or existing. For hot taps larger than 2" the Contractor shall request spacing requirements from the Engineer, which will be determined based on size and material.

Individual hot taps may be requested a minimum of 2 working days in advance, if the request is for multiple hot taps to be done on the same day the request shall be made a minimum of 5 working days in advance. The City Water Department will attempt to facilitate hot taps within these timeframes; however, extenuating circumstances may result in response times in excess of those mentioned above. ~~Under such conditions, no claims related to hot tap delays will be considered.~~

99132-1.15B HDPE Water Services

High Density Polyethylene (HDPE) services shall be installed per applicable City Standard and as specified on the Plans. ~~Any HDPE water service may be replaced with a copper water service if deemed necessary by the Engineer.~~

99132-1.15C Copper Water Services

Unless otherwise specified herein or in other contract documents, water service lateral installations of sizes 2" and smaller shall be HDPE.

If directed to install a copper water service it shall be installed per Section 132-1.03 of these specifications, the applicable City Standard, and any modification herein and/or on the Plans. All brass material and sections of copper tubing where the polyethylene coating is removed shall be wrapped with an approved waterproof pipe wrap to a minimum of 4" beyond any exposed brass or copper. All cut ends of copper tubing shall be deburred prior to installation. ~~Copper water services shall only be installed if specified on the plans or as directed by the Engineer. If a specific material is not specified HDPE service material shall be used. If copper material is shown to be used it shall be installed per applicable City Standard and as specified herein.~~

99132-1.15D Backflow Device Installation

The Contractor shall install new backflow prevention devices at the locations shown on the Plans or as directed by the Engineer. Backflow prevention devices shall be installed per applicable City Standards unless otherwise directed by the Engineer. The Contractor shall purge the water service at the meter of air and sediment, prior to installation. The Contractor shall coordinate this work to provide minimum out-of-service time to existing customers.

All piping downstream of the backflow device shall be of the same material called for between the meter and backflow device unless otherwise specified.

Unions, as required, shall be brass. ~~Brass unions shall be installed unless otherwise specified.~~

~~New backflow devices and piping shall match the size of the new water service. If an existing building service line is to be connected to and is galvanized iron, dielectric protection is required.~~

~~Where excavation for a new backflow prevention device occurs within the drip line of any street tree, the Contractor shall hand dig to protect tree roots, as directed by the Engineer.~~

After installation, the backflow prevention device shall be certified. Certifications shall be completed by a certified tester off the City of Santa Rosa “*Approved List of Backflow Contractors*”, which upon request will be provided by the City Engineer. All necessary paperwork shall be completed by the Tester and one copy given to the property owner and one to the Engineer within 72 hours after connection to the existing building service line.

Submittals shall be required for all backflow devices and related materials.

99132-1.16 Thrust Blocking

Unless other arrangements are made that are acceptable to the Engineer, the Contractor shall coordinate notification, and allow for visual inspection by the City, of all concrete thrust blocking.

Regardless of restrained joint requirements specified elsewhere or actual installation, concrete thrust blocks shall be installed behind all tees, when connecting to any existing line larger than 2” in diameter, and where restrained joints cannot be used or alone are deemed insufficient by the Design and/or City Engineer.

Concrete thrust blocks and/or harnesses shall also be installed per applicable City Standard, and in addition to restrained joints, where the water main is 12” in diameter or larger and the static water pressure in the distribution system is 90 psi or greater.

Permanent concrete thrust blocks and/or harnesses restraints shall be installed at least 24 hours prior to reactivation of the water system when reactivation is required immediately after completion of any operation where a water system shut down is needed and temporary blocking is not feasible. If a joint restraint system can be installed to alleviate the need for concrete thrust blocks and protects the existing and new water systems, it shall be used in place of this requirement.

~~Unless otherwise specified on the Plans or directed by the Engineer, and regardless of restrained joint installation, thrust blocks shall be installed behind all tees, when connecting to any existing line larger than 2 inch, and anywhere else where restrained joints cannot be used, or alone are deemed insufficient by the Engineer. Except for restrained joint pipe systems, all tees, bends, and plugs shall be provided with thrust blocks and/or harness as shown on the plans or in accordance with City Standards 853 and/or 854.~~ If/Wherever concrete thrust blocking is deemed necessary, by the City or the Contractor, it shall be installed per City Standards unless otherwise specified on the plans. Standards 853 and/or 854.

99132-1.17 Abandoning and/or Removal of Water Distribution System Components

Water mains as shown on the plans to be abandoned shall be abandoned per City Standard 507. If the end of the pipe to be abandoned is connected in any way to an active main and allowed to stay in place with the approval from the Director of Santa Rosa Water, the abandonment shall consist of a watertight cap or plug with and proper restraint, and the location shall be recorded on the plans. ~~unless otherwise approved by the Engineer.~~

Existing water system components shall be removed where shown on the Plans, or to facilitate the progress of work. The Contractor must first receive written approval from the Director of Santa Rosa Water prior to removing any component, fully or in part, that is active during construction, and the removed material shall be replaced to the satisfaction of the Water Department.

Prior to abandoning an existing main~~s~~ that will be replaced with a new main, all water services shall be transferred to the new and active main.~~s shall be completed unless otherwise approved by the Engineer.~~

Leaded joints encountered on water mains that are to stay active within the limits of excavations shall be removed by the Contractor as directed by the Engineer. The Contractor shall remove the joints by cutting out the section of pipe containing the exposed joint ~~to a minimum of two feet beyond the walls of the crossing trench~~ and installing ductile iron pipe and approved couplers, ~~conforming to the provisions of Sections 99-1.02 and 99-1.14 of these Specifications. The new section of pipe shall be secured with approved couplers per these Specifications and the City Standards.~~ The removed joint shall be handled, and disposed of according to the Contractor's State Licensing Law and all other applicable laws and regulations.

For all abandoned water services up to and including 2", ~~on mains that are to remain active,~~ remove the valve and saddle and install a stainless steel full circle clamp on the main under ~~Utilities Department~~City inspection.

Tees or crosses shown to be removed on water mains that will remain in service, shall have the tee or cross, any related valves~~(s) shown~~ and thrust blocking removed, and the main shall be repaired with ductile iron pipe and approved couplers.~~For flanged or mechanical joint tees, remove the valve and install a blind flange or mechanical joint plug under Utilities Department inspection.~~

~~For push-on tees, the tee, valve and concrete thrust block must be removed and the main repaired with approved pipe and suitable couplings.~~

Barrels of existing fire hydrants to be removed shall be carefully separated from risers and buried by the Contractor, and the hydrant only shall be delivered to the City's ~~Municipal Services Center~~Utilities Water Department Field Operations site located at ~~(535 Stony Point Road,)~~ unless the Contractor has obtained specific written approval by the ~~City~~Water Department to otherwise dispose of the materials.

Remove all valve boxes and risers on abandoned mains and backfill and resurface per City Standards. If any portion of a gate valve that is to be abandoned is in the structural section of the street, the valve must be fully removed and the pipe ends abandoned per Standard 507. Any valves not in the structural section of the street may be abandoned in place in the fully closed position.

After a new water service lateral is installed on an existing main and the meter is transferred, the old service lateral shall be abandoned by disconnecting it from the main and installing an approved stainless steel full circle clamp over the old penetration under City inspection. The old curb stop and meter box shall be removed and the area backfilled and resurfaced to match the surrounding surface. Any sidewalk that must be replaced shall be done to the nearest transverse score mark on

both sides and the full sidewalk width.

Any abandonment that requires a system shutdown, such as removing an old water service from an active main, shall be done under inspection by authorized City personnel.

99132-1.18 Hydrostatic Test

Prior to being allowed to connect to the City of Santa Rosa's water distribution system all newly constructed water mains, and their appurtenances, shall be hydrostatically tested in accordance with AWWA C600, and any modifications herein.

4" and larger water service laterals, including fire lines, that are installed on an existing water main by cut-in or hot tap requires that the disinfection and bacteria test sampling shall take place prior to hydrostatic testing. The Contractor shall request, and the Engineer shall provide the proper procedures for this operation.

Methods and equipment used for hydrostatic testing shall be submitted to the Engineer for approval.

The Contractor, at their option, may test the system at any time during construction. However, the final test, which will be witnessed by the City for acceptance, shall take only place after the system is fully constructed and trenches backfilled and compacted, but prior to final paving.

Each valved section of the system, or combined sections, as approved by the Engineer, shall be hydrostatically tested to a pressure of not less than 150psi measured at the highest point along the section to be tested. Where the static pressure in the City's distribution system to be connected to is greater than 100psi, the test pressure shall be 1.5 times the static pressure of the City's distribution system.

If complying with the above requirements it appears that the specified test pressure may exceed the new system's designed thrust restraint, valving or joint pressures at the lowest elevation, the Contractor shall request direction from the Director of Santa Rosa Water.

Except where otherwise specified or approved by the Director of Santa Rosa Water, pressure testing against closed gate valves shall not take place. Where testing against a closed gate valve is approved, the valves supplied by the Contractor shall be rated to exceed the specified test pressure. Any damage to gate valves shall be the responsibility of the Contractor and must be corrected to the satisfaction of the Director of Santa Rosa Water, including up to full replacement.

Each section of the new system shall be slowly filled with water, and all air expelled through an opening(s) located at the highest point(s) of the system. If necessary, tap the main at point(s) of the highest elevation(s) and install corporation stops to assist in expelling during filling of the system. Unless the taps are located where combination air and vacuum valves have been designed into the system, the penetrations shall be sealed with stainless steel full circle clamps once all air is expelled. All caps, plugs, fittings and any other appurtenance shall be properly braced prior to pressurizing the system.

When testing ductile iron pipe, it is advisable to allow some time for the lining to absorb water prior to the hydrostatic test.

After all air is expelled, the specified test pressure shall be applied by means of an approved pump connected to the new system in a manner approved of by the Engineer. The pump, connection fittings, and all other necessary apparatus except for the pressure gauge and measuring devices shall be furnished by the Contractor. The City of Santa Rosa will furnish the pressure gauge and measuring devices for the test. The Contractor shall construct all openings into the new system required for filling and expelling air, and shall furnish all necessary assistance for conducting the tests. Before applying the test pressure, all air shall be expelled from the pipe.

The gauge(s) used to measure pressure for the test shall be a liquid filled gauge with increments no greater than 5psi.

The duration of each pressure test shall be 2 hours, and the test pressure shall not vary by more than ± 5 psi. The pressure shall be maintained within this tolerance by adding makeup water through the approved test pump into the system. The makeup water shall be accurately measured in gallons by a meter or by pumping from an approved vessel of known volume, and shall not exceed the applicable testing allowance as specified in Table 1.

Table 1
Hydrostatic testing allowance per 100ft of pipeline*
Gallons per hour

Avg. Test Pressure <i>psi</i>	Nominal Pipe Diameter									
	4"	6"	8"	10"	12"	14"	16"	18"	20"	24"
150	0.033	0.050	0.066	0.083	0.099	0.116	0.132	0.149	0.166	0.199
175	0.036	0.054	0.072	0.089	0.107	0.125	0.143	0.161	0.179	0.215
200	0.038	0.057	0.076	0.096	0.115	0.134	0.153	0.172	0.191	0.229
225	0.041	0.061	0.081	0.101	0.122	0.142	0.162	0.182	0.203	0.243
250	0.043	0.064	0.085	0.107	0.128	0.150	0.171	0.192	0.214	0.256
275	0.045	0.067	0.090	0.112	0.134	0.157	0.179	0.202	0.224	0.269
300	0.047	0.070	0.094	0.117	0.140	0.164	0.187	0.211	0.234	0.281

*If sections of various diameter piping are to be tested at the same, the testing allowance shall be the sum of the testing allowances for each size.

Leakage is defined as the quantity of water to be supplied into the newly constructed water system,

or any valved section thereof, necessary to maintain the specified test pressure.

If at any time during the pressure and leakage testing the specified test pressure can be maintained ± 3 psi for a consecutive 30 minutes without adding makeup water, the test can be discontinued and the system considered as passing. Should any test of combined or individual sections of the new system show leakage greater than the specified limit, the Contractor shall, at their own expense, locate the cause and repair the defect until the leakage is within the specified allowance.

Regardless of test results, the Contractor shall repair any leaks detected.

~~All equipment used for hydrostatic testing and shall first be approved by the Engineer. At no time shall water trucks be used in the application of loading water mains for any purpose unless first approved by the City's Water Quality Section.~~

~~The test shall be performed after the water system has been laid and all backfill placed and compacted as specified elsewhere in these specifications. The Contractor, at his their option, may test the pipe at any time during construction. However, the final test for acceptance shall be made under City inspection and only after all backfill is in place.~~

~~Pressure testing against valves is shall not allowed unless authorized by the Director of Santa Rosa Water Utilities.~~

~~Valves on existing pipes in service shall be operated only by City forces.~~

~~Each section of pipe shall be slowly filled with water and the specified test pressure shall be applied by means of a pump connected to the pipe in a satisfactory manner. The pump, pipe connection, and all necessary apparatus except gauge and measuring devices shall be furnished by the Contractor. The City of Santa Rosa will furnish the gauge and measuring devices for the test. The Contractor shall make the taps into the pipe and shall furnish all necessary assistance for conducting the tests. Before applying the test pressure, all air shall be expelled from the pipe. To accomplish this, taps shall be made, if necessary, at the points of the highest elevation, and afterwards tightly plugged.~~

~~Each valved section of pipe, or combined sections, as approved by the Engineer, shall be subjected to a hydrostatic pressure of not less than 50 psi above working pressure and not less than 150 psi at any point on the pipe. The duration of each pressure test shall be thirty minutes. Suitable means shall be provided by the City for determining the quantity of water leakage under the test pressure. No pipe installation will be accepted until or unless this leakage is less than 40 U.S. gallons per 24 hours, per mile of pipe, per inch nominal diameter of pipe. Should any test of combined or individual sections of pipe disclose leakage greater than the specified limit, the Contractor shall, at his own expense, locate the cause and repair the defect until the leakage is within the specified allowance.~~

~~Leakage is defined as the quantity of water to be supplied into the newly laid pipe, or any valved section of it, necessary to maintain the specified leakage test pressure after the pipe has been filled with water and the air expelled. The Engineer shall designate the time at which the tests shall be~~

~~made.~~

~~The Contractor shall repair any obvious leaks even though the hydrostatic test results are within the prescribed limits above.~~

99132-1.19 Cleaning, Flushing and ~~Chlorination~~ Disinfection of the New Water System Pipeline

Cleaning, flushing and disinfection of new water system components purposed to be connected to the City of Santa Rosa's Water Distribution System shall conform to AWWA C651, all applicable City Standards, and any modifications herein and/or on the plans. To ensure the sanitary integrity of the new water system the Contractor shall practice proper sanitary technics during storage, handling and construction of the new water system.

Unless otherwise approved by the Director of Santa Rosa Water cleaning and flushing of all mainline pipes shall be accomplished by propelling the swab down the pipeline to an exit point per Section 132-with an approved source of potable water. After removal of the swab(s) a unidirectional flush of the new system shall continue until the water is completely clear.

During the installation of new water main(s), the Contractor shall insert an appropriately sized flexible polyurethane foam sweeping or cleaning style swab, with a density of 2 pounds per cubic foot, complete with polyurethane drive seal, into the beginning or ending segment of each pipe run. The swab shall stay in place until utilized for cleaning operations as specified.

Where tees or crosses are installed as part of the new system, swabs shall be placed where practical, and per direction from the Engineer, so both the "run" and "branch" segments are able to be swabbed. If determined by the Engineer that sanitary technics were practiced during construction, the Engineer may, at their discretion, allow segments of new main of 80 linear feet or less to be cleaned by line flushing only.

All temporary blow-offs installed for the purpose of removing foam swabs required for water main cleaning shall be constructed similar to Standard 862 with a "same size as main" elbow and vertical stand pipe to prevent trench and dispelled water from flowing back into the main. After the swab is removed the end of the pipe shall be sealed watertight and all parts restrained to allow for testing. All temporary material shall be removed during operations to connect to the City's distribution system.

After swabbing, as specified above, is complete, any segment that may have been allowed to be omitted by the Engineer, and every lateral, shall be flushed until clean and free of air and debris.

Water used for flushing shall be considered contaminated after exiting the new system and shall not be allowed to reenter the system. If, in the opinion of the Engineer, the new system becomes contaminated the Contractor shall be required to re-disinfect the system, all or in part, at no additional cost to the City.

Except as otherwise specified or permitted by the Director of Santa Rosa Water, disinfection of

the new system shall only take place after all lines have been cleaned and flushed, and each required hydrostatic test has been accepted by the Engineer.

All laterals, 2" and larger, including fire lines, installed on an existing main shall be disinfected and bacteriological test samples taken as specified herein.

All 1" and 1-1/2" service laterals components installed on an existing main shall be thoroughly swabbed with a 1 percent liquid chlorine solution during construction.

All laterals shall be thoroughly flushed just prior to being put into service. Methods, material and equipment used for disinfection of the water system shall be submitted to the Engineer for approval.

Sodium hypochlorite (liquid chlorine) of 10%, 12.5% or 15% shall be utilized for disinfection operations and shall be applied as stated herein. The use of household bleach is not permitted for disinfection at any time.

The point of application of the disinfectant shall be through a permanent or temporary blow off, or through a new fire hydrant installed as part of the new system. If none of the aforementioned components are available or practical for use, the Contractor may use a corporation stop of an approved size, if approved by the Engineer. Adequate venting must be allowed, and both filling and venting port elevations shall be a minimum of 6 inches higher than all components to be disinfected.

Water from the City's existing distribution system shall be used to fill the new mains at a slow controlled rate of flow during the application of the disinfectant; this rate of flow shall not exceed the limits of any openings used to expel water and/or air, including installed air release valves. Precautions shall be taken to prevent back pressure causing a reversal of flow into the City's water distribution system. In the process of disinfecting, all valves and other appurtenances on the new water system shall be operated in such a way to allow the disinfectant solution to be fully distributed to all components of the new water system.

The rate of disinfectant feed shall be in such proportion to the rate of water entering the pipe that the disinfectant dose applied shall be between 100ppm and 200ppm. The disinfectant solution shall be retained in the pipe for a period of at least 24 hours but no longer than 72 hours. After 24 hours disinfectant levels shall not be less than 50% of the initial dosage, as recorded by the Inspector. If the disinfectant level is less than 50% of the initial dosage, the system shall be flushed and the above disinfection procedures repeated. When disinfectant levels are acceptable after the retention period, the chlorinated water shall then be discharged as specified in Section 132-1.20 "Discharge of Chlorinated Water", and all new mains and laterals shall be given a final flush and then filled with water from the City's distribution system.

While the final flush of the new system is taking place the Engineer, or their representative, will take a chlorine residual reading from the City's distribution system and note it. If the reading is higher than 0.5 ppm, the new system shall be flushed until residual readings taken at all locations, as determined by the Engineer, are between the residual noted from the City's distribution system

and 1 ppm, but no higher. If the residual taken from the City's distribution system is less than 0.05 ppm, the new water system shall be flushed until all locations are between 0.5 ppm and 1 ppm.

After the disinfectant is flushed from the new water system and all residual readings are as specified, an initial set, consisting of two bacteria test samples per location, shall be taken where specified by the Engineer per one of the following methods;

Method A:

Take a first set of sample tests just after flushing is complete, and the second after a minimum of 16 hours, but not more than 72 hours after flushing.

Method B:

After flushing is complete let the system sit a minimum of 16 hours without any use, then collect both sets of sample tests from the same locations 15 minutes apart while allowing the sample port to maintain a slight flow in between samples.

The method used shall be determined by the Engineer at the time of sampling.

All residual readings and bacteria test samples specified herein shall be taken by the Engineer, or their designee, and witnessed by the Contractor.

The Engineer must receive written test results showing that all samples from both sets taken are negative for contamination prior to scheduling connection(s) to the City's water distribution system.

If bacteria test results indicate contamination the new water system shall be flushed and sampling shall take place again as specified above. If any results from the additional sampling still show indication of contamination the new system shall be disinfected and flushed again prior to any additional bacteria test sampling taking place.

Unless otherwise approved by The City of Santa Rosa Water Quality Supervisor, the initial two sets of bacteria tests will be considered valid for up to 14 calendar days after the second set has been taken. All other sets taken will be valid for up to 10 calendar days. If more time passes than those specified before connecting to the City's distribution system, additional passing bacteria test samples will be required before connections are approved.

Costs for the collection and analysis of the initial sets of bacteria test samples will be paid for by the City. Samples shall be taken at a minimum; on each blow off of the new water system and on at least one water service between each two blow-offs. The exact location and quantity of the samples will be determined in the field by the Engineer. There shall not be more than 1200 feet between sample points. Samples taken from fire hydrants, new or existing, shall be avoided where possible, if samples must be taken from a fire hydrant the hydrant shall first receive a high volume flush to clean the interior.

The City will pay labor and analytical fees for collecting and analyzing up to two additional sets of bacteria test samples. If additional testing is required, costs shall be borne by the Contractor.

If deemed necessary by the Director of Santa Rosa Water, due to unsanitary or other construction practices, as determined by the Engineer, the Contractor may be required to do additional sampling with satisfactory results prior to connecting to the City's distribution system.

~~Chlorine may be applied by any of the standard methods, subject to the approval of the Engineer. The point of application of the chlorination agent shall be at the beginning of the pipe extension, or any valved section of it, and through a corporation stop inserted in the newly laid pipe.~~

~~Water from the existing distribution system shall be controlled to flow very slowly in the newly laid pipe during the application of chlorine. Precautions shall be taken to prevent back pressure causing a reversal of flow into the pipe being treated. In the process of chlorinating, all valves and other appurtenances on the new pipe shall be operated in such a way as to provide that the chlorine mixture shall be fully distributed to all parts of the new water system. Valves on existing pipes in service shall be operated only by City forces.~~

~~The rate of chlorine feed shall be in such proportion to the rate of water entering the pipe that the chlorine dose applied to the water entering the newly laid pipe shall be at least 100 ppm. The chlorine mixture shall be retained in the pipe for a period of twenty-four hours. After the chlorine mixture has been retained for the required time, the chlorine residual at the pipe extremities and at representative points shall be at least 5 ppm.~~

~~Following chlorination, all chlorine mixture shall be thoroughly flushed from the new pipe.~~

132-1.20 DISCHARGE OF CHLORINATED WATER

Chlorinated water used to disinfect newly constructed water systems is the property of the Contractor and its disposal is the responsibility of the Contractor. Chlorinated water used to disinfect the new mains shall be disposed of in accordance with AWWA C655, all laws and regulations, and any modifications herein or specified on other contract documents.

Discharge to the storm drain system or a waterway is not permitted without a permit from the North Coast Regional Water Quality Control Board.

Discharges may be allowed to be disposed of into the sanitary sewer system, but must first meet the following requirements:

- A. The City of Santa Rosa Subregional Reclamation Facility shall be notified by the Engineer in coordination with the Contractor, prior to the discharge being disposed of in the sanitary sewer system. The payment of any fees required shall be the responsibility of the Contractor.
- B. The pH of the water must be between 6.0 and 9.5.

- C. The Contractor shall maintain an approved “air gap” from the discharge conduit to the receiving sewer facility. ~~with a minimum vertical distance of twice the diameter of the discharge conduit.~~

~~Chlorinated water used to disinfect the pipe is the property of the Contractor and its disposal is the responsibility of the Contractor. Chlorinated water used to disinfect the pipe shall be disposed of in accordance with all laws and regulations.~~

~~The following criteria must be met prior to disposal of chlorinated water to storm sewers or other inland waterways:~~

- ~~_____ (1) Water to be disposed of must contain no chlorine residual.~~
- ~~_____ (2) pH must be between 6.5 and 7.5.~~
- ~~_____ (3) North Coast Regional Water Quality Control Board, at 576 2220, must be notified of discharge.~~

~~Discharges not meeting the above criteria may be allowed to be disposed of into the sanitary sewer system, but must first meet the following requirements:~~

- ~~_____ (1) The Contractor must obtain permission from the City of Santa Rosa Utilities Department Industrial Waste Section, 543 3369, prior to the discharge being disposed of in the sanitary sewer system. The payment of any fees required will be the responsibility of the Contractor.~~
- ~~_____ (2) The pH of the water must be between 6.0 and 9.5.~~

~~Should the initial treatment, in the opinion of the Engineer, prove ineffective, the chlorination procedure shall be repeated until confirmed tests show that the water sampled from the newly laid pipe conforms to the above requirements.~~

~~The initial bacteria samples will be taken and tests made by the City of Santa Rosa. There shall be a 24 hour waiting period after blowing off the pipe prior to taking bacteria samples. If the initial bacteria test fails, two consecutive passing bacteria tests must be obtained prior to making the tie-in. The City will pay for retesting up to ten additional individual bacteria sample tests. If additional testing is required, it will be necessary for the contractor to arrange for and to pay for the tests at a State of California certified laboratory. In extreme cases, at the discretion of the Engineer it may be necessary to require, at the contractor's expense, a complete Title 22 potable water test prior to tie in.~~

~~Bacteria tests are valid for 30 days. If there is more than a 30 day lapse between a bacteria test and the applicable tie-in, the bacteria test must be repeated prior to performing the tie-in.~~

Upon completion of construction and testing of new water mains, service laterals and other appurtenances, ~~final~~tie-in connection(s) ~~shall~~can be made by the Contractor under inspection by authorized City personnel.~~Upon completion of construction, final connection will be made by the Contractor under inspection by City Utilities Department Representative, unless otherwise specified on the plans.~~

The Contractor shall make a schedule request, to the Engineer, for any work which requires a City water distribution system shutdown, including, but not limited to, connection to the City's distribution system or a service hot tap. Connections to the City's distribution system will not be scheduled until the Engineer has received documentation of all required passing bacteria tests. The Contractor shall submit a separate written request to the Engineer to schedule each individual shutdown required to facilitate a tie-in connection or any other work where a shutdown may be necessary. The Contractor shall submit written shut down requests at least 2 working days, and 3 working days in advance for residential and commercial shutdowns respectively. The Santa Rosa Water Department will attempt to facilitate shutdowns within these timeframes; however, extenuating circumstances may result in response times in excess of those mentioned above. Under such conditions, no claims related to work delays shall be considered. All shutdowns and valve turning operations shall be performed by authorized City personnel only. Authorized City personnel must be present during any operation requiring a shutdown unless otherwise approved by the Director of Santa Rosa Water and provided to the Contractor in writing. Connections to the City's distribution system shall not be performed without prior authorization by the Engineer.~~The Contractor shall notify the City inspector 48 hours prior to individual mainline shutdowns required to facilitate a tie in. The contractor shall schedule tie in work with the Engineer and with the City Utilities Engineering Division at (707) 543-3950. Tie ins will not be scheduled until a written passing bacteria test has been received by Utilities Engineering. All shutdowns and valve turning operations shall be performed by City Utilities personnel only. A Utilities Department Inspector must be present during all tie in operations. No tie ins shall be performed without prior authorization of the Engineer.~~

Individual hot taps may be requested a minimum of 2 working days in advance, if the request is for multiple hot taps to be done on the same day the request shall be made a minimum of 5 working days in advance. The City will attempt to facilitate hot taps within these timeframes; however, extenuating circumstances may result in response times in excess of those mentioned herein. Under such conditions, no claims related to hot tap delays will be considered. Hot tap scheduling shall also be subject to the limitations of Section 6-4.01B, "Water Utility Notification", of these Special Provisions.

4" and larger hot taps or any size cut-in shall not be allowed within 4' of a joint unless first receiving written approval from the Director of Santa Rosa Water. 4" and larger hot taps that are within 4' of a joint shall be replaced with a cut-in tee.

Any existing joint that is not specified to be replace and is disturbed by the Contractor's operations may be require by the Director of Santa Rosa Water to be removed and replaced with approved pipe and couplings under City inspection, and at no additional cost.

Excavations for individual tie-in connections and hot taps ~~4 inches and larger must~~ shall be completed as much as possible without causing damage to new or existing facilities and plated a minimum of 1 working day in advance of the scheduled work. If this requirement is not met, the scheduled work will be cancelled. All ~~tie-in parts and~~ connection materials shall be on site for inspection at the tie-in location the morning of the scheduled work.

Contractors ~~or parties~~ who fail to keep field appointments shall be billed for **City personnel and equipment time used**, ~~scheduled Utilities Crew waiting or standby time which was used~~ and the contractor shall bear the costs incurred by the ~~Utilities Department~~**City** for notification of its customers for the subsequent appointment.

~~As a general rule, customer service shall not be terminated or interrupted on Mondays.~~

Interruption of service to commercial customers shall, as much as practical, be coordinated with the customer's needs. **After notification by the Contractor for such a need, the City will contact commercial customers for service interruption needs and will inform the Contractor accordingly.** ~~The Utilities Department will contact the customers, consider the customer's interests and inform the Contractor accordingly.~~

City crews work a 9/80 schedule; this schedule may prohibit shutdowns on alternating Fridays.

~~After hours work or weekend work is to be avoided whenever possible and any overtime costs shall be borne by the contractor requesting such after hours work. Normal working hours are: 7:00 A.M. to 3:30 P.M.~~

Contractors ~~or parties~~ requiring work of any kind by ~~the Utilities Department~~**City** forces shall request such services a minimum of 48 hours in advance of the time such services are desired. Work requests, which will involve ~~Utilities Department~~**City** forces for more than 8 hours or an extensive number of City supplied parts, shall be requested a minimum of 7 calendar days in advance.

If it is necessary to terminate service to any customer, the contractor shall make the request for such work an additional 72 hours (three additional working days for a total of five working days advance notice) in advance of the time such services are desired to allow the customers affected to have a minimum 72 hour notice.

When installing a cut-in-tee **or cross** that is larger than the existing pipe, the new assembly ~~must~~ shall be installed at the depth appropriate to the size of the "cut-in" tee or cross, and shall include all fittings, pipe and couplers required to make the change in grade and connections unless otherwise directed by the Engineer. Depth shall also be sufficient to allow ~~the any valve(s) that may be part of the assembly~~ to remain below the subgrade of the street. ~~which may necessitate lowering the existing pipe.~~

When a connection is required to an existing water pipe, the contractor shall provide all excavation, shoring, backfill and trench resurfacing per City Standard 215.

All joints of a tie-in connection to the City's distribution system shall be mechanically restrained.

Where the connection is to be a "hot tap", the contractor shall provide and install the tapping valve and sleeve, and any other hardware required and City forces ~~will~~ shall make the tap at the developer's expense, unless it is part of a Capital Improvement Project, in which case the hot tap shall be paid for accordingly.

Full circle tapping saddles shall be used when hot tapping 10" and Larger PVC pipe with a static pressure of 85psi or higher

~~When any joint on an existing water pipe is disturbed or within 4 feet of aof a, that joint and any proposed hot tap 4" and larger the hot tap shall be replaced with a "cut-in" tee.~~

Where ~~en~~ a "cut-in" tee or cross and valve(s) assembly is required ~~on the plan~~ to be installed, the contractor shall provide and install the entire assembly (including valves), and any other hardware necessary under City ~~Utilities Department~~ inspection, and shall provide all other work and materials necessary to complete the installation to City Standards.

During the work, the Contractor shall exercise all necessary precautions to prevent the entrance of trench water or any other foreign material into the water main and appurtenances and shall conduct all operations in accordance with the most stringent sanitation practices. The interior of all appurtenances being installed, as well as the exterior of the pipe that will come into contact with the distribution water, shall be thoroughly swabbed with a minimum ~~strong HTH~~ 1 to 3-percent liquid chlorine solution prior to installation.

When connecting to an existing water main the Contractor shall install temporary and permanent thrust blocking, as necessary, for restraint and to allow for reenergizing of the water main immediately after all plumbing is complete.

When installing new components by "cut-in" to an existing PVC or ductile iron main, all new joints shall be mechanically restrained.

~~Connections to cast iron, PVC, or ductile iron pipes shall be made with mechanical joint solid sleeves unless otherwise approved by the Engineer. When connecting to asbestos cement and/or "over sized" cast iron pipe, "wide range" style couplings from Ford, Smith Blair, Romac or an approved equivalent shall be used. Submittals are required for all couplings. Tie in or cut in tee connections to cast iron, PVC, or ductile iron pipes shall be made with mechanical joint solid sleeves. Flexible connections shall only be used when connecting to asbestos cement pipe.~~

Pipe and fittings furnished for tie-ins shall be no smaller than the existing water main to which each tie-in is made.

99-1.21 Water System Component Reporting

~~The Contractor shall submit the material type, manufacturer and model number of all water system components to the City inspector prior to final testing.~~

99132-1.22 Construction Water

All water required for the performance of work shall be legally obtained and furnished by the Contractor.

Prior to obtaining water from the City's water system the Contractor shall obtain a Water Use Permit and rent a hydrant or bridge meter, this can be done at ~~69 Stony Circle~~ 35 Stony Point Rd, Utilities Field Operations ~~Department~~ front counter, Ph# 707-543-4200. The Contractor is responsible for any deposits required, permits and moving fees, and the cost of all water used. Deposits shall be refunded upon removal of the meter by City forces, less any charges for water used. Any damage to the meter may result in forfeiture of all or part of the deposit.

Unmetered connections are not permitted to the City of Santa Rosa water system, including connections ~~that~~ ~~bypassing~~ meters for testing onsite plumbing, or for obtaining construction water. When a subdivision water main has been accepted and tied-in the individual curb stops will be locked off with cable ties/~~or locks~~. Cutting off or tampering with the cable ties/ ~~or locks~~ will constitute a straight tie-in connection. Such connections ~~will~~~~shall~~ be severed by the Utilities Department and will result in penalties including payment of fines and estimated water usage fees.

Construction water shall be obtained from the City water system only at the point(s) designated by the Engineer.

~~The contractor must possess a valid Water Use Permit issued by the Utilities Department for each metered construction water connection.~~

~~A deposit for each meter will be required which is refundable upon removal of the meter by City forces, less any charges for water used.~~

Contractors are prohibited from operating gate valves or fire hydrants on the City system.

Use of water obtained from unmetered fire hydrants or other facilities is a violation of City ordinance and State law. Use of construction water from sources other than the City Water System must be approved by Engineer.

Citations and fines will be levied for violation of these and other utility regulations and deductions will be made from progress payments if necessary.

Construction water for the work under this contract will **not** be furnished by the City.

At no time shall water trucks or any other unapproved vessel be used in the application of loading water mains unless first approved of by the City's Water Quality Section.