


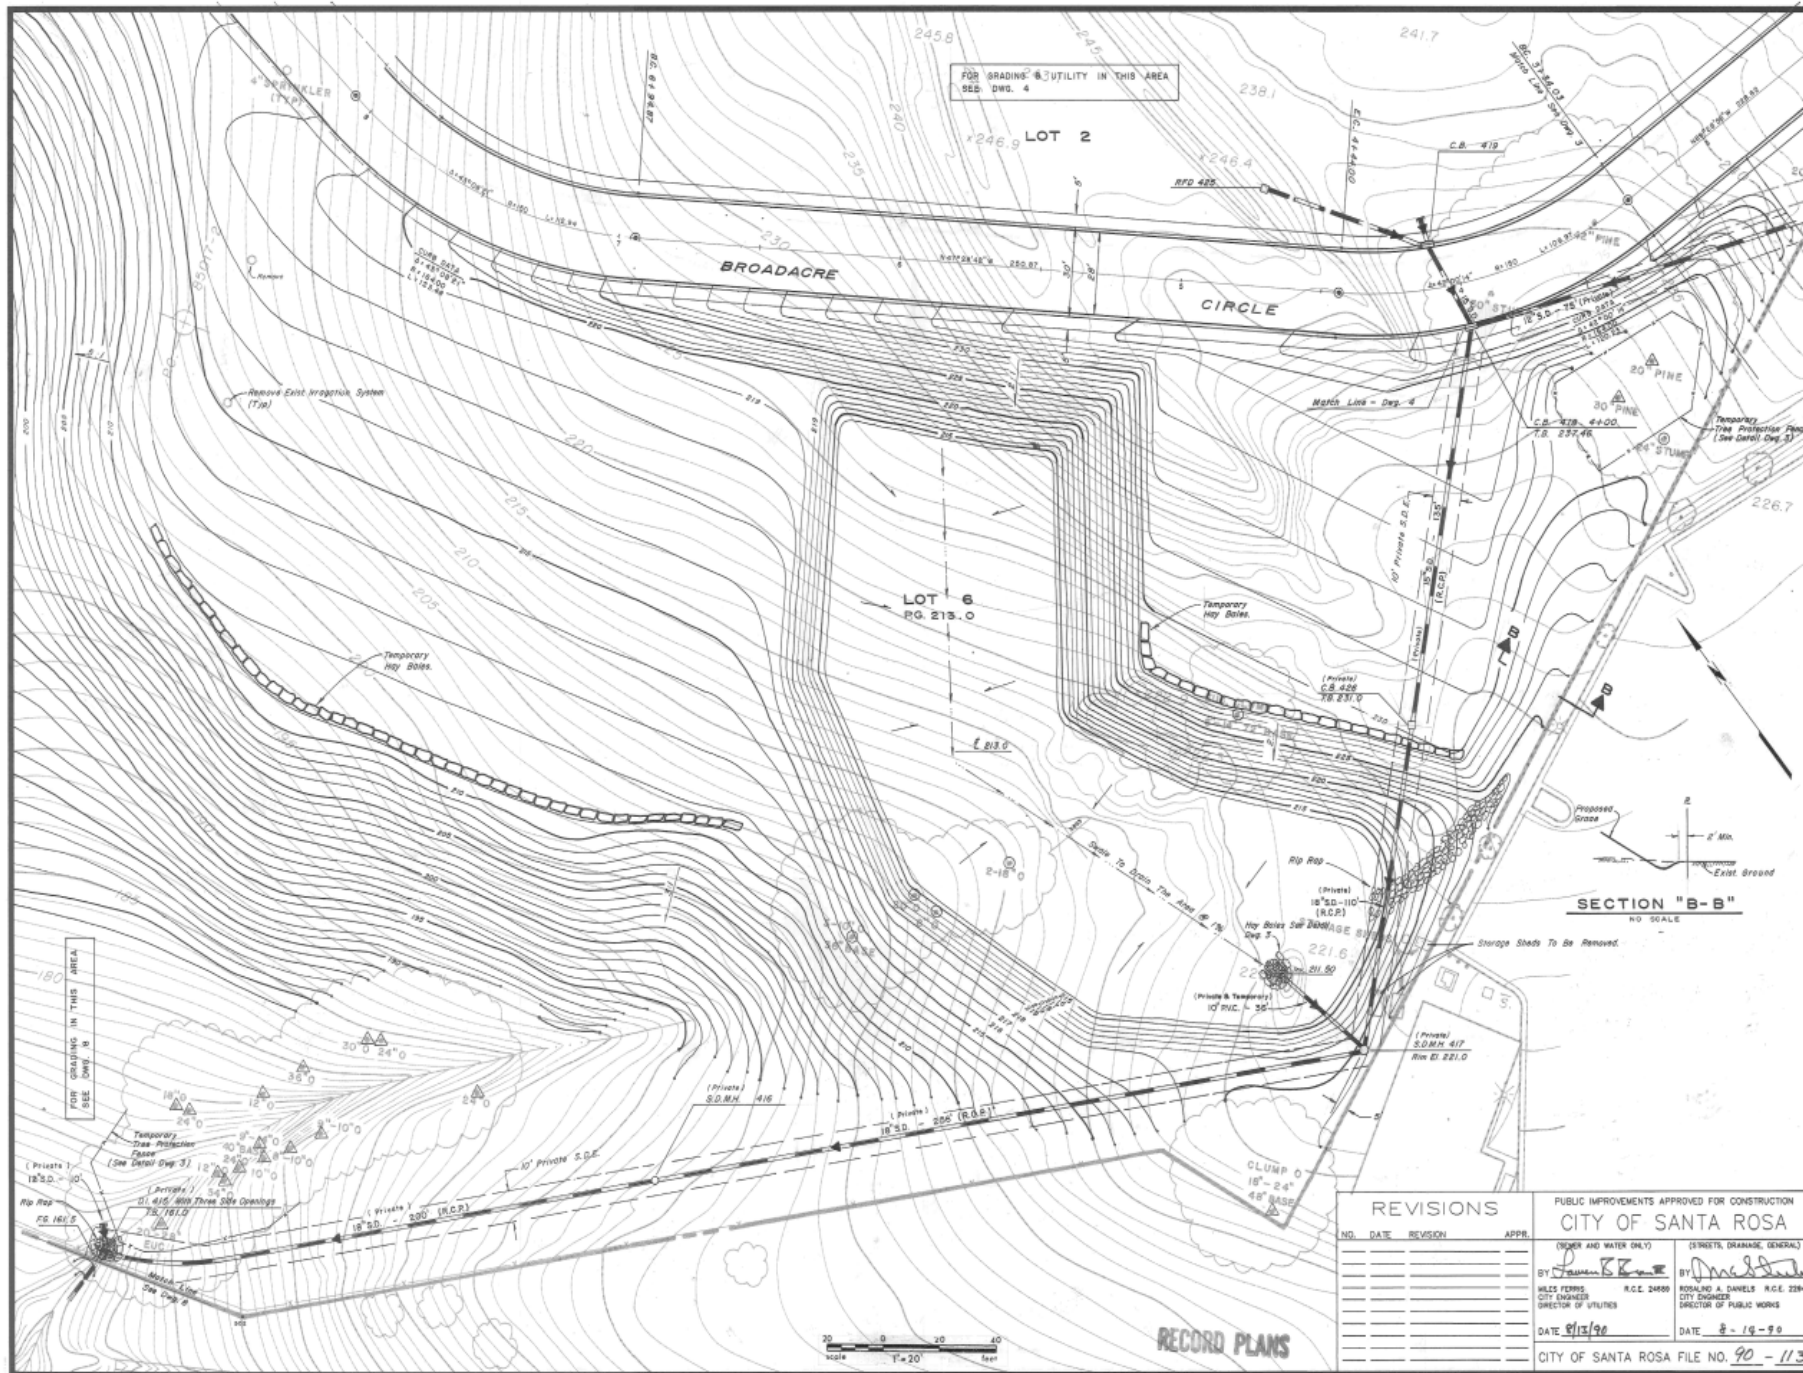

FOR GRADING & UTILITY IN THIS AREA
SEE DWG. 4

LOT 2

BROADACRE

CIRCLE

LOT 6
PG. 213.0

SECTION "B-B"
NO SCALE

RECORD PLANS

REVISIONS

NO.	DATE	REVISION	APPR.

PUBLIC IMPROVEMENTS APPROVED FOR CONSTRUCTION CITY OF SANTA ROSA

(SEWER AND WATER ONLY)		(STREETS, DRAINAGE, GENERAL)	
BY <i>[Signature]</i>	R.C.E. 24000	BY <i>[Signature]</i>	R.C.E. 22843
MILES PEREZ CITY ENGINEER DIRECTOR OF UTILITIES		ROSALEO A. DANIELS CITY ENGINEER DIRECTOR OF PUBLIC WORKS	
DATE 9/13/90		DATE 8-19-90	
CITY OF SANTA ROSA FILE NO. 90-113			



CARLISLE / ASSOCIATES
CIVIL ENGINEERS • SURVEYORS • LAND PLANNERS
303 WEST COLLEGE AVENUE • SANTA ROSA, CALIFORNIA 95404 • 705-454-4001
FEB 1990



FOUNTAINGROVE EXECUTIVE CENTER
SANTA ROSA, CALIFORNIA
GRADING & UTILITY PLAN

DATE FEB 1990
REVISIONS
DRAWN BY CHECKED
J.M.M.
JOB NO. 837-282
DRAWING NUMBER
7 of 13