EXISTING

Attachment 4

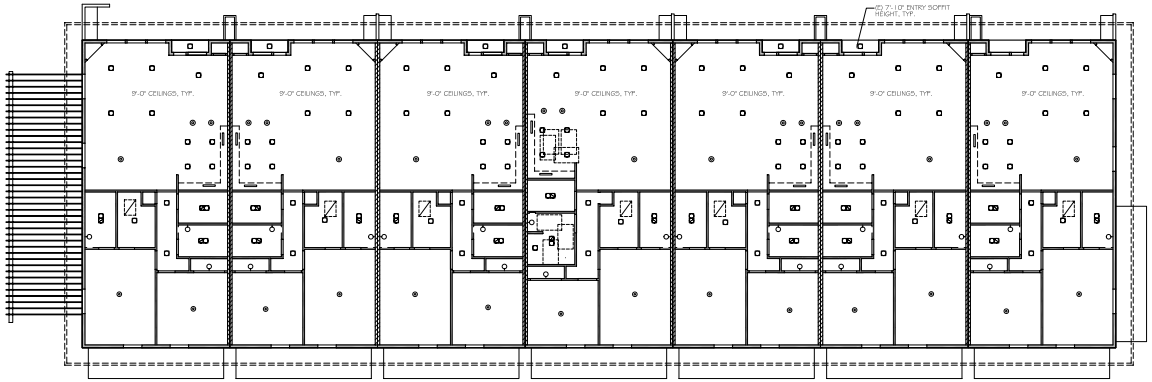

APARTMENT REFLECTED CEILING PLANS SCALE: 1/8" = 1'-0" 2

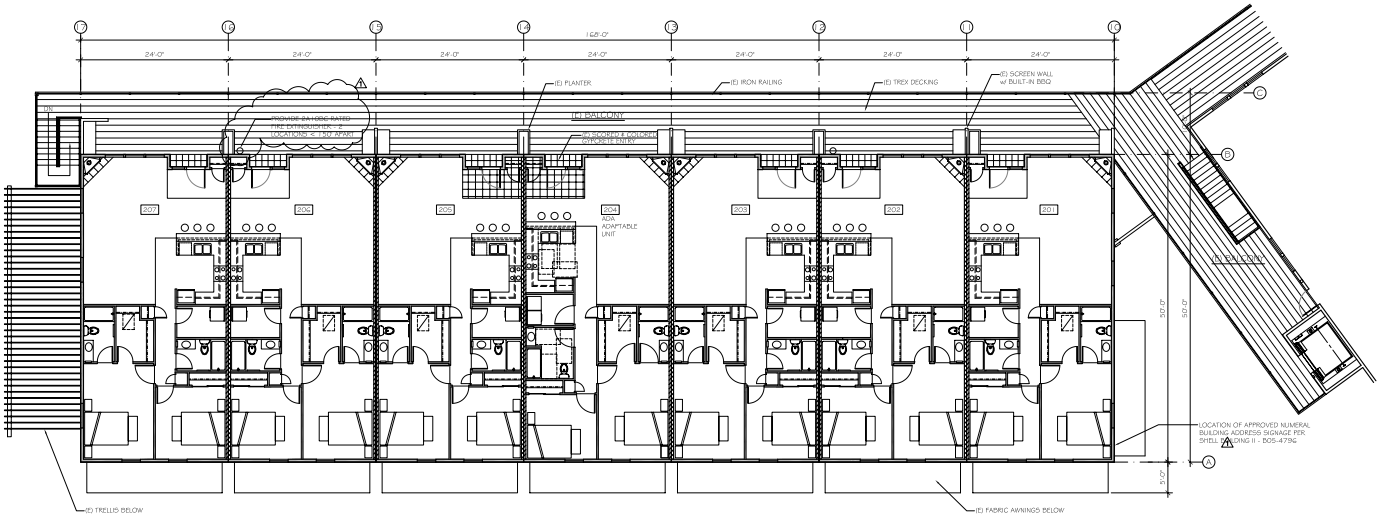

TRUE NORTH

NORTH

APARTMENT FLOOR PLANS SCALE: 1/8" = 1'-0" 1

City of Santa Rosa
Planning & Economic
Development Department
05/05/2025
RECEIVED

M:\Projects\Lafranchi\Projects\04.26 Skyhawk Village\Apartments\AP2.0.dwg

REVISIONS	BY
1 02/11/07 PLAN CHECK	HO

Lafranchi
ARCHITECTURE & DEVELOPMENT
414 Aviation Boulevard
Santa Rosa, California 95403
phone 707.576.4514
fax 707.576.3140
Lafranchidevelopment.com

LICENSED ARCHITECT
NO. C 23475
REN. 03/31/07
STATE OF CALIFORNIA

SKYHAWK VILLAGE - APARTMENTS
5761 MOUNTAIN HAWK WAY SANTA ROSA, CALIFORNIA
APN 153-180-012

Date	01/04/07
Scale	AS NOTED
File No.	AP2.0
Job No.	04.26
Plot	Feb 23, 2007
Sheet	AP2.0

PROPOSED

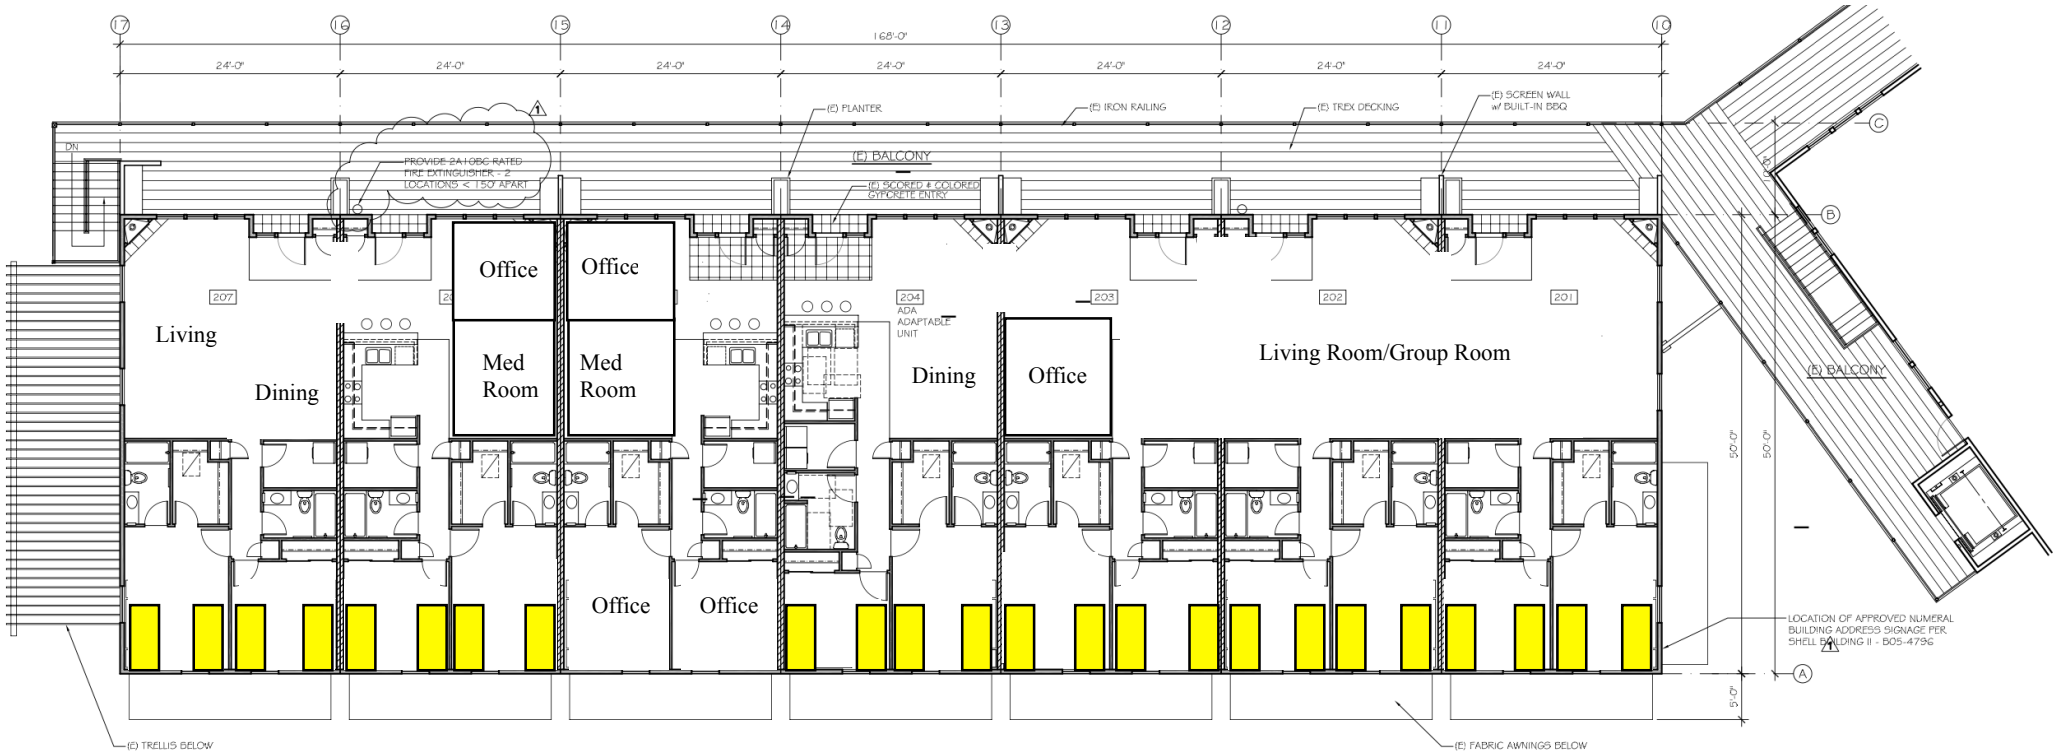

City of Santa Rosa
Planning & Economic
Development Department
05/05/2025
RECEIVED